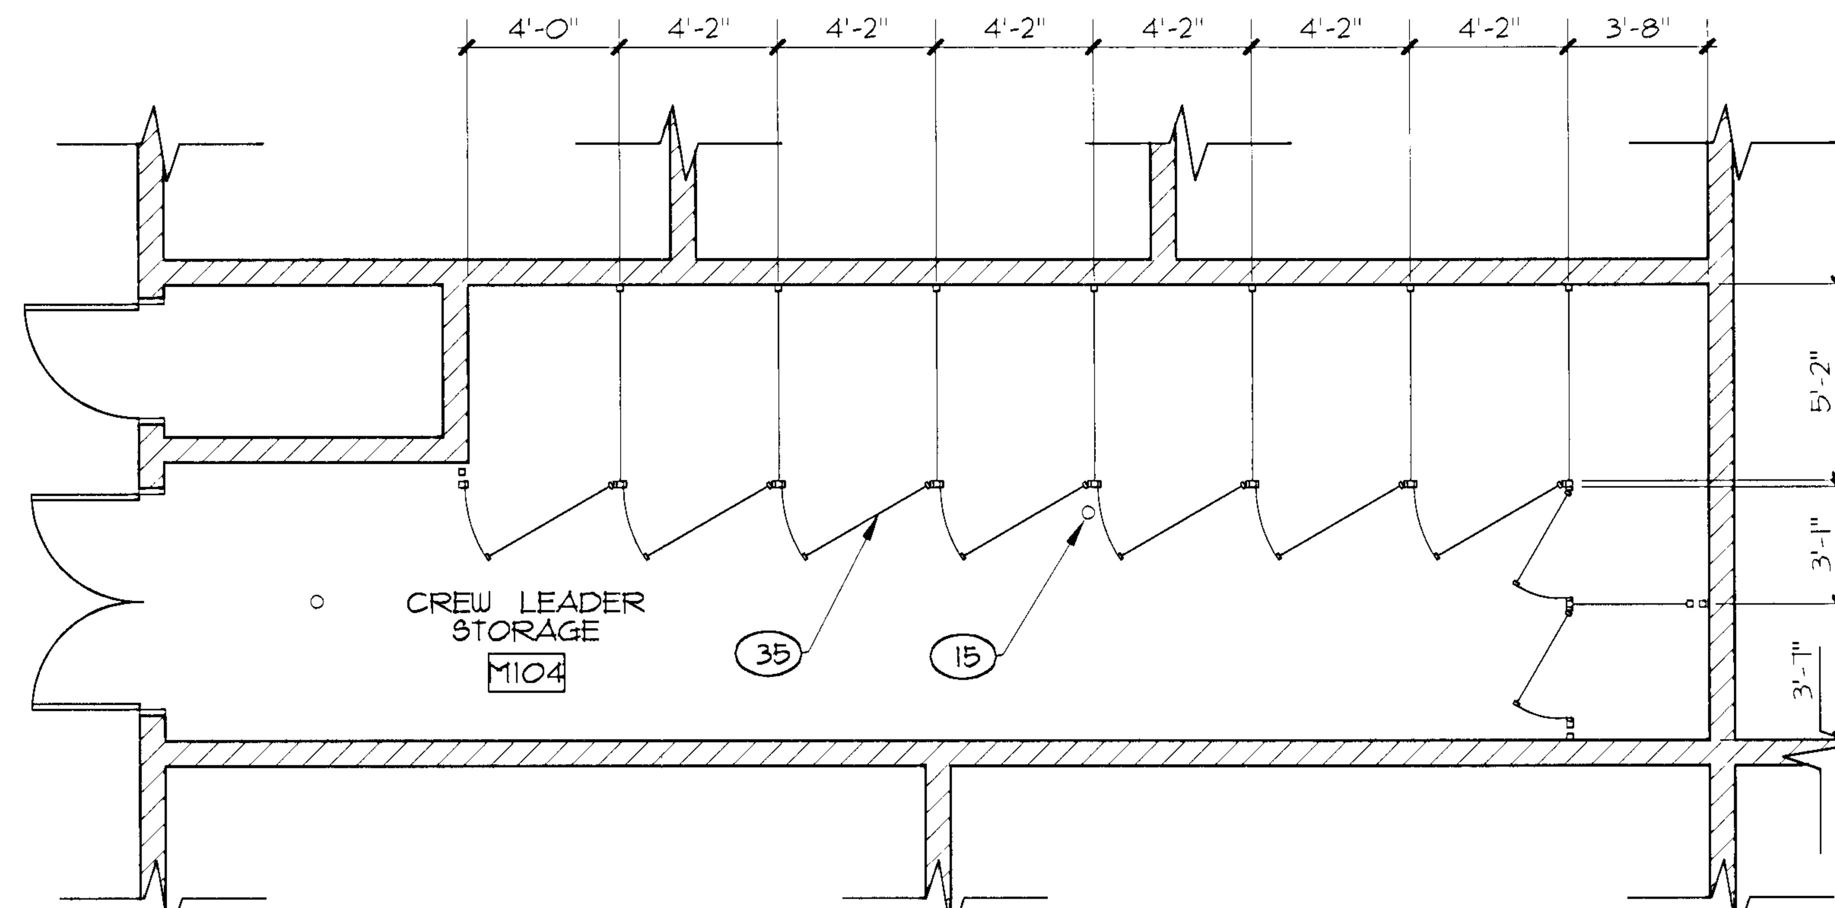

ENLARGED FLOOR PLAN (B)

SCALE: 1/4" = 1'-0"

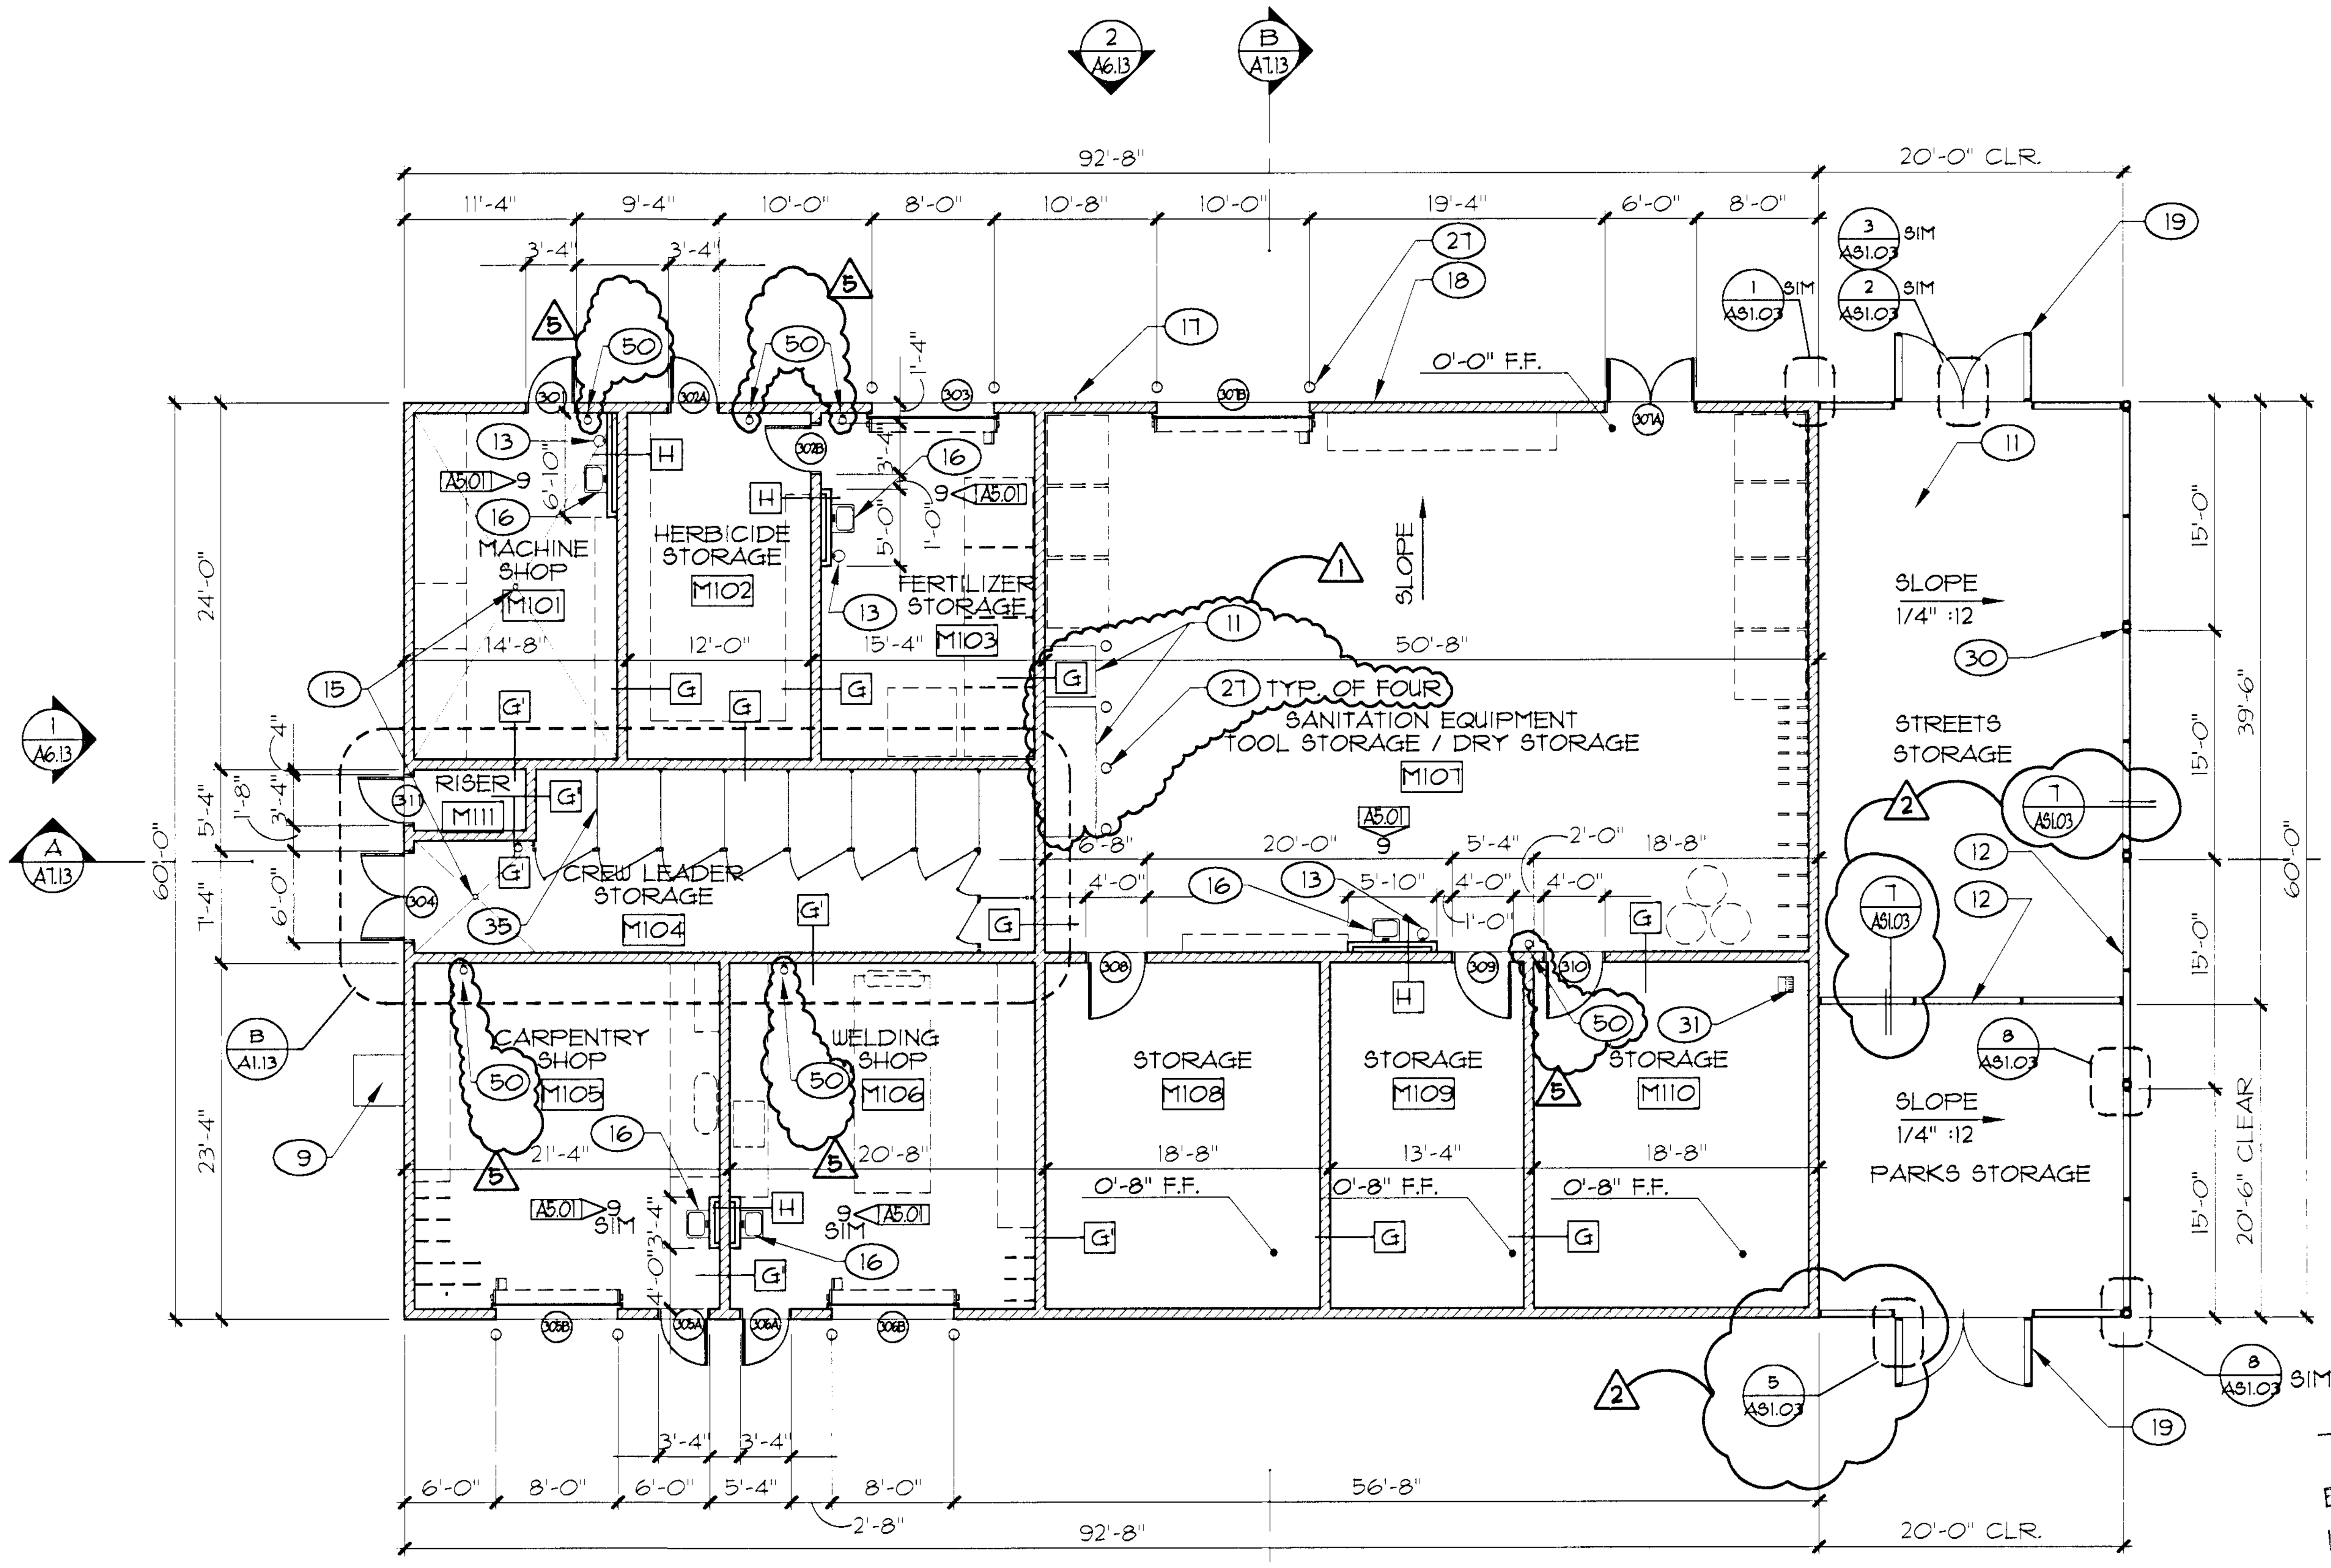

FLOOR PLAN (A)

SCALE: 1/8" = 1'-0"

584262

RECEIVED
MAR 18 2003
CITY OF LAS VEGAS PERMITS

PLANS APPROVED
ARCHITECTURAL
Building & Safety Dept
City of Las Vegas Nevada

MJF MAR 20 2003

Does Not Include Structural, Electrical, Plumbing, Mechanical or Off-Site Improvements. Make No Change Without Approval. Plan Is Not a Permit to Violate Any Ordinance

APPROVAL IS FOR CLOUDED AREAS OR LATEST REVISIONS ONLY. SEE ORIGINALS FOR OTHER REQUIREMENTS.
REVIEWED

BY ___ 4/10/03
LAS VEGAS FIRE DEPARTMENT

APPROVED
FIELD MAINT BLDG
4/11/03

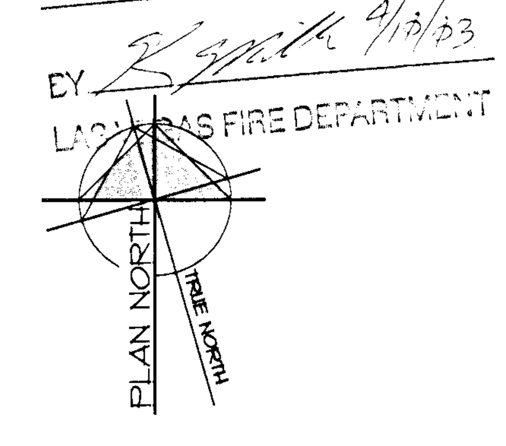

KEYNOTES

SHEETS A1.11 - A1.15

1	4' x 12' DUSTLESS WRITING SURFACE
2	WALL-MOUNTED PROJECT. SCREEN @ 9'-0" AFF
3	VENDING MACHINE (NIC)
4	ICE MACHINE (NIC)
5	LOCKERS
6	LOCKER BENCH, N.I.C.
7	CMU RETAINING WALL
8	CONCRETE LOADING DOCK
9	CONCRETE EQUIPMENT PAD
10	TRENCH DRAIN, SEE PLUMBING DRAWINGS
11	CONCRETE SLAB
12	PERFORATED STEEL PLATE SEE DETAIL 7 / AS1.03
13	EYEWASH
14	WALL-MOUNTED MOP RACK
15	FLOOR DRAIN, SEE PLUMB. DWGS.
16	WALL-MOUNTED SINK
17	HOSE BIB
18	CMU WALL
19	PERFORATED METAL GATE SEE A/AS1.03
20	EXHAUST FAN, MOUNTED IN WALL PANEL ABOVE, SEE MECH. DWGS.
21	LOCATE OWNER-FURNISHED MEMORIAL BENCH
22	CONSTRUCTION JOINT, SEE STRUCTURAL DRAWINGS
23	BOLLARD, TYP
24	METAL ROOF
25	STEEL FRAMING, SEE STRUCTURAL DRAWINGS
26	1-1/2" DIA. STEEL PIPE RAILING, PTD. (SEE A2.01 FOR COLOR), SEE ELEV.
27	8" O.D. STEEL PIPE BOLLARD, PAINTED
28	OPENING AT FLOOR LEVEL FOR TRENCH DRAIN, SEE STRUCTURAL
29	CONCRETE FOOTING, SEE STRUCT. DWGS.
30	TUBE STEEL COLUMN, PTD. SEE STRUCT. DWGS.
31	FLOOR SINK, SEE PLUMB. DWGS.
32	DRINKING FOUNTAIN, SEE PLUMB. DWGS.
33	PREFABRICATED WALL PANELS
34	REMOVE EXIST. SIDEWALK AND LANDSCAPING
35	WOVEN-WIRE PARTITIONS
36	REMOVE EXIST. STUCCO FINISH & METAL LATH TO EXPOSE EXIST. SHEATHNG
37	REMOVE EXIST. STUCCO FR/ COLUMNS, TYP. OF 4 COLUMNS TO REMAIN
38	REMOVE EXIST. CONC. TILE FROM ROOF AREA SHOWN ABOVE
39	REMOVE EXIST. STOREFRONT (NON-LOAD BEARING)
40	REMOVE EXIST. WINDOW
41	REMOVE AND RELOCATE EXIST. SITE LAMP. SEE ELEC. DWGS.
42	REMOVE EXIST. ARCHES & STUCCO SOFFIT FR/ ABOVE
43	ROOF ACCESS LADDER
49	RECESSED FIRE EXT. CAB.
50	FIRE EXT. ON BRACKET

GENERAL NOTES

1	FOR A1.11, FIELD OPERATIONS BUILDING, ALL INTERIOR PARTITIONS TO BE TYPE 'A', U.N.O.
2	FOR A1.11, FIELD OPERATIONS BUILDING, FF ELEV. +0'-0" IS EQUAL TO FF ELEV 78.5 ON CIVIL DRAWINGS
3	FOR A1.12, MATERIALS HAND. BUILDING, FF ELEV. +0'-0" IS EQUAL TO FF ELEV 70.52 ON CIVIL DRAWINGS
4	FOR A1.13, FIELD MAINT. BUILDING, FF ELEV. +0'-0" IS EQUAL TO FF ELEV 71.58 ON CIVIL DRAWINGS
5	ALL FURNISHINGS N.I.C., U.N.O.
6	SEE A2.30 FOR WALL TYPES

DEPARTMENT OF PUBLIC WORKS

CITY OF LAS VEGAS NEVADA

REVISIONS
1 08.30.02
2 10.16.02
5 03.14.03

CONSULTANT
TATE SNYDER KIMSEY ARCHITECTS
709 Valle Verde Court Henderson, Nevada 89014 ph. 702 456 3000 fax 702 898 6209
www.tatesnyderkimsey.com

CITY OF LAS VEGAS WEST SERVICE YARD
BUFFALO DRIVE AND PEAK ROAD
LAS VEGAS, NEVADA
FLOOR PLAN
FIELD MAINTENANCE BUILDING

STAMP
STEPHEN C. RANEK
REGISTERED ARCHITECT
NO. 4440
3/17/03
STATE OF NEVADA

OWNER: CITY OF LAS VEGAS
DEPARTMENT OF PUBLIC WORKS
ARCHITECTURAL SERVICES

400 EAST STEWART AVENUE
LAS VEGAS, NEVADA 89101
PHONE: (702) 229-6535
FAX: (702) 382-3232
TDD: (702) 386-9108

DRAWN	WFE
FILE	047A113
DATE	03.14.03
SCALE	1/8" = 1'-0"
BID NO	02.15341.09
CLV DWG NO	107-V3548
SHT NO	A1.13