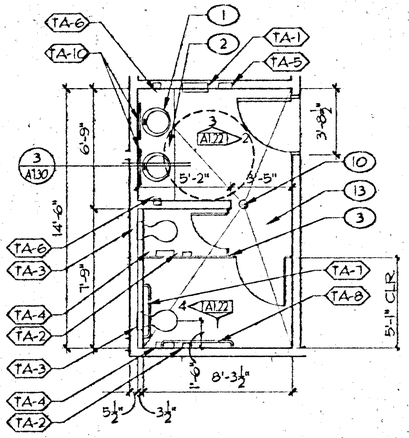

WOMEN F102

SCALE: 1/4" = 1'-0" (E)

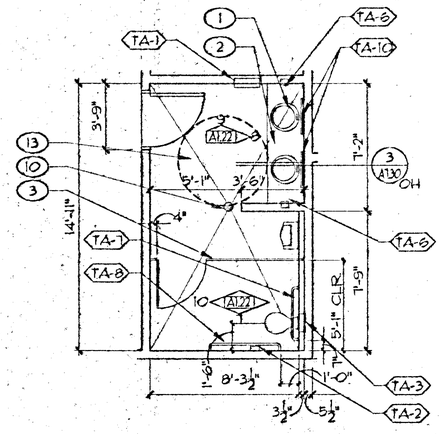

MEN F103

SCALE: 1/4" = 1'-0" (D)

TOILET ACCESSORIES SCHEDULE

ITEM	DESCRIPTION	MFR.	MFR. NO.	NORM. MTG. HGT.	H.C. MTG. HGT.
TA-1	RECESSED TOWEL DISPENSER & WASTE RECEPTACLE	BOBRICK	B-394	±10"	59 1/2"
TA-2	SURFACE TOILET TISSUE (ROLL) DISPENSER	BOBRICK	B-288	30"	28"
TA-3	RECESSED TOILET SEAT COVER DISPENSER	BOBRICK	B-301	59"	43"
TA-4	SURFACE SANITARY NAPKIN DISPOSAL	BOBRICK	B-254	33"	33"
TA-5	RECESSED NAPKIN/TAMPON VENDOR	BOBRICK	B-3500	-	50"
TA-6	SOAP DISPENSER	BOBRICK	B-306	38"	38"
TA-7	1-1/2" dia. S.S. GRAB BAR w/CONCEALED MOUNTING	BOBRICK	B-6806x36	-	34"
TA-8	1-1/2" dia. S.S. GRAB BAR w/CONCEALED MOUNTING	BOBRICK	B-6806x48	-	34"
TA-9	S.S. MOP / BROOM HOLDER	BOBRICK	B223x36	72"	
TA-10	MIRROR - SEE SPEC SECTION 08800 - GLAZING TYPE 10	CUSTOM	SEE DWG.		
TA-11	1-1/2" dia. S.S. GRAB BAR w/CONCEALED MOUNTING - 2-WALL	BOBRICK	B-6861	-	33"
TA-12	FOLDING SHOWER SEAT W/ PADDED CUSHION (RIGHT-HAND)	BOBRICK	B-517	-	19"
TA-13	FOLDING SHOWER SEAT W/ PADDED CUSHION (LEFT-HAND)	BOBRICK	B-518	-	19"
TA-14	SHOWER ROD	BOBRICK	B-207	78"	

VCT LEGEND

	VCT A - SHEET A2.01 FOR COLOR
	VCT B - SHEET A2.01 FOR COLOR
	VCT C - SHEET A2.01 FOR COLOR
	VCT D - SHEET A2.01 FOR COLOR

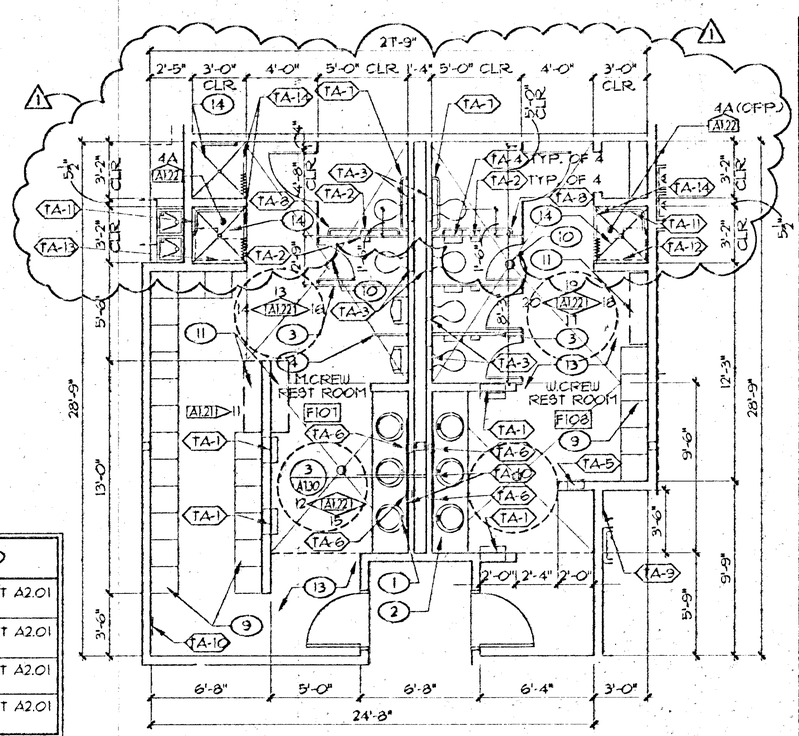

RESTROOMS F107/F108

SCALE: 1/4" = 1'-0" (B)

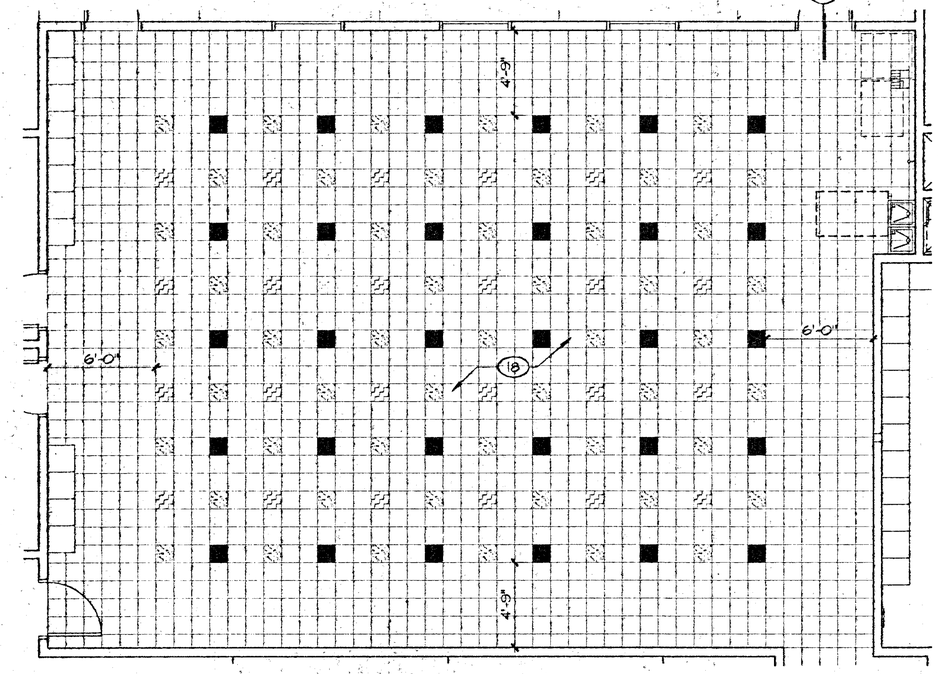

FLOOR PATTERN PLAN CREW ROOM F122

SCALE: 1/4" = 1'-0" (C)

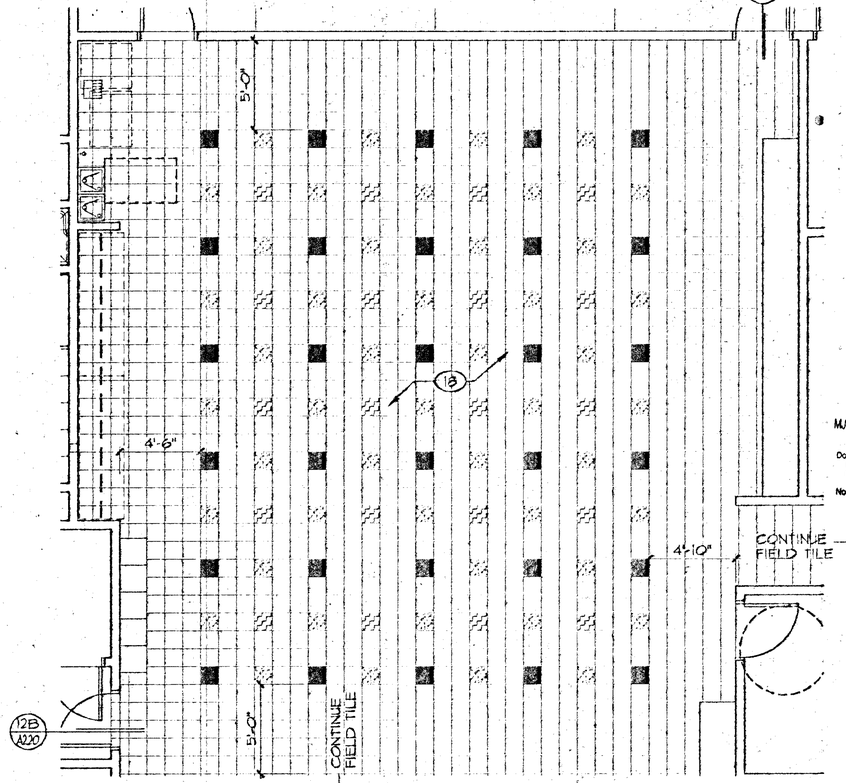

FLOOR PATTERN PLAN CREW ROOM F110

SCALE: 1/4" = 1'-0" (A)

KEYNOTES

SHEETS A1.21 - A1.22

1	LAVATORY
2	COUNTERTOP
3	TOILET PARTITION
4	URINAL DIVIDER
5	MOP SINK
6	4 x 4 CERAMIC WALL TILE
7	GFCI RECEPTACLE - SEE ELECTRICAL DRAWINGS
8	CERAMIC TILE BASE
9	LOCKERS
10	FLOOR DRAIN
11	BENCH - N.I.C.
12	SHELVING - N.I.C.
13	CERAMIC TILE OVER 3" DEPRESSED SLAB W/ A THICKSET MORTAR BED. SLOPE MORTAR BED TO DRAIN. MIN. MORTAR THICKNESS 1-½".
14	SHOWER
15	CONCRETE LOCKER BASE
16	ADA COMPLIANT P-TRAP COVER (WHITE)
17	MOP RACK
18	VINYL COMPOSITION TILE (SEE VCT LEGEND)
19	SHOWER CURTAIN ROD
20	HAND-HELD SHOWER HEAD ON 60" MIN. HOSE
21	SHOWER CONTROL MOUNTING AREA
22	PLUMBING ACCESS DOOR, PAINT TO MATCH FIELD TILE
23	WALL-HUNG TOILET, TYP.
24	ROOF ACCESS LADDER
25	GYP. BD. SOFFIT

PLANS APPROVED
ARCHITECTURAL
Building & Safety Dept.
City of Las Vegas, Nevada
By: [illegible] JAN 14 2003
Does Not Include Structural, Electrical, Plumbing/Mechanical or Off-Site Improvements Make Re-Check Without Approval Plan is Not a Permit To Violate Any Ordinance

GENERAL NOTES

1. BULLNOSE TILE TO BE USED AT ALL EXTERNAL CORNERS AND TOP
2. USE BACKER BOARD IN LIEU OF GYP. BD. IN TILE INSTALLATION LOCATIONS

RECEIVED
SEP 06 2002
CITY OF LAS VEGAS BUILDING DEPT.

CITY OF LAS VEGAS

DEPARTMENT OF PUBLIC WORKS

REVISIONS
1 083022

TATE SNYDER KIMSEY ARCHITECTS

CITY OF LAS VEGAS WEST SERVICE YARD
BUFFALO DRIVE AND PEAK ROAD
LAS VEGAS, NEVADA

ENLARGED FLOOR PLANS

STEPHEN D. RAMEY
REGISTERED
NO. 4430
2-28-03
ARCHITECT
STATE OF NEVADA

OWNER: CITY OF LAS VEGAS
DEPARTMENT OF PUBLIC WORKS
ARCHITECTURAL SERVICES

400 EAST STEWART AVENUE
LAS VEGAS, NEVADA 89101
PHONE: (702) 229-6335
FAX: (702) 382-2232
TDD: (702) 386-9108

DRAWN	JFE
JOB #	047A121
DATE	083022
SCALE	1/4" = 1'-0"
BID NO	02153403
CONTRACT NO	107-V3548
SHEET NO	A1.21