


| COLOR SCHEDULE          |                                                |
|-------------------------|------------------------------------------------|
| CARPET                  |                                                |
| A                       | C & A BATRA #24509 ANDORRA                     |
| VCT                     |                                                |
| A                       | MANNINGTON #112 FEWTER                         |
| B                       | MANNINGTON #102 STONE GRAY                     |
| C                       | MANNINGTON #208 BRICK                          |
| D                       | MANNINGTON #263 SUNFLOWER                      |
| PAINT                   |                                                |
| A                       | ICI #655 SANTA'S BEARD (FIELD)                 |
| B                       | ICI #209 CLAY POT (ACCENT)                     |
| C                       | ICI #391 PARISIAN PINK (EXTERIOR TRIM)         |
| D                       | ICI #1464 JAZZY BLUE (METAL SCREEN)            |
| PAINT COLOR LOCATION -  |                                                |
| A                       | ALL INTERIOR WALLS AND CEILINGS, U.N.O.        |
| B                       | ACCENT WALLS (REFER TO ROOM FINISH SCHEDULE)   |
| B                       | INTERIOR DOORS AND FRAMES                      |
| B                       | EXTERIOR OVERHEAD AND HOLLOW METAL DOORS       |
| LAMINATE                |                                                |
| A                       | ARBORITE #P-202 COPPER                         |
| B                       | ARBORITE #P-224 RAW STEEL                      |
| BASE                    |                                                |
| A                       | ROPPE P-198 IVORY (@CARPET)                    |
| B                       | ROPPE P-174 SMOKE (@VCT)                       |
| ACOUSTICAL CEILING TILE |                                                |
| A                       | ARMSTRONG CORTEGA ITEM #103 WHITE              |
| B                       | ARMSTRONG CORTEGA SECOND-LOOK ITEM #2161 WHITE |

| EXTERIOR MATERIAL COLORS                               |                                           |
|--------------------------------------------------------|-------------------------------------------|
| CMU                                                    |                                           |
| CMU A                                                  | SUPERLITE, PURPLE HAZE SPLIT FACE BLOCK   |
| CMU B                                                  | SUPERLITE, SEDONA RED STANDARD FACE BLOCK |
| STANDING SEAM METAL ROOF                               |                                           |
| TO MATCH FRAZEE AC13N                                  |                                           |
| EXTERIOR WALL PANEL                                    |                                           |
| TO MATCH BUTLER TEXTUREWALL PANEL WALL SYSTEM, WHITE   |                                           |
| EXTERIOR CEMENT PLASTER                                |                                           |
| A TO MATCH DRYVIT #391A PEBBLESTONE, SANDPEBBLE FINISH |                                           |
| EXTERIOR ACCENT TILE                                   |                                           |
| A DAL-TILE / QUARRY TILE CO., NATURAL HUES, GINGER 4X4 |                                           |
| GROUT: CUSTOM BUILDING PRODUCTS #384 CAMEL             |                                           |
| PIPE RAILING                                           |                                           |
| PAINT COLOR B, U.N.O. - SEE COLOR SCHEDULE ABOVE       |                                           |
| DOWNSPOUT                                              |                                           |
| PAINT COLOR B, SEE COLOR SCHEDULE ABOVE                |                                           |
| TUBE STEEL (EXPOSED)                                   |                                           |
| PAINT COLOR D, U.N.O. - SEE COLOR SCHEDULE ABOVE       |                                           |
| PERFORATED METAL SCREEN / FENCE                        |                                           |
| PAINT COLOR D, SEE COLOR SCHEDULE ABOVE                |                                           |

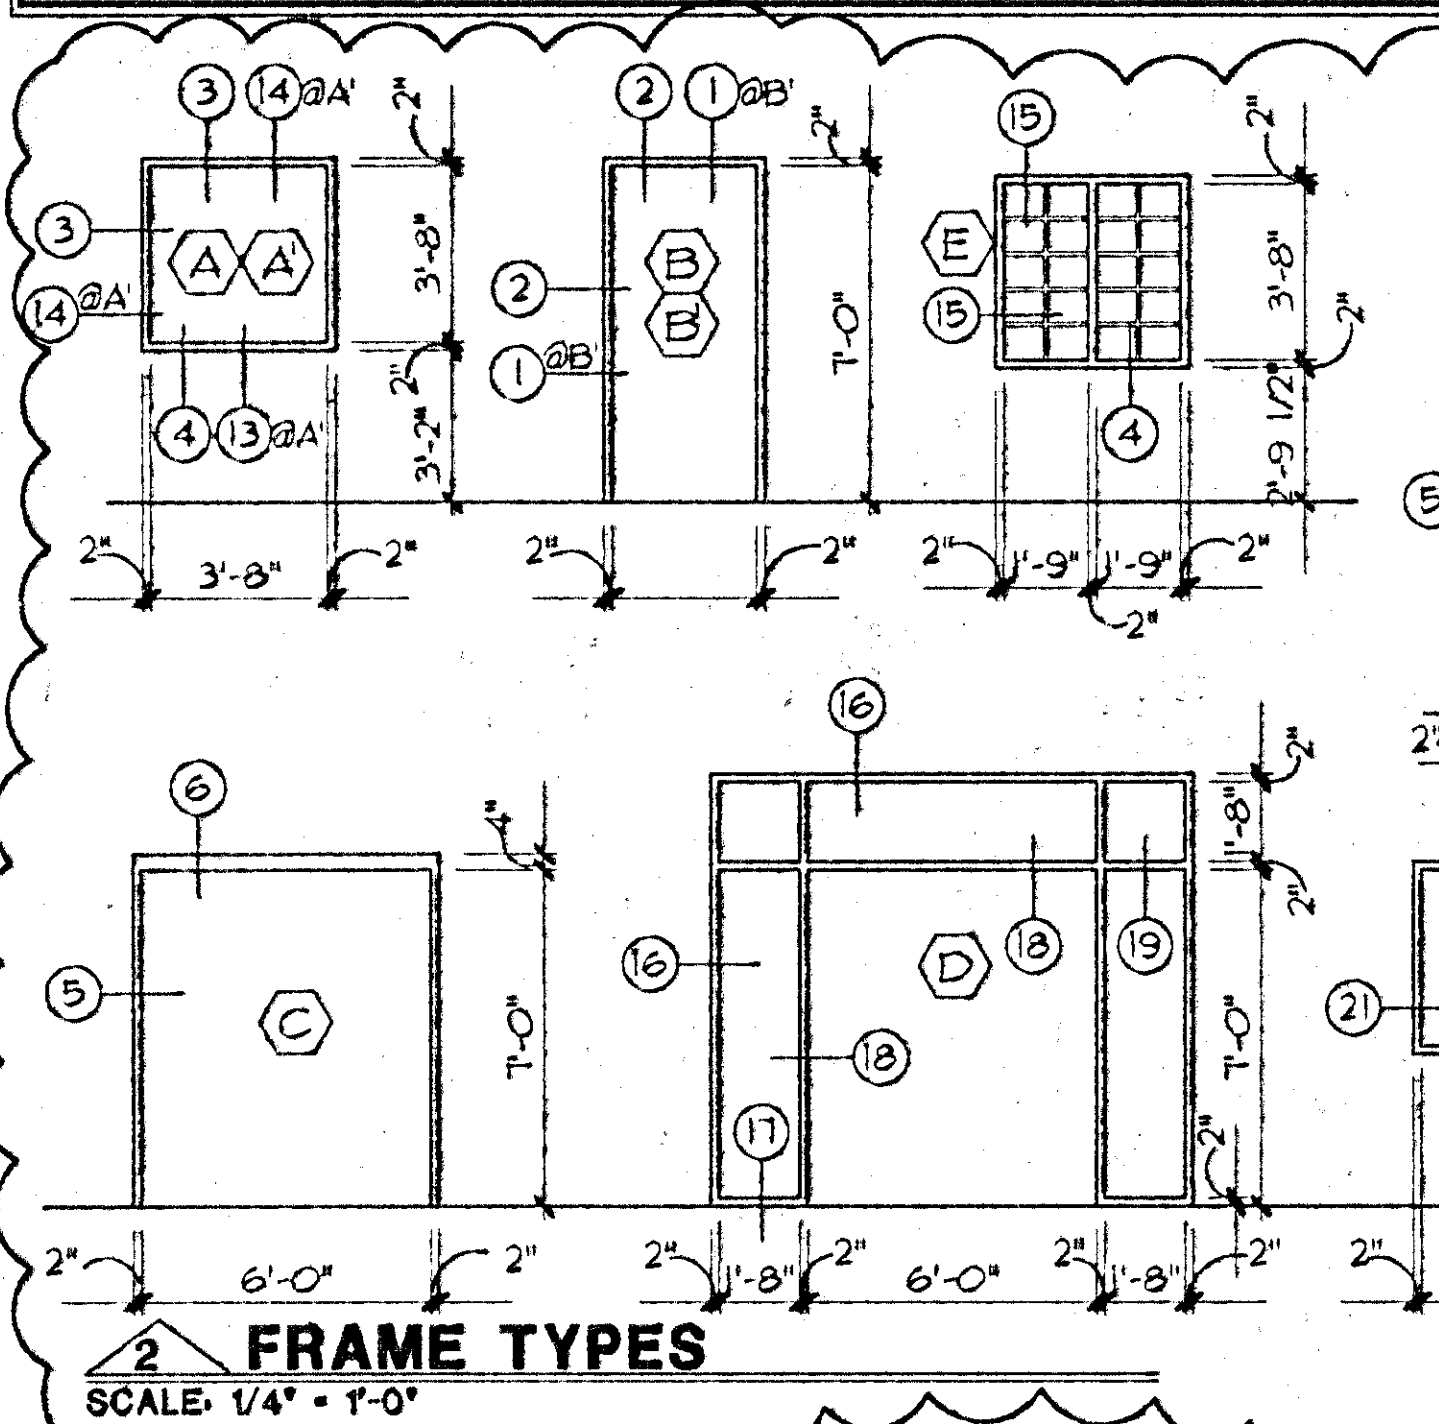

| ROOM FINISH SCHEDULE                                                      |                                    |          |      |          |         |       |       |       |       |                                               |
|---------------------------------------------------------------------------|------------------------------------|----------|------|----------|---------|-------|-------|-------|-------|-----------------------------------------------|
| RM.NO.                                                                    | ROOM NAME                          | FLOORING |      | CEILING  |         | WALLS |       |       |       | REMARKS                                       |
|                                                                           |                                    | MATERIAL | BASE | MATERIAL | HEIGHT  | N     | E     | S     | W     |                                               |
| FIELD OPERATIONS BUILDING (F)                                             |                                    |          |      |          |         |       |       |       |       |                                               |
| F101                                                                      | RECEPTION                          | 1        | 1A   | 1B/2A    | VARIES  | 1A    | 1A    | 1A    | 1A    |                                               |
| F102                                                                      | WOMENS' RESTROOM                   | 3*       | 2*   | 2A       | 9'-0"   | 1A/3* | 1A/3* | 1A/3* | 1A/3* | *SEE A1.21 & A1.22 FOR TILE COLORS & PATTERNS |
| F103                                                                      | MENS' RESTROOM                     | 3*       | 2*   | 2A       | 9'-0"   | 1A/3* | 1A/3* | 1A/3* | 1A/3* |                                               |
| F104                                                                      | CONFERENCE                         | 1A       | 1A   | 1B/2A    | VARIES  | 1A    | 1A    | 1A    | 1A    |                                               |
| F105                                                                      | HALL                               | 1A       | 1A   | 1A       | 9'-0"   | 1A    | 1A    | 1A    | 1A    |                                               |
| F106                                                                      | CUSTODIAN'S CLOSET                 | 2A       | 1B   | 2A       | 9'-0"   | 1A/3* | 1A    | 1A    | 1A/3* | *SEE A1.21 & A1.22 FOR TILE COLORS & PATTERNS |
| F107                                                                      | MENS' CREW RR                      | 3*       | 2*   | 2A       | VARIES  | 1A/3* | 1A/3* | 1A/3* | 1A/3* |                                               |
| F108                                                                      | WOMENS' CREW RR                    | 3*       | 2*   | 2A       | VARIES  | 1A/3* | 1A/3* | 1A/3* | 1A/3* |                                               |
| F109                                                                      | IT ROOM                            | 2A       | 1B   | 1A       | 10'-0"  | 1A    | 1A    | 1A    | 1A    |                                               |
| F110                                                                      | CREW ROOM                          | 2*       | 1B   | 1A/2A    | VARIES  | 1A    | 1A    | 1A    | 1A    | *SEE A1.22, VCT PATTERN                       |
| F111                                                                      | MECHANICAL CLOSET                  | 4        | -    | 3        | 11'-10" | 4     | 4     | 4     | 4     |                                               |
| F112                                                                      | HAND TOOLS                         | 4        | -    | 3        | 11'-10" | 4     | 4     | 4     | 4     |                                               |
| F113                                                                      | RECORD STORAGE                     | 2A       | 1B   | 1A       | 9'-0"   | 1A    | 1A    | 1A    | 1A    |                                               |
| F114                                                                      | FIELD SUPERVISOR                   | 1A       | 1A   | 1A       | 9'-0"   | 1A    | 1A    | 1A    | 1A    |                                               |
| F115                                                                      | FIELD SUPERVISOR                   | 1A       | 1A   | 1A       | 9'-0"   | 1A    | 1A    | 1A    | 1A    |                                               |
| F116                                                                      | FIELD SUPERVISOR                   | 1A       | 1A   | 1A       | 9'-0"   | 1A    | 1A    | 1A    | 1A    |                                               |
| F117                                                                      | HALL                               | 1A       | 1A   | 1A/2A    | VARIES  | 1A    | 1A    | 1A    | 1A    |                                               |
| F118                                                                      | ANALYST                            | 1A       | 1A   | 1A       | 9'-0"   | 1A    | 1A    | 1A    | 1A    |                                               |
| F119                                                                      | DIVISION MANAGER                   | 1A       | 1A   | 1A       | 9'-0"   | 1A    | 1A    | 1A    | 1A    |                                               |
| F120                                                                      | WATER TECHNICIAN                   | 1A       | 1A   | 1A       | 9'-0"   | 1A    | 1A    | 1A    | 1A    |                                               |
| F121                                                                      | SECRETARY                          | 1A       | 1A   | 1A       | 10'-0"  | -     | 1A    | 1A    | 1A    |                                               |
| F122                                                                      | CREW ROOM                          | 2*       | 1B   | 1A/2A    | VARIES  | 1A    | 1A    | 1A    | 1A    | *SEE A1.22, VCT PATTERN                       |
| F123                                                                      | SANITATION                         | 4        | -    | 2A       | 9'-0"   | 1A    | 1A    | 1A    | 1A    |                                               |
| F124                                                                      | STREETS REHAB                      | 4        | -    | 2A       | 9'-0"   | 1A    | 1A    | 1A    | 1A    |                                               |
| F125                                                                      | OFFICE                             | 1A       | 1A   | 1A       | 10'-0"  | 1A    | 1A    | 1A    | 1A    |                                               |
| F126                                                                      | FIELD SUPERVISOR                   | 1A       | 1A   | 1A       | 9'-0"   | 1A    | 1A    | 1A    | 1A    |                                               |
| F127                                                                      | FIELD SUPERVISOR                   | 1A       | 1A   | 1A       | 9'-0"   | 1A    | 1A    | 1A    | 1A    |                                               |
| F128                                                                      | FIELD SUPERVISOR                   | 1A       | 1A   | 1A       | 9'-0"   | 1A    | 1A    | 1A    | 1A    |                                               |
| F129                                                                      | FIELD SUPERVISOR                   | 1A       | 1A   | 1A       | 9'-0"   | 1A    | 1A    | 1A    | 1A    |                                               |
| F130                                                                      | RECORD STORAGE                     | 2A       | 1B   | 1A       | 9'-0"   | 1A    | 1A    | 1A    | 1A    |                                               |
| F131                                                                      | S&S ANALYST                        | 1A       | 1A   | 1A       | 9'-0"   | 1A    | 1A    | 1A    | 1A    |                                               |
| F132                                                                      | S&S DIV. MANAGER                   | 1A       | 1A   | 1A       | 9'-0"   | 1A    | 1A    | 1A    | 1A    |                                               |
| F133                                                                      | S&S SUPERVISOR                     | 1A       | 1A   | 1A       | 9'-0"   | 1A    | 1A    | 1A    | 1A    |                                               |
| F134                                                                      | ADMIN. BREAK ROOM                  | 1A       | 1A   | 1A       | 9'-0"   | 1A    | 1A    | 1A    | 1A    |                                               |
| F135                                                                      | SECRETARY                          | 1A       | 1A   | 1A       | 10'-0"  | -     | 1A    | 1A    | 1A    |                                               |
| F136                                                                      | HALL                               | 1A       | 1A   | 1A       | 10'-0"  | 1A    | 1A    | 1A    | -     |                                               |
| F137                                                                      | COPY                               | 1A       | 1A   | 1A/2A    | VARIES  | 1A    | 1A    | 1A    | 1A    |                                               |
| F138                                                                      | HALL                               | 1A       | 1A   | 1A       | 10'-0"  | 1A    | 1A    | 1A    | 1A    |                                               |
| F139                                                                      | HALL                               | 2A       | 1B   | 1A       | 10'-0"  | 1A    | 1A    | 1A    | -     |                                               |
| MATERIALS HANDLING CENTER (H)                                             |                                    |          |      |          |         |       |       |       |       |                                               |
| H101                                                                      | HANDLING CENTER                    | 4        | -    | -        | @STR.   | 2     | 2     | 2     | 2     |                                               |
| H102                                                                      | RISER ROOM                         | 4        | -    | 4        | 8'-0"   | 2     | 2     | 2     | 2     |                                               |
| FIELD MAINTENANCE BUILDING (M)                                            |                                    |          |      |          |         |       |       |       |       |                                               |
| M101                                                                      | MACHINE SHOP                       | 4        | -    | 1A       | 16'-0"  | 2     | 2/1A  | 2     | 2     |                                               |
| M102                                                                      | HERBICIDE STORAGE                  | 4        | -    | -        | @STR.   | 2     | 2     | 2     | 2     |                                               |
| M103                                                                      | FERTILIZER STORAGE                 | 4        | -    | -        | @STR.   | 2     | 2     | 2     | 2/1A  |                                               |
| M104                                                                      | CREW LEADER STOR.                  | 4        | -    | -        | @STR.   | 2     | 2     | 2     | 2     |                                               |
| M105                                                                      | CARPENTRY SHOP                     | 4        | -    | 1A       | 16'-0"  | 2     | 2/1A  | 2     | 2     |                                               |
| M106                                                                      | WELDING SHOP                       | 4        | -    | 1A       | 16'-0"  | 2     | 2     | 2     | 2/1A  |                                               |
| M107                                                                      | SANITATION EQUIP./TOOL / DRY STOR. | 4        | -    | -        | @STR.   | 2     | 2     | 2/1A  | 2     |                                               |
| M108                                                                      | STORAGE                            | 4        | -    | -        | @STR.   | 2     | 2     | 2     | 2     |                                               |
| M109                                                                      | STORAGE                            | 4        | -    | -        | @STR.   | 2     | 2     | 2     | 2     |                                               |
| M110                                                                      | STORAGE                            | 4        | -    | -        | @STR.   | 2     | 2     | 2     | 2     |                                               |
| M111                                                                      | RISER ROOM                         | 4        | -    | -        | @STR.   | 2     | 2     | 2     | 2     |                                               |
| IT CONTINGENCY ADDITION (A)                                               |                                    |          |      |          |         |       |       |       |       |                                               |
| A101                                                                      | OFFICE                             | 1A       | 1A   | 1A       | 9'-0"   | 1A    | 1A    | 1A    | 1A    |                                               |
| A102                                                                      | OFFICE                             | 1A       | 1A   | 1A       | 9'-0"   | 1A    | 1A    | 1A    | 1A    |                                               |
| A103                                                                      | OFFICE                             | 1A       | 1A   | 1A       | 9'-0"   | 1A    | 1A    | 1A    | 1A    |                                               |
| A104                                                                      | IT CONTINGENCY RM.                 | 2        | 1B   | 1A       | 9'-0"   | 1A    | 1A    | 1A    | 1A    |                                               |
| A105                                                                      | CORRIDOR                           | 1A       | 1A   | 1A       | 8'-0"   | 1A    | 1A    | 1A    | 1A    |                                               |
| **GENERAL NOTE : SEE SHEETS A1.21 AND A1.22 FOR FLOOR AND WALL PATTERNS** |                                    |          |      |          |         |       |       |       |       |                                               |

\*\*GENERAL NOTE: SEE SHEETS A1.21 AND A1.22 FOR FLOOR AND WALL PATTERNS\*\*

| LEGEND  |                         |
|---------|-------------------------|
| SYMBOL  | DESCRIPTION             |
| FLOOR   |                         |
| 1       | CARPET                  |
| 2       | VINYL COMPOSITION TILE  |
| 3       | CERAMIC TILE            |
| 4       | SEALED CONCRETE         |
| BASE    |                         |
| 1       | RUBBER BASE             |
| 2       | CERAMIC TILE            |
| CEILING |                         |
| 1       | ACOUSTICAL CEILING TILE |
| 2       | PAINTED GYPSUM BOARD    |
| 3       | GYPSUM BOARD            |
| 4       | OPEN TO STRUCTURE       |
| WALLS   |                         |
| 1       | PAINTED GYPSUM BOARD    |
| 2       | CONCRETE MASONRY UNIT   |
| 3       | CERAMIC TILE            |
| 4       | GYPSUM BOARD            |

| DOOR SCHEDULE                  |         |           |        |        |      |       |       |      |      |      |      |      |         |   |
|--------------------------------|---------|-----------|--------|--------|------|-------|-------|------|------|------|------|------|---------|---|
| DR. NO.                        | RM. NO. | DOOR      |        |        | TYPE | MAT'L | FRAME |      |      |      |      |      | REMARKS |   |
|                                |         | SIZE      |        |        |      |       | MAT'L | HEAD | JAMB | JAMB | TYPE | HOWL |         | LABEL   |
| W                              | H       | T         |        |        |      |       |       |      |      |      |      |      |         |   |
| FIELD OPERATIONS BUILDING (F)  |         |           |        |        |      |       |       |      |      |      |      |      |         |   |
| 101A                           | F101    | PR. 3'-0" | 7'-0"  | 1-3/4" | C    | AL.   | AL.   | 18   | 18   | 18   | D    | 1    | -       |   |
| 101B                           | F101    | 3'-0"     | 7'-0"  | 1-3/4" | D    | WD.   | H.M.  | 2    | 2    | 2    | B    | 11   | -       |   |
| 101C                           | F101    | 3'-0"     | 7'-0"  | 1-3/4" | D    | WD.   | H.M.  | 2    | 2    | 2    | B    | 11   | -       |   |
| 102                            | F102    | 3'-0"     | 7'-0"  | 1-3/4" | D    | WD.   | H.M.  | 2    | 2    | 2    | B    | 12   | -       |   |
| 103                            | F103    | 3'-0"     | 7'-0"  | 1-3/4" | D    | WD.   | H.M.  | 2    | 2    | 2    | B    | 12   | -       |   |
| 104A                           | F104    | 3'-0"     | 7'-0"  | 1-3/4" | D    | WD.   | H.M.  | 2    | 2    | 2    | B    | 13   | -       |   |
| 104B                           | F104    | 3'-0"     | 7'-0"  | 1-3/4" | D    | WD.   | H.M.  | 2    | 2    | 2    | B    | 13   | -       |   |
| 105A                           | F105    | 3'-0"     | 7'-0"  | 1-3/4" | D    | WD.   | H.M.  | 2    | 2    | 2    | B    | 14   | -       |   |
| 105B                           | F105    | 3'-0"     | 7'-0"  | 1-3/4" | D    | WD.   | H.M.  | 2    | 2    | 2    | B    | 12   | -       |   |
| 105C                           | F105    | 3'-0"     | 7'-0"  | 1-3/4" | D    | WD.   | H.M.  | 2    | 2    | 2    | B    | 12   | -       |   |
| 106                            | F106    | 3'-0"     | 7'-0"  | 1-3/4" | D    | WD.   | H.M.  | 2    | 2    | 2    | B    | 15   | -       |   |
| 107                            | F107    | 3'-0"     | 7'-0"  | 1-3/4" | D    | WD.   | H.M.  | 2    | 2    | 2    | B    | 12   | -       |   |
| 108                            | F108    | 3'-0"     | 7'-0"  | 1-3/4" | D    | WD.   | H.M.  | 2    | 2    | 2    | B    | 12   | -       |   |
| 109                            | F109    | 3'-0"     | 7'-0"  | 1-3/4" | A    | H.M.  | H.M.  | 1    | 1    | 1    | B1   | 4    | -       |   |
| 110A                           | F110    | 3'-0"     | 7'-0"  | 1-3/4" | D    | WD.   | H.M.  | 2    | 2    | 2    | B    | 14   | -       |   |
| 110B                           | F110    | 3'-0"     | 7'-0"  | 1-3/4" | E    | WD.   | H.M.  | 2    | 2    | 2    | B    | 16   | -       | DUTCH DOOR   |
| 110C                           | F110    | 3'-0"     | 7'-0"  | 1-3/4" | A    | H.M.  | H.M.  | 1    | 1    | 1    | B1   | 5    | -       |   |
| 110D                           | F110    | 3'-0"     | 7'-0"  | 1-3/4" | A    | H.M.  | H.M.  | 1    | 1    | 1    | B1   | 5    | -       |   |
| 111                            | F111    | 3'-0"     | 7'-0"  | 1-3/4" | A    | H.M.  | H.M.  | 1    | 1    | 1    | B1   | 6    | -       |   |
| 112A                           | F112    | 3'-0"     | 7'-0"  | 1-3/4" | A    | H.M.  | H.M.  | 2    | 2    | 2    | B    | 15   | -       |   |
| 112B                           | F112    | 3'-0"     | 7'-0"  | 1-3/4" | D    | H.M.  | H.M.  | 1    | 1    | 1    | B1   | 7    | -       |   |
| 113                            | F113    | 3'-0"     | 7'-0"  | 1-3/4" | A    | WD.   | H.M.  | 2    | 2    | 2    | B    | 15   | -       |   |
| 114                            | F114    | 3'-0"     | 7'-0"  | 1-3/4" | D    | WD.   | H.M.  | 2    | 2    | 2    | B    | 13   | -       |   |
| 115                            | F115    | 3'-0"     | 7'-0"  | 1-3/4" | D    | WD.   | H.M.  | 2    | 2    | 2    | B    | 13   | -       |   |
| 116                            | F116    | 3'-0"     | 7'-0"  | 1-3/4" | D    | WD.   | H.M.  | 2    | 2    | 2    | B    | 13   | -       |   |
| 117                            | F117    | 3'-0"     | 7'-0"  | 1-3/4" | A    | H.M.  | H.M.  | 1    | 1    | 1    | B1   | 7    | -       |   |
| 118                            | F118    | 3'-0"     | 7'-0"  | 1-3/4" | D    | WD.   | H.M.  | 2    | 2    | 2    | B    | 13   | -       |   |
| 119                            | F119    | 3'-0"     | 7'-0"  | 1-3/4" | D    | WD.   | H.M.  | 2    | 2    | 2    | B    | 13   | -       |   |
| 120                            | F120    | 3'-0"     | 7'-0"  | 1-3/4" | D    | WD.   | H.M.  | 2    | 2    | 2    | B    | 13   | -       |   |
| 122A                           | F122    | 3'-0"     | 7'-0"  | 1-3/4" | D    | WD.   | H.M.  | 2    | 2    | 2    | B    | 14   | -       |   |
| 122B                           | F122    | 3'-0"     | 7'-0"  | 1-3/4" | A    | H.M.  | H.M.  | 1    | 1    | 1    | B1   | 7    | -       |   |
| 122C                           | F122    | 3'-0"     | 7'-0"  | 1-3/4" | A    | H.M.  | H.M.  | 1    | 1    | 1    | B1   | 7    | -       |   |
| 123                            | F123    | 3'-0"     | 7'-0"  | 1-3/4" | A    | H.M.  | H.M.  | 2    | 2    | 2    | B    | 17   | -       |   |
| 124A                           | F124    | 3'-0"     | 7'-0"  | 1-3/4" | A    | H.M.  | H.M.  | 2    | 2    | 2    | B    | 17   | -       |   |
| 124B                           | F124    | 3'-0"     | 7'-0"  | 1-3/4" | D    | WD.   | H.M.  | 2    | 2    | 2    | B    | 17   | -       |   |
| 125A                           | F125    | 3'-0"     | 7'-0"  | 1-3/4" | B    | H.M.  | H.M.  | 1    | 1    | 1    | B1   | 7    | -       |   |
| 125B                           | F125    | 3'-0"     | 7'-0"  | 1-3/4" | B    | H.M.  | H.M.  | 1    | 1    | 1    | B1   | 7    | -       |   |
| 126                            | F126    | 3'-0"     | 7'-0"  | 1-3/4" | D    | WD.   | H.M.  | 2    | 2    | 2    | B    | 13   | -       |   |
| 127                            | F127    | 3'-0"     | 7'-0"  | 1-3/4" | D    | WD.   | H.M.  | 2    | 2    | 2    | B    | 13   | -       |   |
| 128                            | F128    | 3'-0"     | 7'-0"  | 1-3/4" | D    | WD.   | H.M.  | 2    | 2    | 2    | B    | 13   | -       |   |
| 129                            | F129    | 3'-0"     | 7'-0"  | 1-3/4" | D    | WD.   | H.M.  | 2    | 2    | 2    | B    | 13   | -       |   |
| 130                            | F130    | 3'-0"     | 7'-0"  | 1-3/4" | D    | WD.   | H.M.  | 2    | 2    | 2    | B    | 15   | -       |   |
| 131                            | F131    | 3'-0"     | 7'-0"  | 1-3/4" | D    | WD.   | H.M.  | 2    | 2    | 2    | B    | 13   | -       |   |
| 132                            | F132    | 3'-0"     | 7'-0"  | 1-3/4" | D    | WD.   | H.M.  | 2    | 2    | 2    | B    | 13   | -       |   |
| 133                            | F133    | 3'-0"     | 7'-0"  | 1-3/4" | D    | WD.   | H.M.  | 2    | 2    | 2    | B    | 13   | -       |   |
| 134A                           | F134    | 3'-0"     | 7'-0"  | 1-3/4" | D    | WD.   | H.M.  | 2    | 2    | 2    | B    | 12   | -       |   |
| 134B                           | F134    | 3'-0"     | 7'-0"  | 1-3/4" | A    | H.M.  | H.M.  | 1    | 1    | 1    | B1   | 8    | -       |   |
| MATERIALS HANDLING CENTER (H)  |         |           |        |        |      |       |       |      |      |      |      |      |         |   |
| 202                            | H102    | 3'-0"     | 7'-0"  | 1-3/4" | A    | H.M.  | H.M.  | 6    | 5    | 5    | G    | 9    | -       |   |
| 201A                           | H101    | 3'-0"     | 7'-0"  | 1-3/4" | A    | H.M.  | H.M.  | 6    | 5    | 5    | G    | 7    | -       |   |
| 201B                           | H101    | 3'-0"     | 7'-0"  | 1-3/4" | A    | H.M.  | H.M.  | 6    | 5    | 5    | G    | 7    | -       |   |
| 201C                           | H101    | 20'-0"    | 22'-0" | -      | G    | STL.  | STL.  | 9    | 7/8  | 7/8  | -    | 19   | -       |   |
| 201D                           | H101    | 20'-0"    | 22'-0" | -      | G    | STL.  | STL.  | 9    | 7/8  | 7/8  | -    | 19   | -       |   |
| 201E                           | H101    | 20'-0"    | 22'-0" | -      | G    | STL.  | STL.  | 9    | 7/8  | 7/8  | -    | 19   | -       |   |
| FIELD MAINTENANCE BUILDING (M) |         |           |        |        |      |       |       |      |      |      |      |      |         |   |
| 301                            | M101    | 3'-0"     | 7'-0"  | 1-3/4" | A    | H.M.  | H.M.  | 6    | 5    | 5    | G    | 8    | -       |   |
| 302A                           | M102    | 3'-0"     | 7'-0"  | 1-3/4" | A    | H.M.  | H.M.  | 6    | 5    | 5    | G    | 9    | -       |   |
| 302B                           | M102    | 3'-0"     | 7'-0"  | 1-3/4" | A    | H.M.  | H.M.  | 6    | 5    | 5    | G    | 15   | -       |   |
| 303                            | M103    | 8'-0"     | 10'-0" | -      | H    | STL.  | STL.  | 11   | 10   | 10   | -    | 19   | -       |   |
| 304                            | M104    | PR. 3'-0" | 7'-0"  | 1-3/4" | F    | H.M.  | H.M.  | 6    | 5    | 5    | C1   | 2    | -       | DUTCH DOOR (LEAF)   |
| 305A                           | M105    | 3'-0"     | 7'-0"  | 1-3/4" | A    | H.M.  | H.M.  | 6    | 5    | 5    | G    | 8    | -       |   |
| 305B                           | M105    | 8'-0"     | 10'-0" | -      | H    | STL.  | STL.  | 11   | 10   | 10   | -    | 19   | -       |   |
| 306A                           | M106    | 3'-0"     | 7'-0"  | 1-3/4" | A    | H.M.  | H.M.  | 6    | 5    | 5    | G    | 8    | -       |   |
| 306B                           | M106    | 8'-0"     | 10'-0" | -      | H    | STL.  | STL.  | 11   | 10   | 10   | -    | 19   | -       |   |
| 307A                           | M107    | PR. 3'-0" | 7'-0"  | 1-3/4" | F    | H.M.  | H.M.  | 6    | 5    | 5    | C1   | 3    | -       | DUTCH DOOR (LEAF)   |
| 307B                           | M107    | 10'-0"    | 10'-0" | -      | H    | STL.  | STL.  | 11   | 10   | 10   | -    | 19   | -       |   |
| 308                            | M108    | 3'-8"     | 7'-0"  | 1-3/4" | A    | H.M.  | H.M.  | 6    | 5    | 5    | G    | 18   | -       |   |
| 309                            | M109    | 3'-8"     | 7'-0"  | 1-3/4" | A    | H.M.  | H.M.  | 6    | 5    | 5    | G    | 18   | -       |   |
| 310                            | M110    | 3'-8"     | 7'-0"  | 1-3/4" | A    | H.M.  | H.M.  | 6    | 5    | 5    | G    | 18   | -       |   |
| 311                            | M111    | 3'-0"     | 7'-0"  | 1-3/4" | A    | H.M.  | H.M.  | 6    | 5    | 5    | G    | 9    | -       |   |
| IT CONTINGENCY (ADDITION (A))  |         |           |        |        |      |       |       |      |      |      |      |      |         |   |
| 401                            | A101    | 3'-0"     | 7'-0"  | 1-3/4" | A    | WD.   | H.M.  | 2    | 2    | 2    | B    | 13   | -       | PLANS APPROVED<br>ARCHITECTURAL<br>Building & Safety Dept.<br>City of Las Vegas, NV/06/08<br><br>MUH JAN 14 2003<br><br>Does Not Include Structural, Electrical,<br>Plumbing/Mechanical or Civil<br>Improvements Make No Change<br>Without Approval. Plans are<br>Not a Permit to Violate Any Code/Ordinance |
| 402                            | A102    | 3'-0"     | 7'-0"  | 1-3/4" | A    | WD.   | H.M.  | 2    | 2    | 2    | B    | 13   | -       |   |
| 403                            | A103    | 3'-0"     | 7'-0"  | 1-3/4" | A    | WD.   | H.M.  | 2    | 2    | 2    | B    | 13   | -       |   |
| 404A                           | A104    | 3'-0"     | 7'-0"  | 1-3/4" | A    | WD.   | H.M.  | 2    | 2    | 2    | B    | 14   | -       |   |
| 404B                           | A104    | 3'-0"     | 7'-0"  | 1-3/4" | A    | WD.   | H.M.  | 1    | 1    | 1    | B1   | 10   | -       |   |
| 405A                           | A105    | 3'-0"     | 7'-0"  | 1-3/4" | A    | WD.   | H.M.  | 2    | 2    | 2    | B    | 11   | 1HR     |   |
| 405B                           | A105    | 3'-0"     | 7'-0"  | 1-3/4" | A    | WD.   | H.M.  | 1    | 1    | 1    | B1   | 8    | -       |   |
| RECEIVED                       |         |           |        |        |      |       |       |      |      |      |      |      |         |   |
| SEP 06 2002                    |         |           |        |        |      |       |       |      |      |      |      |      |         |   |