


ROOF PLAN
SCALE: 1/8" = 1'-0"

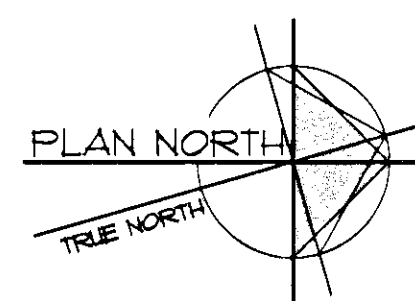

KEYNOTES
SHEETS A4.11 -A4.14

- 1 STANDING SEAM METAL ROOF
- 2 CONCRETE TILE ROOF
- 3 SINGLE PLY ROOFING
- 4 DOWN SPOUT
- 5 ROOF DRAIN
- 6 WALL BELOW SHOWN DASHED
- 7 TUBE STEEL SHADE STRUCTURE, PTD. COLOR. B SEE 1/A1.30
- 8 STEEL DECK, PAINTED
- 9 METAL FASCIA PANEL
- 10 ROOF PARAPET WALL
- 11 GUTTER
- 12 TAPERED RIGID INSULATION CRICKET
- 13 EXHAUST FAN - SEE MECHANICAL DRAWINGS
- 14 HVAC UNIT - SEE MECHANICAL DRAWINGS
- 15 EVAPORATIVE COOLER, & CURB, SEE MECH. DWGS.
- 16 METAL ROOF
- 17 4' x 8' TRANSLUCENT PANELS BY BLDG. MANUFACTURER, TYP. OF 16
- 18 ROOF ACCESS HATCH
- 19 TRAFFIC PAD, TYP.
- 20 ROOF VENT



REVISIONS
1 08.30.02
B 03.14.03

CONSULTANT
TATE SNYDER KIMSEY
ARCHITECTS
2000 Valley View Court, Henderson, Nevada 89015
PH: (702) 405-8000
FAX: (702) 405-8000
WWW.TSKARCHITECTS.COM

DEPARTMENT OF PUBLIC WORKS
CITY OF LAS VEGAS WEST SERVICE YARD
BUFFALO DRIVE AND PEAK ROAD
LAS VEGAS, NEVADA
ROOF PLAN
MATERIALS HANDLING BUILDING

584282

RECEIVED
MAR 18 2003
CITY OF LAS VEGAS PERMITS



OWNER: CITY OF LAS VEGAS
DEPARTMENT OF PUBLIC WORKS
ARCHITECTURAL SERVICES

APPROVAL IS FOR CLOUDED AREAS OR LATEST REVISIONS ONLY. SEE ORIGINALS FOR OTHER REQUIREMENTS.

PLANS APPROVED
ARCHITECTURAL
Consulting & Survey, Inc.
City of Las Vegas, Nevada

MHP MAR 20 2003

Does Not Include Structural, Electrical, Plumbing, Mechanical, Fire, or Life Safety. Approval is Subject to Change Without Notice. Not a Permit to Violate Any Ordinance.

400 EAST STEWART AVENUE
LAS VEGAS, NEVADA 89101
PHONE: (702) 229-6535
FAX: (702) 386-3232
TDD: (702) 386-9108

| | |
|------------|--------------|
| ISSUED | DATE |
| FILE | 047A412 |
| DATE | 03.14.03 |
| SCALE | 1/8" = 1'-0" |
| DWG NO | 02.15341.03 |
| REVISED NO | 107-V3548 |
| DATE | |