


WEST ELEVATION

SCALE: 1/8" = 1'-0"

WARNING:


ALL AIR CONDITIONING, ROOF MECHANICS AND TRASH AREAS MUST BE SCREENED FROM VIEW.

ANY VARIATION IN THE ELEVATIONS AS SHOWN AND APPROVED HEREON MAY RESULT IN THE WITHHOLDING OF FINAL APPROVAL AND OR A CERTIFICATE OF OCCUPANCY UNTIL SUCH TIME AS THE BUILDING OR STRUCTURE CONFORMS TO THE PLANS AND ELEVATIONS AS APPROVED BY THE CITY OF LAS VEGAS.

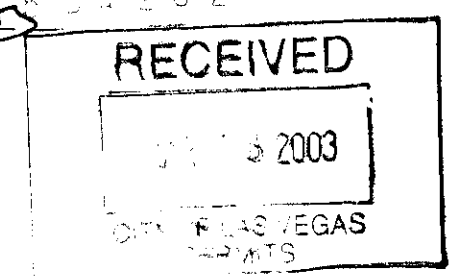

KEYNOTES
SHEETS A6.11 - A6.14

- 1 EXTERIOR CEMENT PLASTER COLOR A - SEE COLOR LEGEND, A2.01
- 2 TUBE STEEL SHADE STRUCT. - PAINT COLOR B, SEE DETAIL 1/A1.30
- 3 CONCRETE TILE ROOF
- 4 STANDING SEAM METAL ROOF
- 5 INSULATED METAL WALL PANELS
- 6 CMU WALL
- 7 DOWNSPOUT (SEE A2.01 FOR COLOR)
- 8 OVERHEAD DOOR - SEE DOOR SCHEDULE
- 9 STANDING SEAM METAL FASCIA
- 10 TUBE STEEL COLUMN - PAINTED (SEE A2.01 FOR COLOR)
- 11 STEEL DECK CANOPY, PTD.
- 12 PERFORATED STEEL SCREEN
- 13 1 1/2" STEEL PIPE RAILING - PAINTED (SEE A2.01 FOR COLOR)
- 14 CONCRETE STAIRS & LOADING DOCK
- 15 CMU RETAINING WALL
- 16 8" DIA. STEEL PIPE BOLLARD, SEE STRUCTURAL DRAWINGS.
- 17 TOP OF RAMP BEYOND CMU ACCENT BAND
- 18 CERAMIC TILE ACCENT, SEE COLOR LEGEND, A2.01
- 19 NOT USED
- 20 EXTERIOR CEMENT PLASTER FRIEZE COLOR A - SEE COLOR LEGEND, A2.01
- 21 PLYWOOD FASCIA BOARD, PAINTED - SEE COLOR LEGEND, A2.01
- 22 CMU CONTROL JOINT, TYP. LOUVER (TYP), SEE MECHANICAL DRAWINGS
- 23 EVAPORATIVE COOLER, SEE MECHANICAL DRAWINGS
- 24 EXHAUST FAN (TYP), SEE MECH DRAWINGS
- 25 BRUSHED ALUMINUM LETTERS, 9" TALL, "FUTURA LT BD" FONT
- 26 BRUSHED ALUMINUM LETTERS, 6-3/4" TALL, "FUTURA LT BD" FONT
- 27 EXHAUST FAN (NORTH ELEV ONLY), SEE MECH. DUGS.
- 28 CONCRETE FOOTING, SEE STRUCT. DUGS. FOR SIZE
- 29 FIN. GRADE BEYOND METAL ROOF
- 30 METAL PANEL FASCIA
- 31 EXTERIOR CEMENT PLASTER TO MATCH EXISTING COLOR
- 32 CERAMIC TILE TO MATCH EXISTING COLOR
- 33 2'-0" DRAINAGE OPENING
- 34 LIGHT FIXTURE
- 35 NOT USED
- 36 ROOF VENT
- 37 SAWDUST COLLECTOR - SEE MECH. DUGS.
- 40

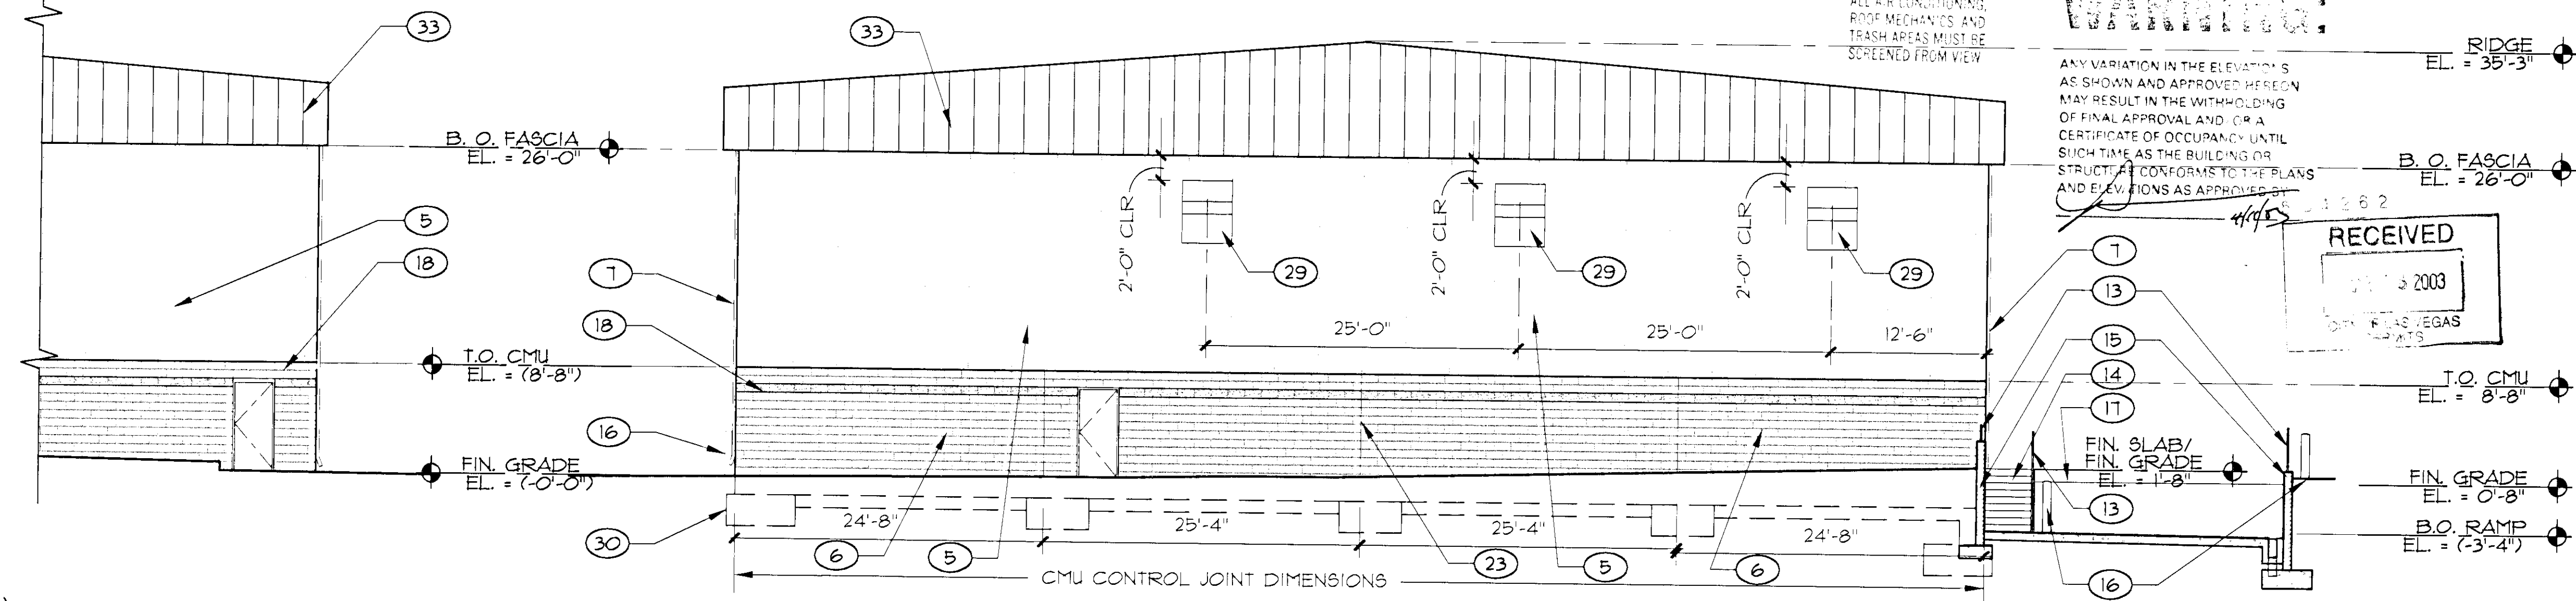


NORTH ELEVATION

SCALE: 1/8" = 1'-0"

(SOUTH ELEVATION SIMILAR - O.H.)

SOUTH ELEVATION

SCALE: 1/8" = 1'-0"

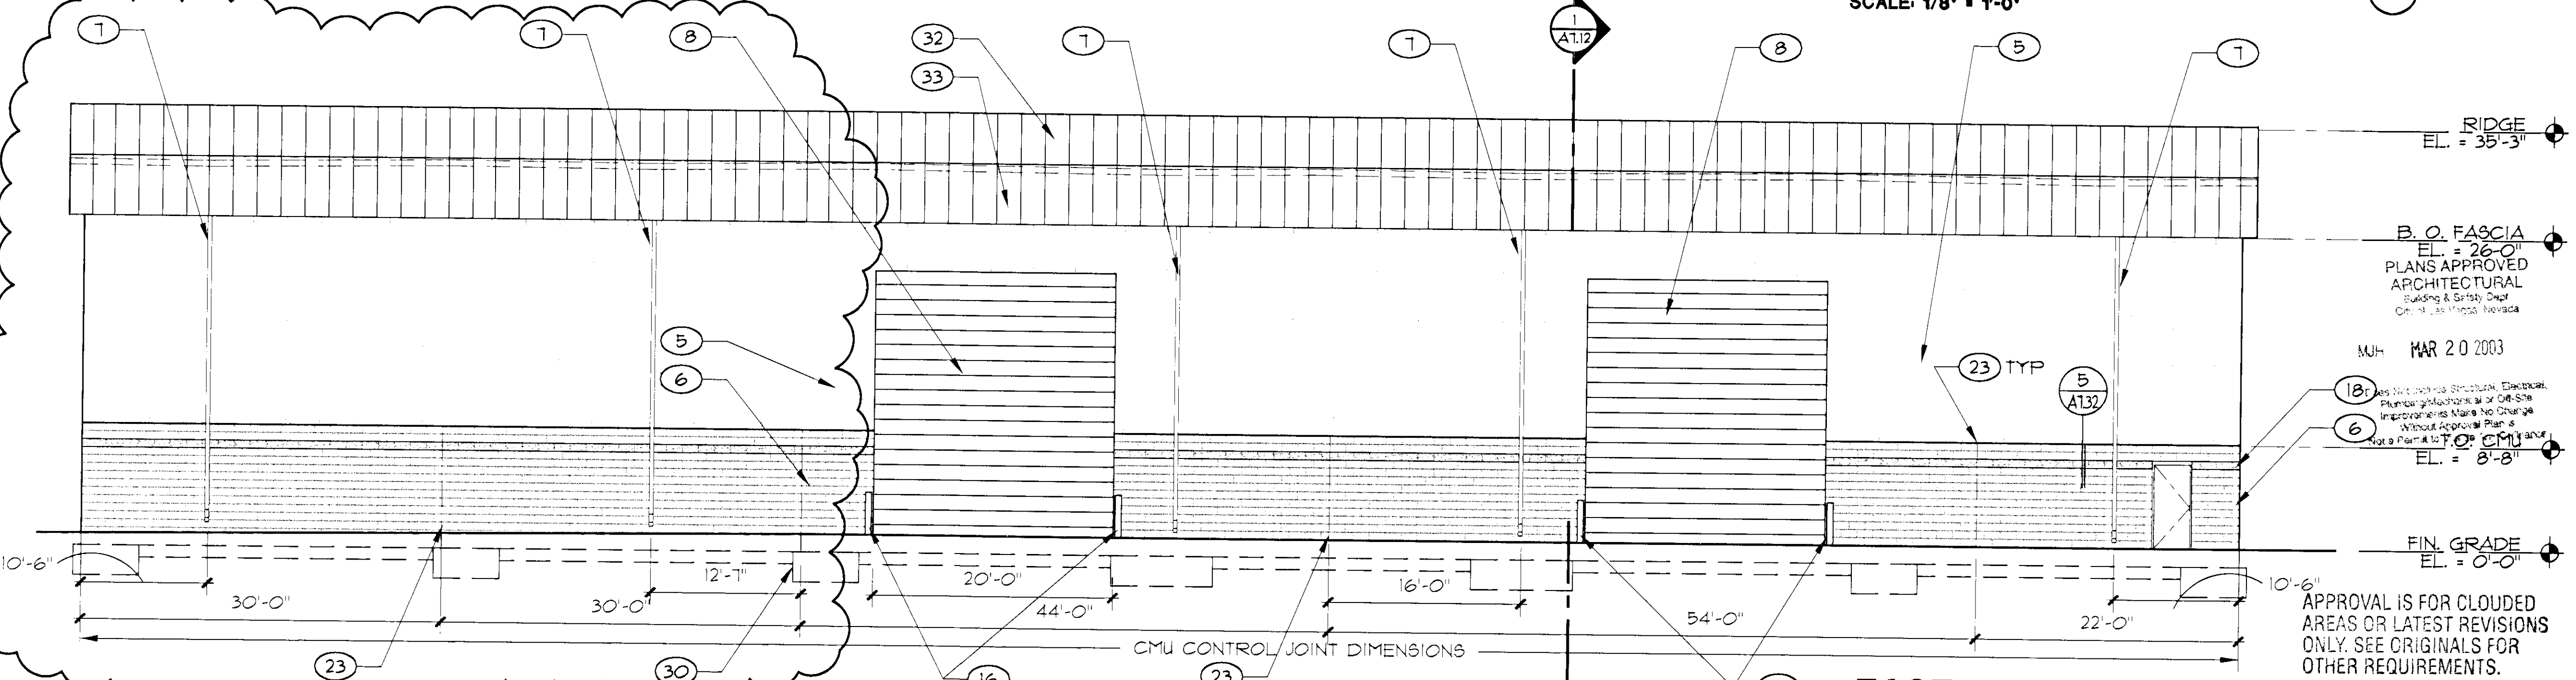

EAST ELEVATION

SCALE: 1/8" = 1'-0"

APPROVAL IS FOR CLOUDED AREAS OR LATEST REVISIONS ONLY. SEE ORIGINALS FOR OTHER REQUIREMENTS.

- GENERAL NOTES**
- 1 SEE BUILDING SECTIONS AND WALL SECTIONS FOR FINISH HEIGHTS AND CONSTRUCTION
 - 2 FOR MATERIALS HANDLING BUILDING A6.12, SEE FLOOR PLAN A1.12 FOR INTERIOR SLAB ELEVATIONS

CMU LEGEND

	CMU A SEE SHEET A2.01
	CMU B SEE SHEET A2.01



REVISIONS: 03.14.03

CONSULTANT: TATE SNYDER KIMSEY ARCHITECTS
2000 Village Center, Henderson, Nevada 89015
PH: 702.486.1000 FAX: 702.486.1009
WWW.TSKARCH.COM

DEPARTMENT OF PUBLIC WORKS
CITY OF LAS VEGAS WEST SERVICE YARD
BUFFALO DRIVE AND PEAK ROAD
LAS VEGAS, NEVADA
EXTERIOR ELEVATIONS
MATERIALS HANDLING BUILDING



OWNER: CITY OF LAS VEGAS
DEPARTMENT OF PUBLIC WORKS
ARCHITECTURAL SERVICES

400 EAST STEWART AVENUE
LAS VEGAS, NEVADA 89101
PHONE: (702) 229-6335
FAX: (702) 388-2332
TDD: (702) 386-9108

DATE: 04/26/12
SCALE: 1/8" = 1'-0"
JOB NO: 02.15341.09
DRAWING NO: 107-V3548