


APPROVAL IS FOR CLOUDED AREAS OR LATEST REVISIONS ONLY. SEE ORIGINALS FOR OTHER REQUIREMENTS.

SOUTH ELEVATION

SCALE: 1/8" = 1'-0"


2

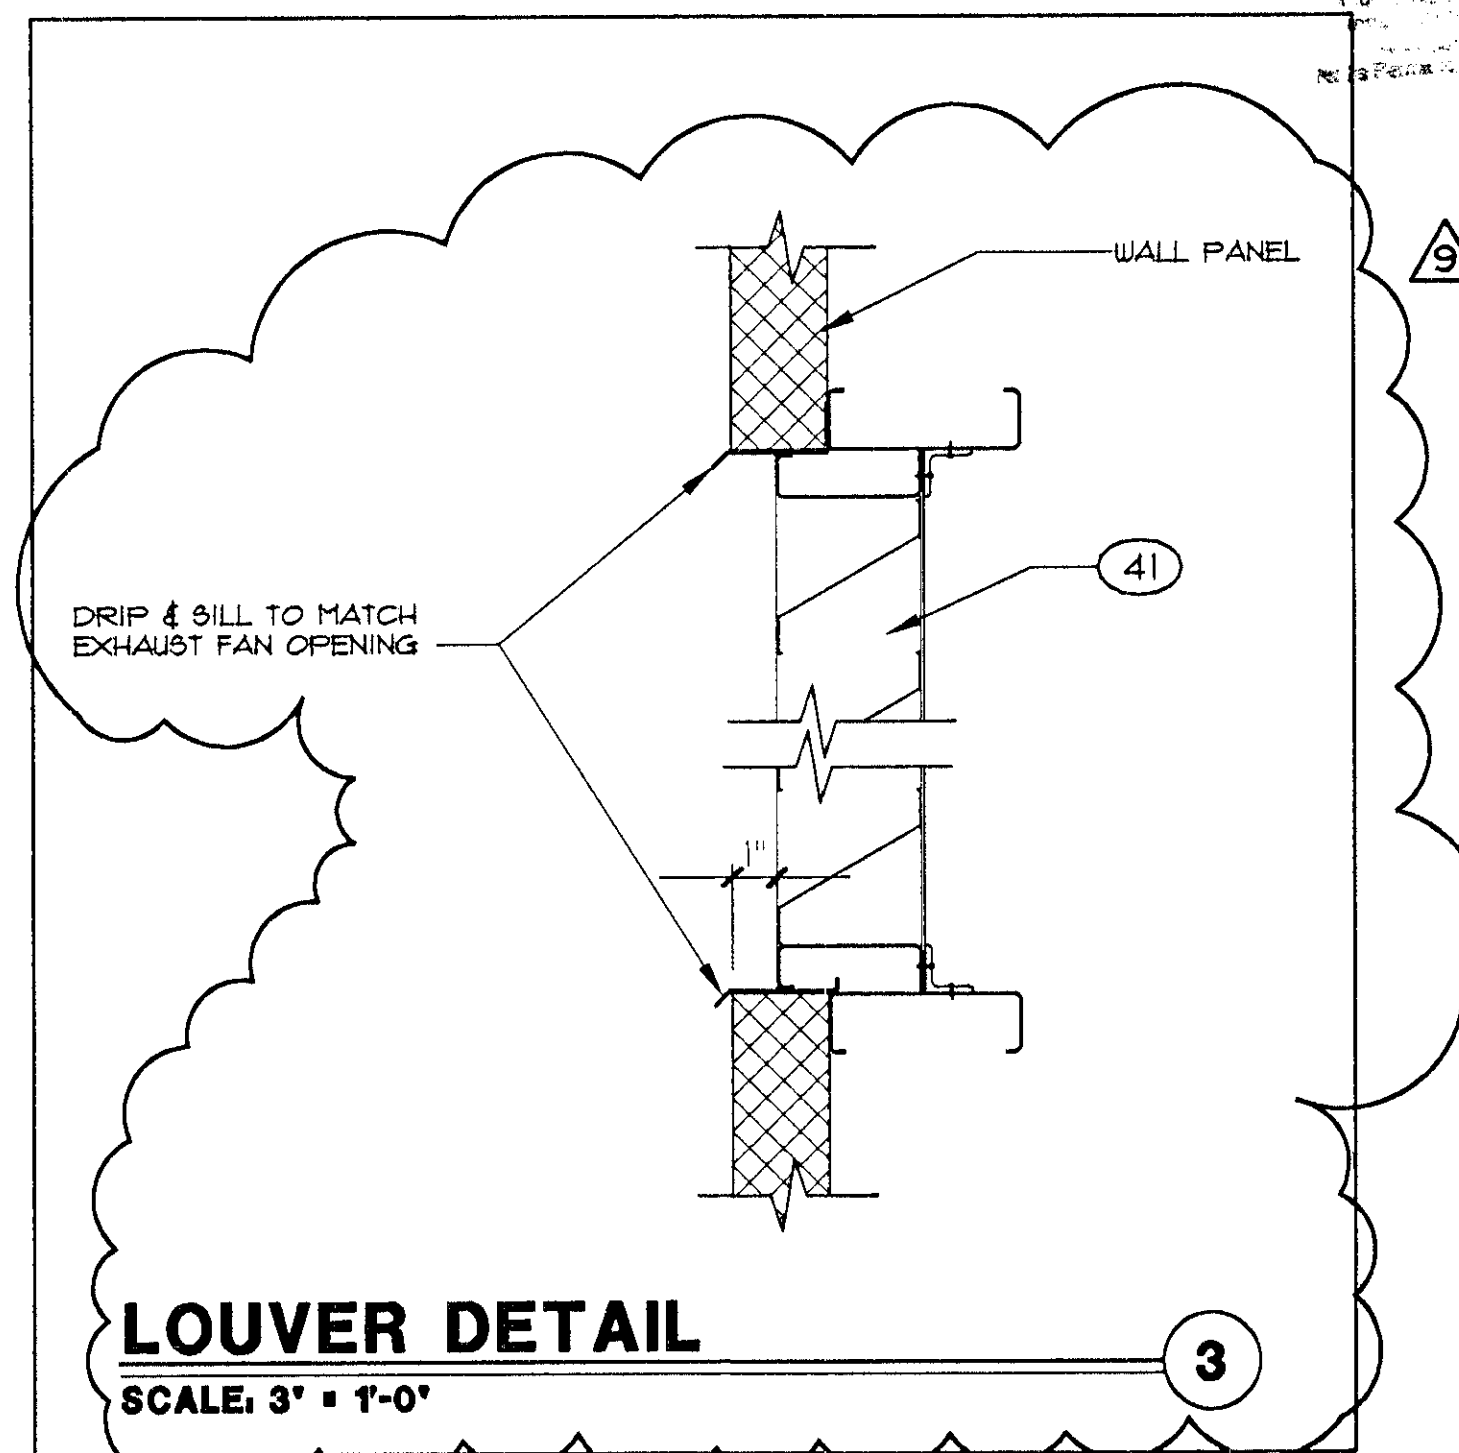

LOUVER DETAIL

SCALE: 3" = 1'-0"

3

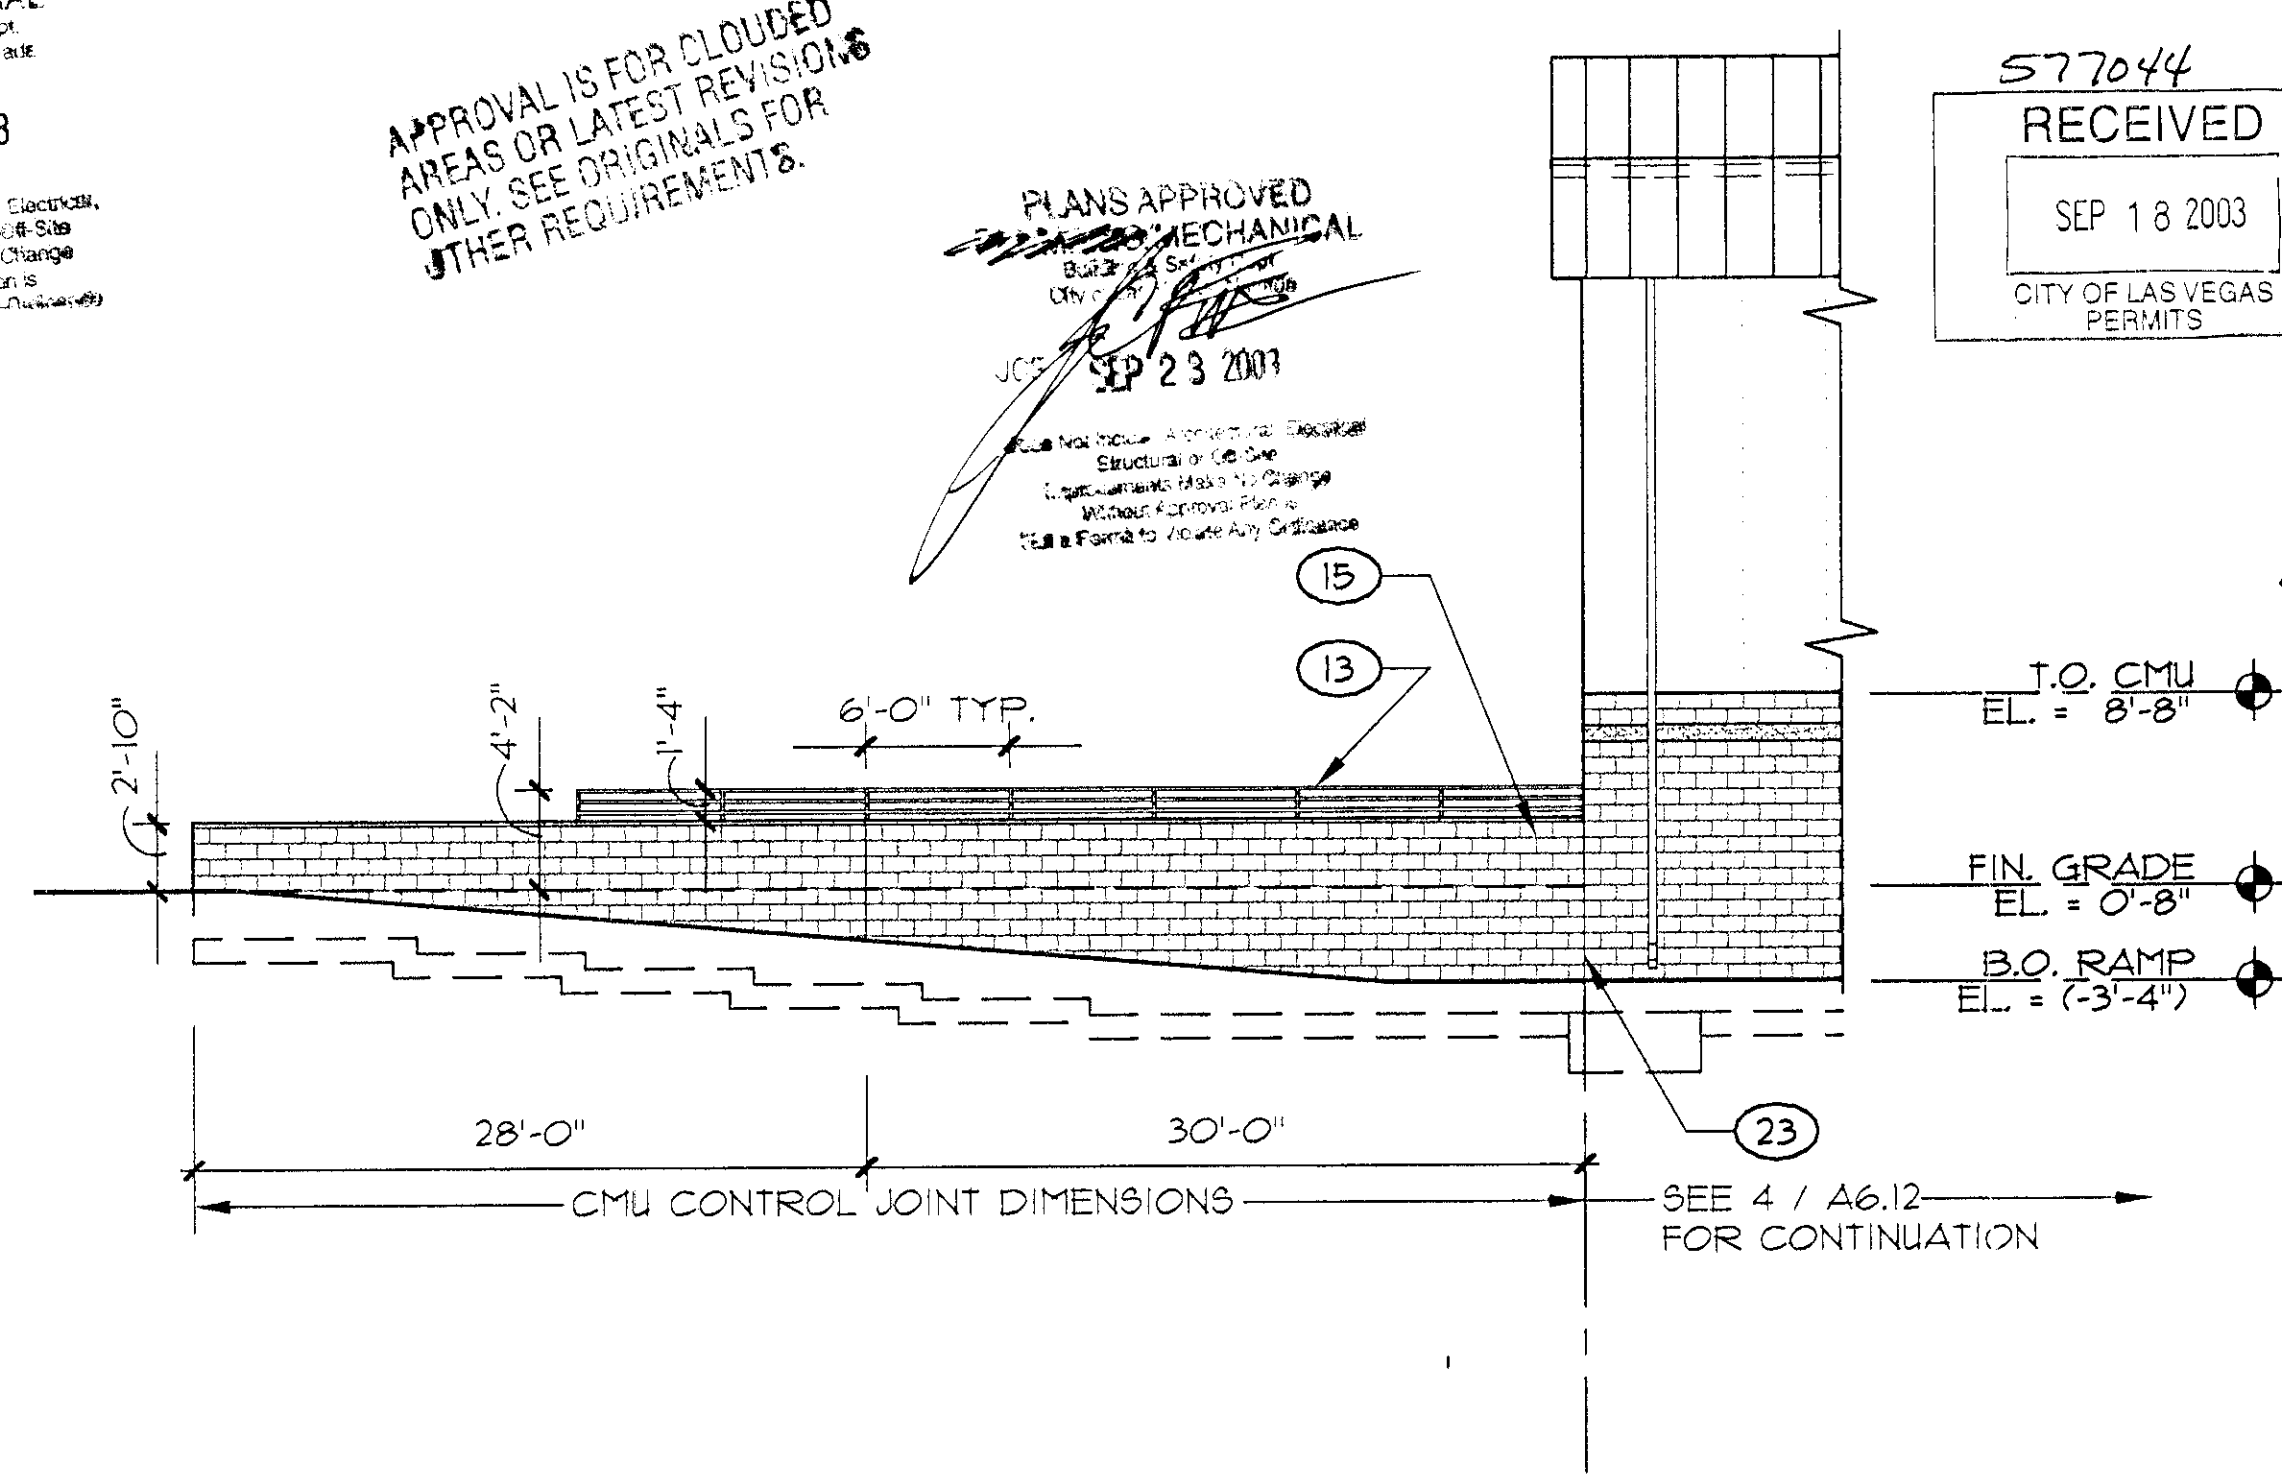

WEST ELEVATION, CONT'D.

SCALE: 1/8" = 1'-0"

1

KEYNOTES
SHEETS A6.11 - A6.14

- 1 EXTERIOR CEMENT PLASTER COLOR A - SEE COLOR LEGEND, A2.01
- 2 TUBE STEEL SHADE STRUCT. - PAINT COLOR B, SEE DETAIL 1/A1.30
- 3 CONCRETE TILE ROOF
- 4 STANDING SEAM METAL ROOF
- 5 INSULATED METAL WALL PANELS
- 6 CMU WALL
- 7 DOWNSPOUT (SEE A2.01 FOR COLOR)
- 8 OVERHEAD DOOR - SEE DOOR SCHEDULE
- 9 STANDING SEAM METAL FASCIA
- 10 TUBE STEEL COLUMN - PAINTED (SEE A2.01 FOR COLOR)
- 11 STEEL DECK CANOPY, PTD.
- 12 PERFORATED STEEL SCREEN
- 13 1 1/2" STEEL PIPE RAILING - PAINTED (SEE A2.01 FOR COLOR)
- 14 CONCRETE STAIRS & LOADING DOCK
- 15 CMU RETAINING WALL
- 16 8" DIA. STEEL PIPE BOLLARD. SEE STRUCTURAL DRAWINGS.
- 17 TOP OF RAMP BEYOND CMU ACCENT BAND
- 18 CERAMIC TILE ACCENT, SEE COLOR LEGEND, A2.01
- 19 NOT USED
- 20 EXTERIOR CEMENT PLASTER FRIEZE COLOR A - SEE COLOR LEGEND, A2.01
- 21 PLYWOOD FASCIA BOARD, PAINTED -SEE COLOR LEGEND, A2.01
- 22 CMU CONTROL JOINT, TYP. LOUVER (TYP), SEE MECHANICAL DRAWINGS
- 23 EVAPORATIVE COOLER, SEE MECHANICAL DRAWINGS
- 24 EXHAUST FAN (TYP), SEE MECH DRAWINGS
- 25 BRUSHED ALUMINUM LETTERS, 9" TALL, "FUTURA LT BD" FONT
- 26 BRUSHED ALUMINUM LETTERS, 6-3/4" TALL, "FUTURA LT BD" FONT
- 27 EXHAUST FAN (NORTH ELEV ONLY) SEE MECH. DWGS.
- 28 CONCRETE FOOTING, SEE STRUCT. DWGS. FOR SIZE
- 29 FIN. GRADE BEYOND
- 30 METAL ROOF
- 31 METAL PANEL FASCIA
- 32 EXTERIOR CEMENT PLASTER TO MATCH EXISTING COLOR
- 33 CERAMIC TILE TO MATCH EXISTING COLOR
- 34 2'-0" DRAINAGE OPENING
- 35 LIGHT FIXTURE
- 36 NOT USED
- 37 ROOF VENT
- 38 SAWDUST COLLECTOR - SEE MECH. DWGS.
- 39 8'-0" x 8'-0" LOUVER, RUSKIN #L330 OR EQUAL, BIRDSCREEN ON INT. SIDE, PAINT TO MATCH TEXTURE WALL PANEL COLOR.

- GENERAL NOTES**
- 1 SEE BUILDING SECTIONS AND WALL SECTIONS FOR FINISH HEIGHTS AND CONSTRUCTION
 - 2 FOR MATERIALS HANDLING BUILDING A6.12, SEE FLOOR PLAN A1.12 FOR INTERIOR SLAB ELEVATIONS

CMU LEGEND

	CMU A SEE SHEET A2.01
	CMU B SEE SHEET A2.01



REVISIONS


1	8/30/02
2	10/16/02
3	01/22/03
4	03/14/03
5	09/18/03

CONSULTANT

CLV 02/11/02

TATE SNYDER KIMSEY ARCHITECTS
700 West Nevada Court Henderson, Nevada 89014 PH: 702-488-5000 FAX: 702-488-1000
www.tatekimsey.com

CITY OF LAS VEGAS WEST SERVICE YARD
BUFFALO DRIVE AND PEAK ROAD
LAS VEGAS, NEVADA
EXTERIOR ELEVATIONS
MATERIALS HANDLING BUILDING

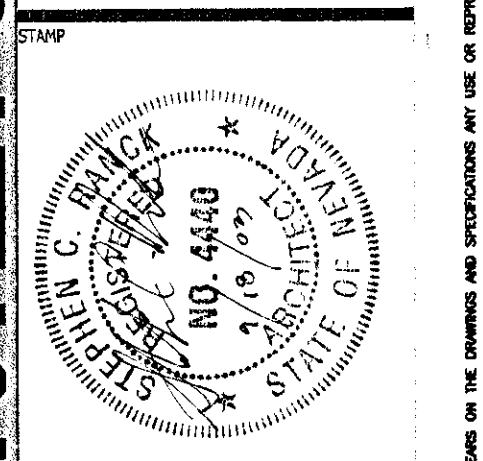

OWNER: CITY OF LAS VEGAS
DEPARTMENT OF PUBLIC WORKS
ARCHITECTURAL SERVICES

400 EAST STEWART AVENUE LAS VEGAS, NEVADA 89101 PHONE: (702) 229-6333 FAX: (702) 382-3232 TDD: (702) 386-9104
DRAWN: LIFE
FILE: 047A612
DATE: 03/14/03
SCALE: 1/8" = 1'-0"
SHEET NO: 02.15341.03
CLV DWG NO: 107-V3548

A6.12B