


**FIELD OPERATIONS CENTER
WALL SECTION @ PORTICO**
SCALE: 3/4" = 1'-0" ②

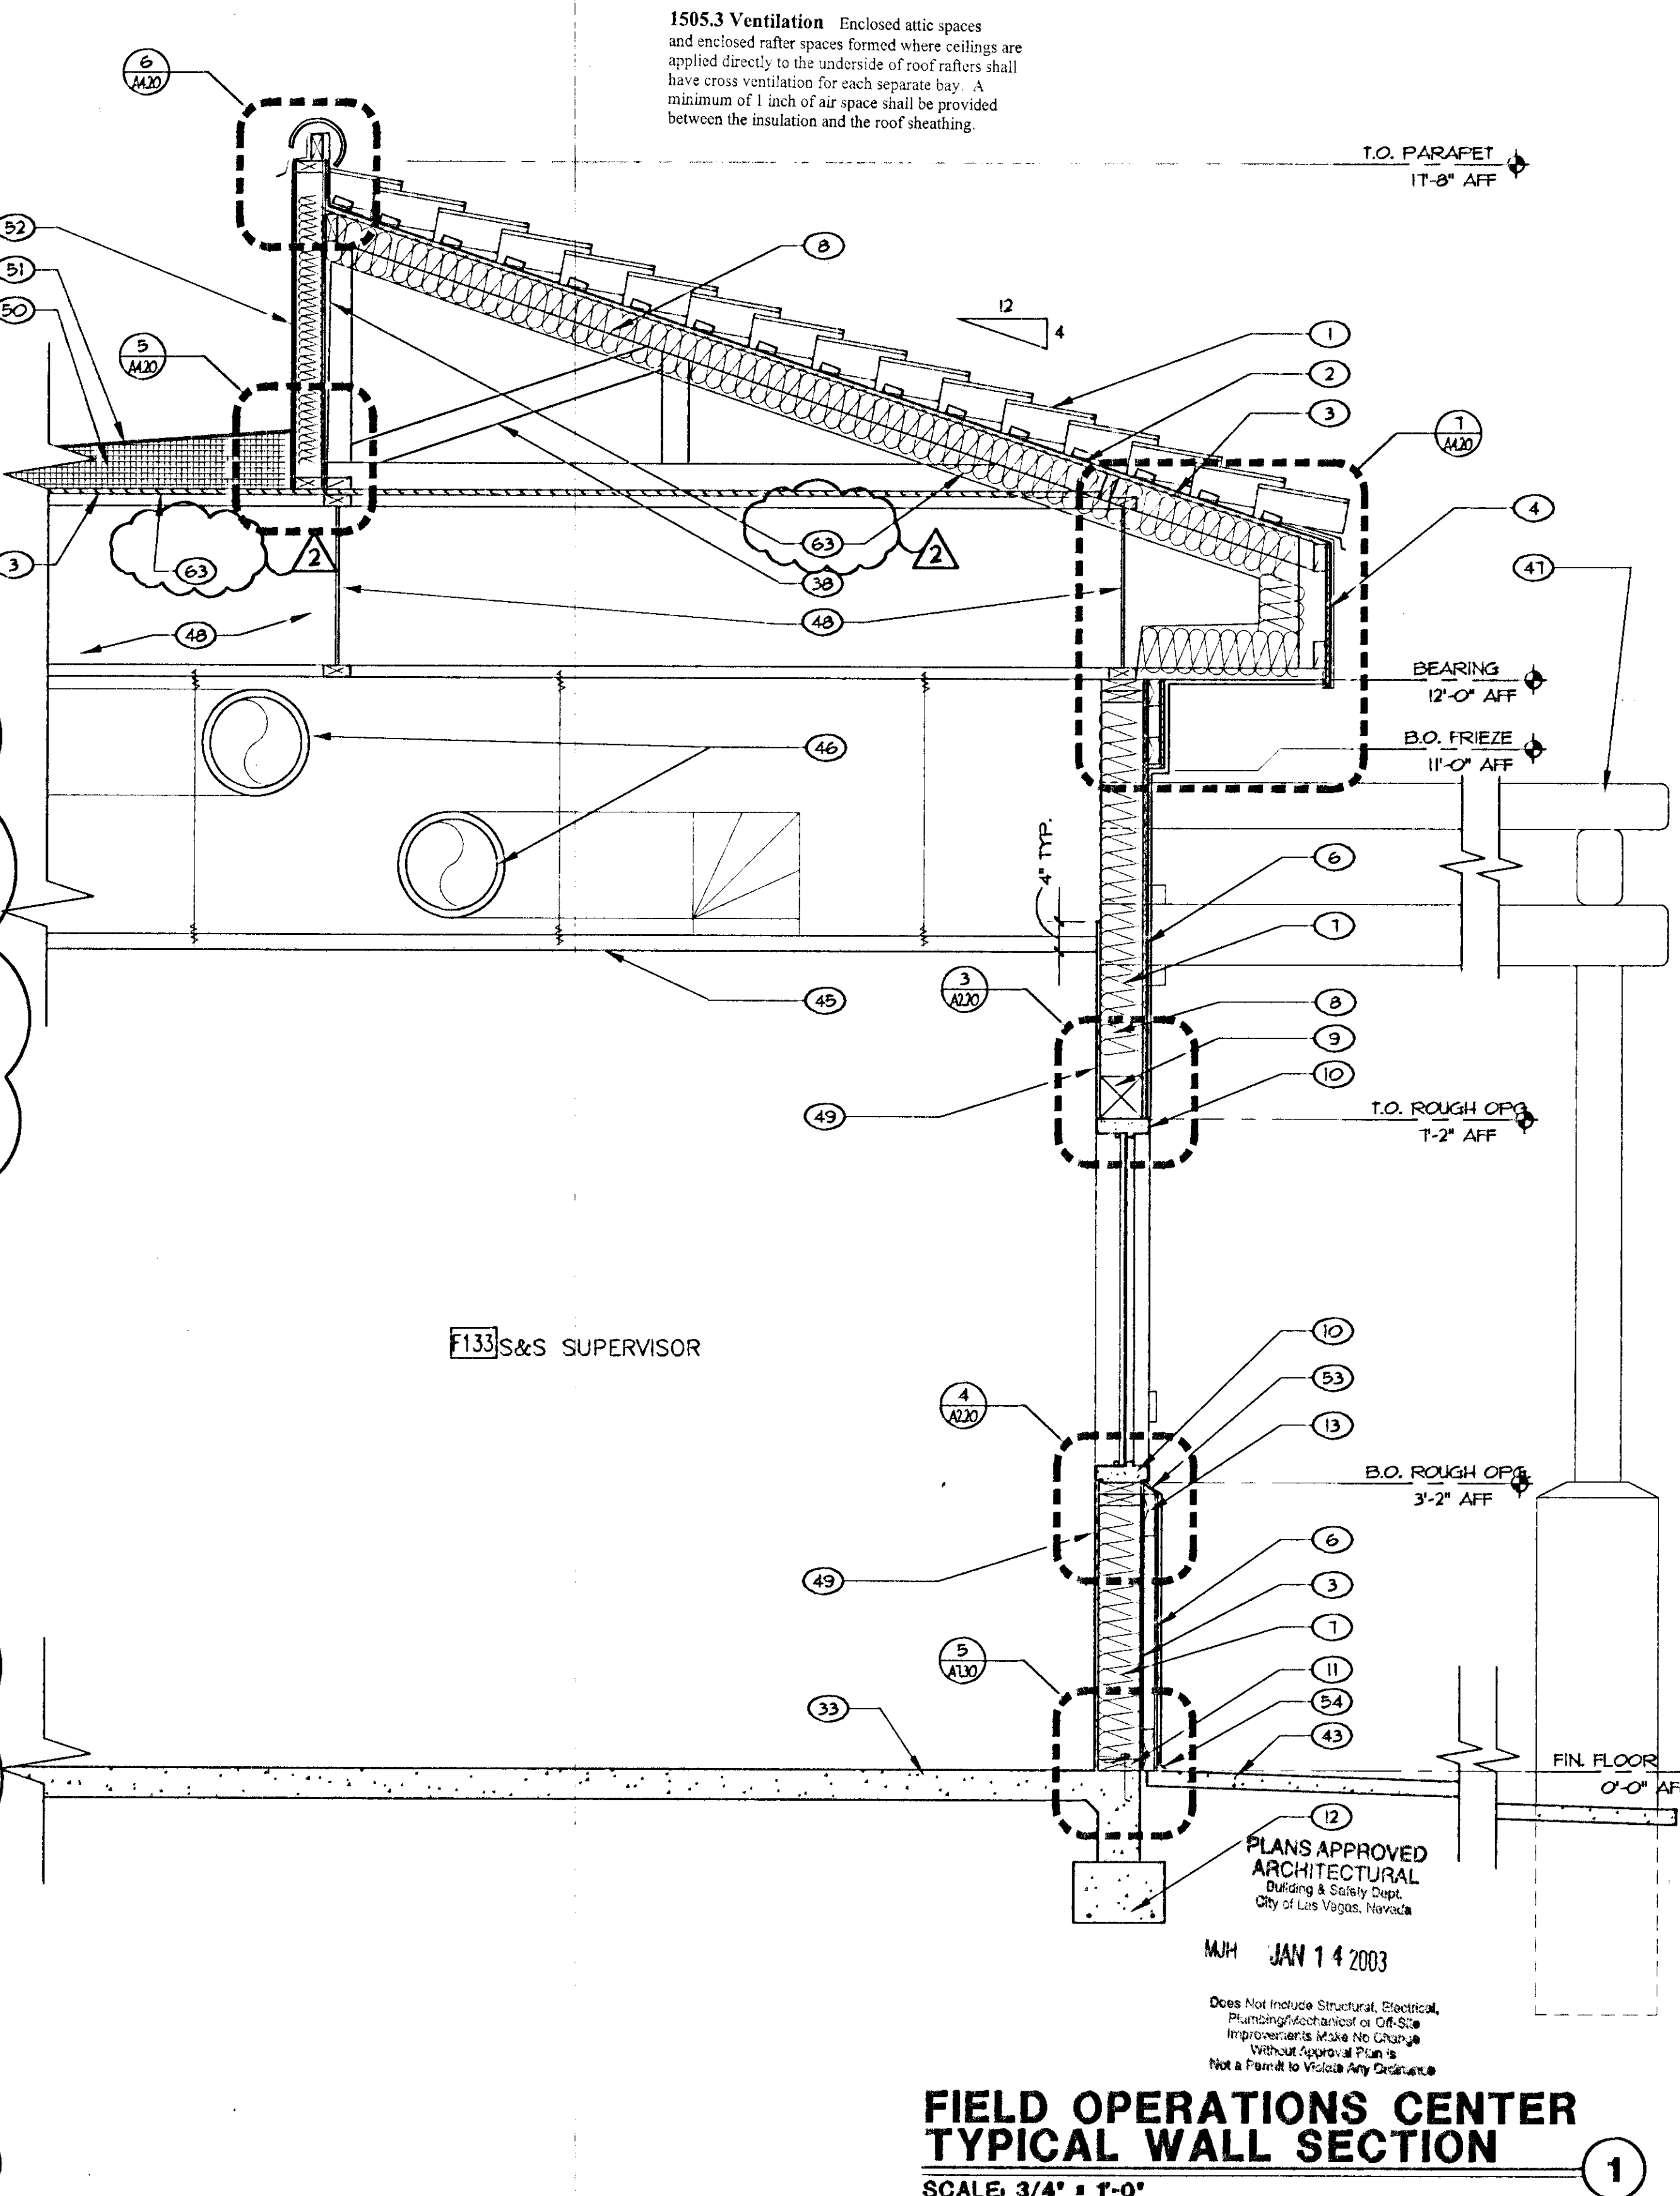

**FIELD OPERATIONS CENTER
TYPICAL WALL SECTION**
SCALE: 3/4" = 1'-0" ①

KEYNOTES
SHEETS A121 - A123

- 1 CONCRETE ROOF TILE
- 2 #30 FELT
- 3 PLYWOOD SHEATHING SEE STRUCT. DUGS.
- 4 PLYWOOD FASCIA
- 5 METAL SOFFIT PANEL
- 6 3/4" EXTERIOR CEMENT PLASTER ON METAL LATH / FELT PAPER ON PLYWOOD SHEATHING
- 7 2 x 6 WOOD STUDS
- 8 R13 BATT INSULATION
- 9 HEADER, SEE STRUCT.
- 10 HOLLOW METAL FRAME
- 11 BILL FLATE
- 12 CONCRETE FOOTING, SEE STRUCTURAL DRAWINGS
- 13 2x WOOD BLOCKING
- 14 4" x 4" CERAMIC TILE
- 15 2" x FRIEZE, PAINTED
- 16 8" x 8" x 16" STANDARD-FACE CMU, RUNNING BOND WITH SMOOTH JOINTS
- 17 CMU BOND BEAM - GROUT SOLID
- 18 SPLIT-FACE CMU
- 19 8" x 8" x 16" STANDARD CMU, GROUT SOLID
- 20 STEEL ANGLE LEDGER, INSTALL TO MATCH ROOF SLOPE, SEE STRUCT. DUGS.
- 21 METAL ROOF DECK
- 22 STEEL CANOPY FRAMING, SEE STRUCT. DUGS.
- 23 CONTINUOUS METAL FASCIA TO MATCH ROOF
- 24 TUBE STEEL FENCE ASSEMBLY
- 25 PERFORATED METAL SCREEN
- 26 TUBE STEEL COLUMN, SEE STRUCT. DUGS.
- 27 STANDING BEAM METAL ROOF
- 28 2" RIGID INSULATION
- 29 GUTTER
- 30 FRAMING AS REQUIRED
- 31 STEEL JOIST, SEE STRUCT. DUGS.
- 32 DOWNSPOUT
- 33 CONCRETE FLOOR SLAB
- 34 AC PAVING
- 35 1x WOOD BLOCKING
- 36 LIGHT FIXTURE
- 37 2x WOOD FRAMING
- 38 PREMANUFACTURED WOOD TRUSSES, SEE STRUCT.
- 39 ALUMINUM STOREFRONT SYSTEM
- 40 9" TALL ALUMINUM LETTERS
- 41 6-3/4" TALL ALUMINUM LETTERS
- 42 GLAZING
- 43 SIDEWALK, SEE CIVIL
- 44 GYP. BD. SOFFIT
- 45 ACOUSTICAL CEILING TILE
- 46 DUCTWORK, SEE MECH.
- 47 TUBE STEEL SHADE CANOPY
- 48 TJI JOISTS
- 49 5/8" GYP. BD.
- 50 TAPERED RIGID INSULATION, MINIMUM 2" THICK
- 51 SINGLE-PLY ROOFING
- 52 MEMBRANE FLASHING
- 53 45 DEGREE ANGLE, TYP.
- 54 PLASTER SCREED
- 55 LOUVER - SEE MECHANICAL
- 56 EXISTING FRAMING - VERIFY IN FIELD
- 57 EXISTING SHEATHING - VERIFY IN FIELD
- 58 EXISTING WALL FINISH - VERIFY IN FIELD
- 59 2 x FRAMING @ 16" O.C. TO FILL EXIST. ROUGH OPENING
- 60 GYP. BD. - COVER FILLED WINDOW OPENING, PATCH & FINISH TO MATCH EXIST
- 61 ACOUSTICAL CEILING
- 62 CONT. VAPOR BARRIER




REVISION 1 08.30.02
2 10.16.02

CONSULTANT
TATE SNYDER KIMSEY ARCHITECTS
700 South Main Street, Henderson, Nevada 89015, P.O. Box 1000, Las Vegas, NV 89102
TEL: (702) 438-3000 FAX: (702) 438-3000
WWW.TSKARCHITECTS.COM

DEPARTMENT OF PUBLIC WORKS

CITY OF LAS VEGAS WEST SERVICE YARD
BUFFALO DRIVE AND PEAK ROAD
LAS VEGAS, NEVADA
WALL SECTIONS
FIELD OPERATIONS BUILDING

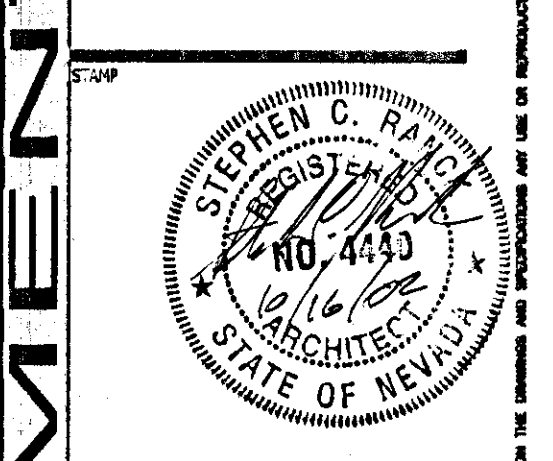

OWNER: CITY OF LAS VEGAS
DEPARTMENT OF PUBLIC WORKS
ARCHITECTURAL SERVICES

400 EAST STEWART AVENUE
LAS VEGAS, NEVADA 89101
PHONE: (702) 229-4338
FAX: (702) 382-3232
TDD: (702) 386-9108

DESIGNER	DATE	REVISION
FILE	047/21	
DATE	08.30.02	
SCALE	3/4" = 1'-0"	
DESIGN NO.	02.15341.09	
PROJECT NO.	101-V3548	

REVIEWED BY: [Signature]
OCT 17 2002
CITY OF LAS VEGAS BUILDING DEPT.

505198

A7.21

PLANS APPROVED
ARCHITECTURAL
City of Las Vegas, Nevada

MJH JAN 14 2003

Does Not Include Structural, Electrical,
Improvements. Make No Change
Without Approval of Plans.
Not a Permit to Violate Any Ordinance.