



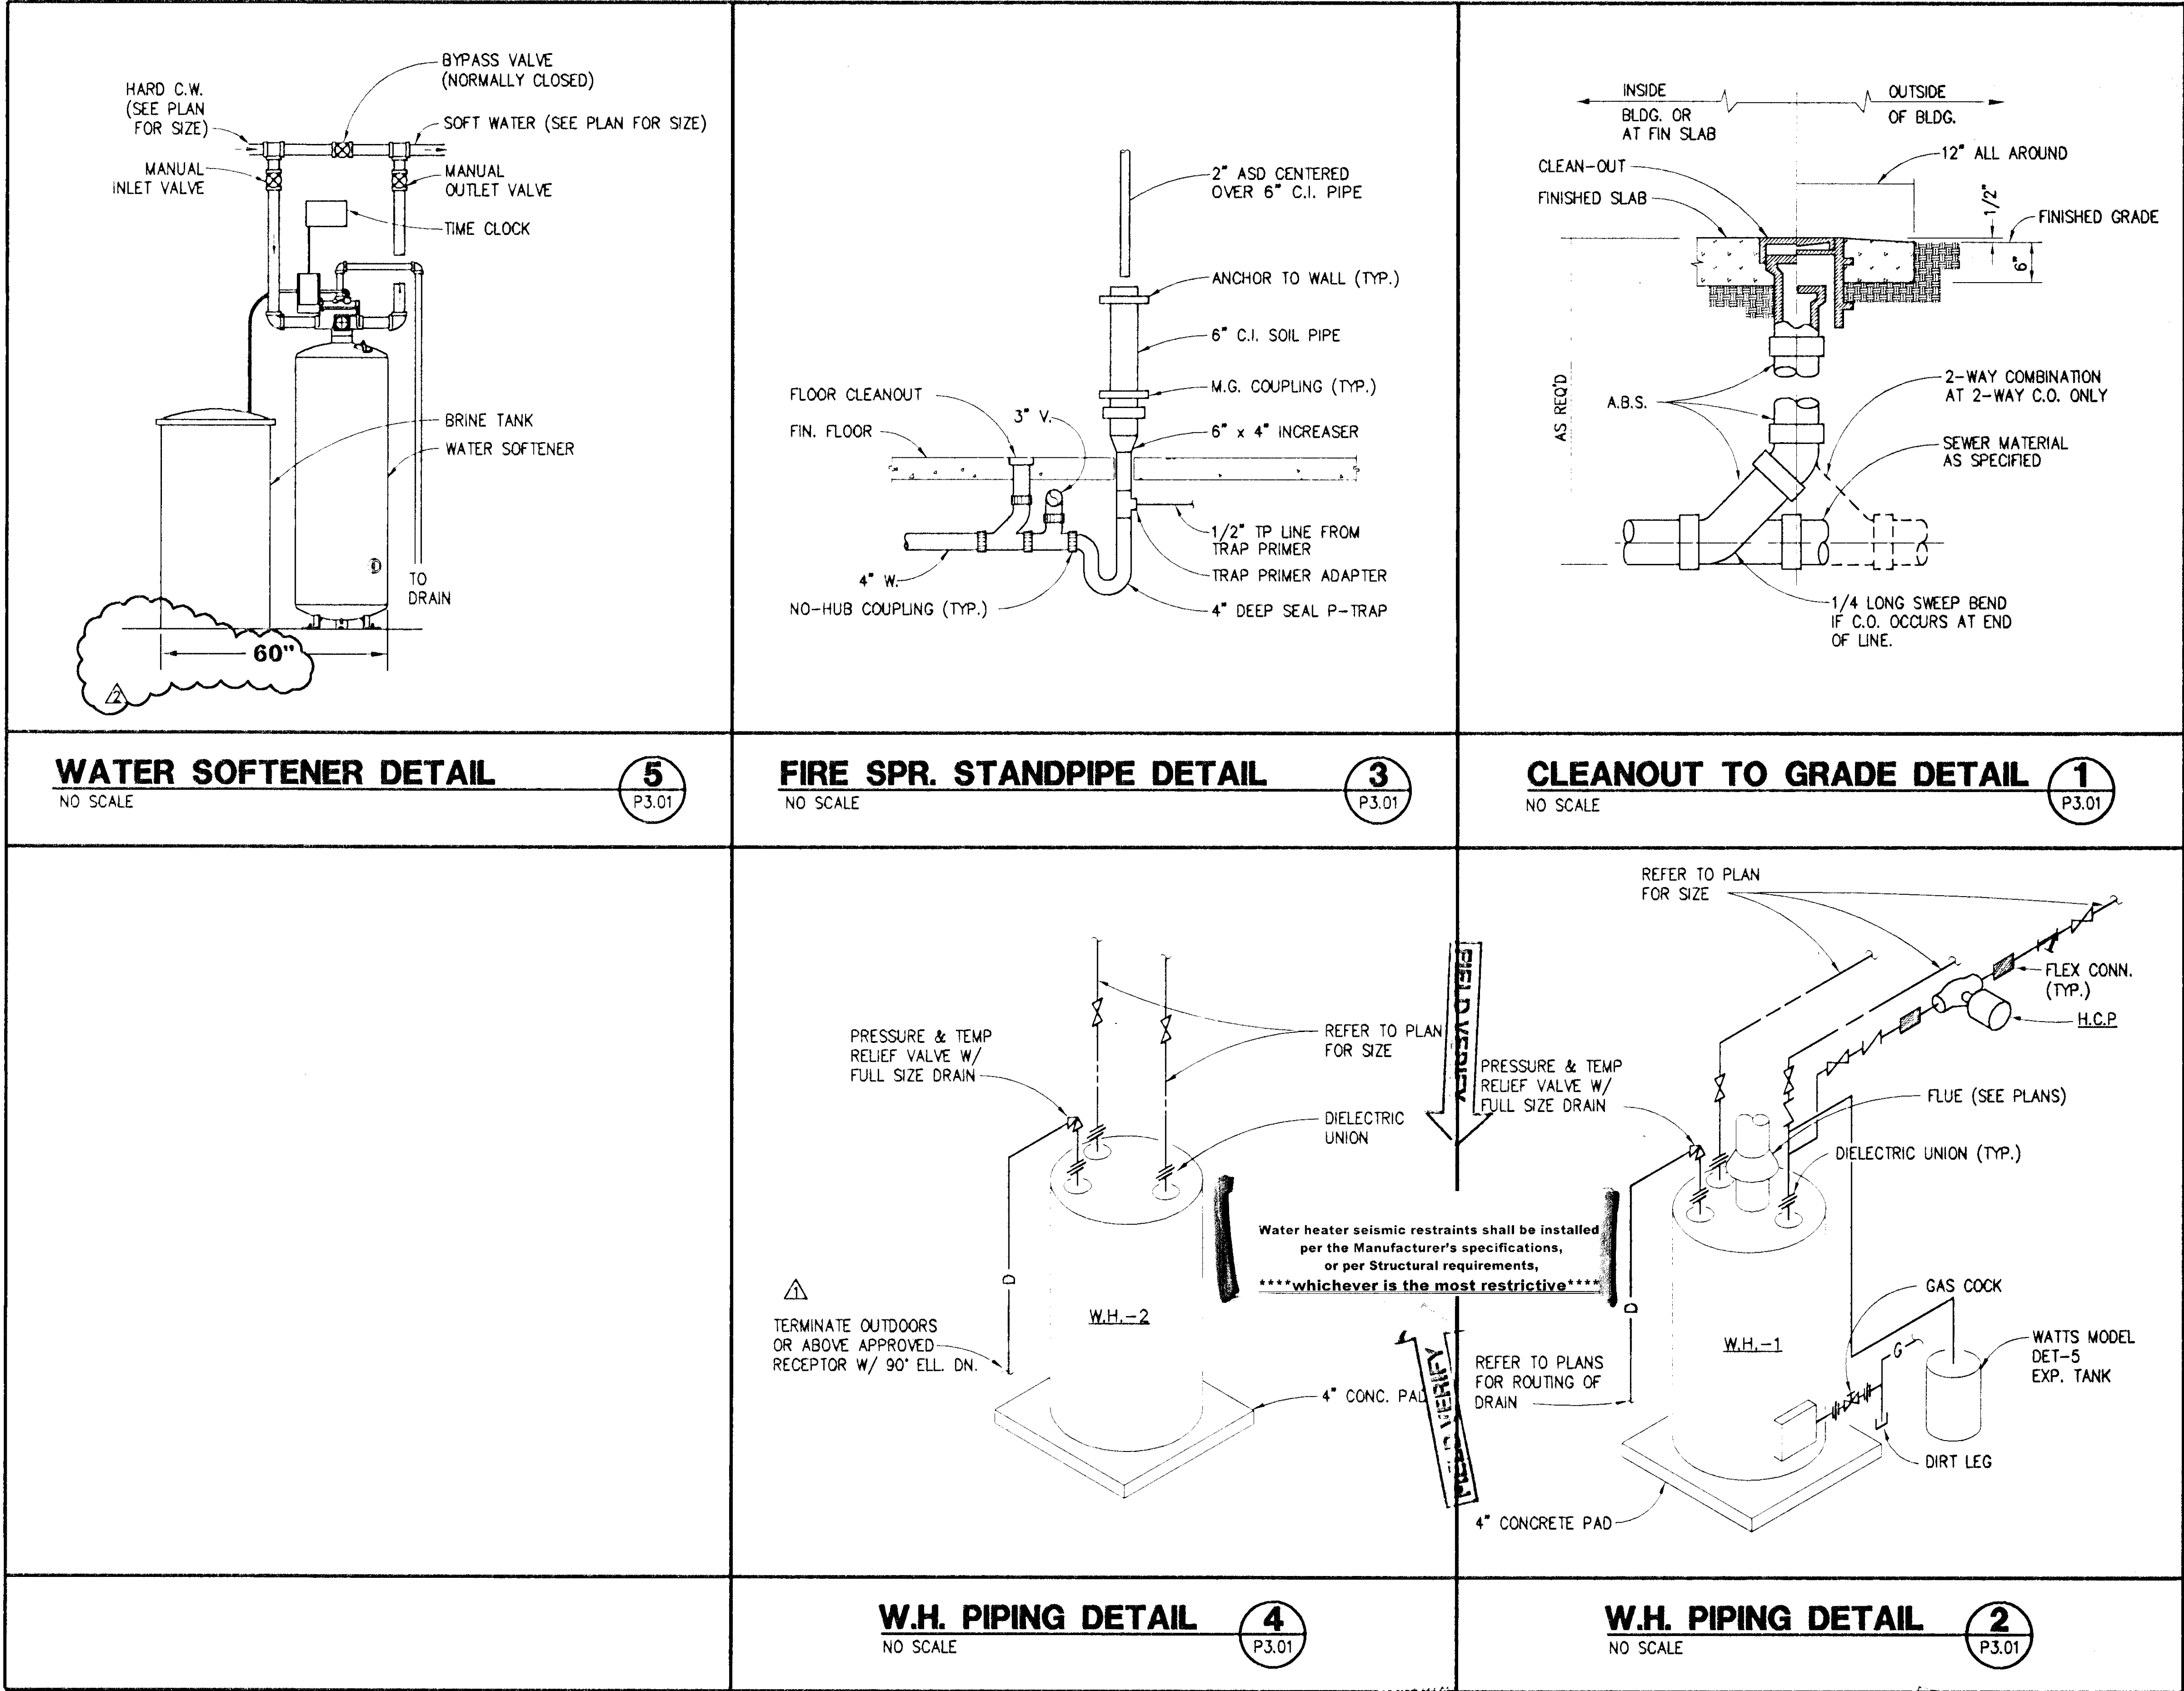

REVISION	REVISION #1
	AUGUST 30, 2002
	REVISION #2
	OCTOBER 16, 2002
CONSULTANT	
DESIGNER	
CHECKED	
APPROVED	

CITY OF LAS VEGAS WEST SERVICE YARD
BUFFALO DRIVE AND PEAK ROAD
LAS VEGAS, NEVADA
DETAILS

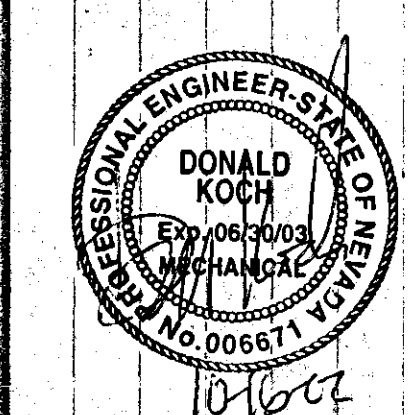

OWNER: CITY OF LAS VEGAS
DEPARTMENT OF PUBLIC WORKS
ARCHITECTURAL SERVICES

100 EAST STEWART AVENUE LAS VEGAS, NEVADA 89101 PHONE: (702) 229-6533 FAX: (702) 229-6532 TDD: (702) 229-6108	DATE 08.26.02	SCALE AS NOTED	REV NO 02.15341.09	REV DATE 107-V3548	SHEET NO P3.01
---	------------------	-------------------	-----------------------	-----------------------	-------------------

APPROVAL OF THIS PLAN DOES NOT RELY ON THE DESIGN PROFESSIONAL NOR THE CONTRACTOR TO VIOLATE THE EQUIPMENT CLEARANCE REQUIREMENTS OF CHAPTER 3 OF THE U.M.C. AND/OR CHAPTER 5 OF THE U.P.C.

SEE ATTACHED DOCUMENTS AND REQUIREMENTS

JCS JAN 31 2003

PLANS APPROVED
PLUMBING/MECHANICAL
CITY OF LAS VEGAS
JAN 31 2003

505198

RECEIVED
OCT 17 2002
CITY OF LAS VEGAS
BUILDING DEPT.
REVIEWED BY

