
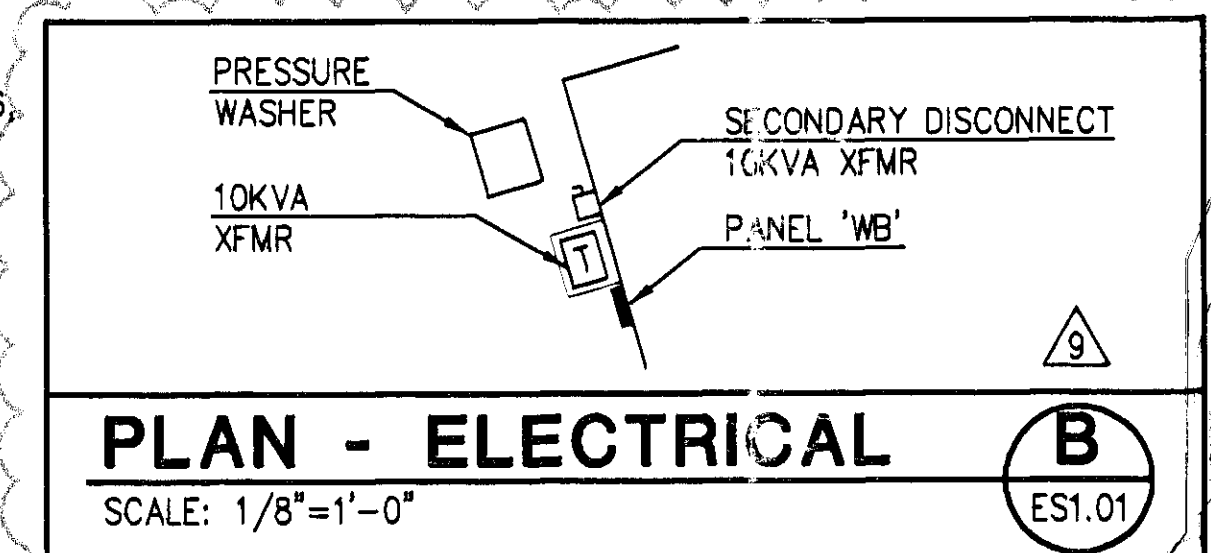


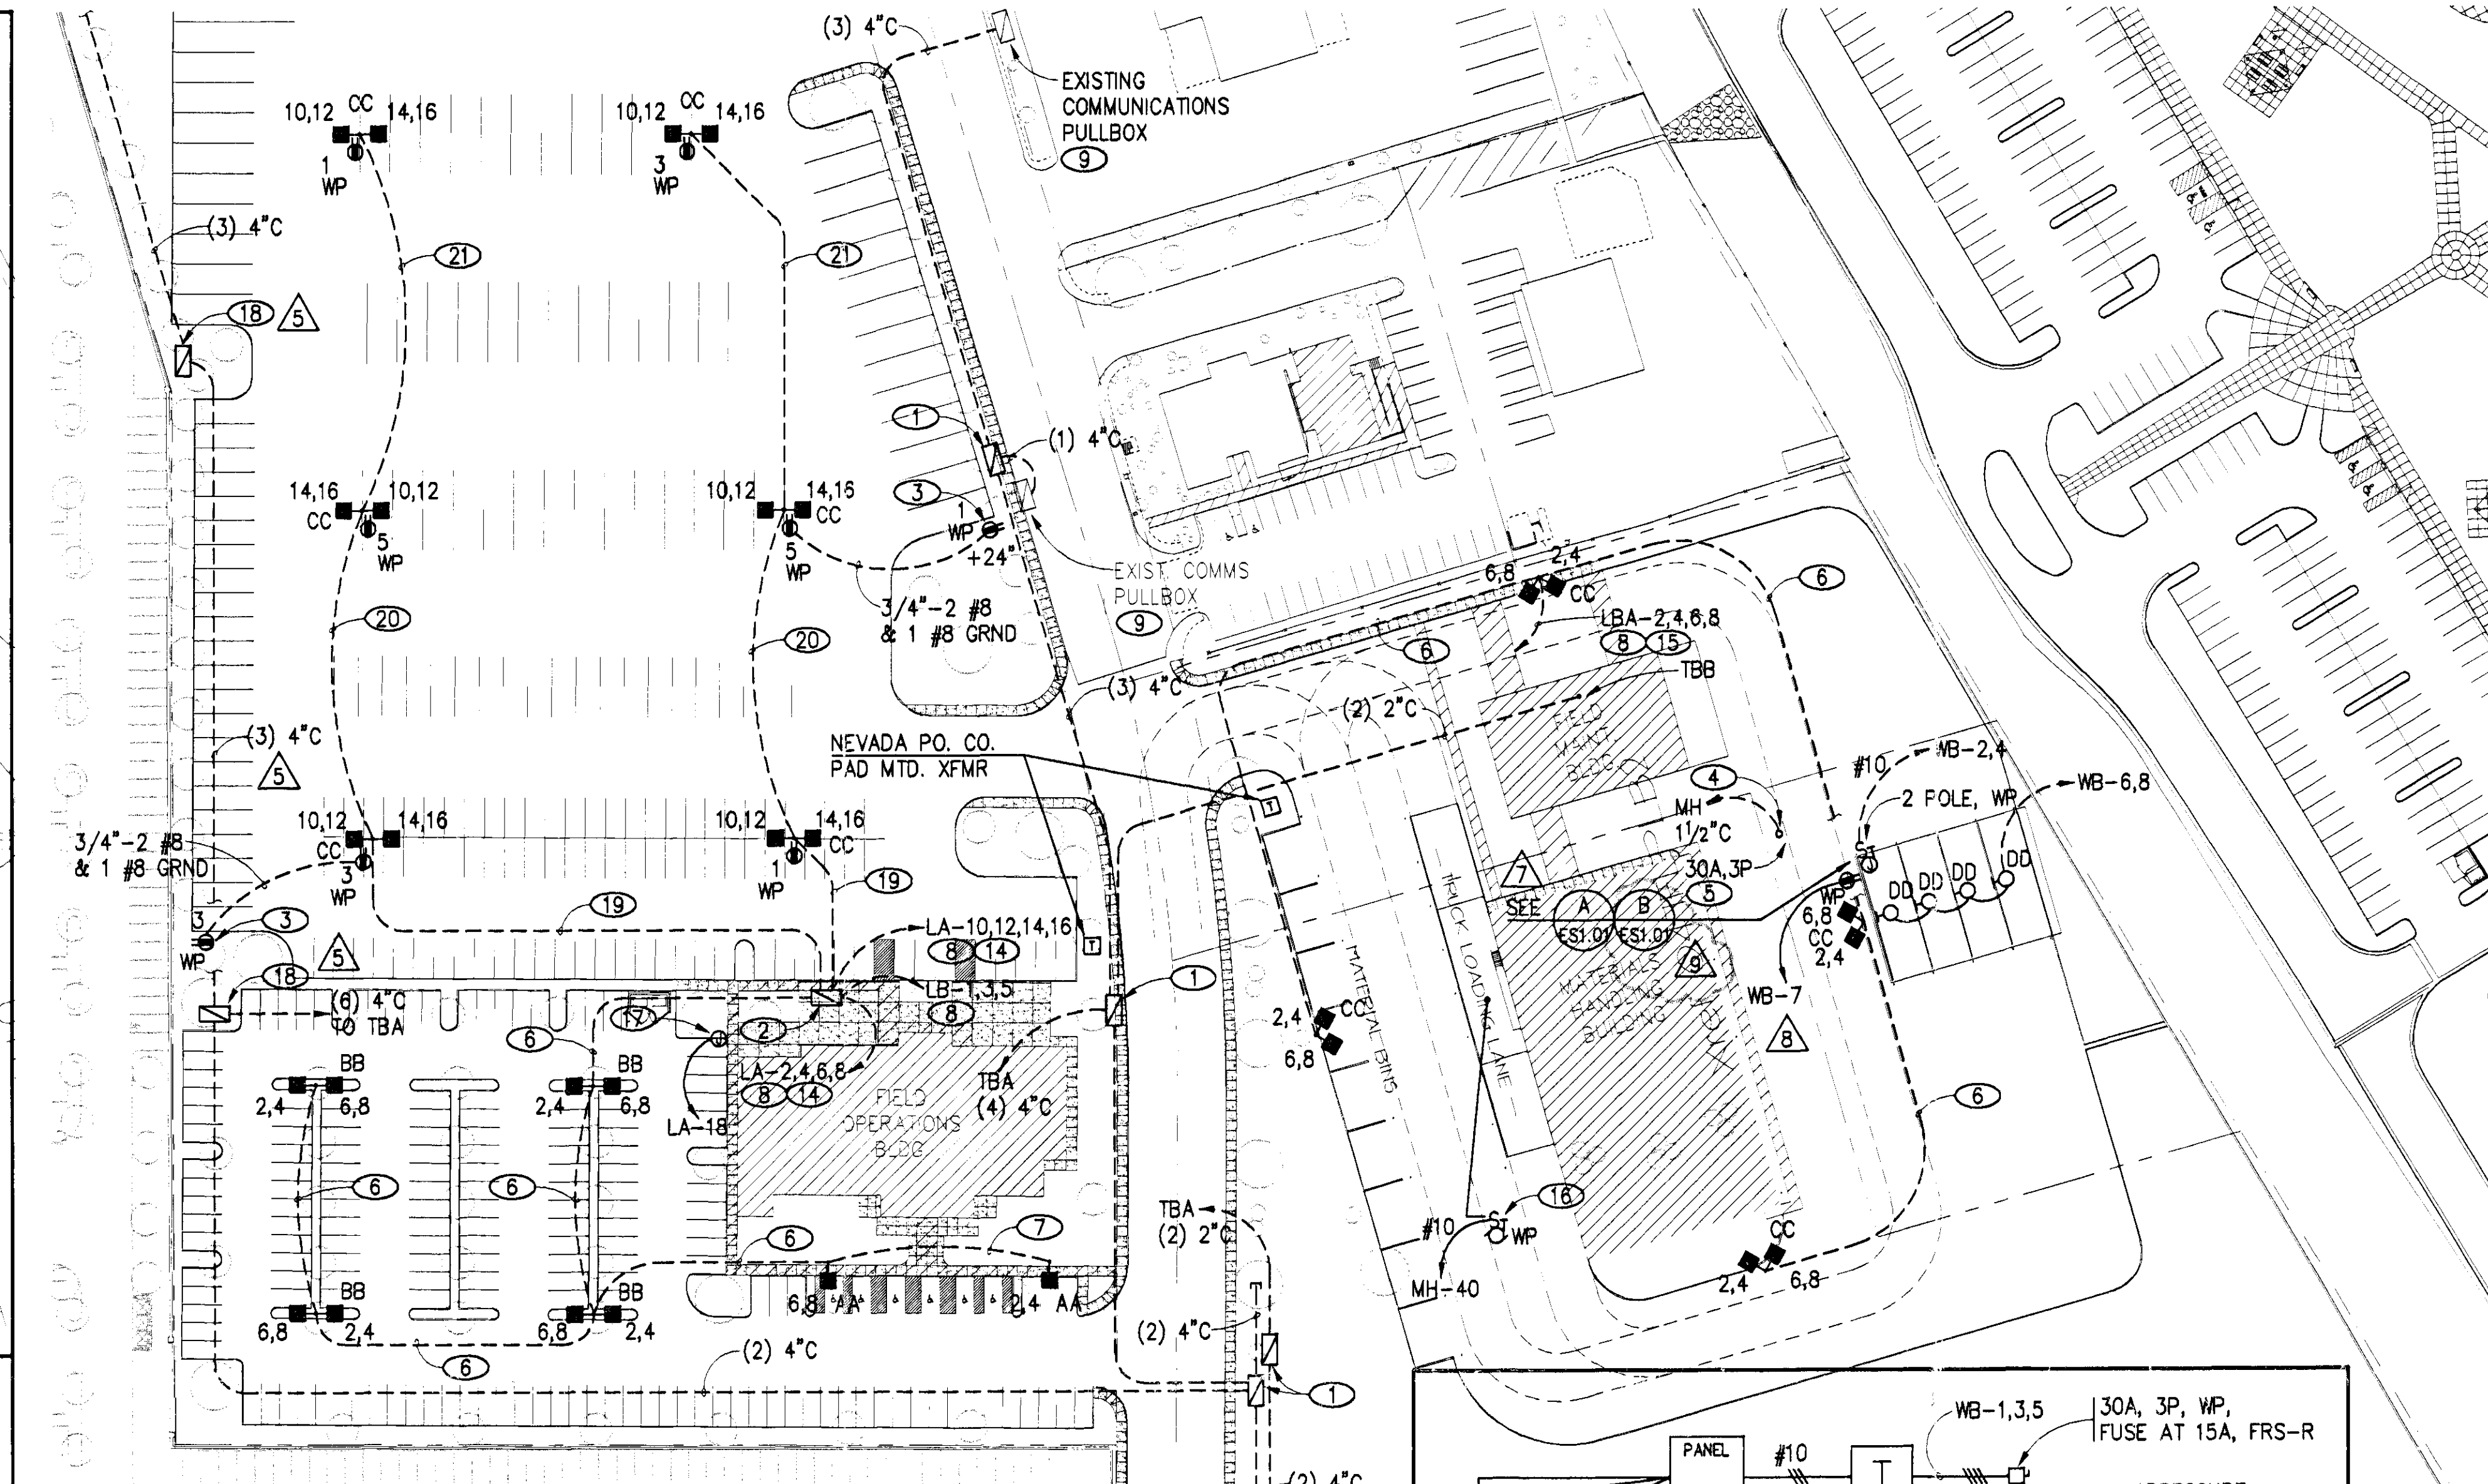

APPROVAL IS FOR CLOUDED
AREAS ~~FOR CLOUDED AREAS~~
ONLY. SEE ORIGINALS 

PLANS APPROVED
ELECTRICAL

SAT FEB 17 2004

- ## SITE PLAN - ELECTRICAL