



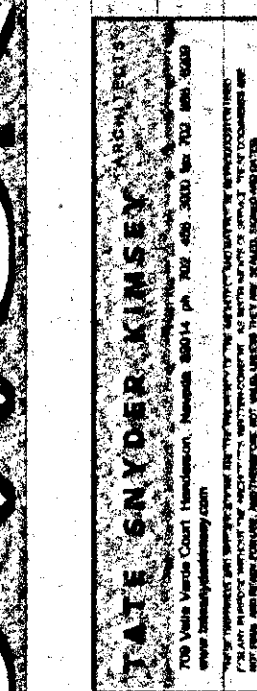

MAR. 14, 2003
OWNER REVISION

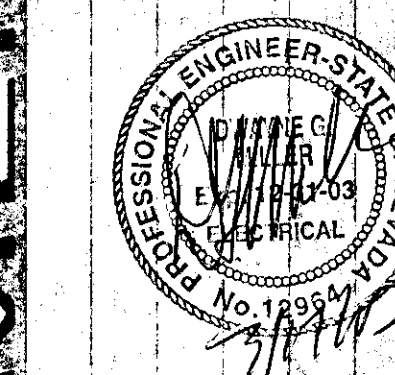

CITY OF LAS VEGAS WEST SERVICE YARD
BUFFALO DRIVE AND PEAK ROAD
LAS VEGAS, NEVADA
FLOOR PLAN - LIGHTING
MATERIALS HANDLING BUILDING



OWNER: CITY OF LAS VEGAS
DEPARTMENT OF PUBLIC WORKS
ARCHITECTURAL SERVICES

100 EAST STEWART AVENUE
LAS VEGAS, NEVADA 89101
PHONE: (702) 225-6335
FAX: (702) 386-5222
TDD: (702) 386-9108


DESIGN: YES
FILE: 64316112.DWG
DATE: 10.16.02
SCALE: 1/8" = 1'-0"

NO. 02.15341.09
REV. 107-V3548

E1.12

NOTES

- 1 FURNISH WITH 1200 LUMEN EMERGENCY BATTERY PACK, WIRED FOR SWITCHED OPERATION.
- 2 RELAY 'R-2', 20A, 8 POLE, N.O. WITH 120V COIL, NEMA 1 ENCLOSURE.
- 3 #10 THRU-OUT CIRCUIT.
- 4 20A, 4P, N.O. WITH 120V COIL, NEMA 1 ENCLOSURE.
- 5 FIXTURE UNSWITCHED FOR NIGHT LIGHTING.
- 6 ROUTE VIA RELAY 'R-2'.

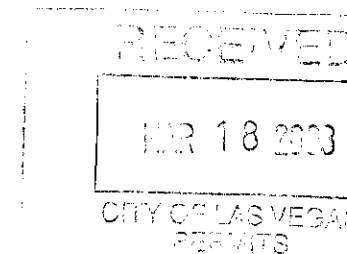

5 8 4 2 6 2

APPROVAL IS FOR CLOUSED
AREAS ONLY. SEE ORIGINALS

PLANS APPROVED
ELECTRICAL
Suzanne S. Soley, Esq.
City of Las Vegas, Nevada



SAZ MAR 20 2003

Draw Not to be Used for Structural, Architectural,
Plumbing, or Mechanical or Civil-
Engineering Purposes. Make No Change
without Approval of the Original Designer.
Not a Permit to Violate Any Ordinance.

FLOOR PLAN - LIGHTING

SCALE: 1/8" = 1'-0"

1

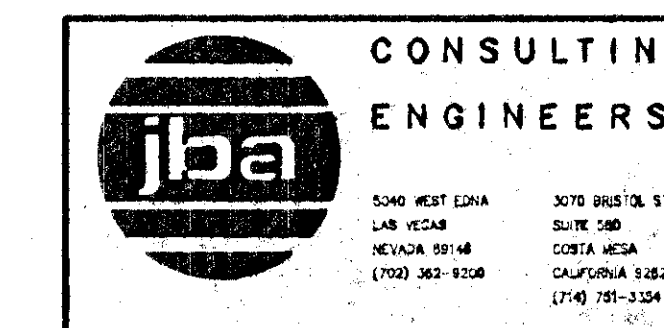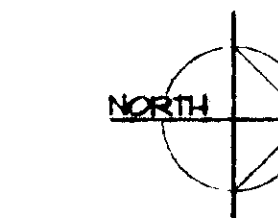

5040 WEST EDNA
LAS VEGAS

