


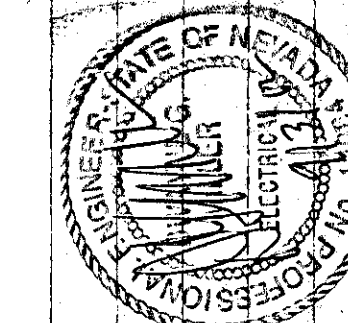

CONSULTAS

Abstract

CITY OF LAS VEGAS WEST SERVICE YARD
BUFFALO DRIVE AND PEAK ROAD
LAS VEGAS, NEVADA
FLOOR PLAN - POWER




OWNER: CITY OF LAS VEGAS
DEPARTMENT OF PUBLIC WORKS
ARCHITECTURAL SERVICE

400 EAST STEWART AVENUE
LAS VEGAS, NEVADA 89101
PHONE: (702) 229-6555
FAX: (702) 382-3223

DRAWN	YES
FILE	6431E214.DWG
DATE	03.15.02
SCALE	1/8" = 1'-0"
BID NO	02.15341.00
CLV DWG NO	107-V3548


E2.14

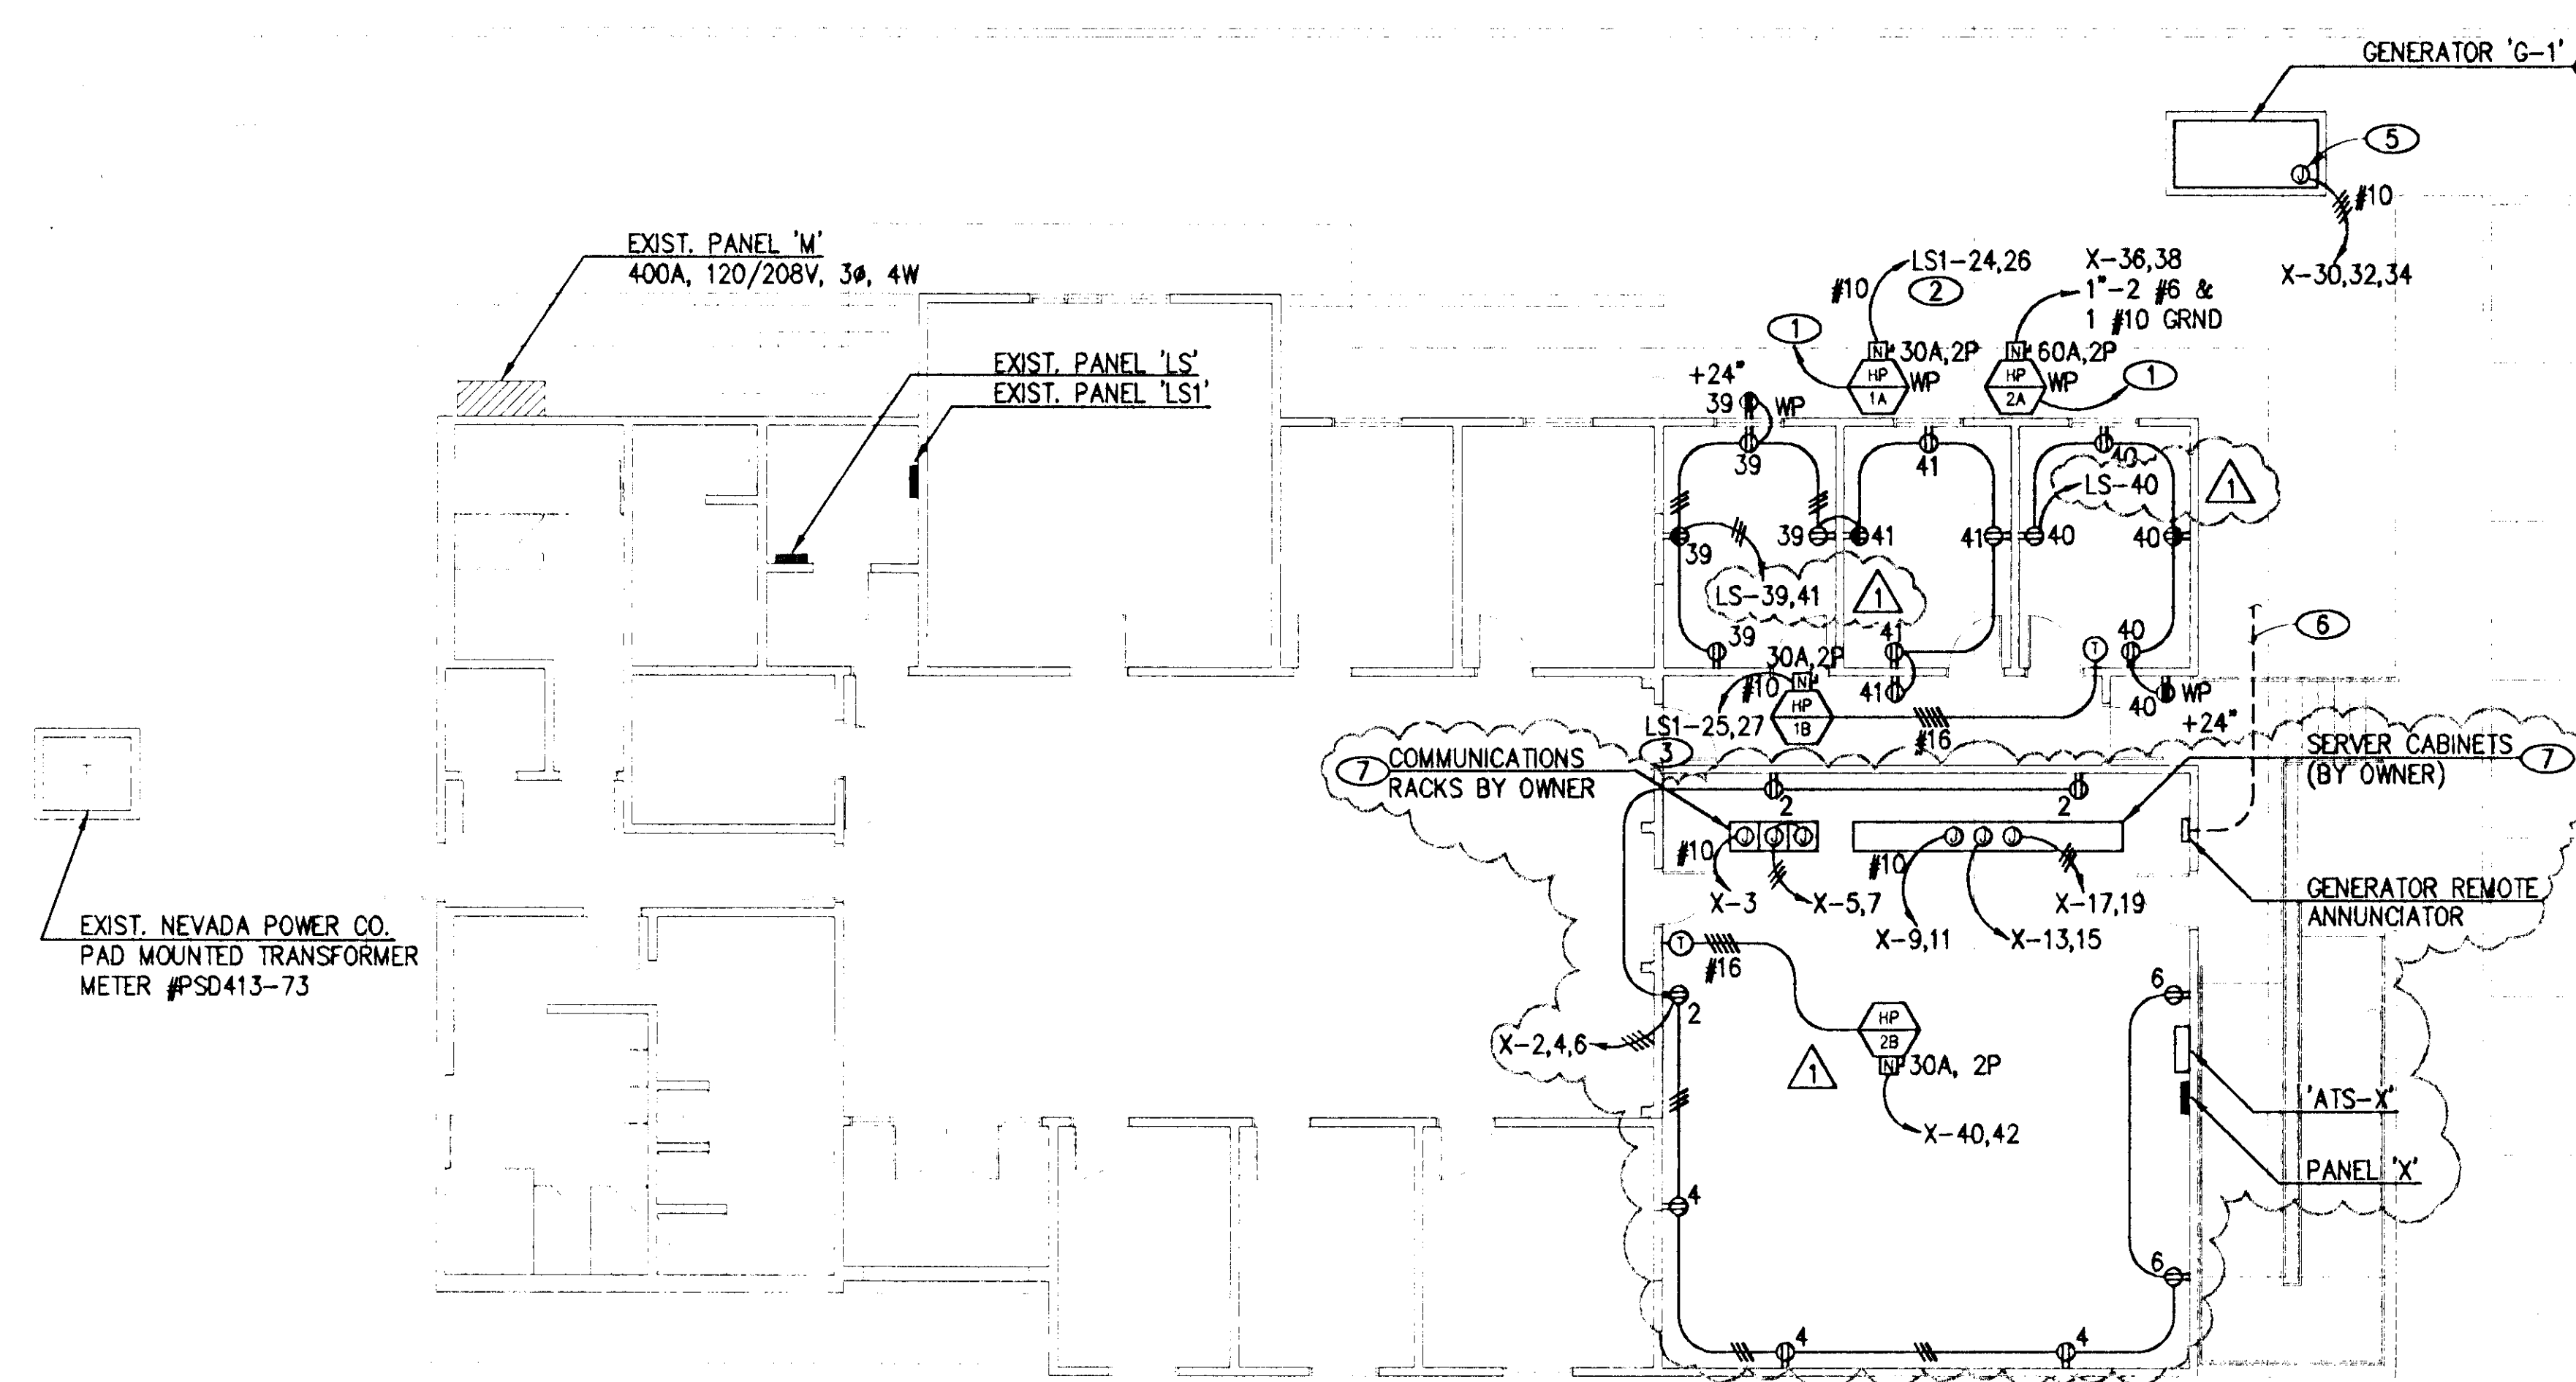

NOTES

- ① INTERLOCK WITH INDOOR UNIT.
- ② PROVIDE 25A, 2P IN EXISTING SPACE, MATCH EXISTING MANUFACTURER AND TYPE.
- ③ PROVIDE 30A, 2P IN EXISTING SPACE, MATCH EXISTING MANUFACTURER AND TYPE.
- ④ PROVIDE 8" THICK CONCRETE PAD WITH 4" EXTENDING ABOVE GRADE.
- ⑤ CONNECT TO TANK HEATER AND CHARGER.
- ⑥ TO GENERATOR, CONDUIT AND WIRE PER MANUFACTURER'S REQUIREMENTS.
- ⑦ VERIFY ROUGH-IN LOCATION AND HEIGHT WITH OWNER, CONNECT TO EQUIPMENT RACKS.

CLOOF PLAN - POWER

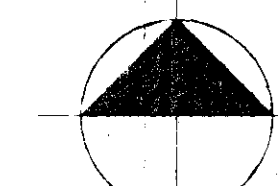

PLANS APPROVE

RECEIVED

SAZ SEP 13 2002

CITY OF LAS VEGAS
Does Not include Signature, Stamp
Plumbing Mechanical or Electrical
License or Make No City

**Improvements Make No Change
Without Approval Plan Is
Not a Permit to Violate Any Ordinance**

CONSULTING
ENGINEERS

3040 WEST EDNA 3070 BRIT

LAS VEGAS 2247 508
NEVADA 88146
(702) 352-9200

1998, 1999, 2000,26