


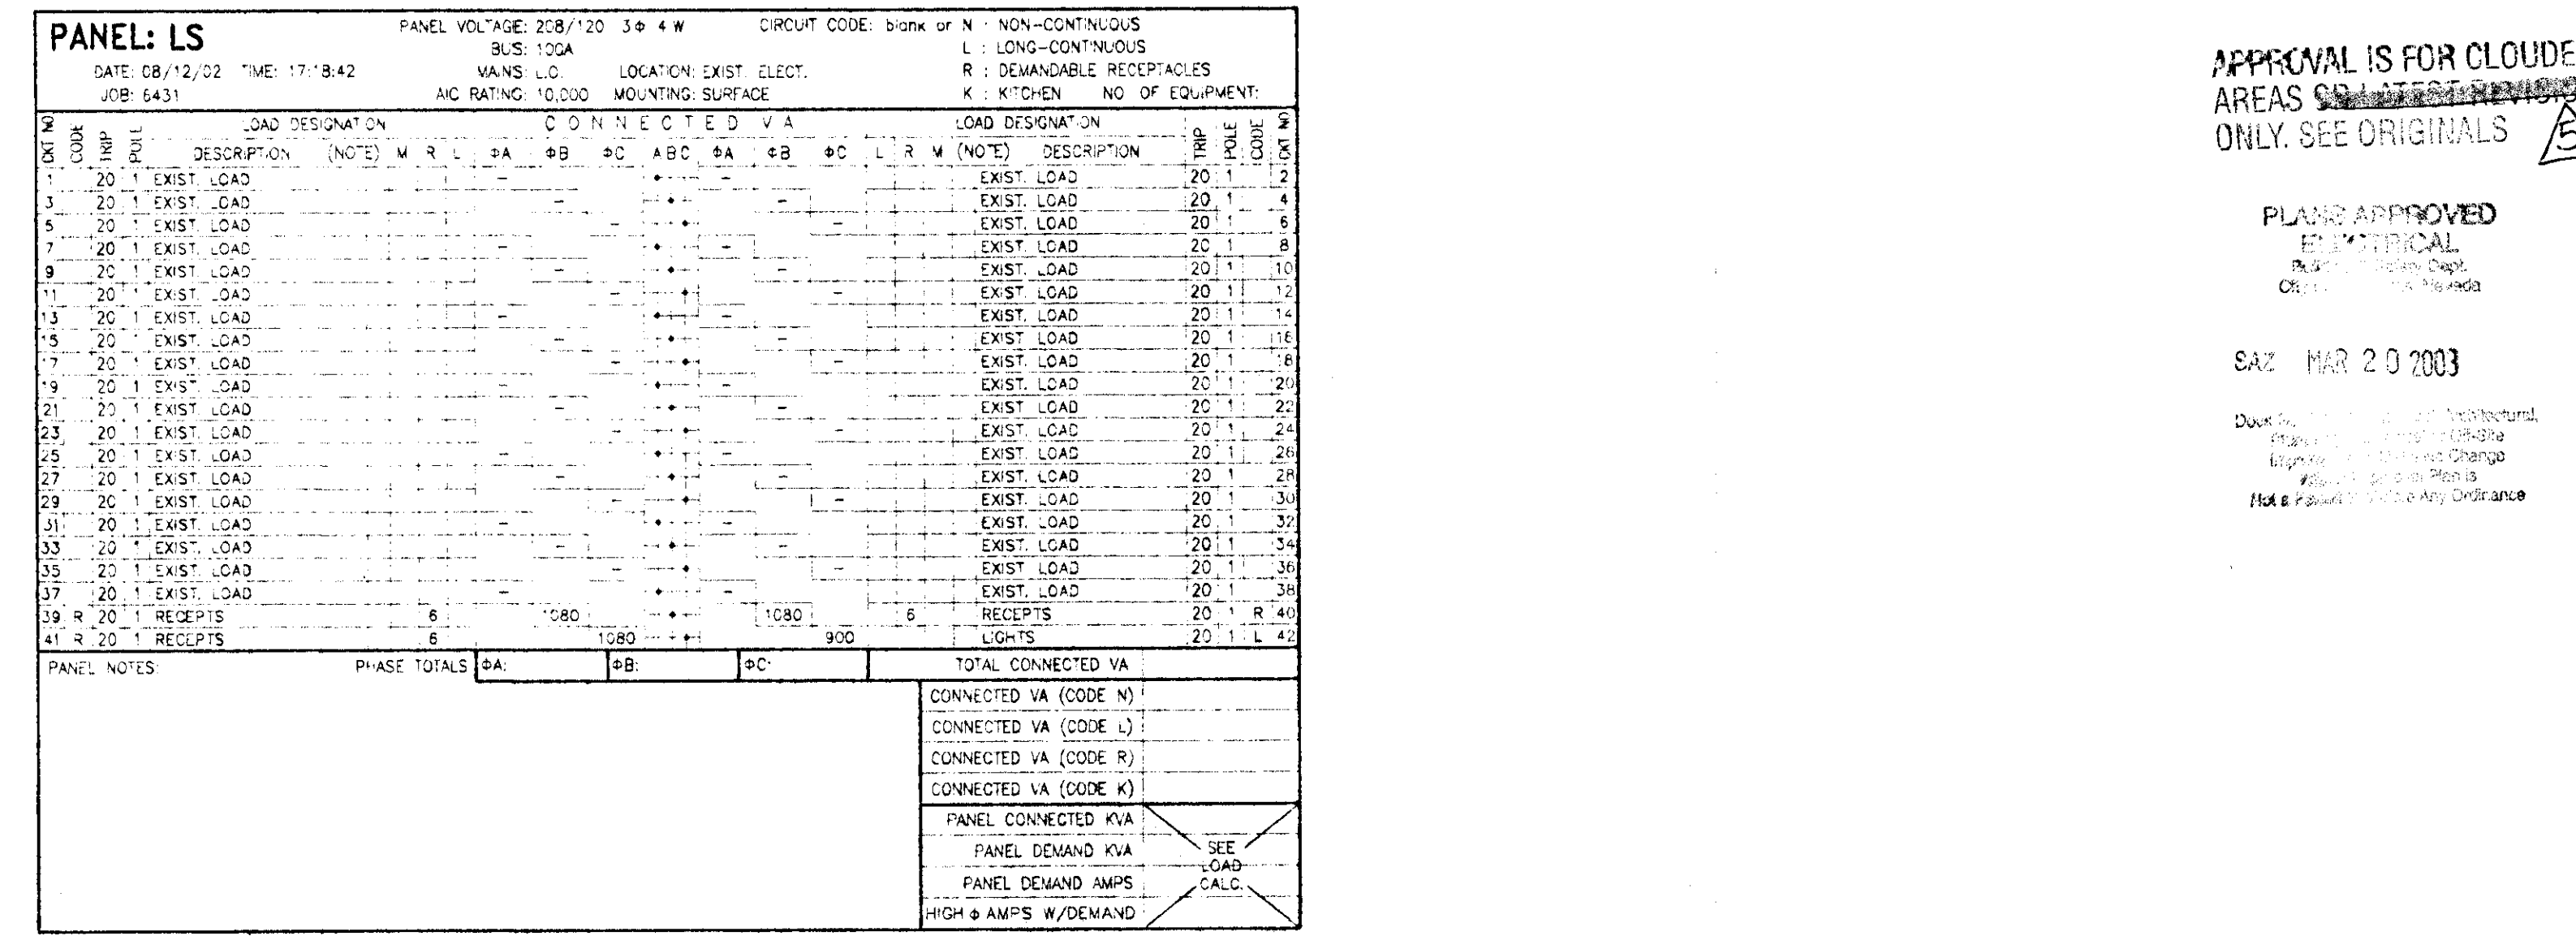

E5.02