



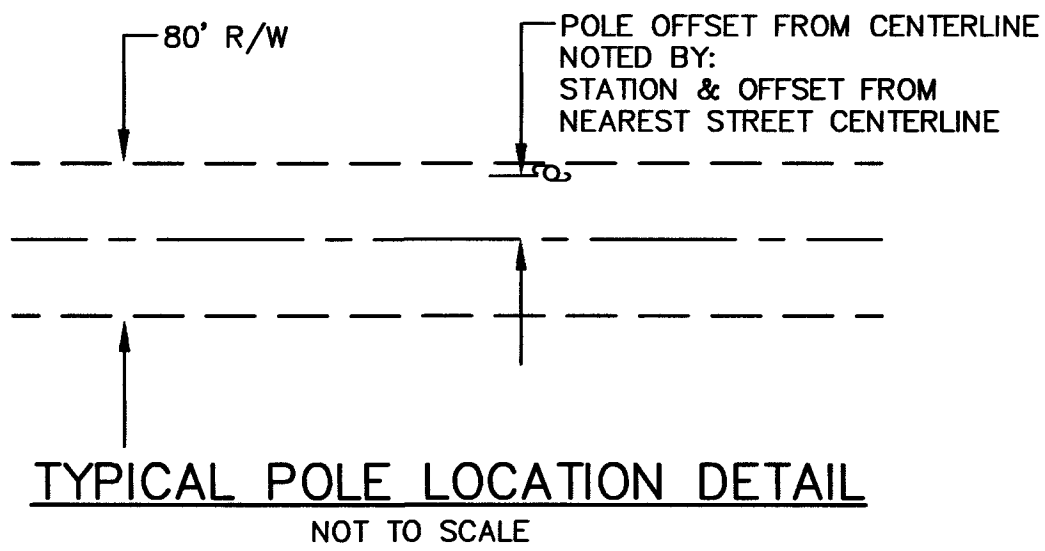


LENGTH OF FIBER CABLE IN
RIGHT-OF-WAY
SHEET 4
CITY = 1905.1 FT.

LEGEND

————	PROPERTY LINE
- - - - -	RIGHT-OF-WAY LINE
————	STREET CENTERLINE
—●—	EXISTING POWER LINE
●	POWER POLES
—●—	FOUND MONUMENT AS NOTED
- - - - -	144 CT FIBER IN CITY RIGHT-OF-WAY (UNDERGROUND IN CONDUIT)
————	144 CT FIBER IN CITY RIGHT-OF-WAY (OVERHEAD ON NPC POLES)
————	144 CT FIBER OUT OF RIGHT-OF-WAY (OVERHEAD ON NPC POLES)
- - - - -	144 CT FIBER OUT OF RIGHT-OF-WAY (UNDERGROUND IN CONDUIT)

STATIONING STARTING POINT NOTE:
0+00.0 REFERENCES CENTERLINE ALONG THE
ROUTE AND BEGINS AT THE FOUND 1-1/2" ALUM. CAP IN THE CENTERLINE OF ALTA DRIVE APPROXIMATELY 1632.1 FEET EAST OF THE INTERSECTION OF VALLEY VIEW BOULEVARD AND ALTA DRIVE. (SEE SHEET 3 OF 18 FOR FOUND MONUMENTS AND STATIONING.)

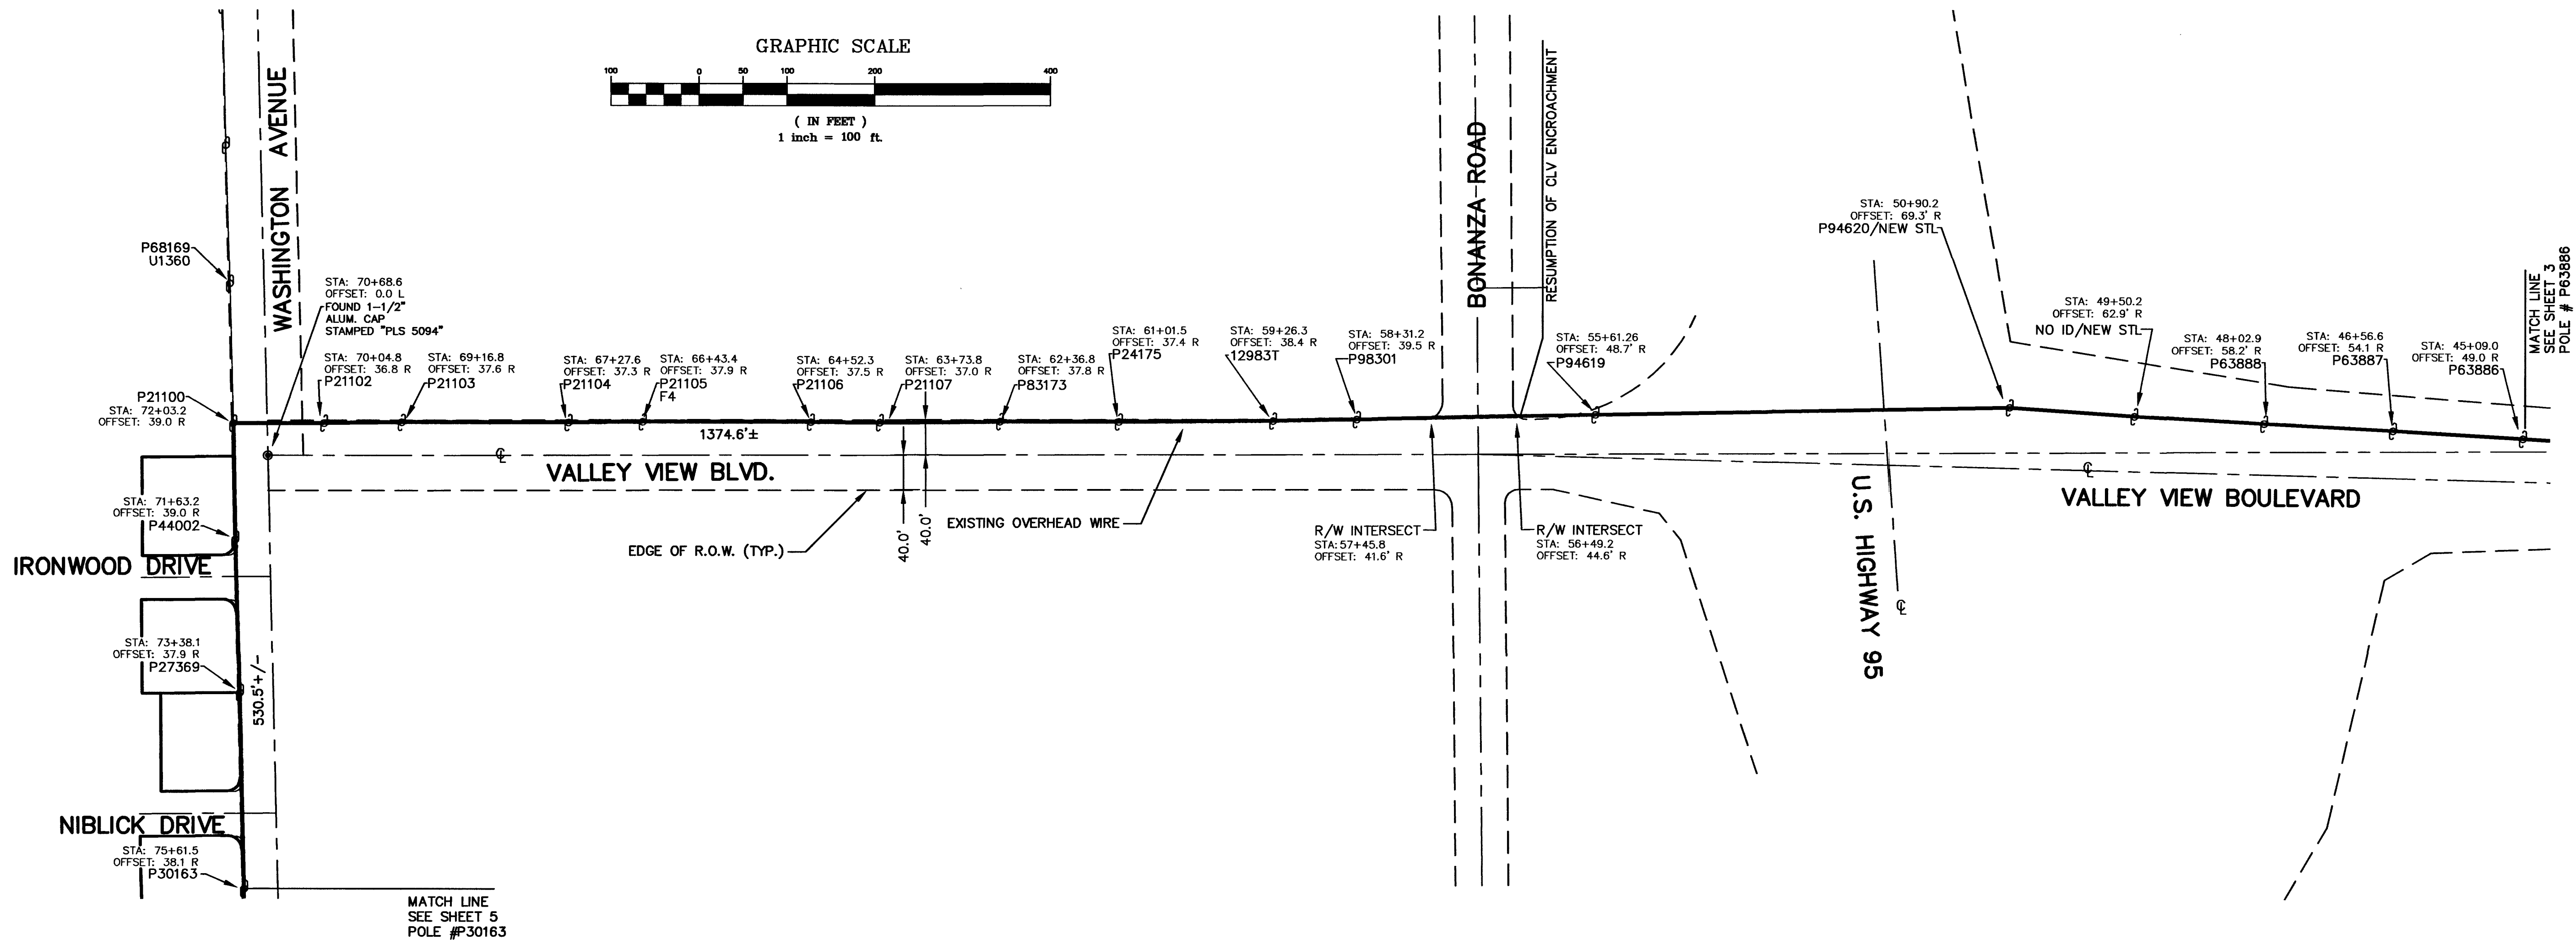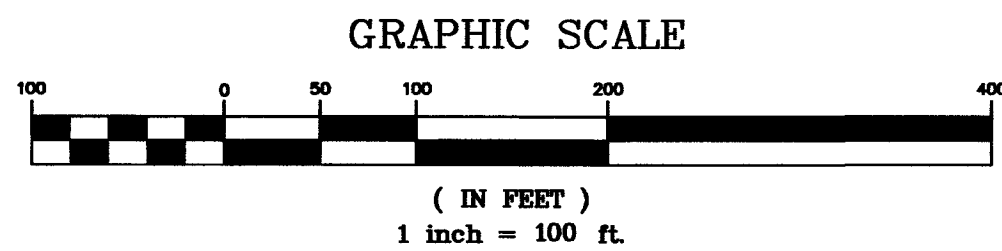

Sierra Pacific
Communications

5860 S. PECOS BLVD. G. STE. 100
LAS VEGAS, NV 89120
PHONE: 702-949-7931
FAX: 702-949-7929


SPECTRUM
SURVEYING & ENGINEERING

7351 W. CHARLESTON BOULEVARD
SUITE 120
LAS VEGAS, NEVADA 89117
PH: (702) 367-7705
FAX (702) 367-8733

WESTERN LOOP
CLV PERMIT ROUTE
ALTA DRIVE
TO
WEST GOWAN ROAD

DRAWING INFORMATION

DATE:	04/11/2002
JOB NO:	SIERRA PACIFIC
DRAWN:	D. W./J. C./M. Y.
CHECKED:	CW
SCALE:	1" = 100'
CAD FILE:	PH2-CLV-ALTA-GOWAN

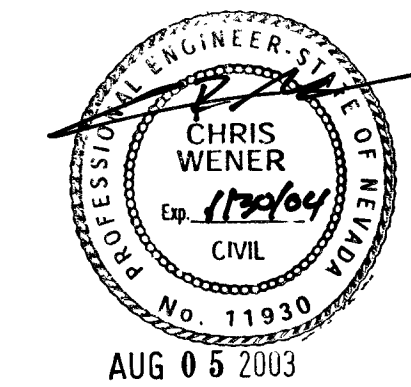

W.O. NUMBER 2001 - 055	ROUTE PLAN	SHEET 4 OF 18
---------------------------	------------	---------------