

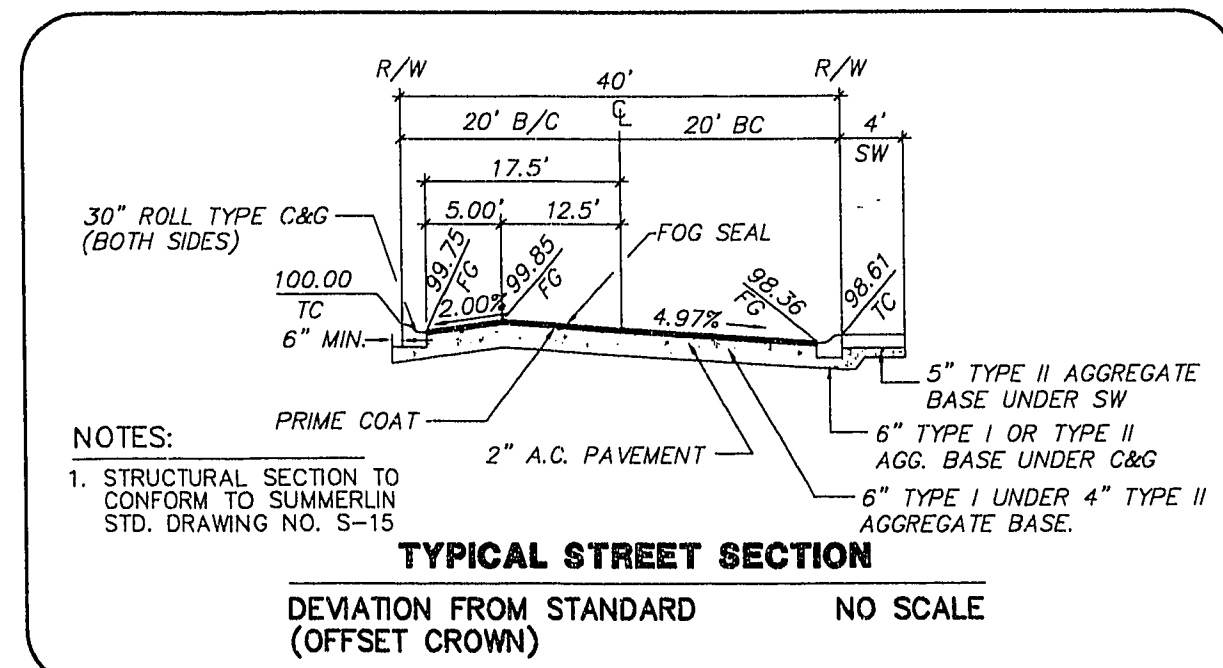
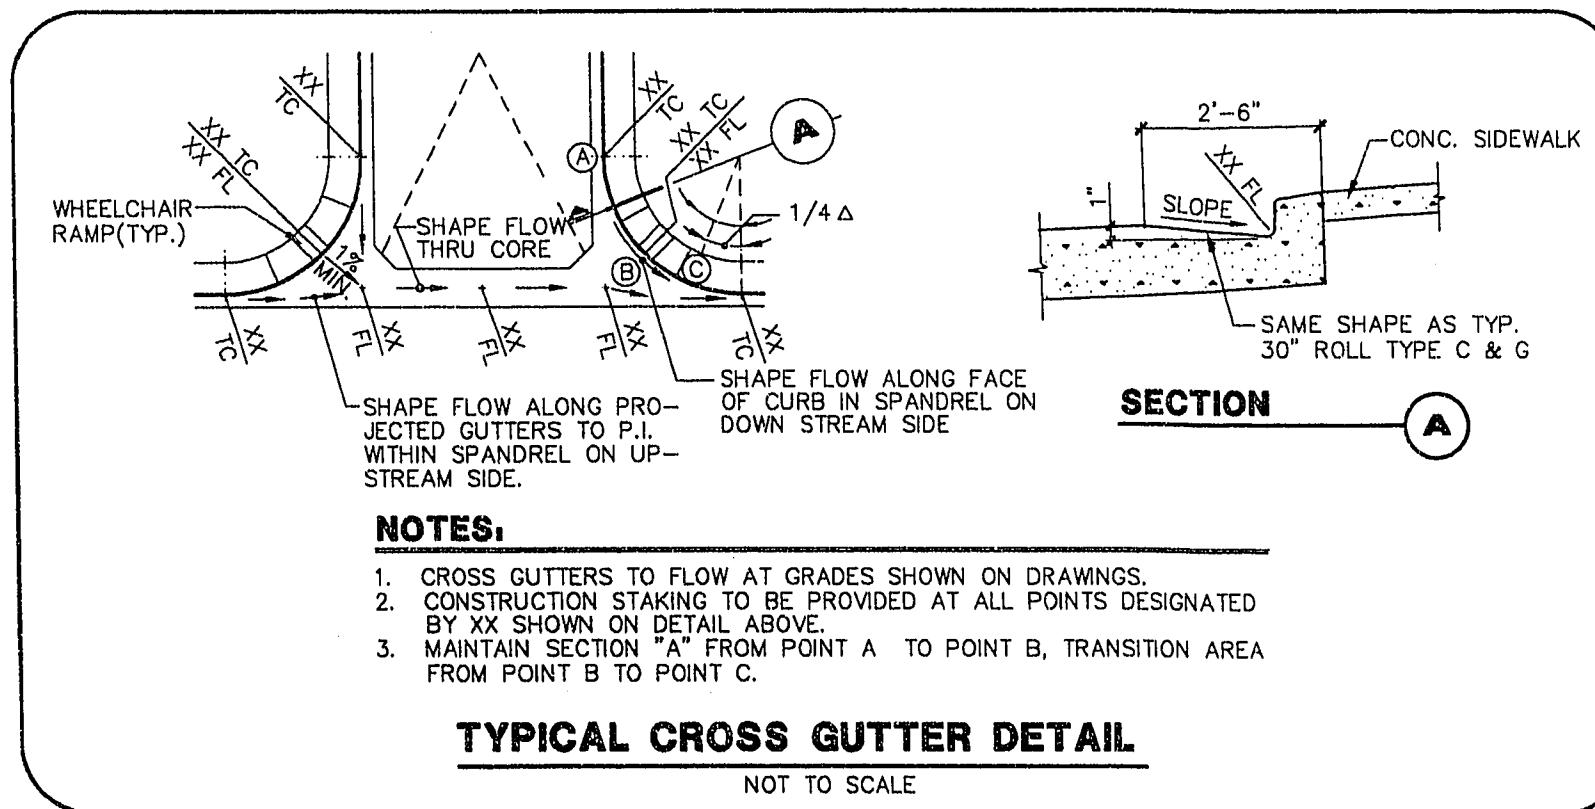
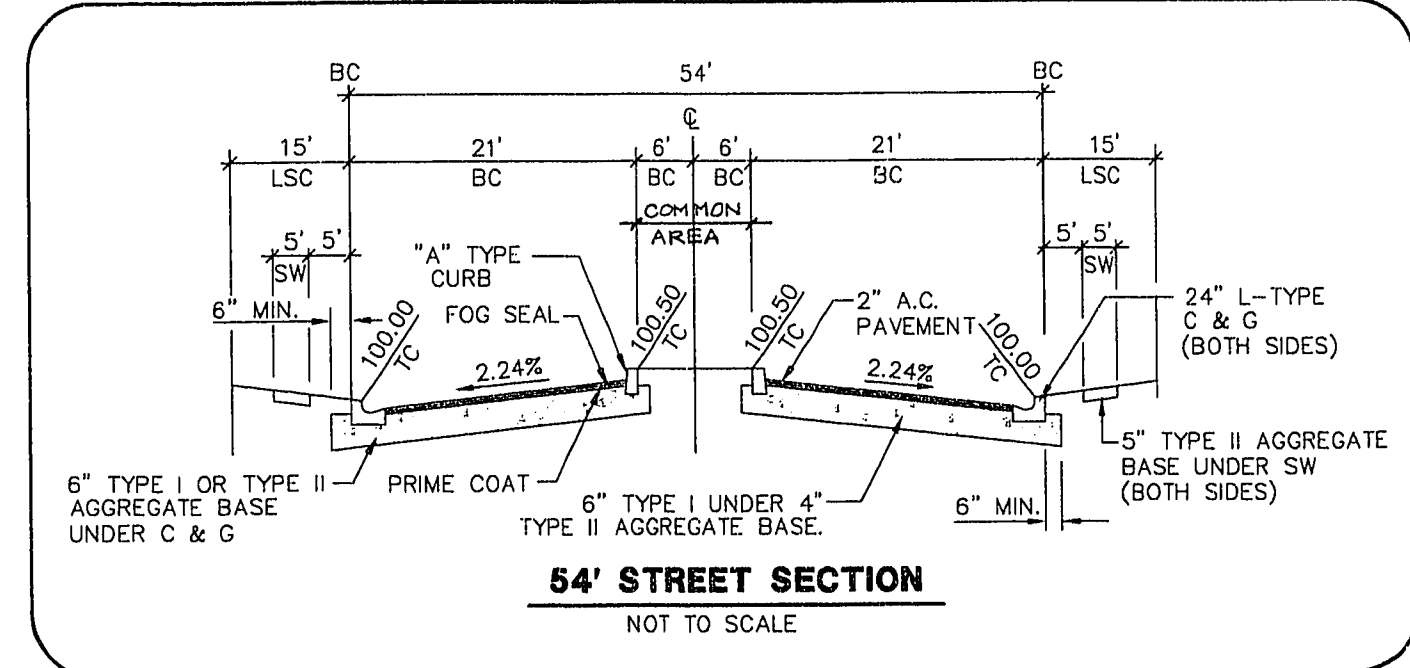
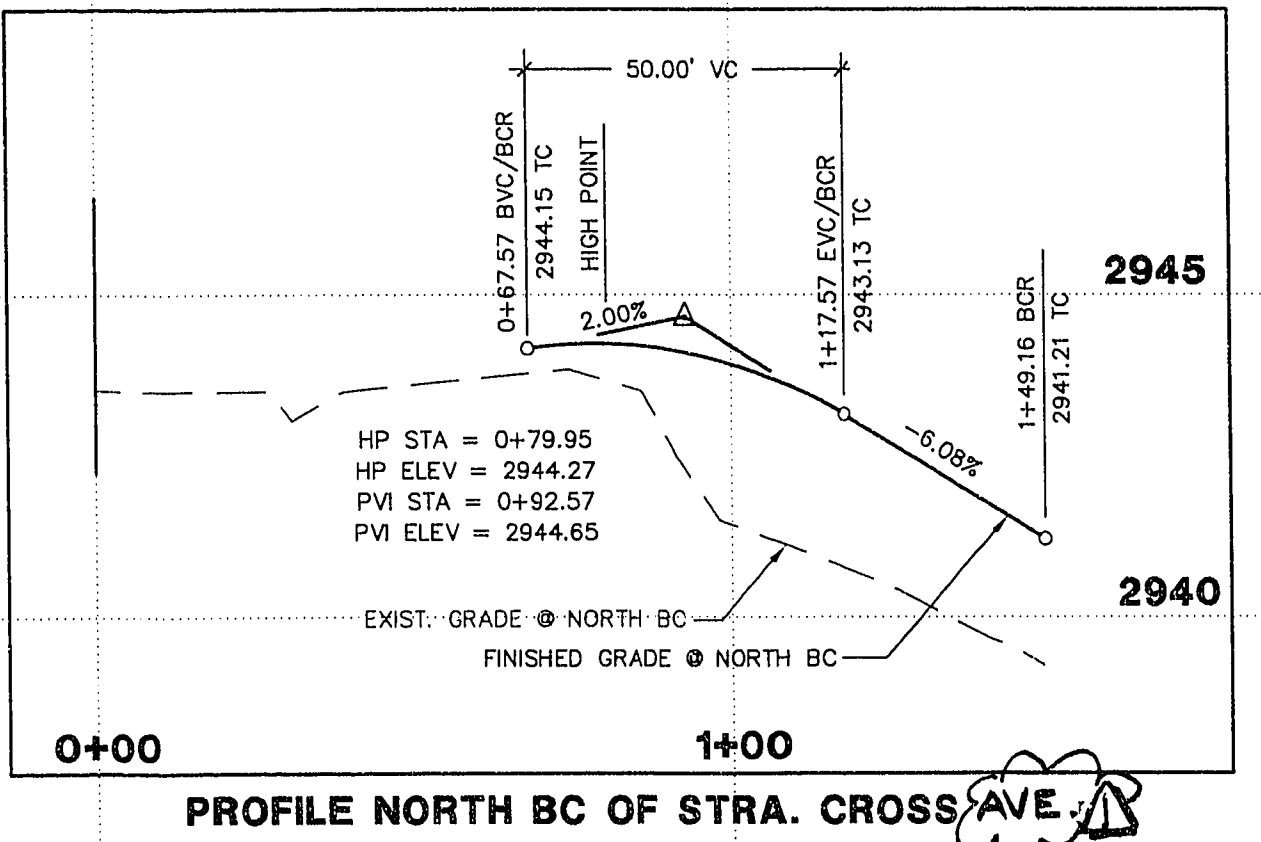
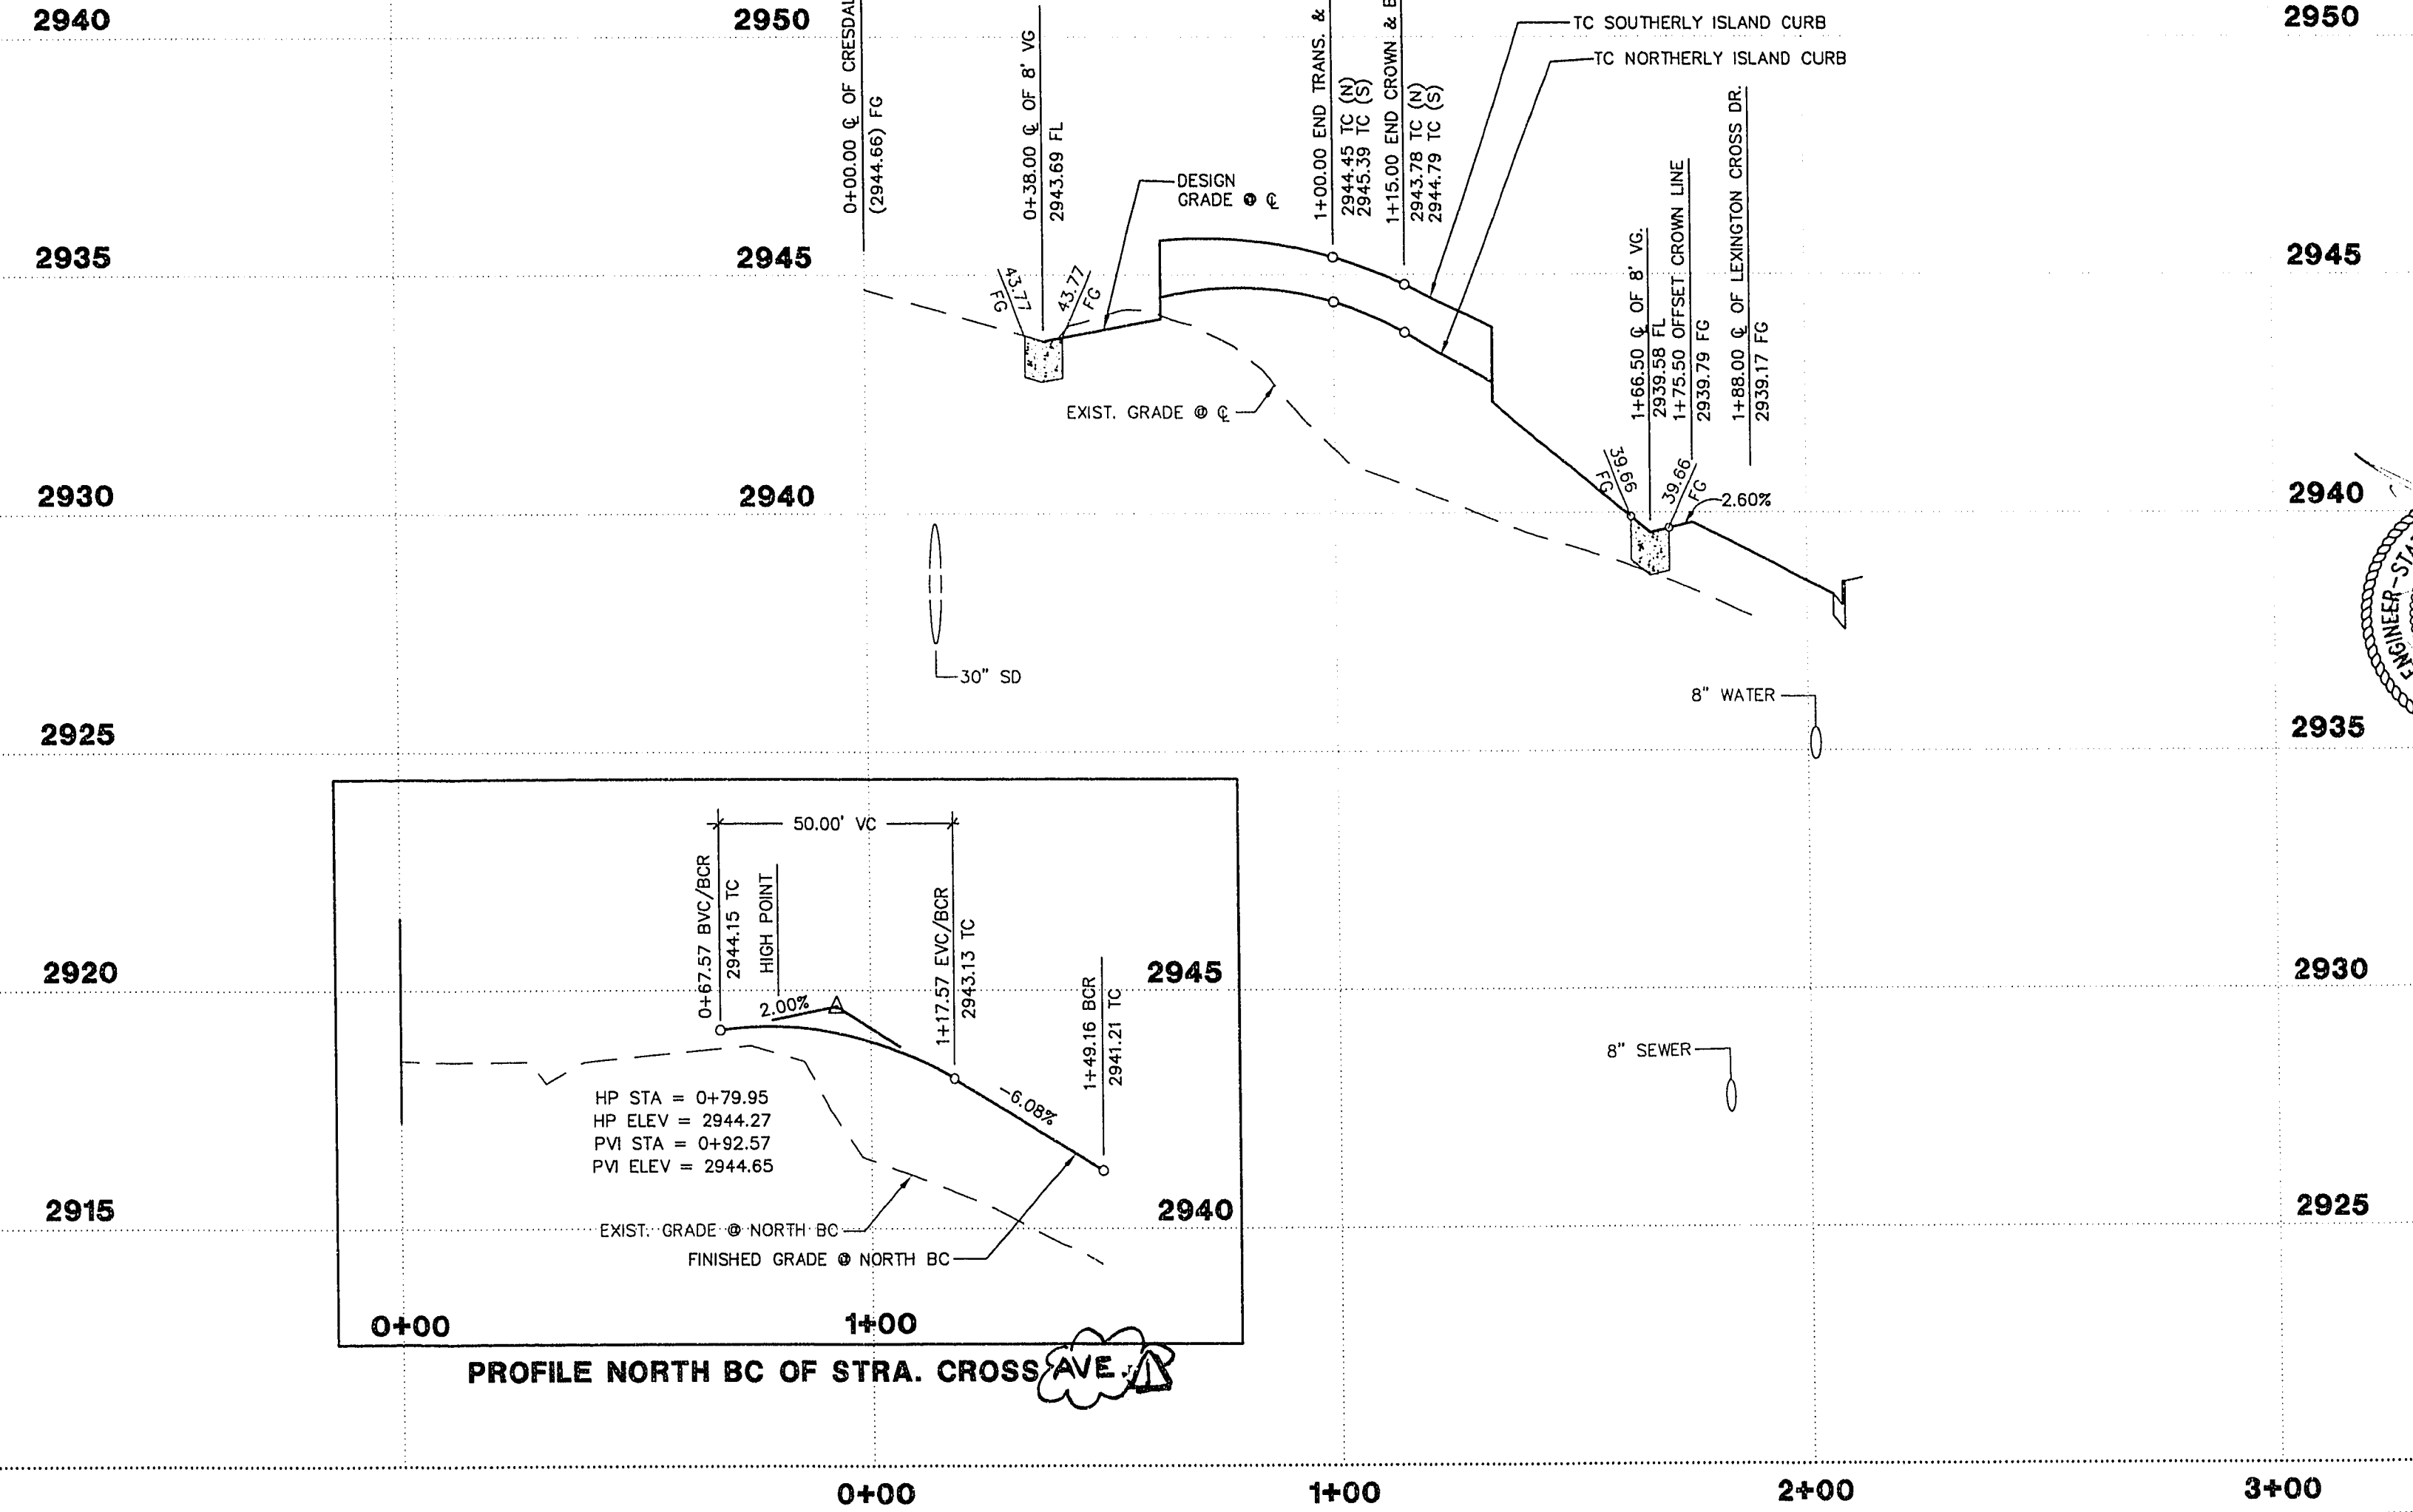
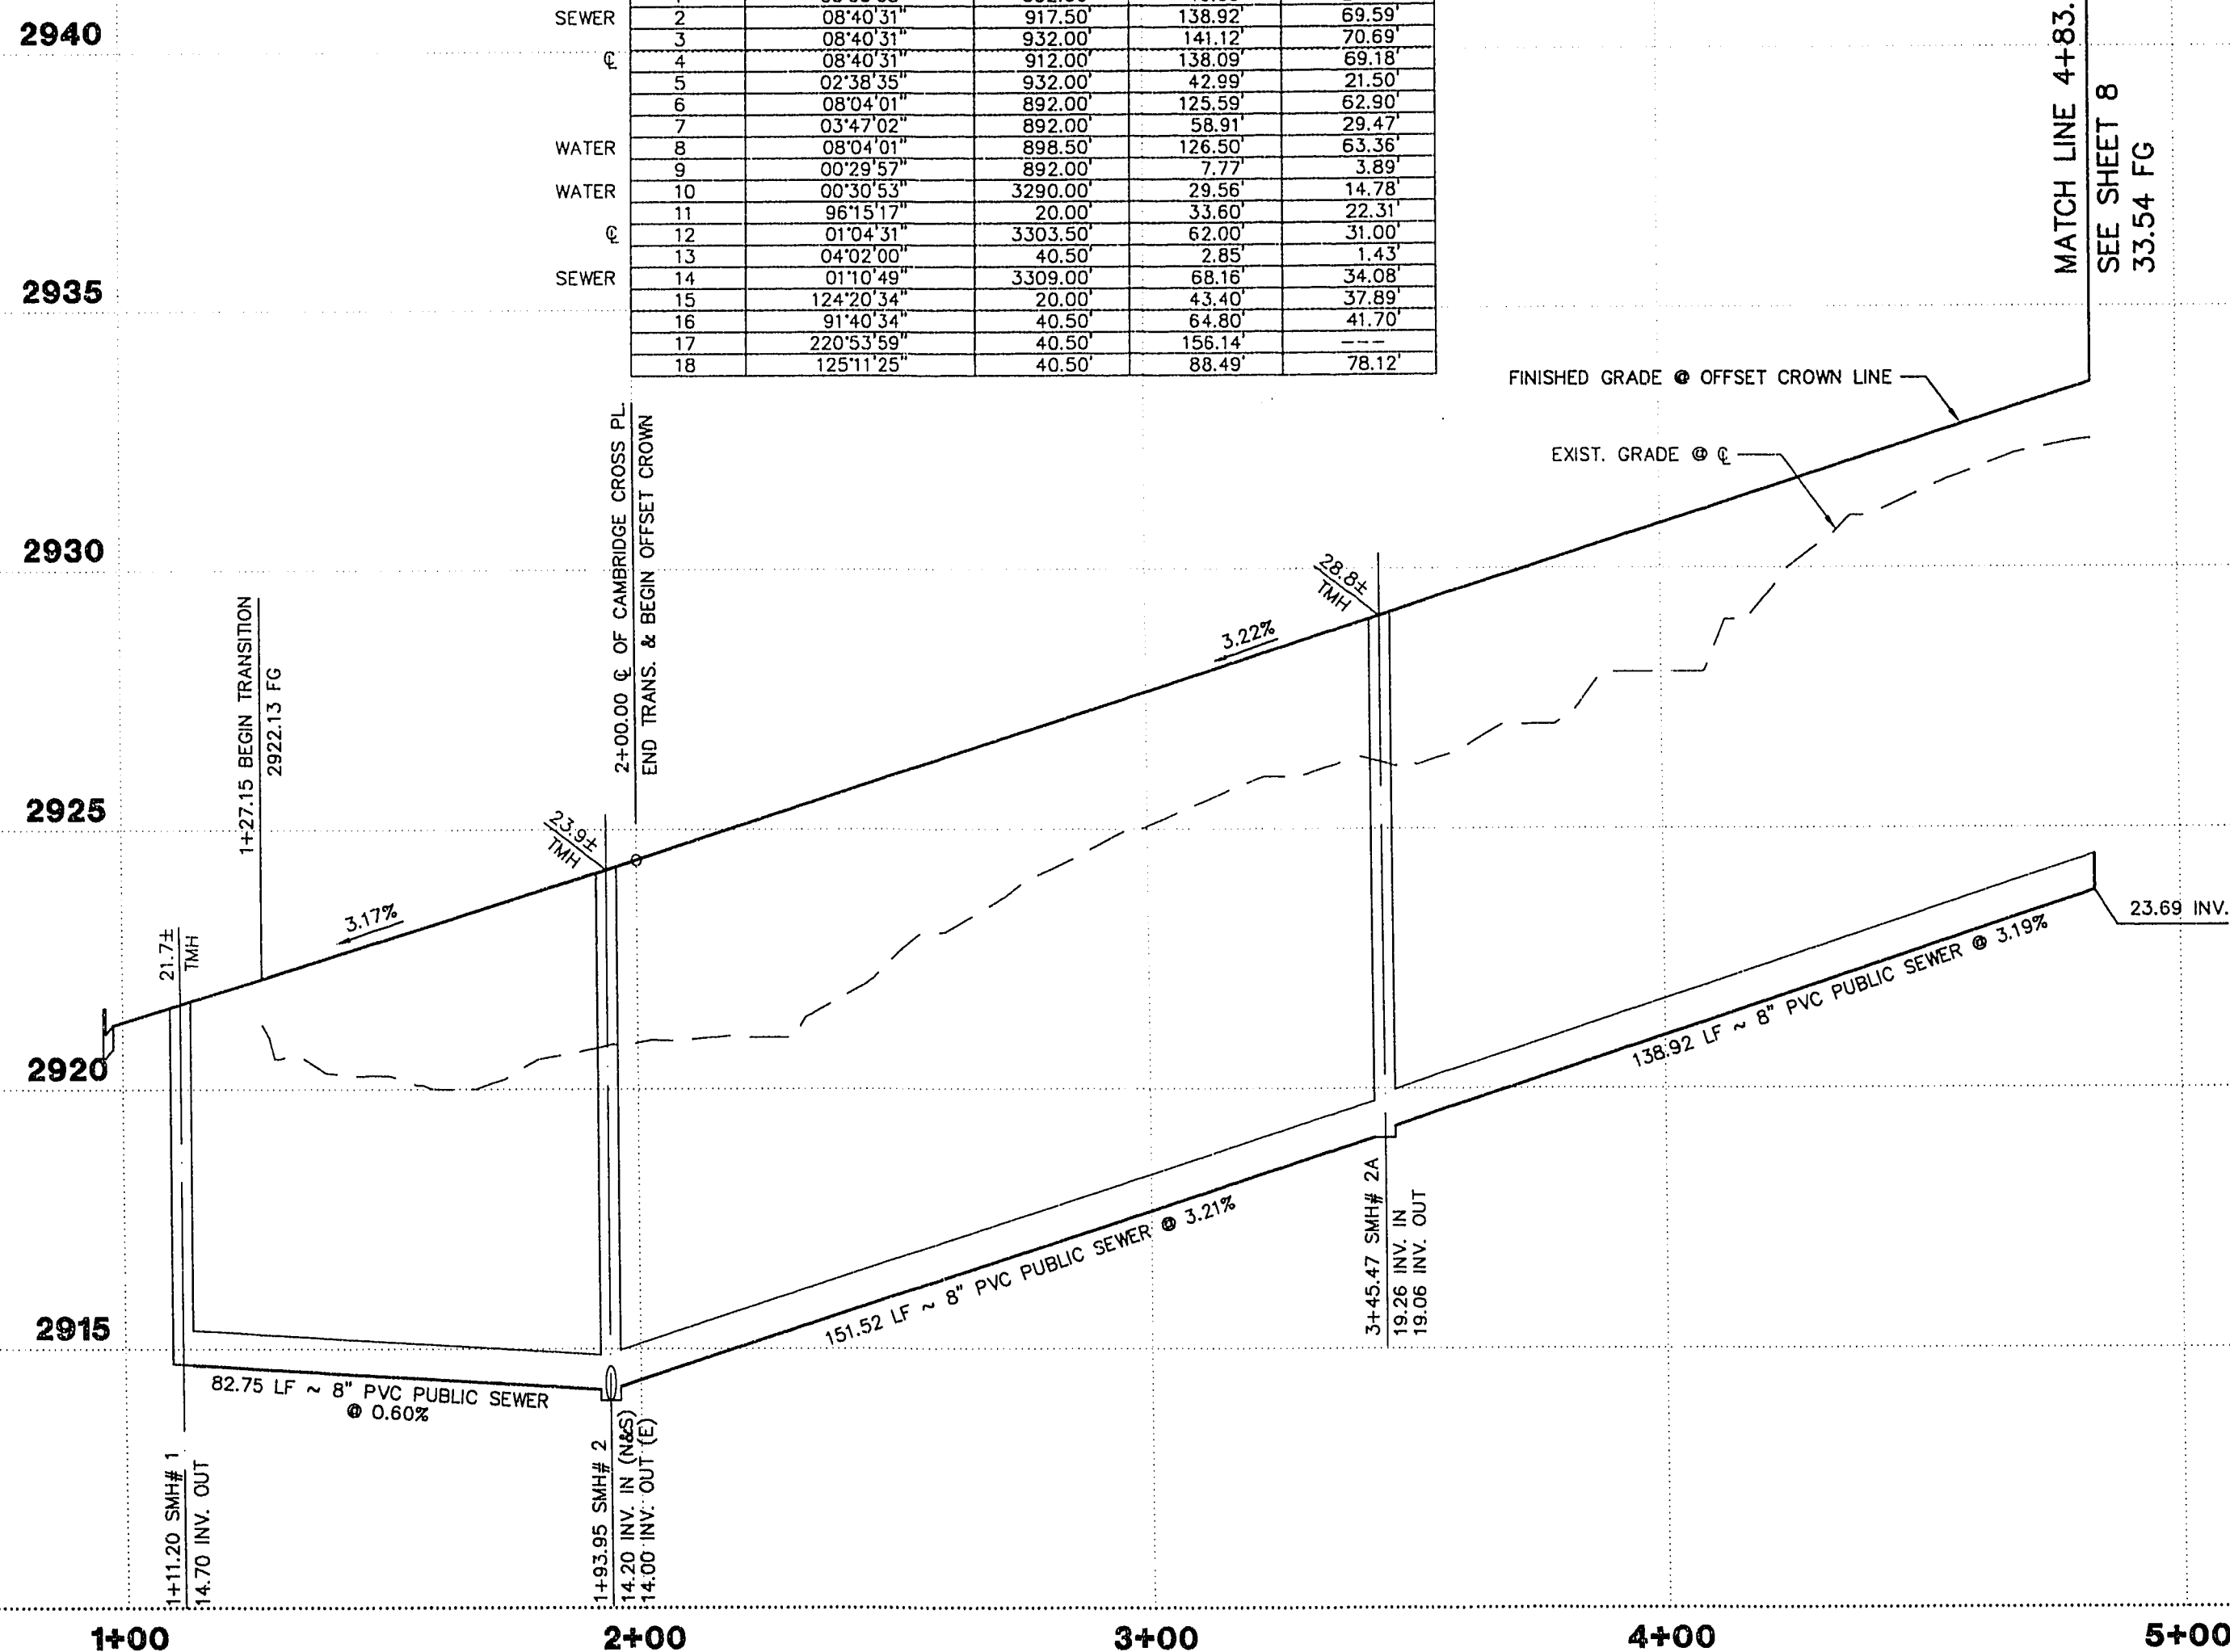
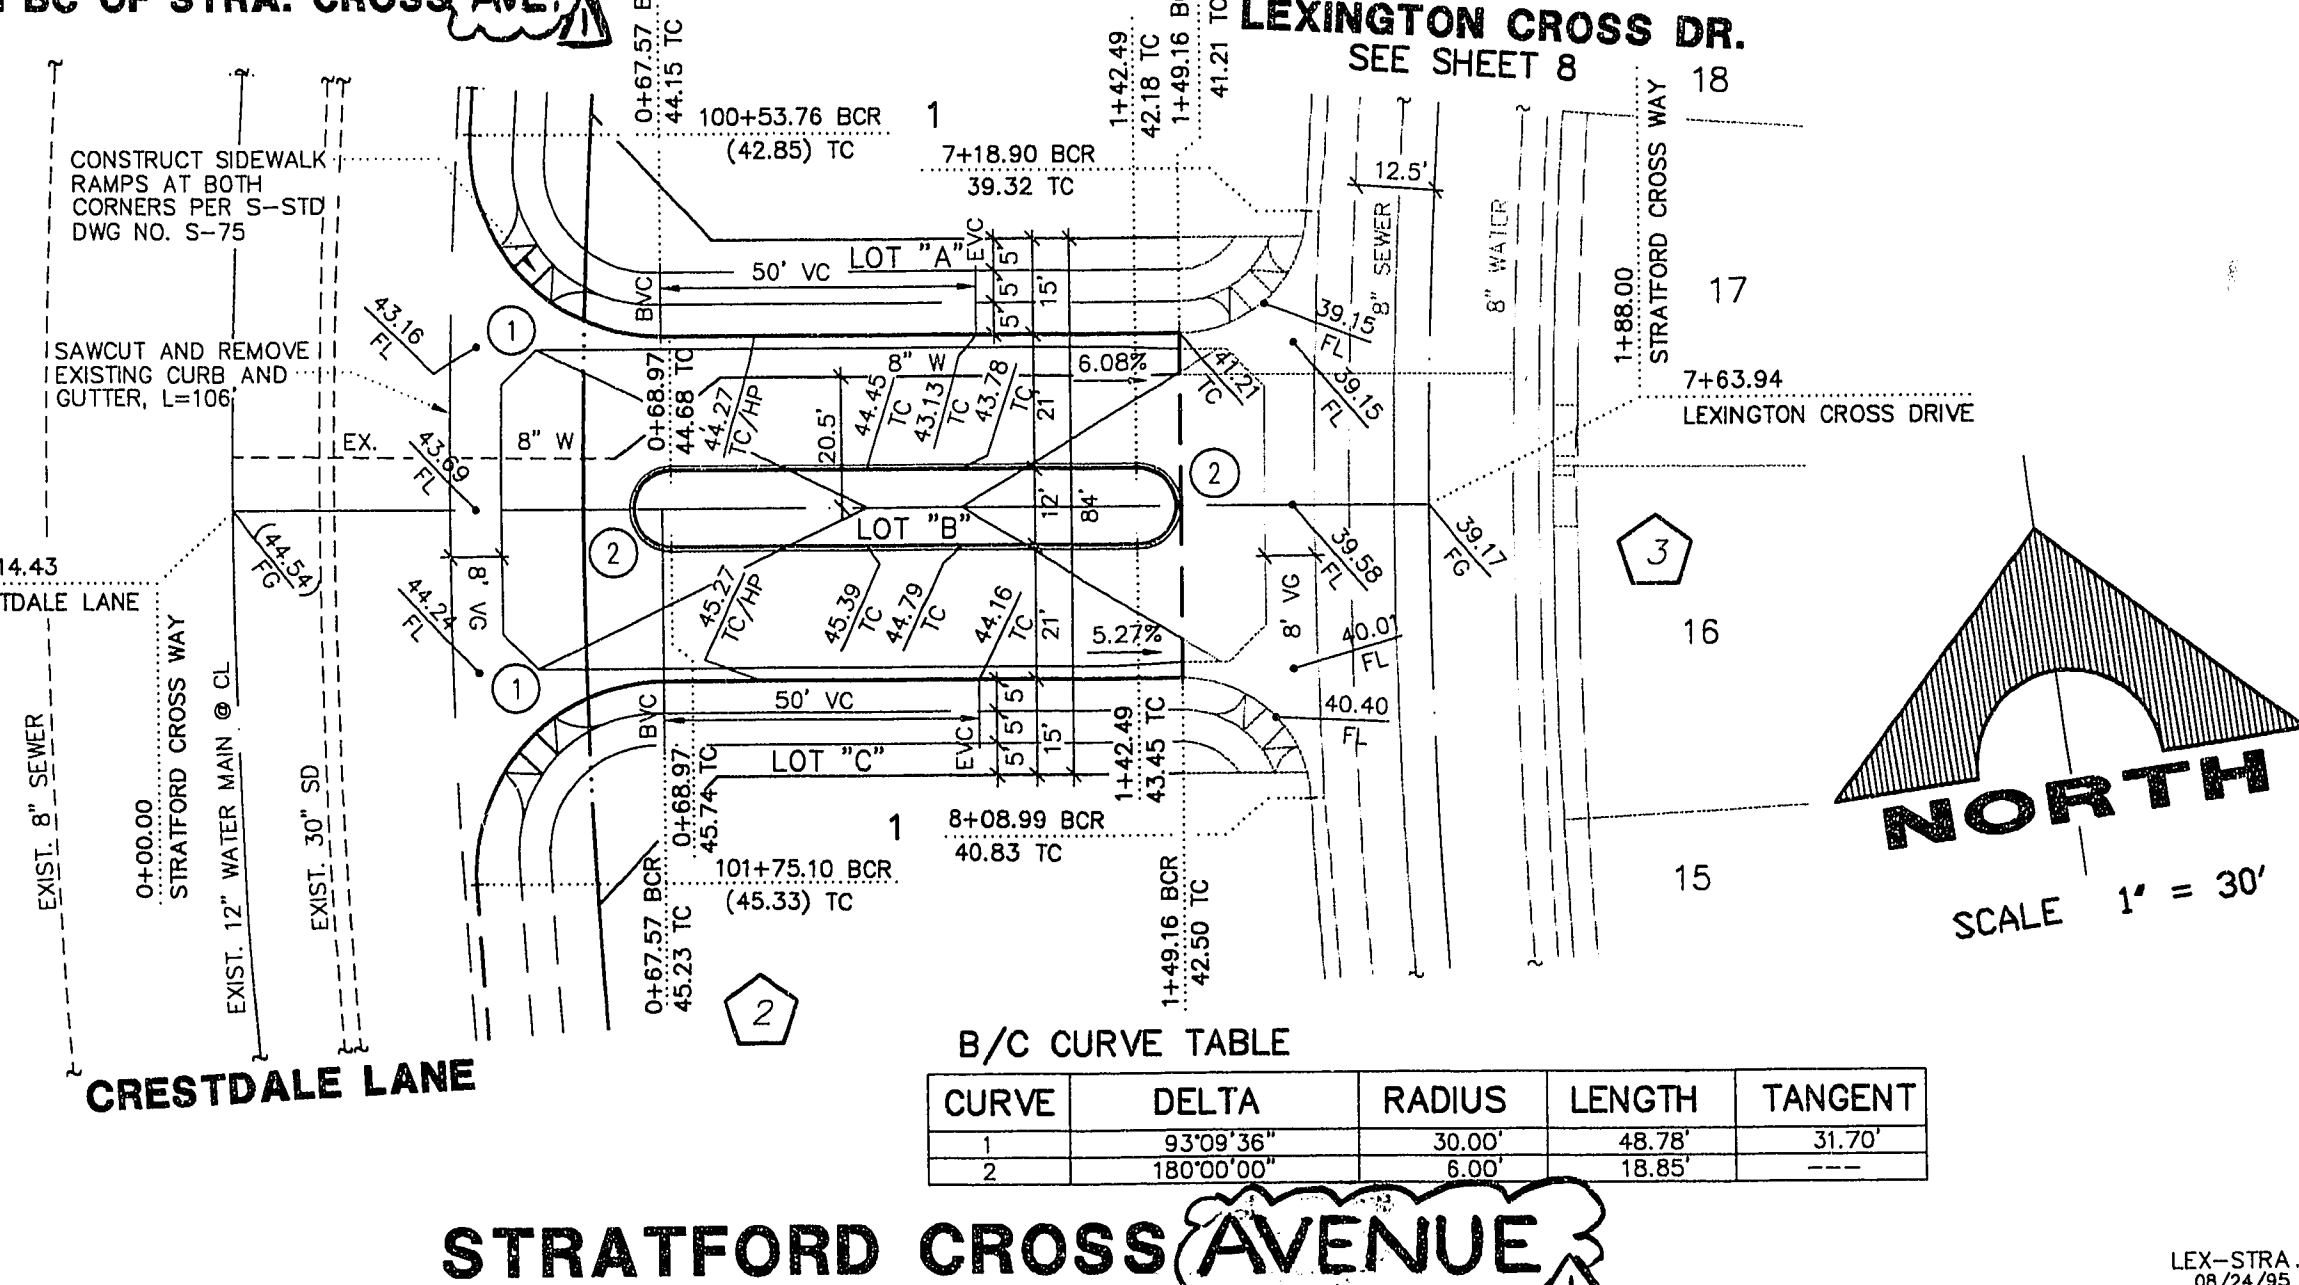


B/C CURVE TABLE

CURVE	DELTA	RADIUS	LENGTH	TANGENT
1	03°00'58"	932.00'	49.98'	24.54'
2	08°40'31"	917.50'	138.92'	69.59'
3	08°40'31"	912.00'	141.12'	70.69'
4	02°38'15"	932.00'	42.89'	21.50'
5	08°04'01"	892.00'	125.55'	62.90'
6	03°47'02"	892.00'	58.91'	29.47'
7	08°04'01"	892.00'	126.50'	63.36'
8	00°29'57"	3290.00'	7.77'	3.89'
9	00°30'53"	3290.00'	29.56'	14.78'
10	08°04'01"	892.00'	33.60'	16.78'
11	06°15'17"	3303.50'	62.00'	31.00'
12	01°04'31"	40.50'	2.85'	1.43'
13	04°02'00"	40.50'	2.85'	1.43'
14	01°10'49"	3309.00'	68.16'	34.08'
15	12°22'04"	20.00'	43.40'	37.89'
16	01°40'34"	40.50'	64.80'	41.70'
17	22°03'59"	40.50'	156.14'	78.12'
18	12°51'12"	40.50'	88.49'	44.24'

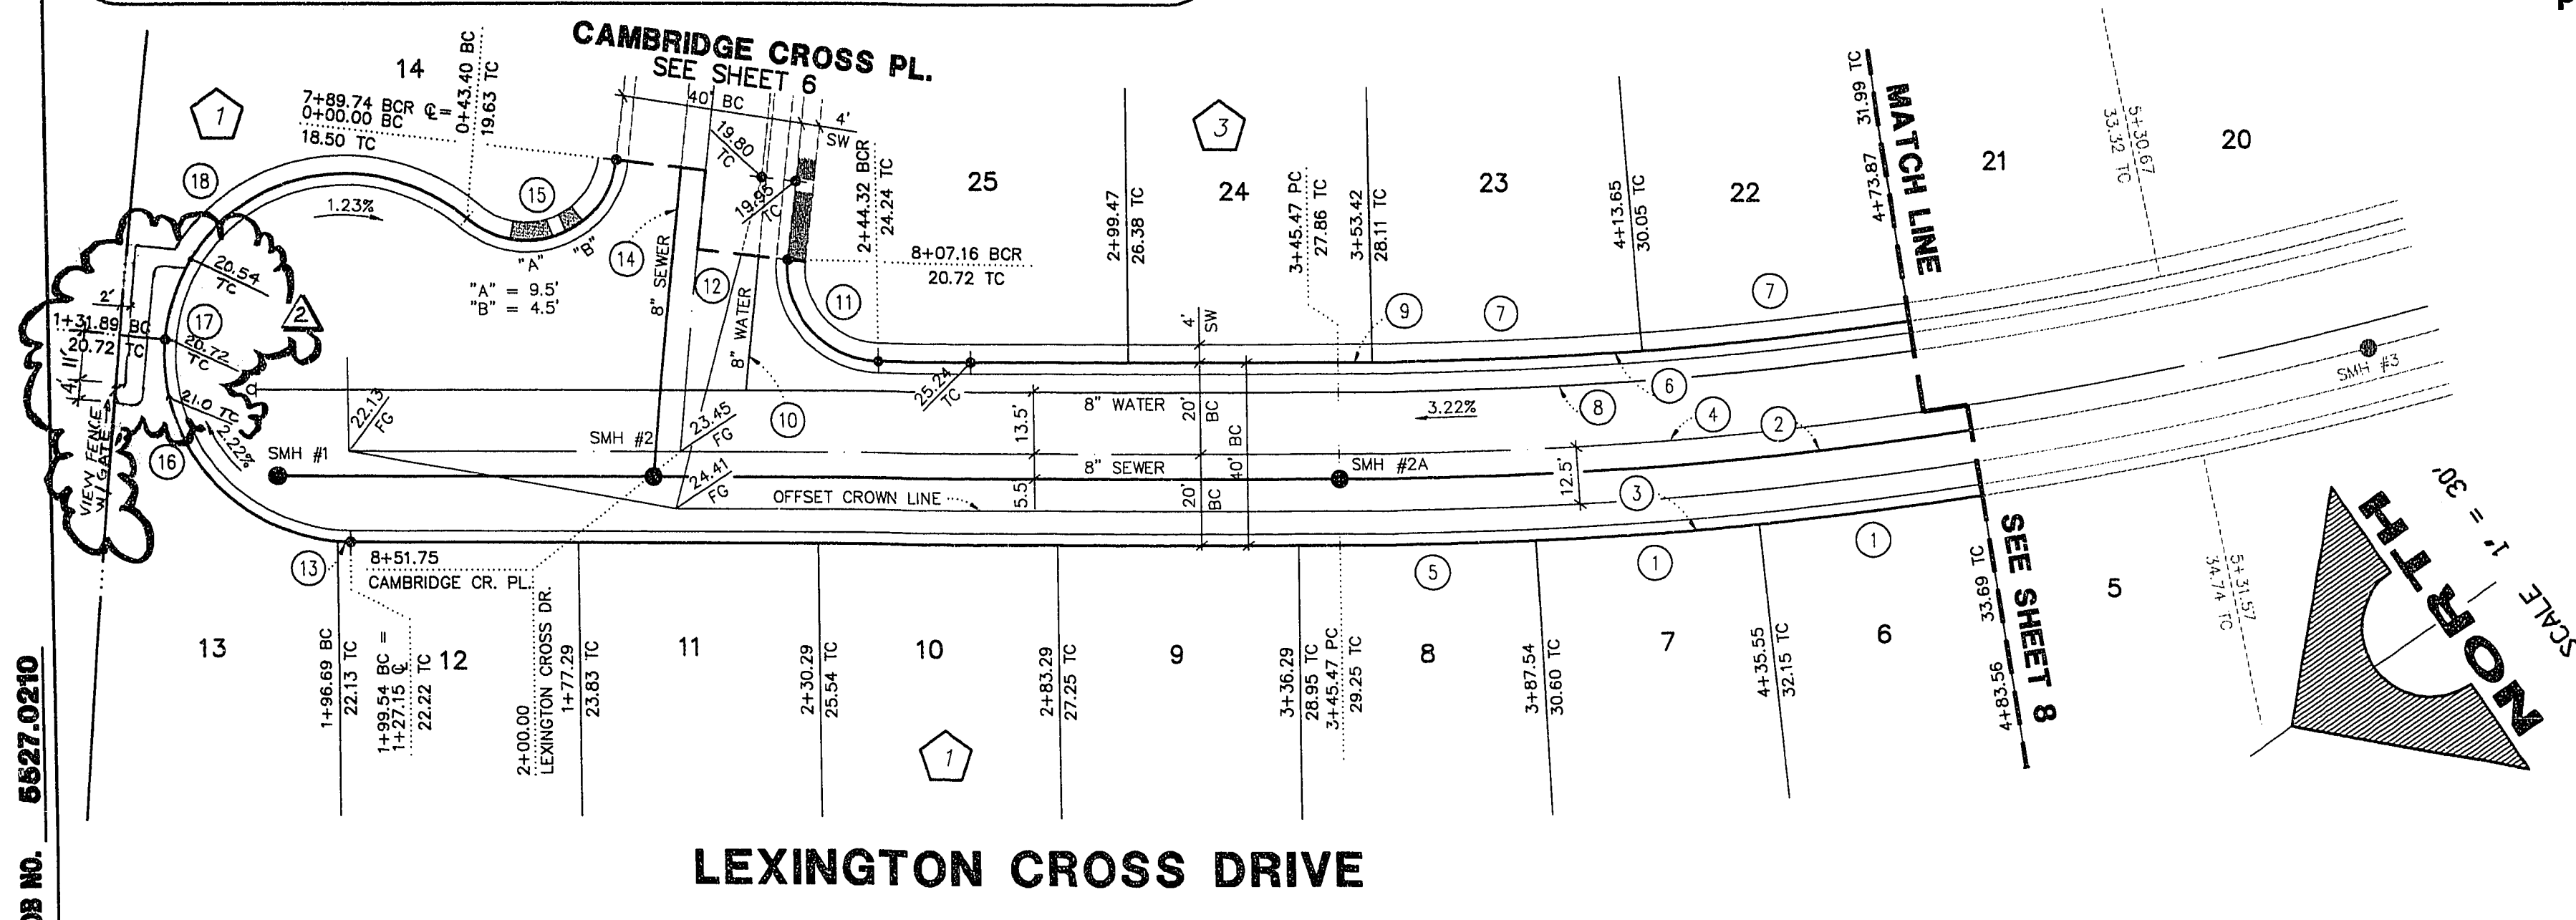

PLAN AND PROFILE
SCALE: HOR. : 1" = 30'
VERT. : 1" = 3'

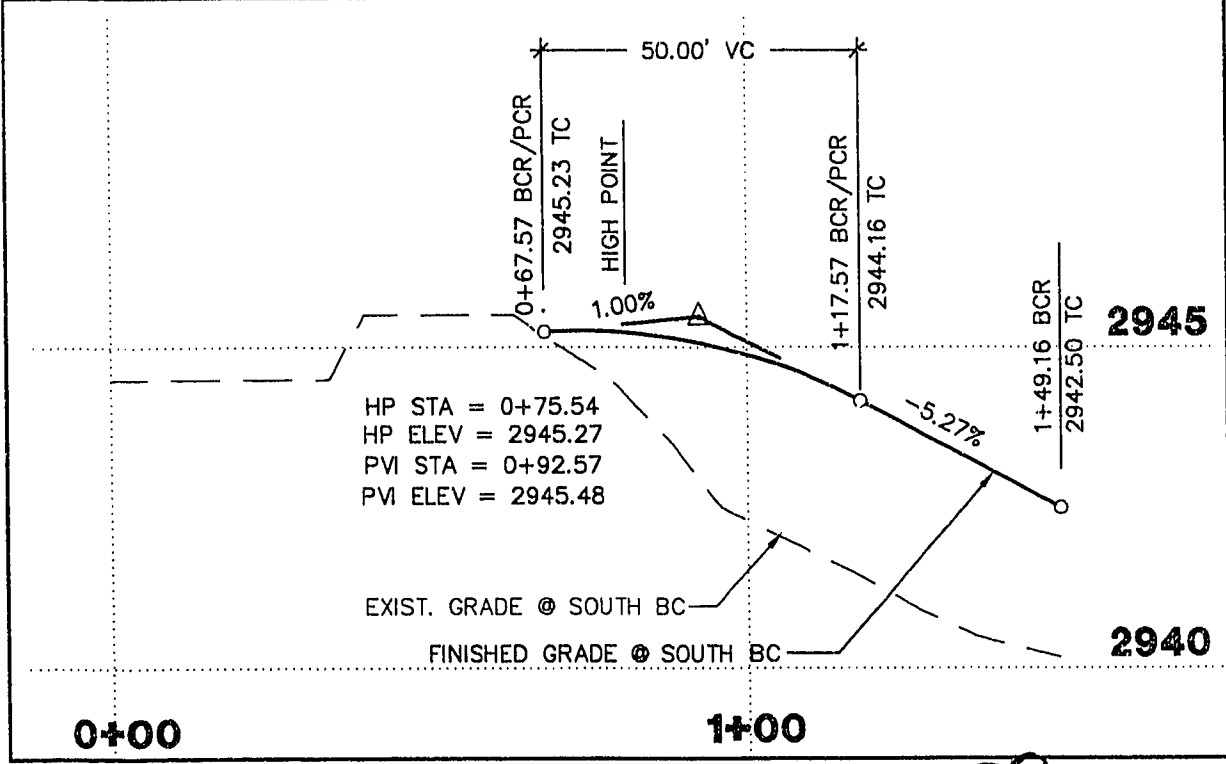

B/C CURVE TABLE

CURVE	DELTA	RADIUS	LENGTH	TANGENT
1	93°09'36"	30.00'	48.78'	31.70'

REVISIONS

REV	DATE	DESCRIPTION

RECOMMENDED

G. IRA WALLACE
Professional Engineer
No. 1091

PARDEE CONSTRUCTION COMPANY
WESTRIDGE AT SUMMERLIN - PHASE I
LEXINGTON CROSS DR. & STRATFORD CROSS AVE.

G. C. WALLACE, INC.
Engineering/Architecture

SHEET 7

LEX-STRA DWG 08/24/95 C0716 OF 13 SHEETS

JOB NO. 5827.0210

11-24-99 107Y-4417-1