AGBLANK

RANCHO DRIVE (AC)

CAREY AVENUE (AC)

MATCHLINE STA. 97+00.00 — NDOT STA. 63+72±

MATCHLINE STA. 109+00.00 — NDOT STA. 75+72±

NDOT STA. 64+79.78

AC MEDIAN W/ CONC CURB

CONC MEDIAN

NEW MH-23
P.I. STA. 98+60.00
Δ=3°42'19"RT

NEW MH-24
P.I. STA. 104+75.00
Δ=1°24'27"LT

NEW INTERCEPTOR SEWER

AC CURB

EDGE OF AC PAVEMENT

TBM #10

SUPPORT SIGNAL AS NECESSARY

NOTE:
INTERSECTION OF RANCHO DRIVE & CAREY AVENUE HAS SIGNALIZED TRAFFIC CONTROL DEVICES

UNDERGROUND ELECTRICAL DUCT BANK

REMOVE & REPLACE EXIST HEADWALL & CULVERT AS NECESSARY PER NDOT STD DWGS & SPECIFICATIONS

REMOVE & REPLACE HEADWALL AT EXIST CULVERT PER NDOT STD DWGS & SPECIFICATIONS

40' TEMPORARY CONSTRUCTION EASEMENT

REMOVE & REPLACE HEADWALL AT EXIST CULVERT PER NDOT STD DWGS & SPECIFICATIONS

T.B.M. #10 EL. 2187.66
60D NAIL IN NORTH SIDE OF POWER POLE IN NE QUADRANT OF RANCHO RD. & CAREY AVE. NEAR EAST P.C.

CALL BEFORE YOU DIG — UNDERGROUND SERVICE ALERT
CA: 800-642-2444
NV: 800-227-2600

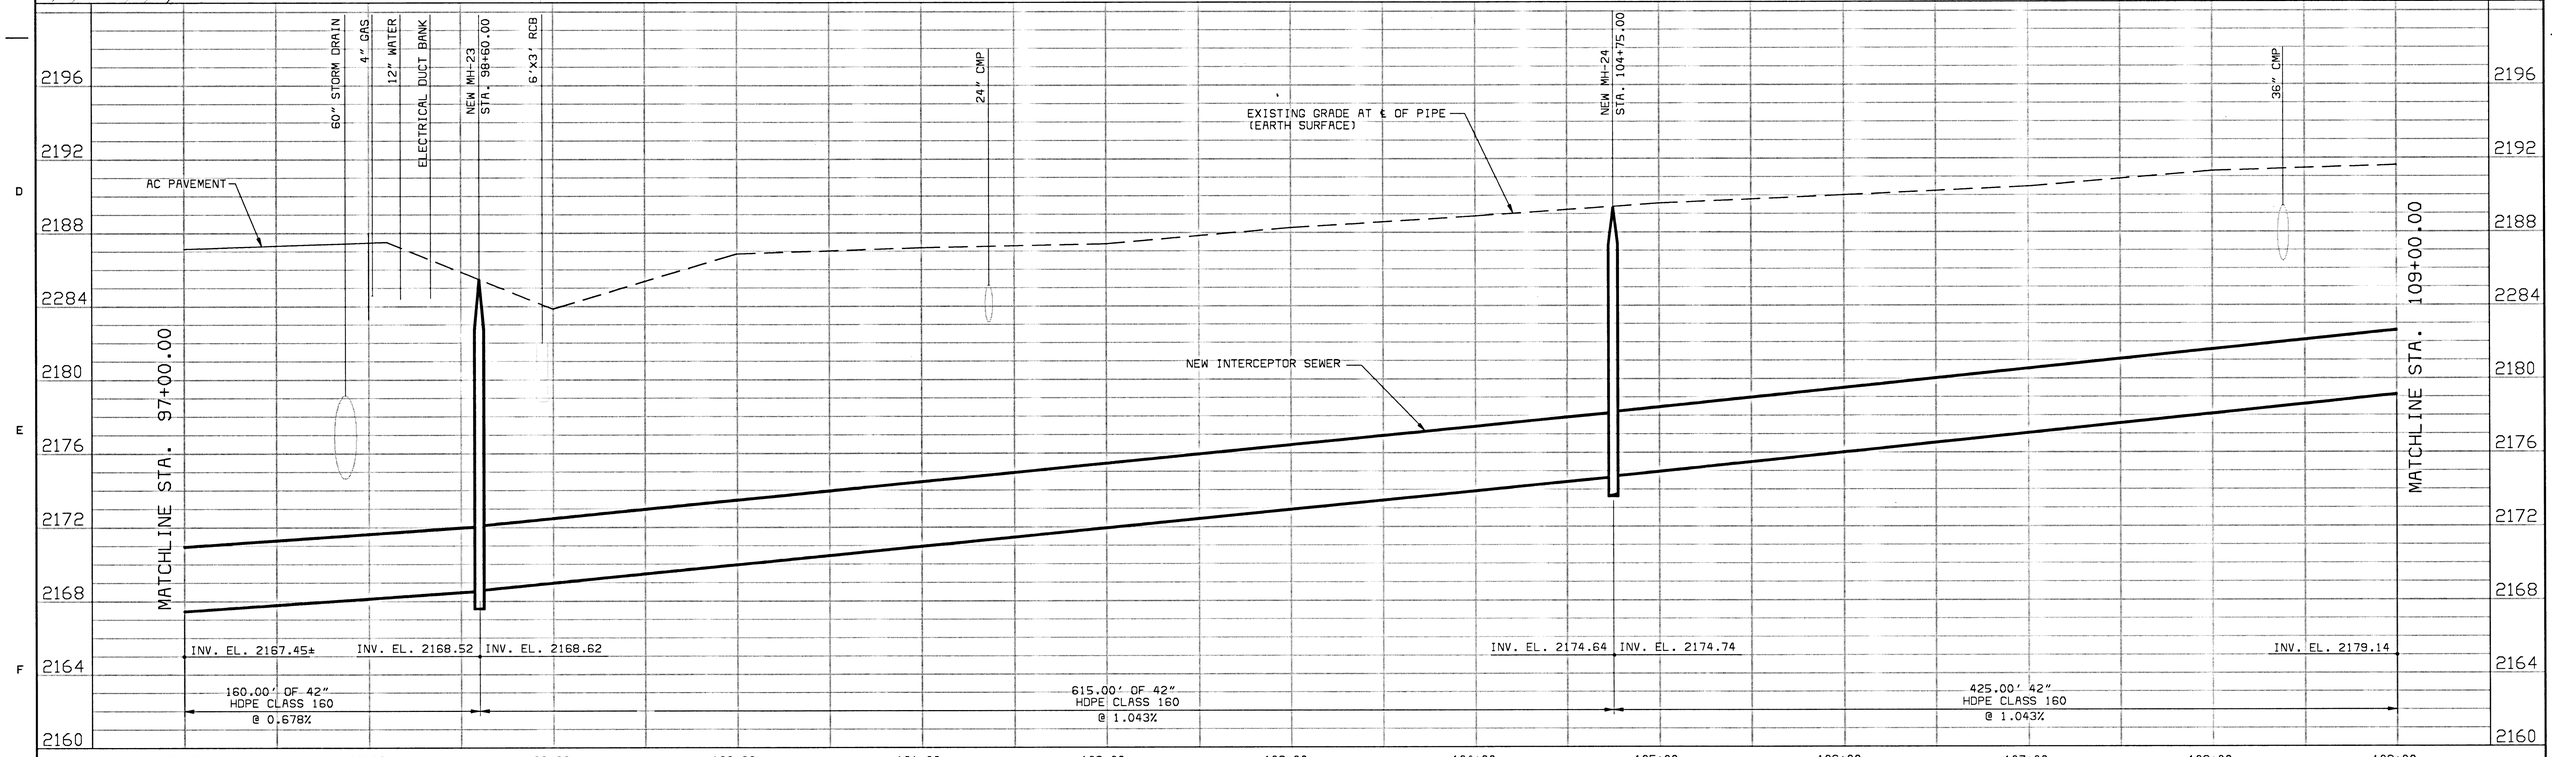

SCALE: HORIZ. 1 IN. = 40 FT.
VERT. 1 IN. = 4 FT.

DATE	REVISIONS AND RECORD OF ISSUE	NO.	BY	CK	APP
6-93	CONFORMS TO AS-BUILT CONDITIONS		PT	PR	PR

DESIGNED GEB/SDC
DETAILED PAT
CHECKED JBW
APPROVED
DATE 2-17-92

Black & Veatch
Las Vegas, Nevada

PROJECT NO. 17857

CITY OF LAS VEGAS
DEPARTMENT OF PUBLIC WORKS
WESTSIDE INTERCEPTOR SEWER

PLAN AND PROFILE
STA. 97+00.00 TO STA. 109+00.00

REGISTERED PROFESSIONAL ENGINEER — STATE OF NEVADA — DANA V. REEL — CIVIL — No. 7138 — 2-17-92

DWG. NO. 307-V695

SHEET 10 OF 18

CCG. DWG. NO: P-9

25-1-24

CBG00002
FCBG000000