29-5-31

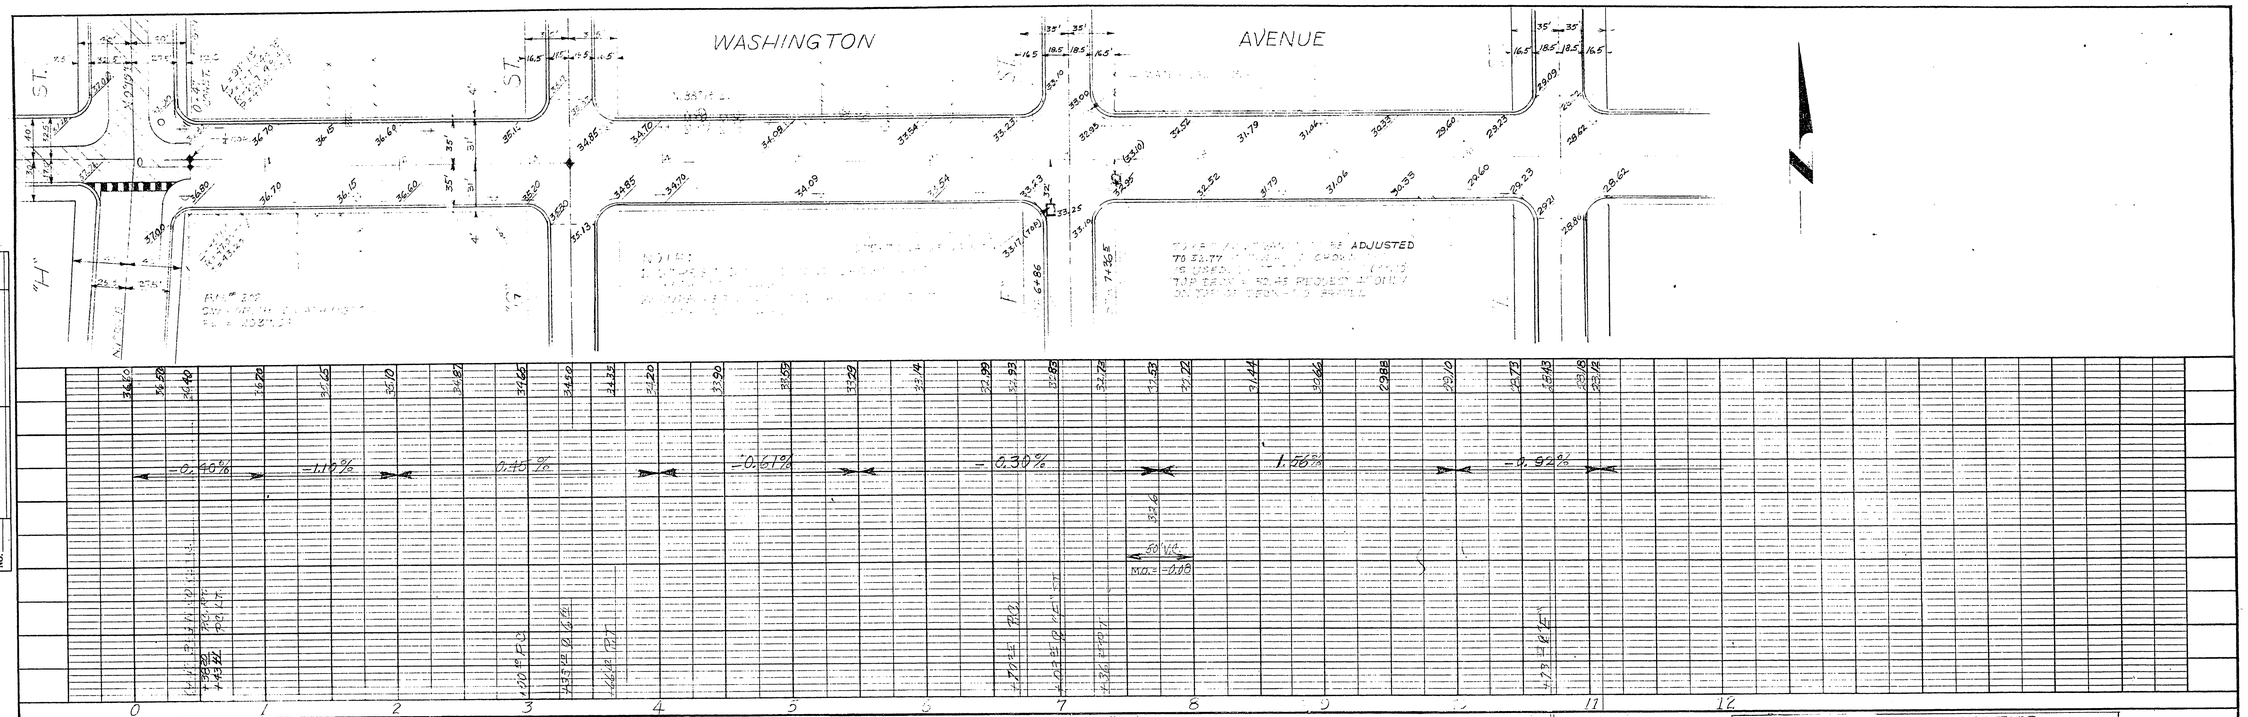

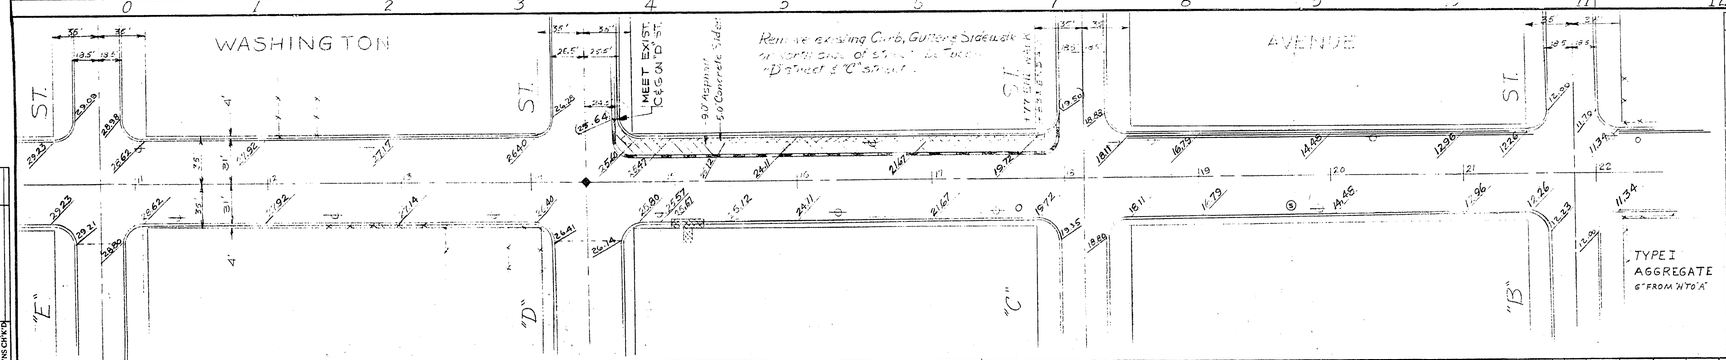

FINAL ~~ESTIMATE~~ SF QUANTITIES			
ITEM	DESCRIPTION	AMOUNT	UNIT
1	Excavation	7135 49	Cu. Yd.
2	2" AC Paving	16,228 78	Sq. Yd.
2-1	2½" AC Paving	NONE	Sq. Yd.
3	2" Type "C" G	4193 10	Lin. Ft.
4	Alley Curb	NONE	Lin. Ft.
5	Val. in Gutters	489 33 ONE	Sq. Ft.
6	Alley Gutters	NONE	Sq. Ft.
7	Remove Curb for Driveways & Valley Gutters	1276 80	Sq. Ft.
8	Remove Curb & Gutter	296 30	Lin. Ft.
9	Adjust Manholes	NONE	EACH
10	Replace: Curb Rim with ST. Ring & Cover	FOUR	EACH
11	Inclined Header	NONE	Lin. Ft.
12	Remove Trees ≥ 4" to 10" DIA.	NONE	EACH
13	Remove Trees over 10" DIA.	NONE	EACH
14	Construct Sidewalk	1276 80	Sq. Ft.
15			
16			
17	Type I Aggregate	3606 33	Cu. Yds.

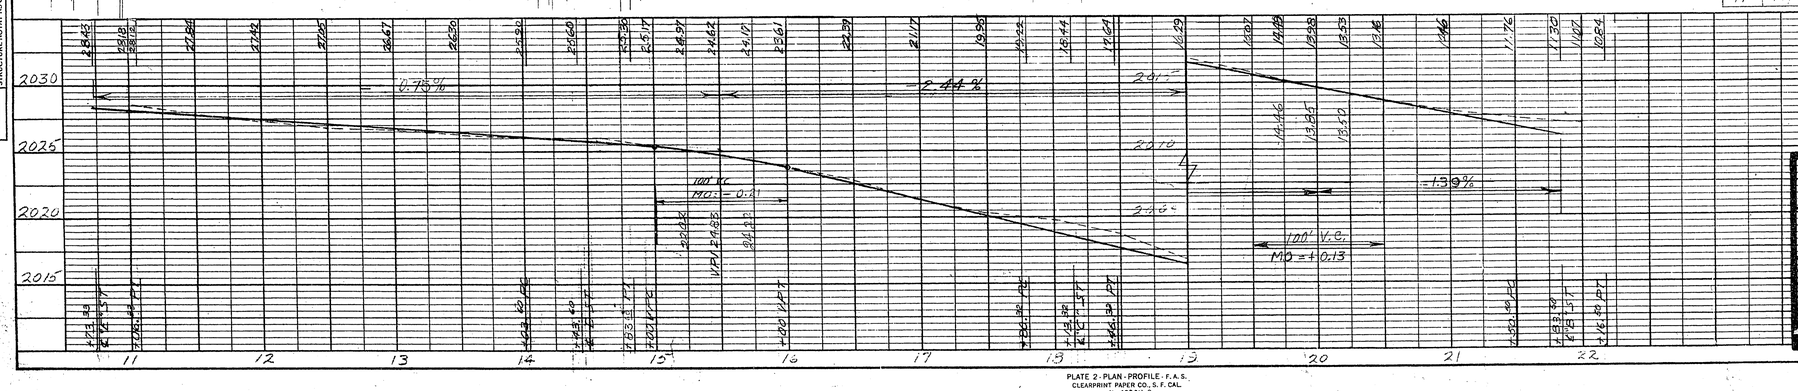

REVISIONS	
1 M.S. REDUCTION IN WIDTH OF WASHINGTON AVE	2-8-56
APPROVAL: R.E.N.	6-20-56

INVERTED CROWN AS BUILT

CITY OF LAS VEGAS, NEVADA
ENGINEERING DEPT.

WEST SIDE PAVING PROJECT
WASHINGTON AVE. "H" ST. TO "A" ST.

ENGINEERED BY	R.E.N.	DATE	SCALE 1"=20' HOR. 1"=2' VERT.
DRAWN BY	L. HARPER	9-2-55	FIELD BOOK NO. 55-128
CHECKED BY	C.M.	9-27-55	WORK ORDER NO. 170-5
APPROVED CITY ENGR.			DRAWING NO. 107-10

PLATE 2 - PLAN - PROFILE - F. A. S.
CLEARPRINT PAPER CO., S. F. CAL.
No. 1000H-2

S.A.D. 100-36 SHEET 5 OF 34
107-18