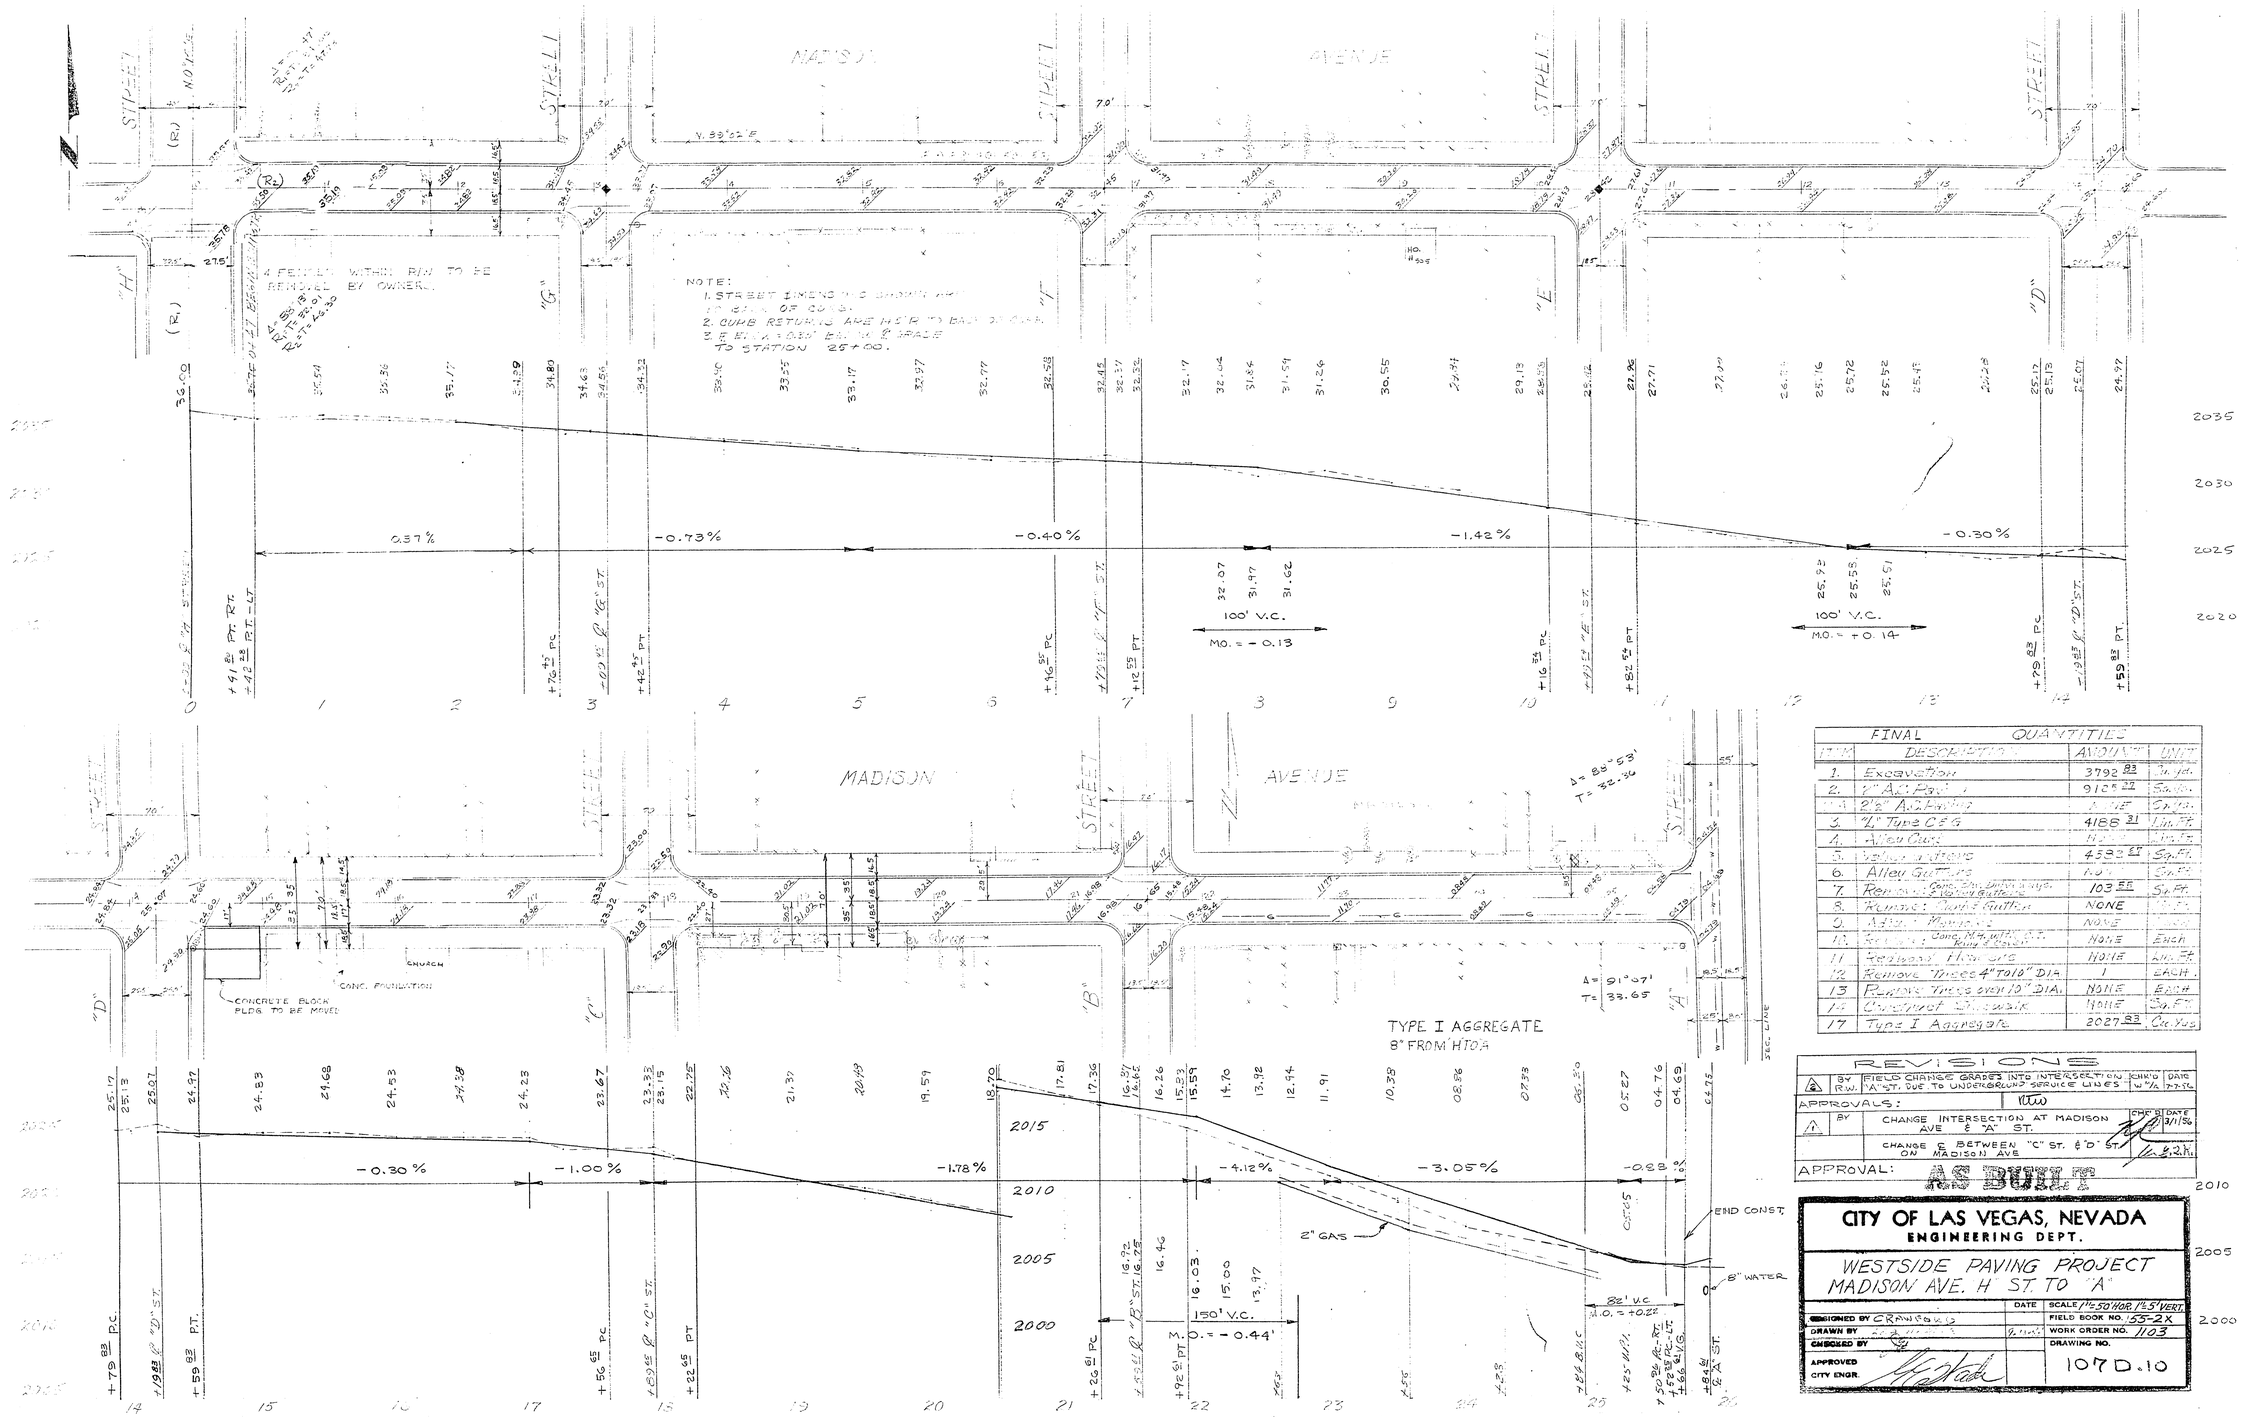

FINAL QUANTITIES			
ITEM	DESCRIPTION	AMOUNT	UNIT
1.	Excavation	3792 83	Cu. Yds.
2.	1" AC Pavement	910 5 32	Sq. Yds.
3.	2½" AC Pavement	NONE	Sq. Yds.
3.	¾" Type C S G	4188 31	Lin. Ft.
4.	Alley Gutter	NONE	Lin. Ft.
5.	Valley Gutters	4593 27	Sq. Ft.
6.	Alley Gutters	NONE	Sq. Ft.
7.	Remove Conc. Curb, Gutter & Valley Gutters	103 50	Sq. Ft.
8.	Remove Alley Gutter	NONE	Sq. Ft.
9.	Adjust Manholes	NONE	Each
10.	Remove Conc. Mtg. Ring & Cover	NONE	Each
11	Redwood Fence	NONE	Lin. Ft.
12	Remove Trees 4" to 10" DIA	1	Each
13	Remove Trees over 10" DIA.	NONE	Each
14	Construct Sidewalk	NONE	Sq. Ft.
17	Type I Aggregate	2027 83	Cu. Yds.

REVISIONS

	BY		CHK'D	DATE
2	R.W.	FIELD CHANGE GRADES INTO INTERSECTION "A" ST. DUE TO UNDERGROUND SERVICE LINES	L.V.	7-7-76

APPROVALS: RTW

	BY		CHK'D	DATE
1		CHANGE INTERSECTION AT MADISON AVE & "A" ST.		3/1/56
		CHANGE ℄ BETWEEN "C" ST. & "D" ST. ON MADISON AVE	L.V.H.	

APPROVAL: AS BUILT

CITY OF LAS VEGAS, NEVADA
ENGINEERING DEPT.

WESTSIDE PAVING PROJECT
MADISON AVE. H ST. TO "A"

DESIGNED BY CRAWFORD	DATE	SCALE 1"=50' HOR. 1"=5' VERT.	
DRAWN BY		FIELD BOOK NO. 155-2X	
CHECKED BY		WORK ORDER NO. 1103	
APPROVED CITY ENGR.		DRAWING NO. 107D.10	

S.A.D. 100-30 Sheet No. 9 of 34

107-V8