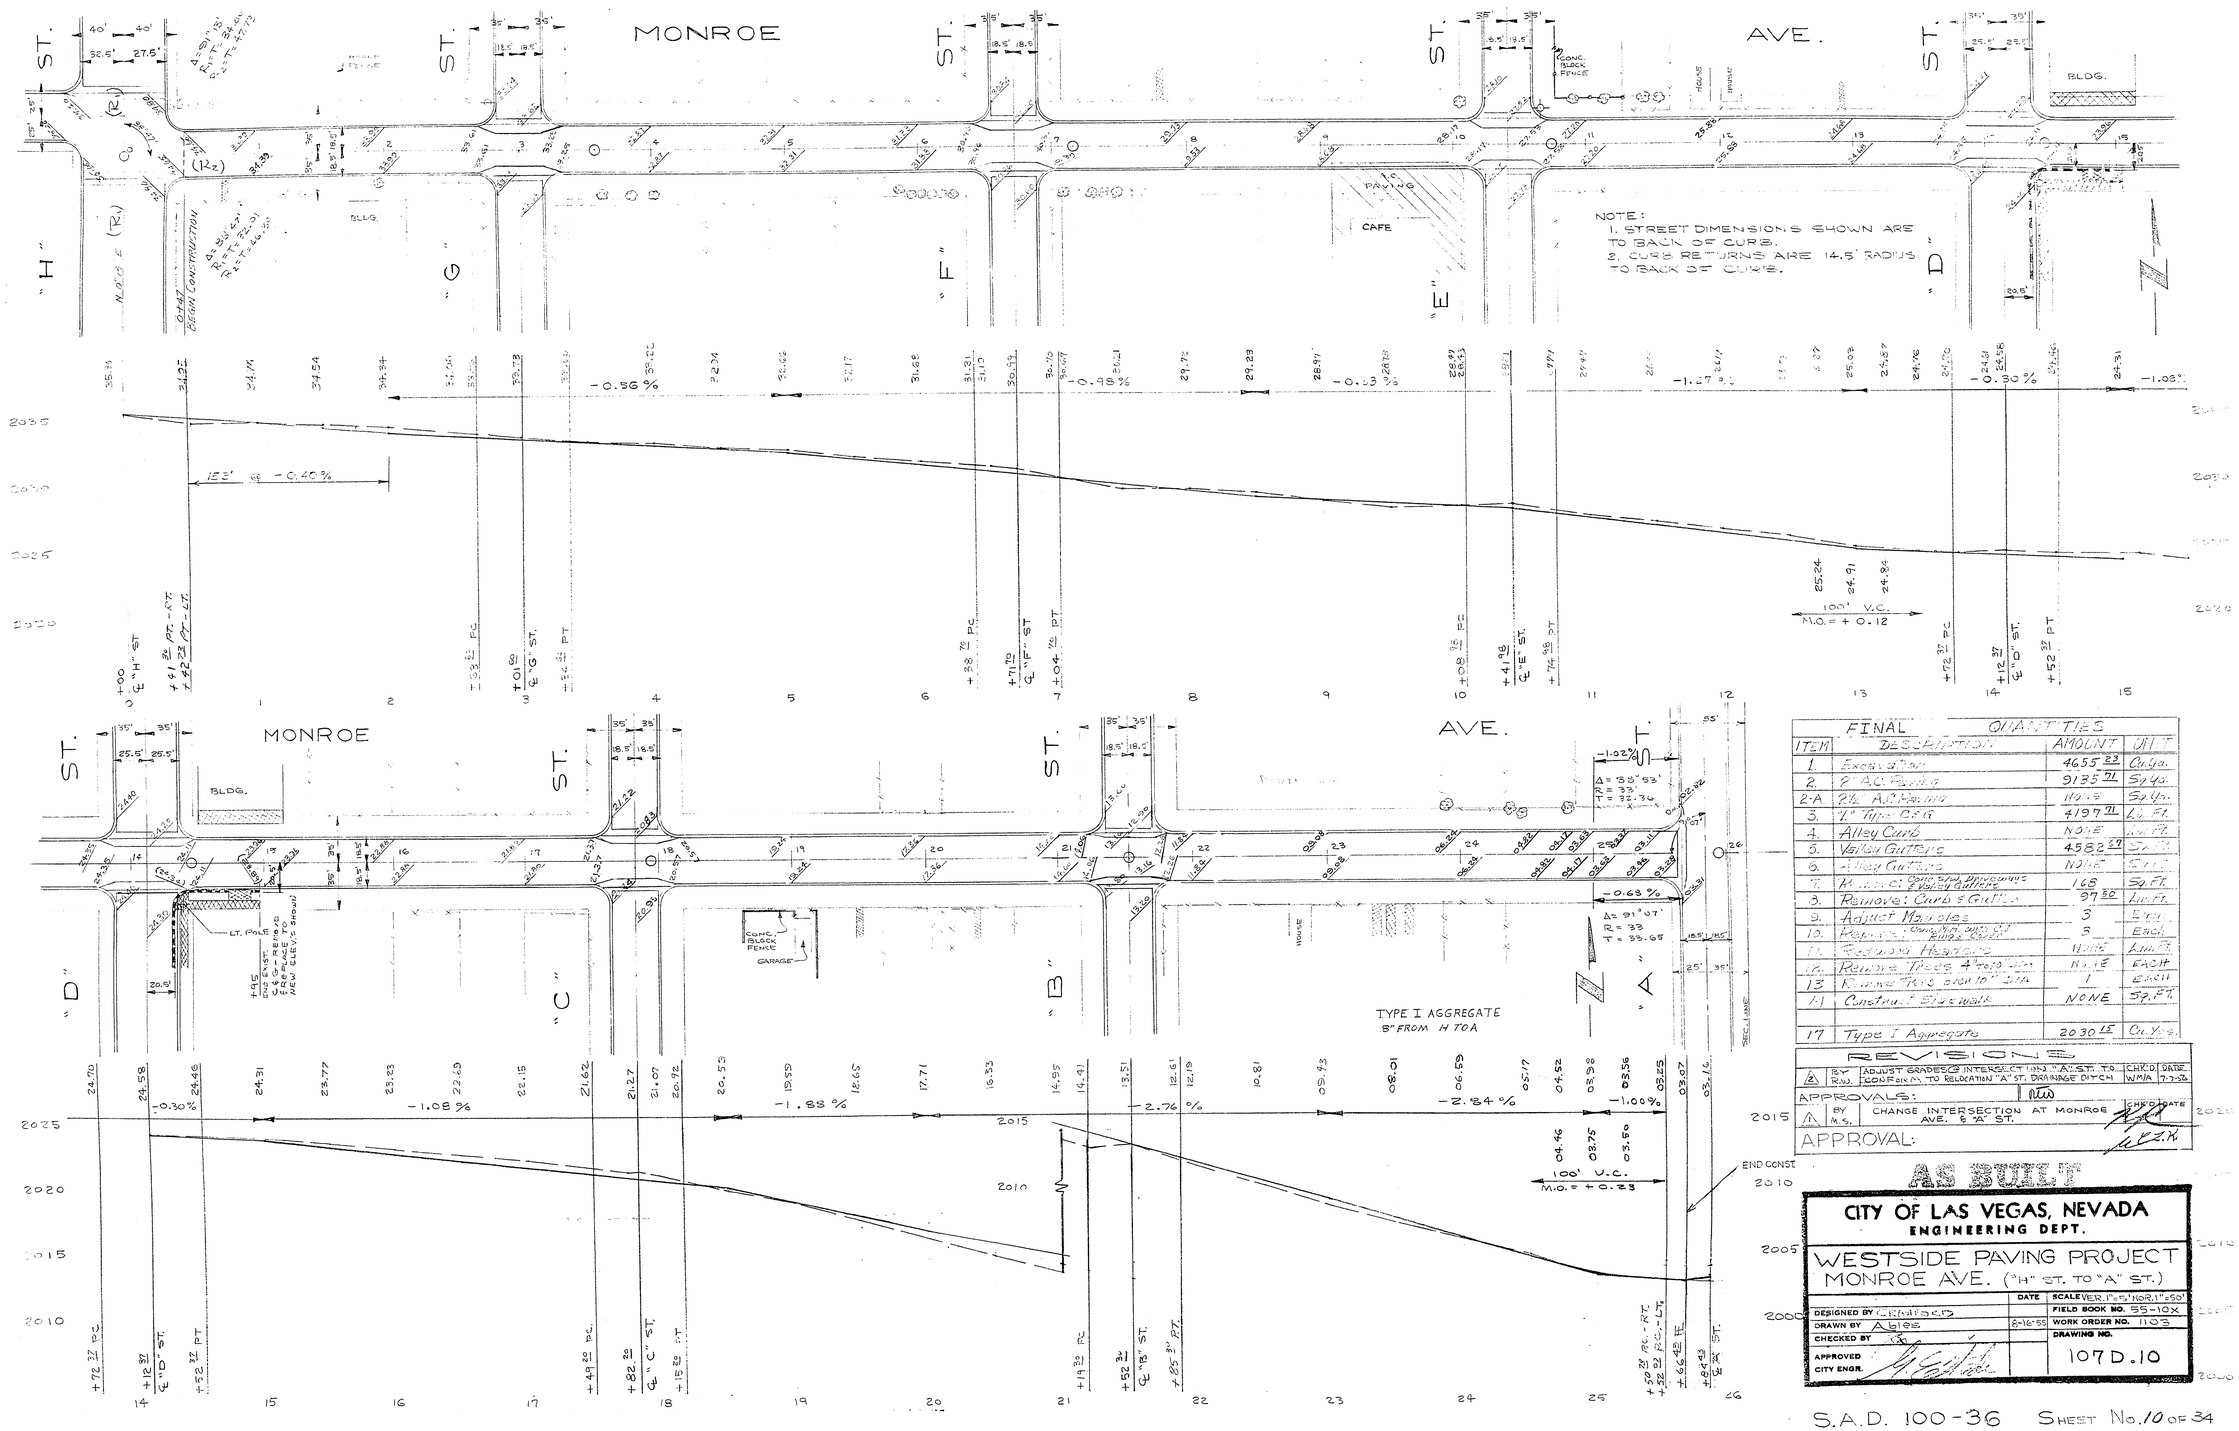

FINAL QUANTITIES			
ITEM	DESCRIPTION	AMOUNT	UNIT
1.	Excavation	4655 23	Cu. Yd.
2.	2" A.C. Paving	9135 71	Sq. Yd.
2-A	2½" A.C. Paving	None	Sq. Yd.
3.	1' Type C & G	4197 71	Lin. Ft.
4.	Alley Curb	None	Lin. Ft.
5.	Valley Gutters	4582 25	Sq. Ft.
6.	Alley Gutters	None	Sq. Ft.
7.	Remove: Conc. Sidewalk, Driveways & Valley Gutters	168	Sq. Ft.
8.	Remove: Curb & Gutter	97 50	Lin. Ft.
9.	Adjust Manholes	3	Each
10.	Remove: Concrete Block Fence	3	Each
11.	Relocating Hydrants	None	Lin. Ft.
12.	Remove Trees 4" and under	None	Each
13	Remove Trees over 10" Dia.	1	Each
14	Construct Sidewalk	None	Sq. Ft.
17	Type I Aggregate	2030 LB	Cu. Yds.

REVISIONS				
	BY		CHK'D	DATE
2	R.W.	ADJUST GRADES @ INTERSECT'N OF "A" ST. TO CONFORM TO RELOCATION "A" ST. DRAINAGE DITCH	W/A	7-7-56

APPROVALS: RW

	BY		CHK'D	DATE
1	M.S.	CHANGE INTERSECTION AT MONROE AVE. & "A" ST.		

APPROVAL:

AS BUILT

CITY OF LAS VEGAS, NEVADA
ENGINEERING DEPT.

WESTSIDE PAVING PROJECT
MONROE AVE. ("H" ST. TO "A" ST.)

DESIGNED BY	K.R. Nielsen	DATE	SCALE VER. 1"=5' HOR. 1"=50'
DRAWN BY	A. Giles	8-16-55	FIELD BOOK NO. 55-10X
CHECKED BY			WORK ORDER NO. 1103
APPROVED CITY ENGR.			DRAWING NO. 107D.10

S.A.D. 100-36 SHEET No. 10 OF 34

107-V8

10-16-56