


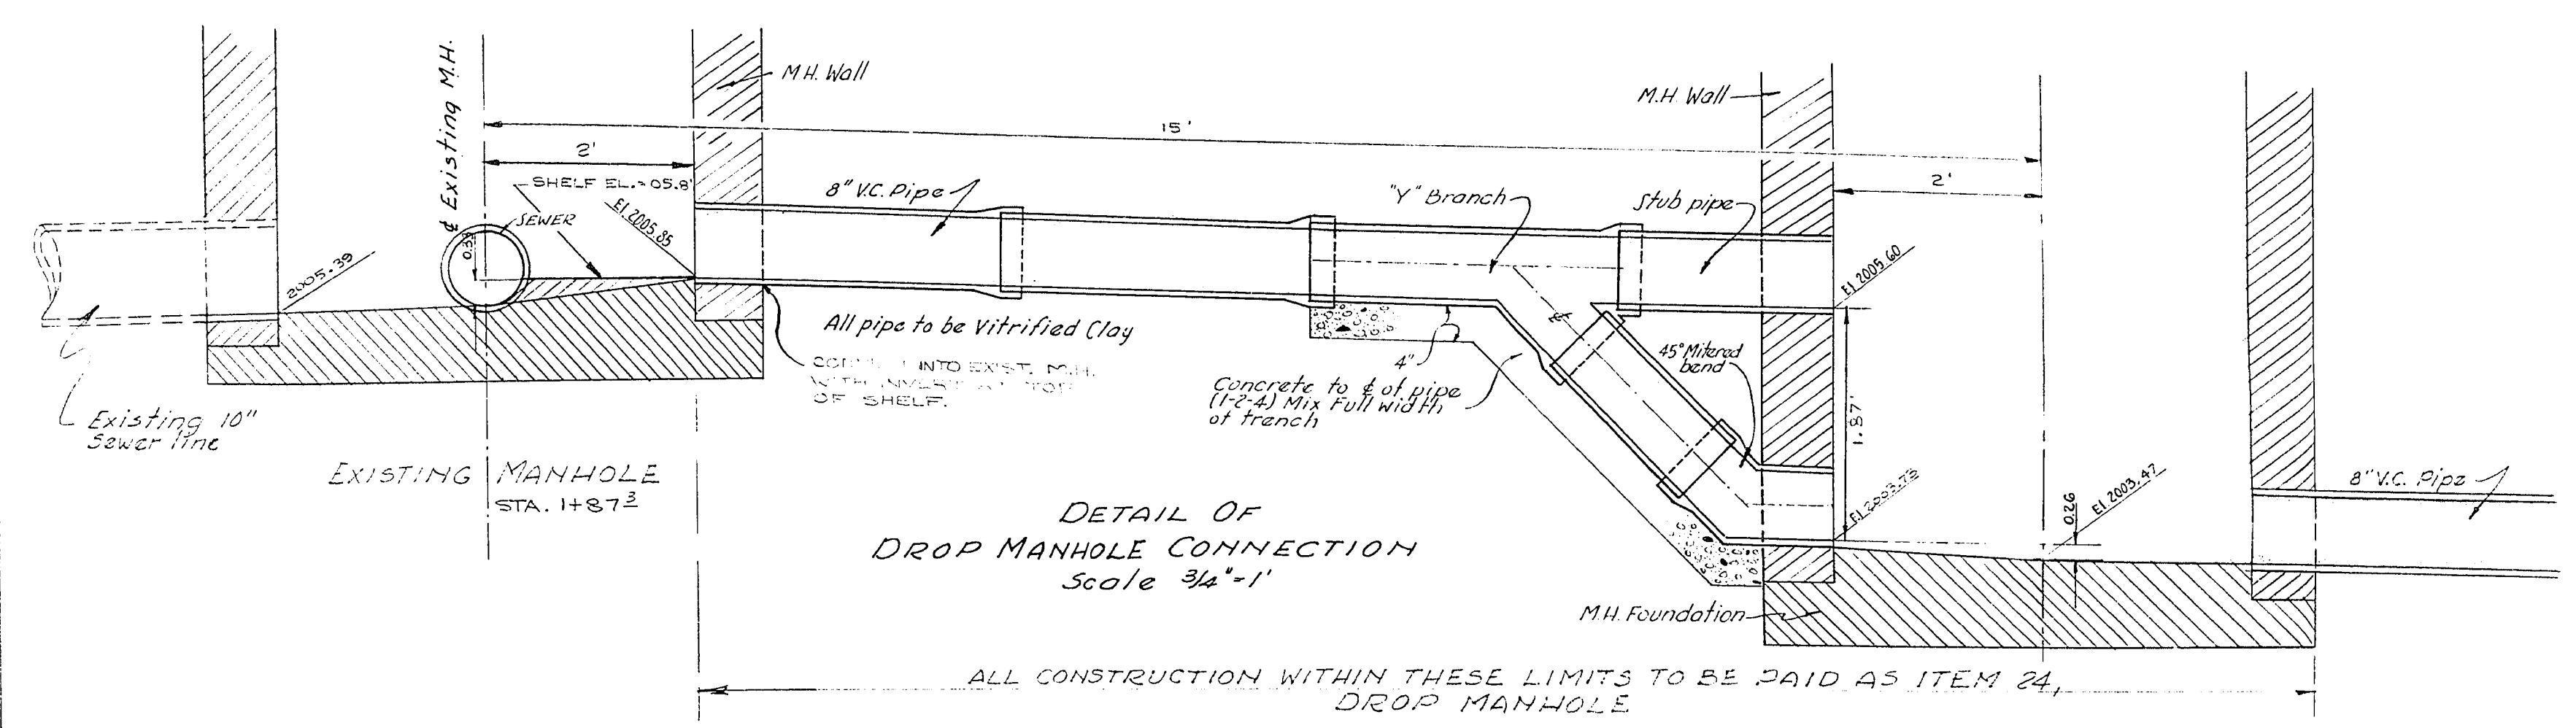

REVISED: 12-28-55

1. DISTANCE CORRECTED.
2. GRADES CORRECTED.
3. NOTE ADDED.

CITY OF LAS VEGAS, NEVADA ENGINEERING DEPT.		
WESTSIDE PAVING PROJECT "A" STREET SAN. SEWER DIVERSION		
DESIGNED BY	K. CRAWFORD	DATE
DRAWN BY	LEGENTH	SCALE 1"=50' HORIZ. 1"=5' VERT.
CHECKED BY	<i>Handwritten signature</i>	FIELD BOOK NO. 55-2459-3X
APPROVED	<i>Handwritten signature</i>	WORK ORDER NO. 1103
CITY ENGR.	<i>Handwritten signature</i>	DRAWING NO. 107 D.10

SAD 100-36 SHEET 34 OF 34
107-V8