


BEING PARCEL 1 AS SHOWN ON THE PARCEL MAP IN FILE 97, PAGE 90, OFFICIAL RECORDS, LOCATED IN THE SOUTHEAST QUARTER (SE 1/4) OF THE NORTHWEST QUARTER (NE 1/4) OF SECTION 21 TOWNSHIP 20 SOUTH, RANGE 61 EAST, M.D.M. CITY OF LAS VEGAS, CLARK COUNTY, NEVADA
RECORDED IN BOOK 95 OF PLATS, PAGE 06

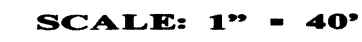


(IN FEET)
1 inch = 40' ft.



- | | |
|--------|--|
| ===== | RIGHT-OF-WAY LINE |
| ----- | CENTERLINE |
| ===== | BOUNDARY LINE |
| ===== | LOT LINE |
| ===== | BACK OF CURB |
| △ | SET REFERENCE MONUMENT
STAMPED PLS 10114 |
| ● | SET - 5/8" REBAR AND ALUMINUM CAP
STAMPED PLS 10114 |
| ① | BLOCK NUMBER |
| 1 | LOT NUMBER |
| 92.53' | MONUMENT TIE DISTANCE |

I, ROBERT C. JOHNSON A LICENSED PROFESSIONAL LAND SURVEYOR IN THE STATE OF NEVADA, DO HEREBY CERTIFY THE MONUMENTS HAVE BEEN SET AND THE TIE DISTANCE ESTABLISHED AS SHOWN HERON, THIS SURVEY WAS COMPLETED ON DECEMBER 14, 2001

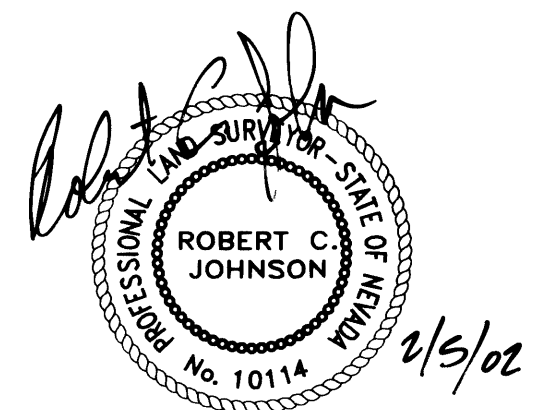[illegible]

COMMUNITY DEV. PROGRAMS CENTER
5420 WEST SAHARA AVENUE
LAS VEGAS, NEVADA

**Engineering • Landscape Architecture
Planning • Urban Design • Surveying**
2551 N. Green Valley Pkwy. Suite A425
HENDERSON, NV. 89014 (702) 458-2551

MONUMENTATION TIE MAP

PROJECT: **WHISPERING TIMBERS**
CITY of LAS VEGAS, NEVADA

Drawn by NDC	2/01/02
Designed by:	
Checked by:	1/08/02
RCJ	
Project No : 499050A-001	Scale: 1" = 40'

SEAL

SHEET

2

OF 2

DRAWING NO.
258-4634