
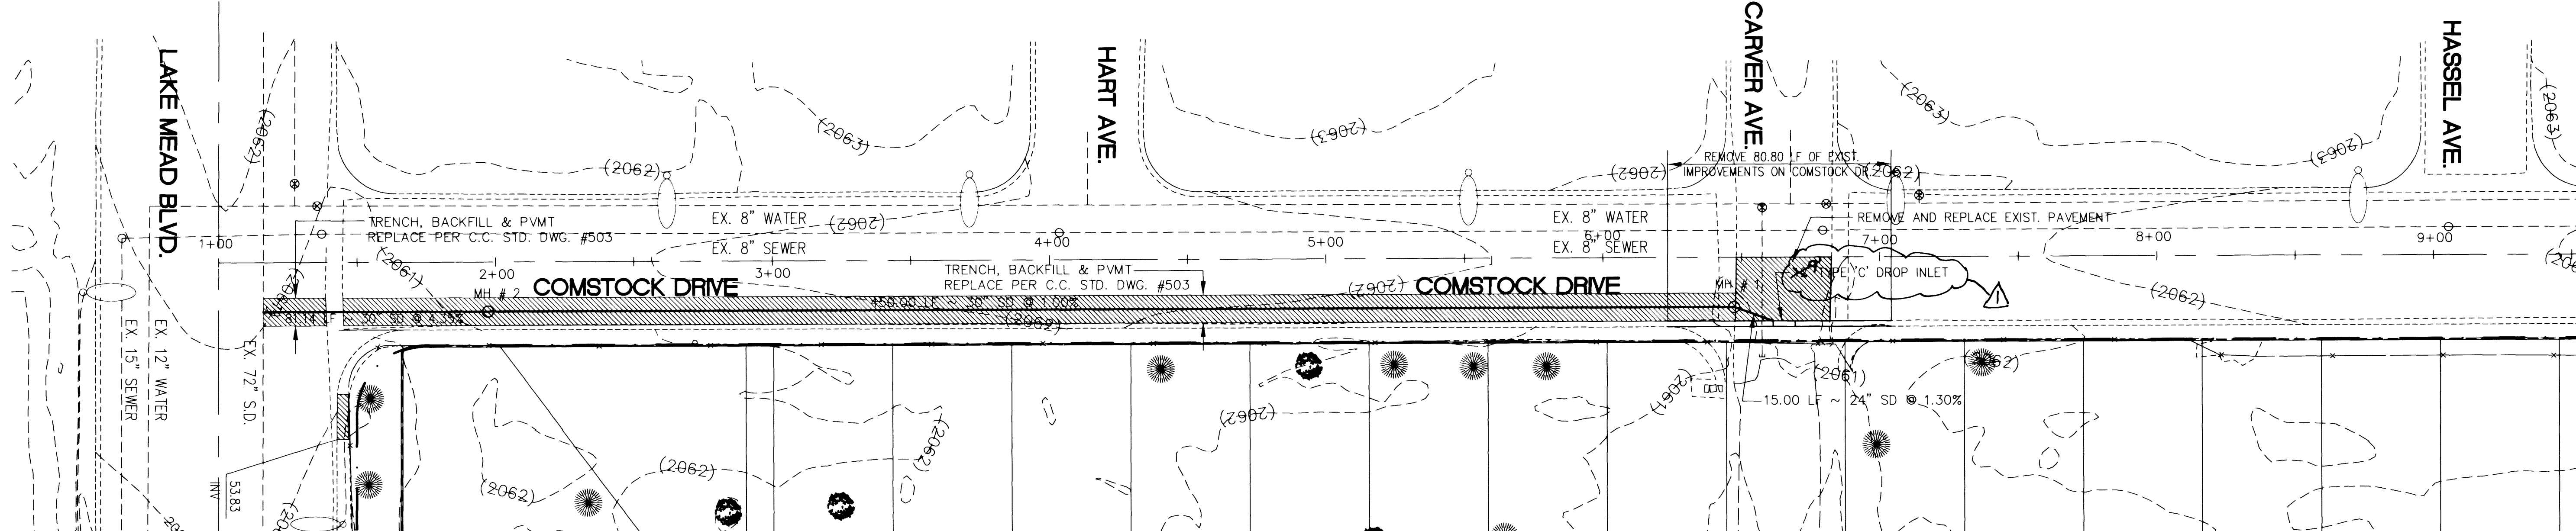
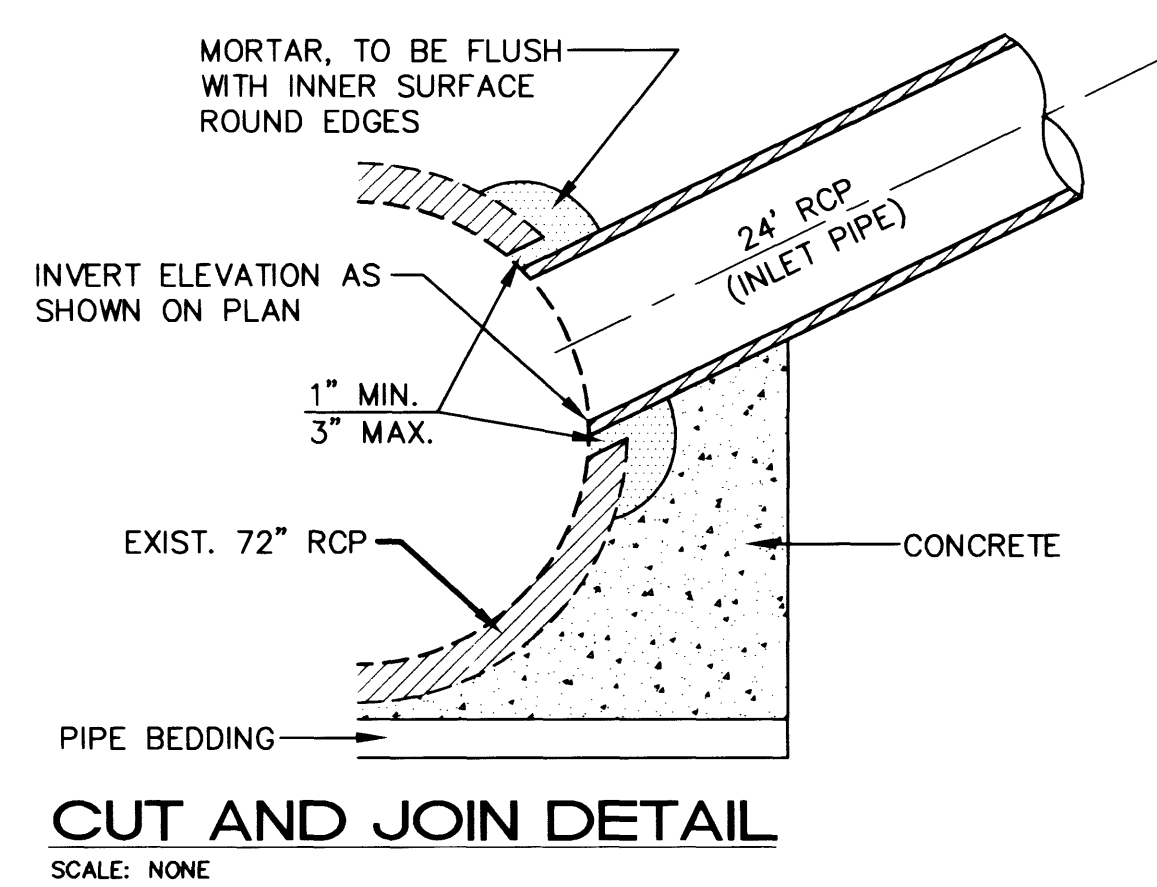


SCALE
H: 1" = 30' ~ V: 1" = 3'

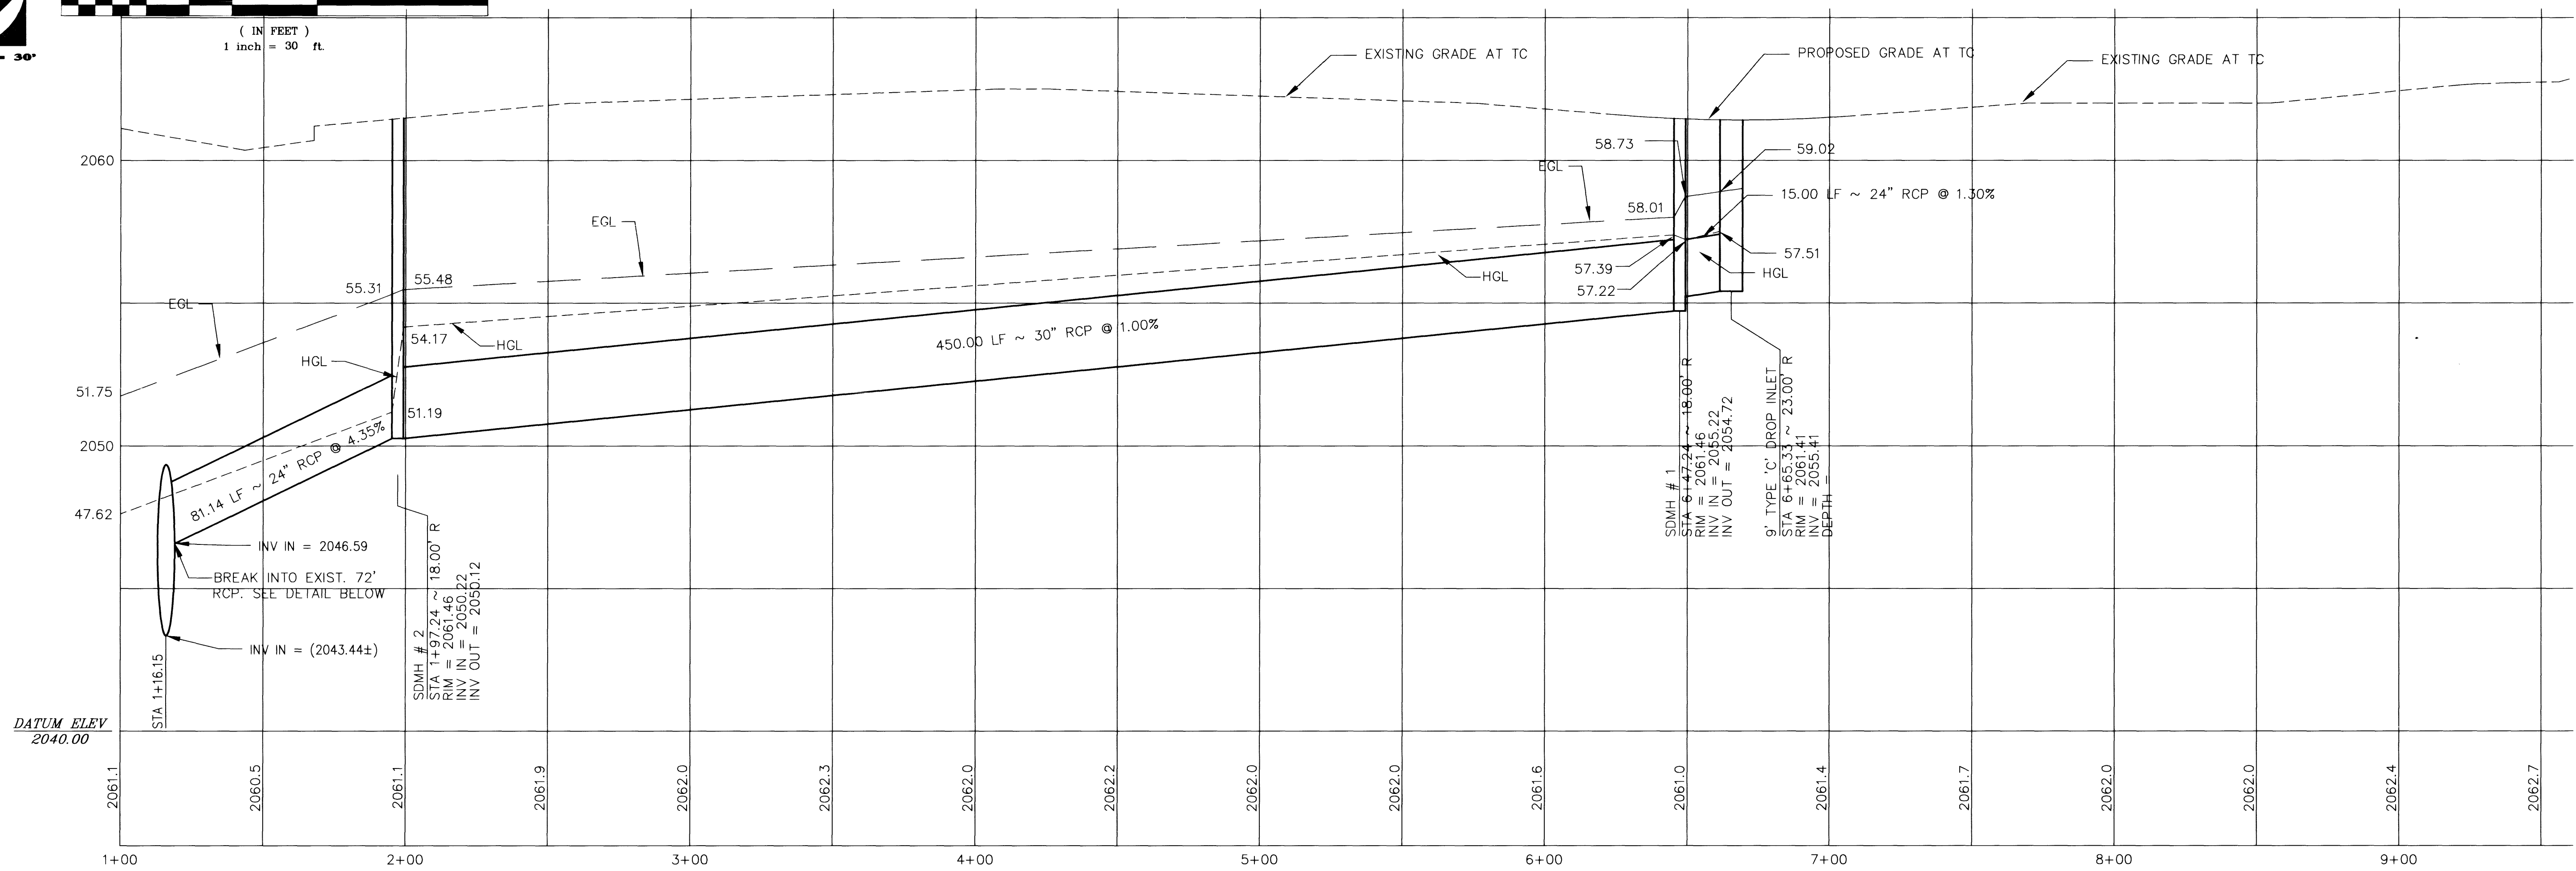

SHEET TITLE: PLAN AND PROFILE COMSTOCK DRIVE STORM DRAIN		PROJECT: WHISPERING TIMBERS	
Drawn by: JPM	Designed by: JPM	Checked by: ANS	Scale: 1"=30' (H) 1"=3' (V)
Project No.: 499050-A-001		Project No.: 499050-A-001	
DATE: 11/10/20		DATE: 11/10/20	
SHEET C19 C19 OF C20		SHEET C19 C19 OF C20	
DRAWING NO. 1074-4634		DRAWING NO. 1074-4634	
COMMUNITY DEV. PROGRAMS CENTER 5420 W. SAHARA AVE LAS VEGAS, NEVADA 89146		COMMUNITY DEV. PROGRAMS CENTER 5420 W. SAHARA AVE LAS VEGAS, NEVADA 89146	
The WLB Group Inc. Engineering • Landscape Architecture Planning • Urban Design • Surveying 2551 N. Green Valley Pkwy, Suite A425 HENDERSON, NV 89014(702) 458-2551		The WLB Group Inc. Engineering • Landscape Architecture Planning • Urban Design • Surveying 2551 N. Green Valley Pkwy, Suite A425 HENDERSON, NV 89014(702) 458-2551	
REV	DATE	BY	REVISION
1	1/12/20	JPM	CHANGED 12-7-19
2	1/12/20	JPM	KB 6/24/20

22625 23145