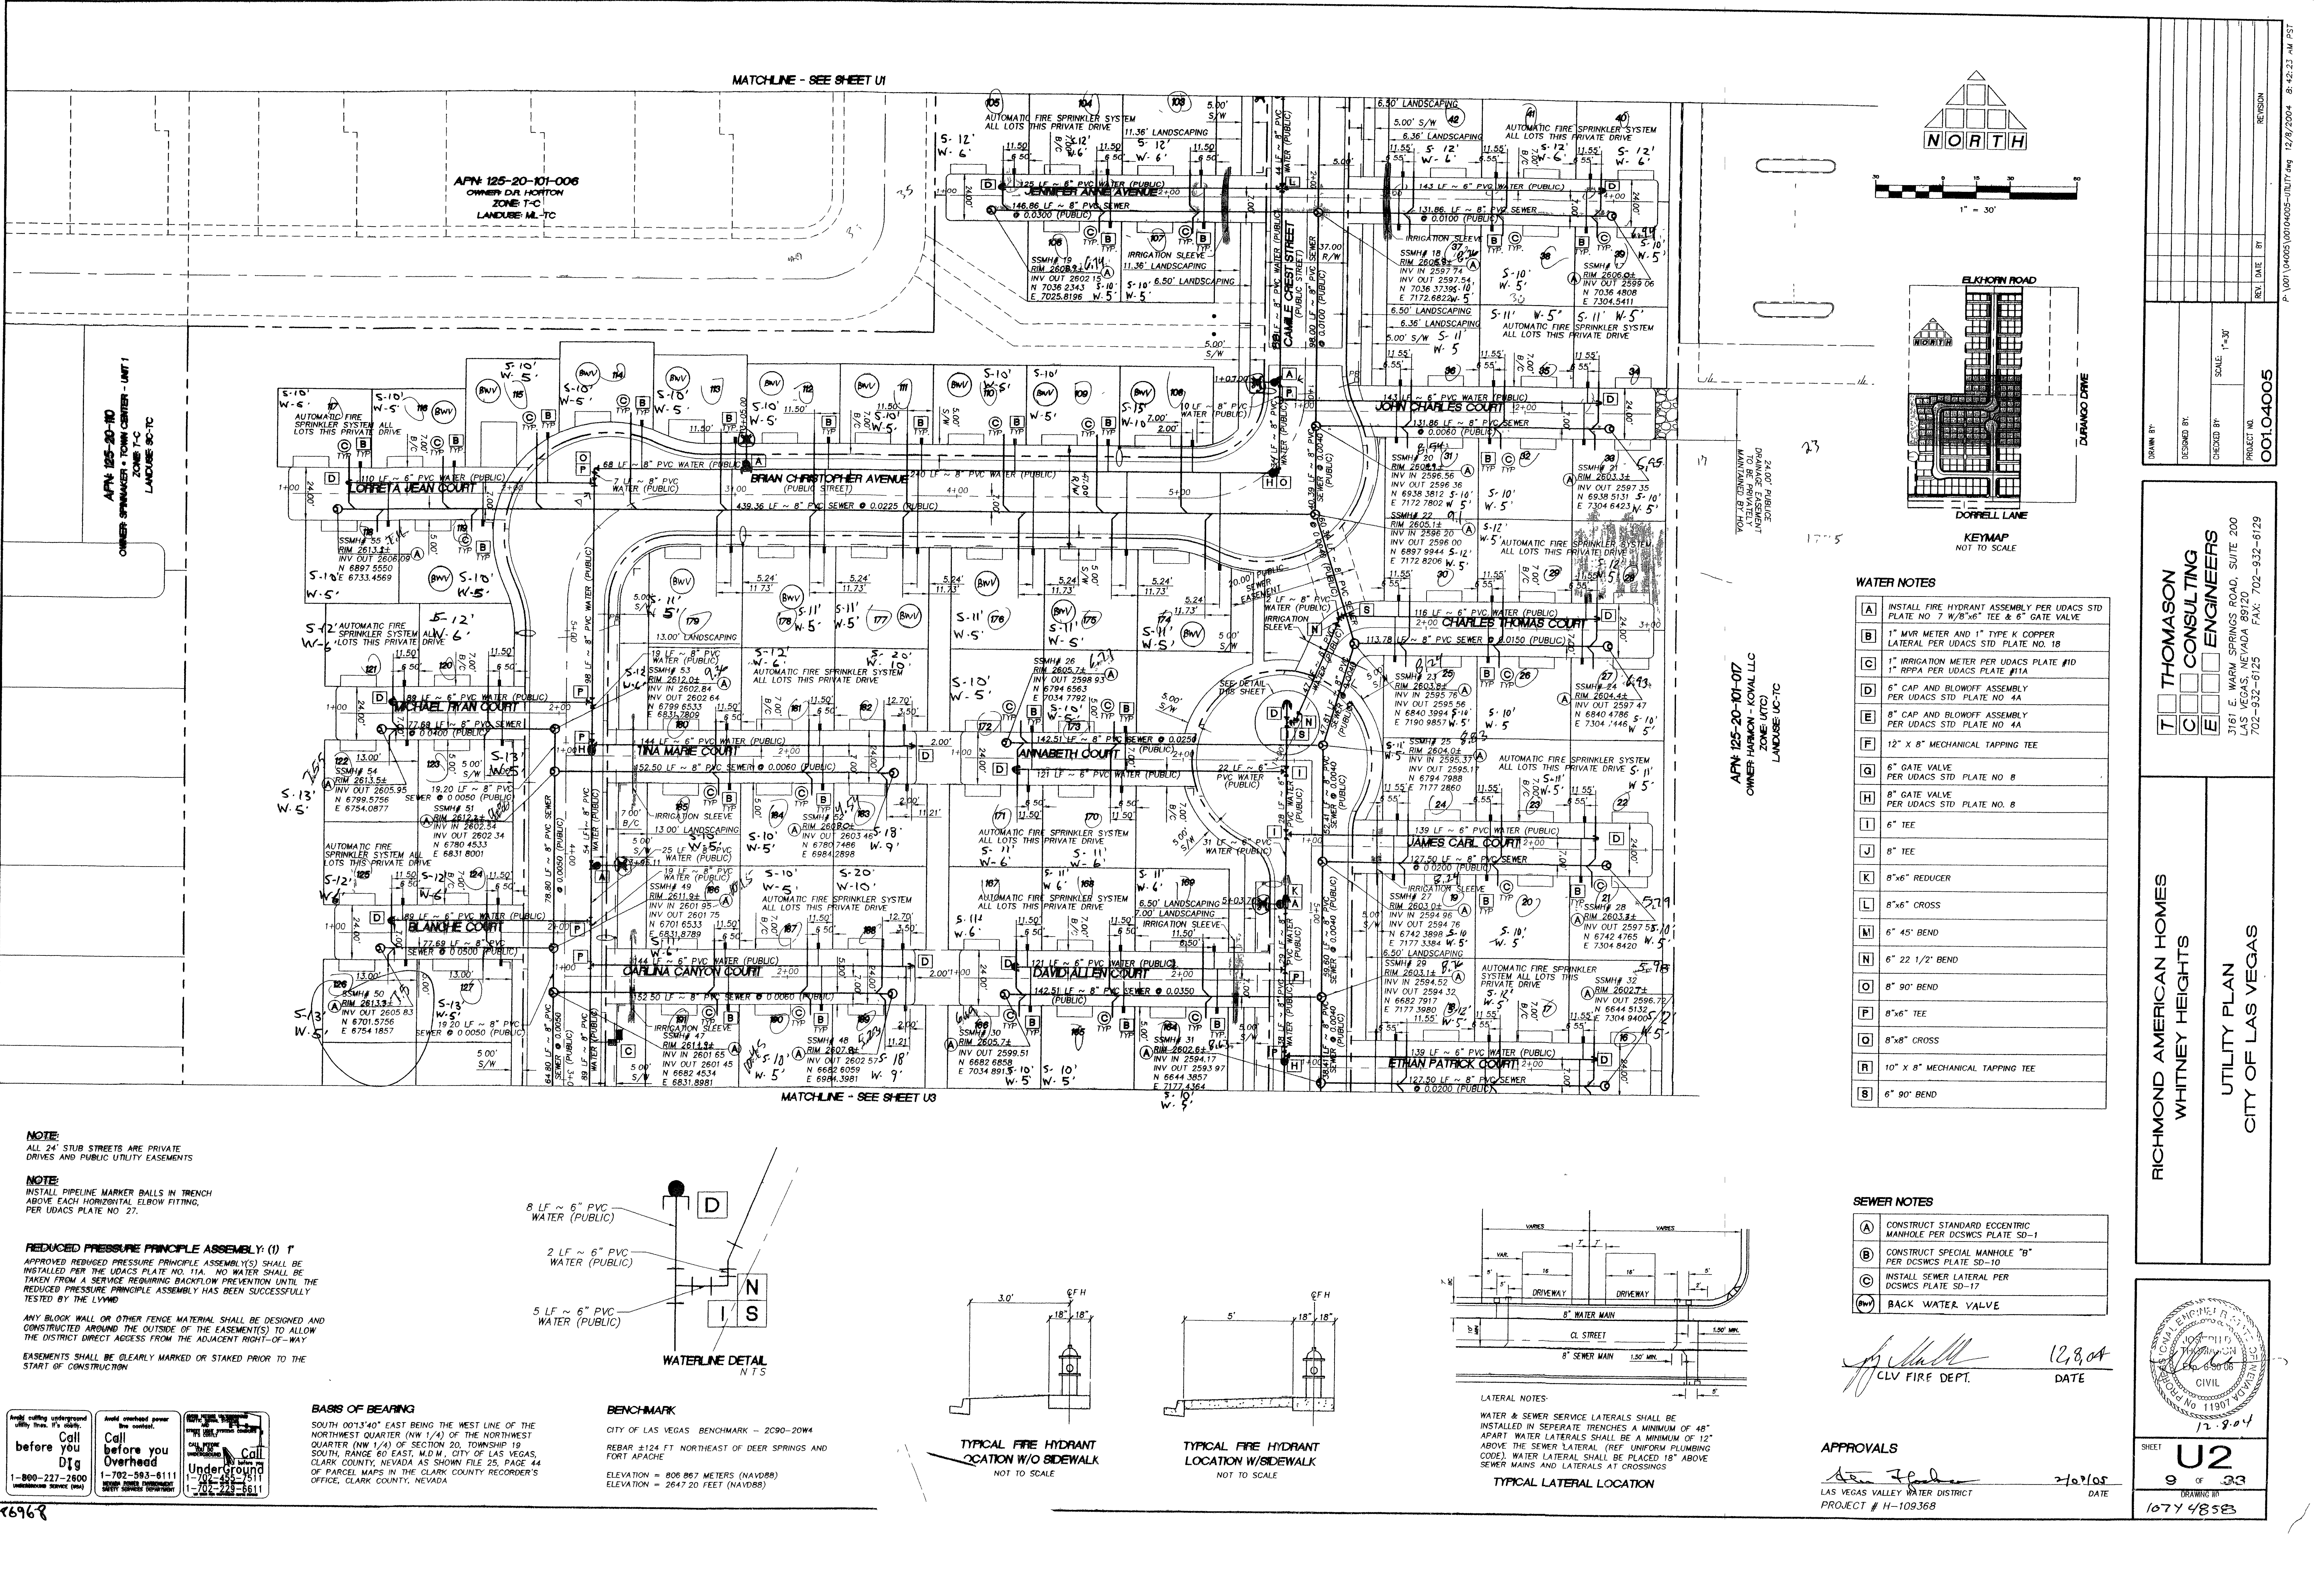


SYMBOL	DESCRIPTION
[A]	INSTALL FIRE HYDRANT ASSEMBLY PER UDACS STD PLATE NO. 7 W/8"X6" TEE & 6" GATE VALVE
[B]	1" MVR METER AND 1" TYPE K COPPER LATERAL PER UDACS STD PLATE NO. 18
[C]	1" IRRIGATION METER PER UDACS PLATE #10 1" RPFA PER UDACS PLATE #11A
[D]	6" CAP AND BLOWOFF ASSEMBLY PER UDACS STD PLATE NO. 4A
[E]	8" CAP AND BLOWOFF ASSEMBLY PER UDACS STD PLATE NO. 4A
[F]	12" X 8" MECHANICAL TAPPING TEE
[G]	6" GATE VALVE PER UDACS STD PLATE NO. 8
[H]	8" GATE VALVE PER UDACS STD PLATE NO. 8
[I]	6" TEE
[J]	8" TEE
[K]	8"x6" REDUCER
[L]	8"x6" CROSS
[M]	6" 45° BEND
[N]	6" 22 1/2° BEND
[O]	8" 90° BEND
[P]	8"x6" TEE
[Q]	8"x8" CROSS
[R]	10" X 8" MECHANICAL TAPPING TEE
[S]	6" 90° BEND

WATER NOTES

[A] INSTALL FIRE HYDRANT ASSEMBLY PER UDACS STD PLATE NO. 7 W/8"X6" TEE & 6" GATE VALVE

[B] 1" MVR METER AND 1" TYPE K COPPER LATERAL PER UDACS STD PLATE NO. 18

[C] 1" IRRIGATION METER PER UDACS PLATE #10 1" RPFA PER UDACS PLATE #11A

[D] 6" CAP AND BLOWOFF ASSEMBLY PER UDACS STD PLATE NO. 4A

[E] 8" CAP AND BLOWOFF ASSEMBLY PER UDACS STD PLATE NO. 4A

[F] 12" X 8" MECHANICAL TAPPING TEE

[G] 6" GATE VALVE PER UDACS STD PLATE NO. 8

[H] 8" GATE VALVE PER UDACS STD PLATE NO. 8

[I] 6" TEE

[J] 8" TEE

[K] 8"x6" REDUCER

[L] 8"x6" CROSS

[M] 6" 45° BEND

[N] 6" 22 1/2° BEND

[O] 8" 90° BEND

[P] 8"x6" TEE

[Q] 8"x8" CROSS

[R] 10" X 8" MECHANICAL TAPPING TEE

[S] 6" 90° BEND


SEWER NOTES

[A] CONSTRUCT STANDARD ECCENTRIC MANHOLE PER DCSWCS PLATE SD-1

[B] CONSTRUCT SPECIAL MANHOLE "B" PER DCSWCS PLATE SD-10

[C] INSTALL SEWER LATERAL PER DCSWCS PLATE SD-17

[D] BACK WATER VALVE

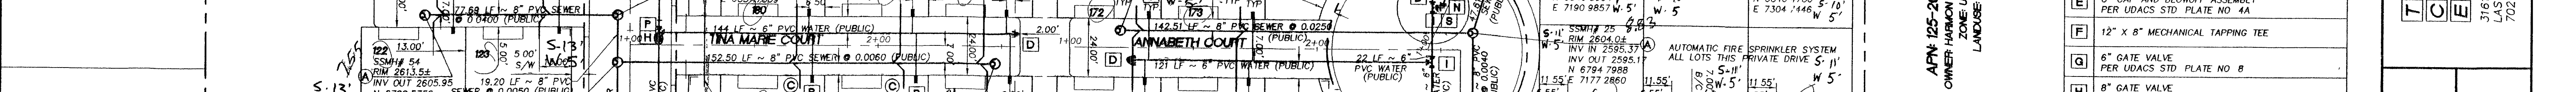

WATERLINE DETAIL

8 LF ~ 6" PVC WATER (PUBLIC)

2 LF ~ 6" PVC WATER (PUBLIC)

5 LF ~ 6" PVC WATER (PUBLIC)

SEWER DETAIL

8 LF ~ 8" PVC SEWER (PUBLIC)

2 LF ~ 8" PVC SEWER (PUBLIC)

5 LF ~ 8" PVC SEWER (PUBLIC)

APPROVALS

CLV FIRE DEPT. DATE 12/8/04

DATE 2/10/05

APPROVALS

DATE 2/10/05

APPROVALS

DATE 2/10/05