

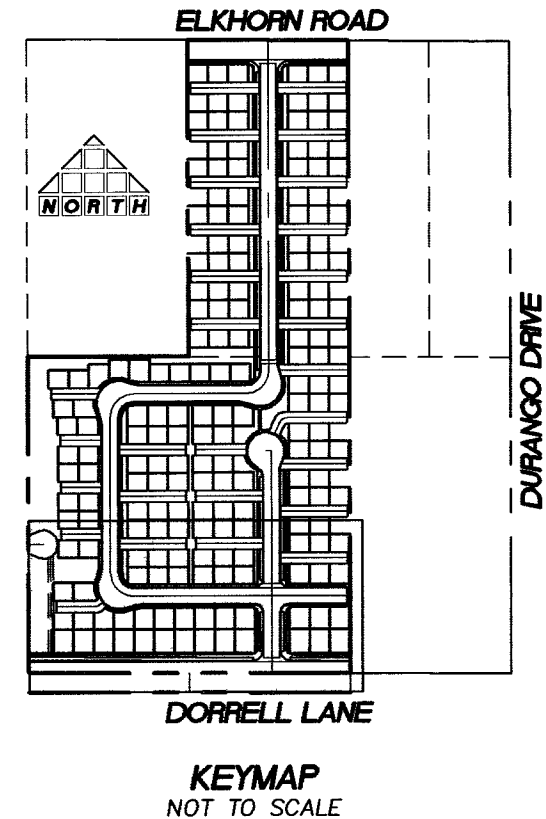


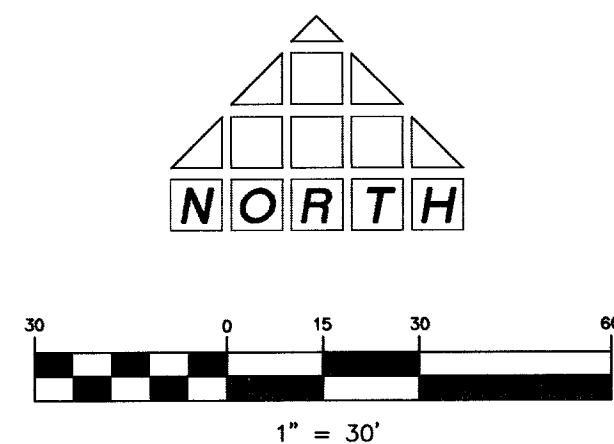

- LEGEND**
- PROPOSED 400W HPS TS POLE XX-A
 - PROPOSED 250 W HPS STREETLIGHT
 - PROPOSED 200 W HPS STREETLIGHT
 - PROPOSED 150W HPS STREETLIGHT
 - PROPOSED 100W HPS STREETLIGHT
 - EXISTING STREETLIGHT
 - PROPOSED STREETLIGHT SERVICE POINT
 - PROPOSED 3 1/2 PULLBOX
 - PROPOSED STREETLIGHT CONDUIT
 - PROPOSED 3" CONDUIT WITH (1) #8 THW AND PULLSTRING FOR "F.A.S.T."
 - STOP SIGN
 - STREET NAME SIGN
 - "NO PARKING BEYOND THIS POINT" SIGN PER USD #213.
 - SIGHT VISIBILITY RESTRICTION ZONES PER STD. DWG. 201.1 (NOTHING OVER 24" IN HEIGHT ALLOWED IN SVZ EXCEPT TRAFFIC CONTROL DEVICES)

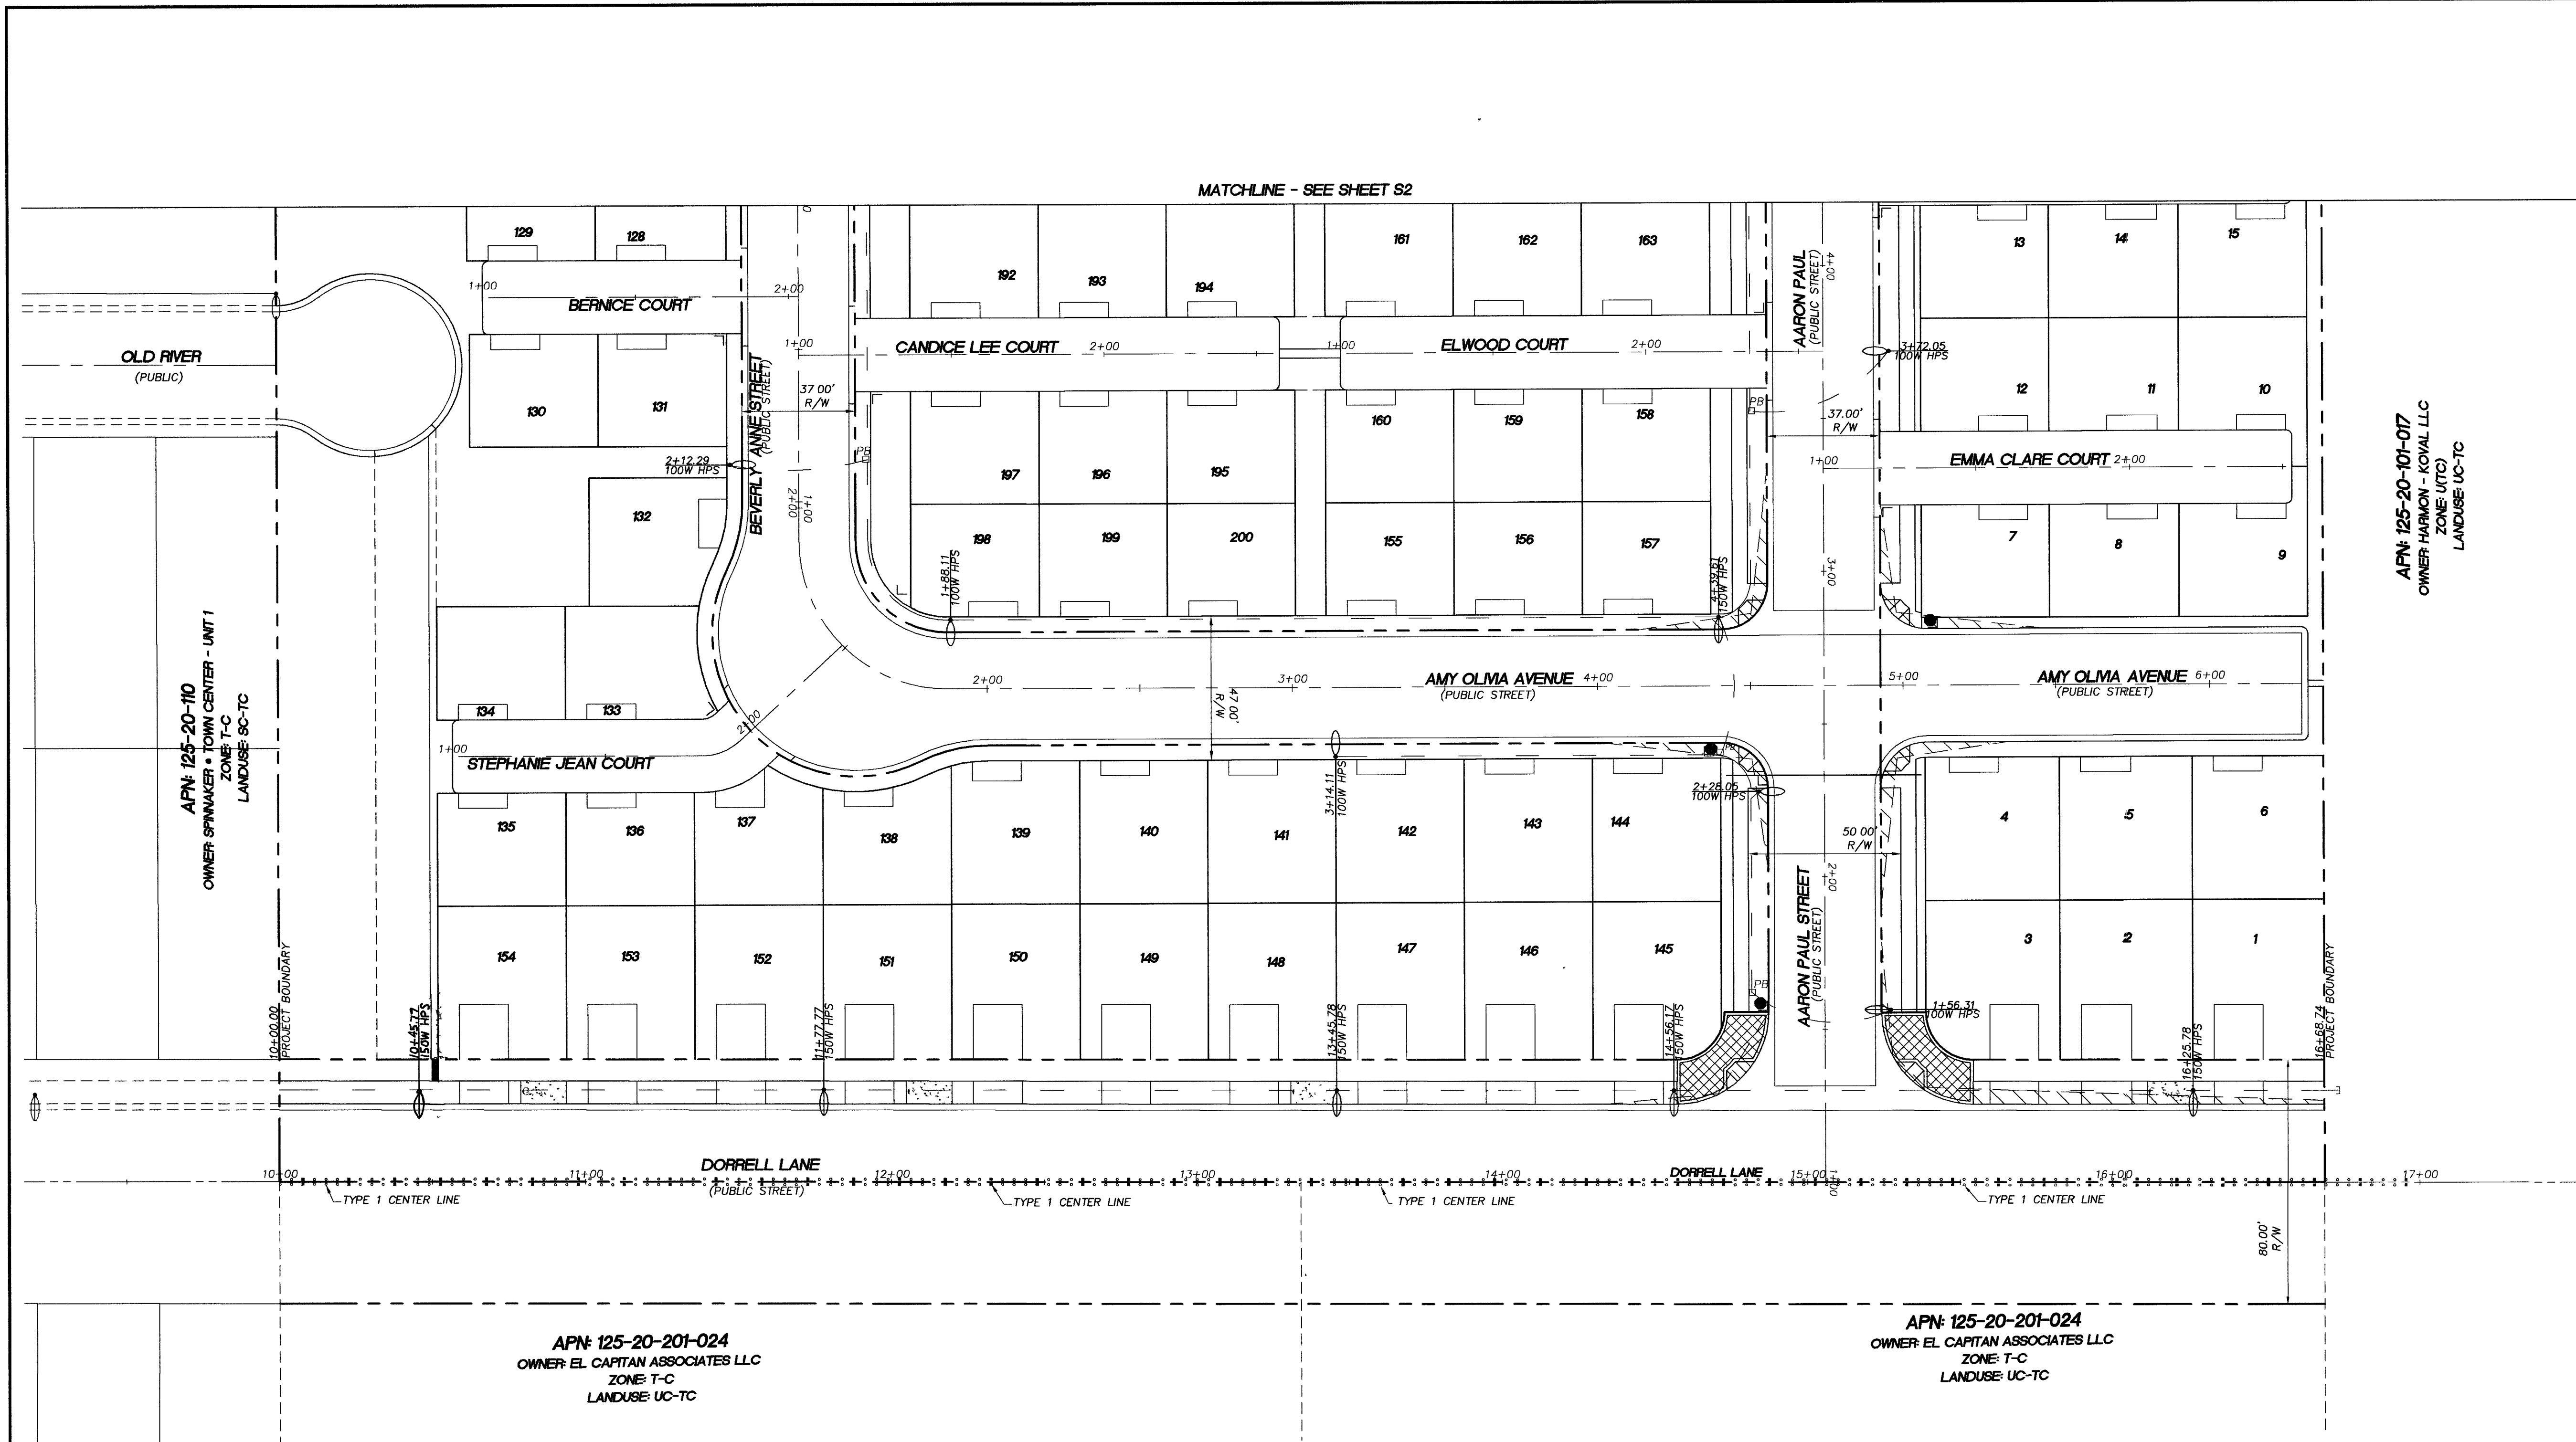





Avoid cutting underground utility lines. It's costly.
Call before you Dig
1-800-227-2600
UNDERGROUND SERVICE (USA)

Avoid overhead power line contact.
Call before you Overhead
1-702-593-6111
UTAH POWER CORPORATION
SAFETY SERVICE DEPARTMENT

CALL BEFORE YOU DIG
UNDERGROUND
1-702-455-7511
1-702-228-6611

BASIS OF BEARING
NORTH 89°54'17" EAST, BEING THE SOUTH LINE OF THE SOUTHEAST QUARTER (SE 1/4) OF THE NORTHWEST QUARTER (NW 1/4) OF SECTION 20, TOWNSHIP 19 SOUTH, RANGE 60 EAST, M.D.M., CLARK COUNTY, NEVADA AS SHOWN IN FILE 118 OF SURVEYS AT PAGE 89, OFFICIAL RECORDS, COUNTY OF CLARK, STATE OF NEVADA

BENCHMARK
CITY OF LAS VEGAS VERTICAL CONTROL POINT "8LV90 18SES", BEING A RIVET PLATE IN A CONCRETE CYLINDER, NORTHWEST CORNER OF ELKHORN AND FORT APACHE
ELEVATION: 2675.26 (FEET)
815.4214 (METERS)
CITY OF LAS VEGAS VERTICAL CONTROL BASED ON NORTH AMERICAN VERTICAL DATUM OF 1988 (NAVD 88)

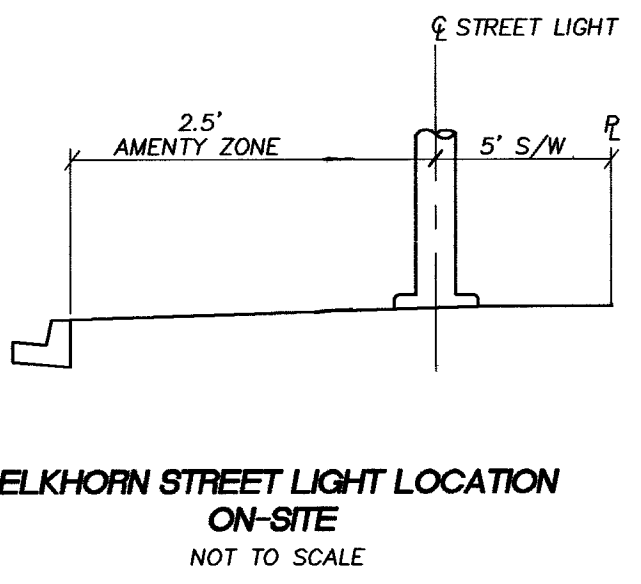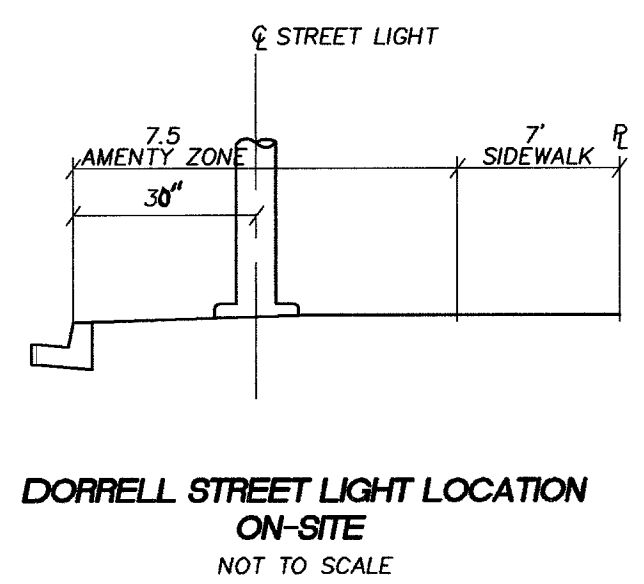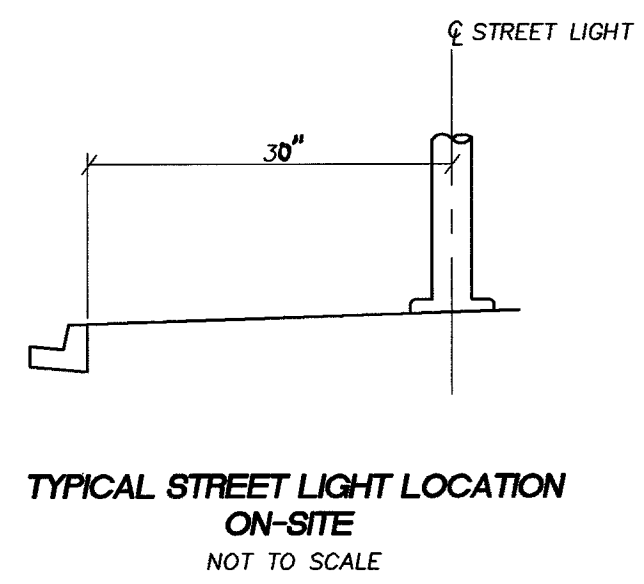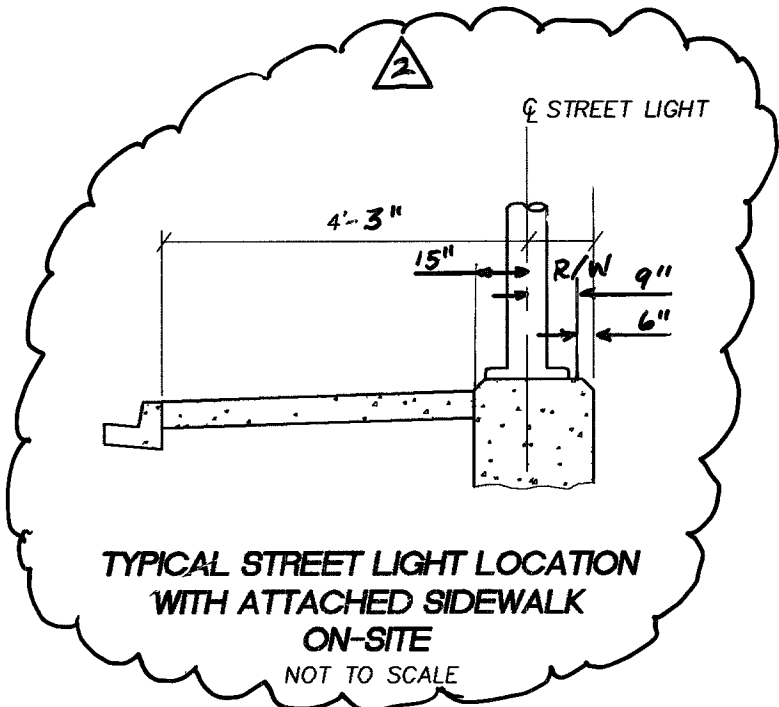

DRAWN BY		DESIGNED BY		CHECKED BY		SCALE		PROJECT NO		REVISION	
						1"=30'		001.04005			
THOMASON CONSULTING ENGINEERS											
3161 E. WARM SPRINGS ROAD, SUITE 200 LAS VEGAS, NEVADA 89120 702-932-6125 FAX: 702-932-6129											
RICHMOND AMERICAN HOMES WHITNEY HEIGHTS											
STREETLIGHT, SIGNAGE AND STRIPING PLAN											
SHEET S3 OF 33											
DRAWING NO. 1574/858											

11-2-2018 7:15:00 PM