
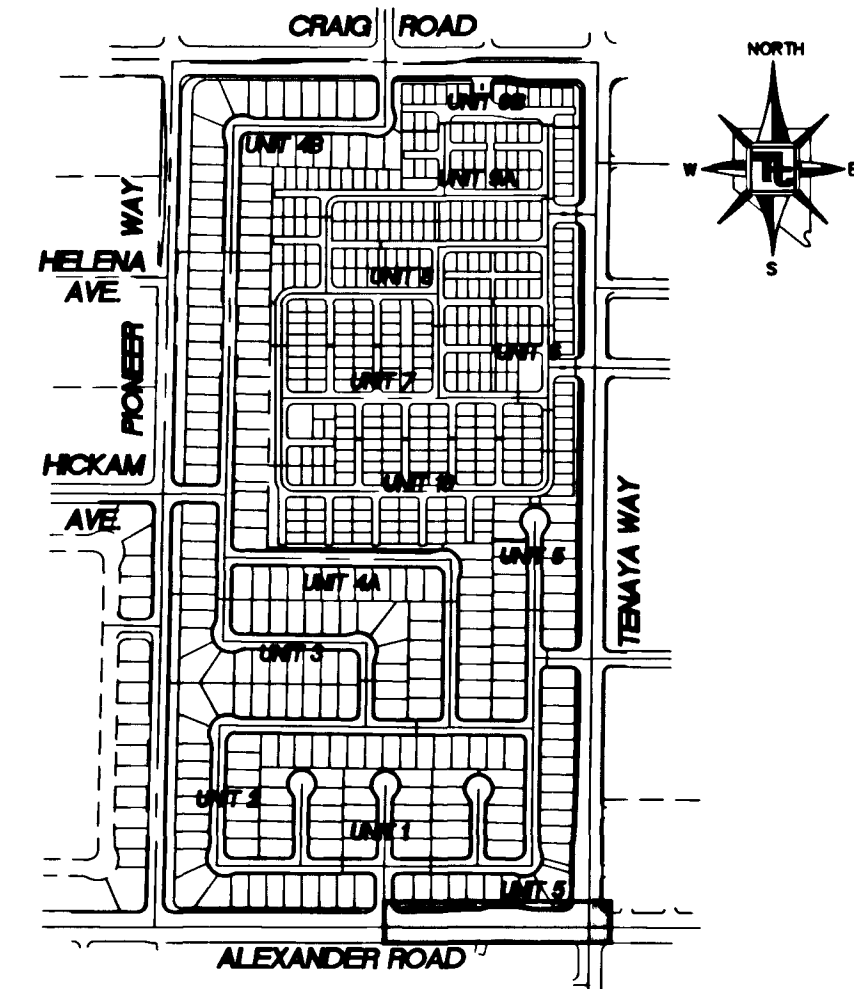
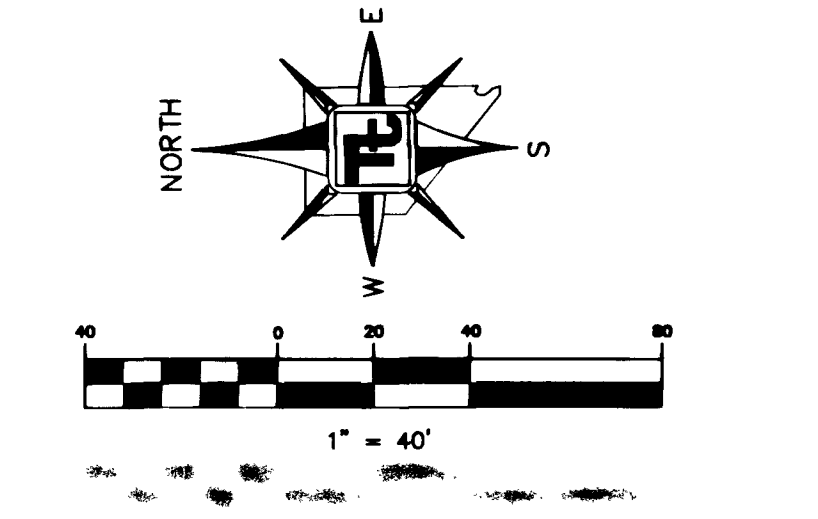


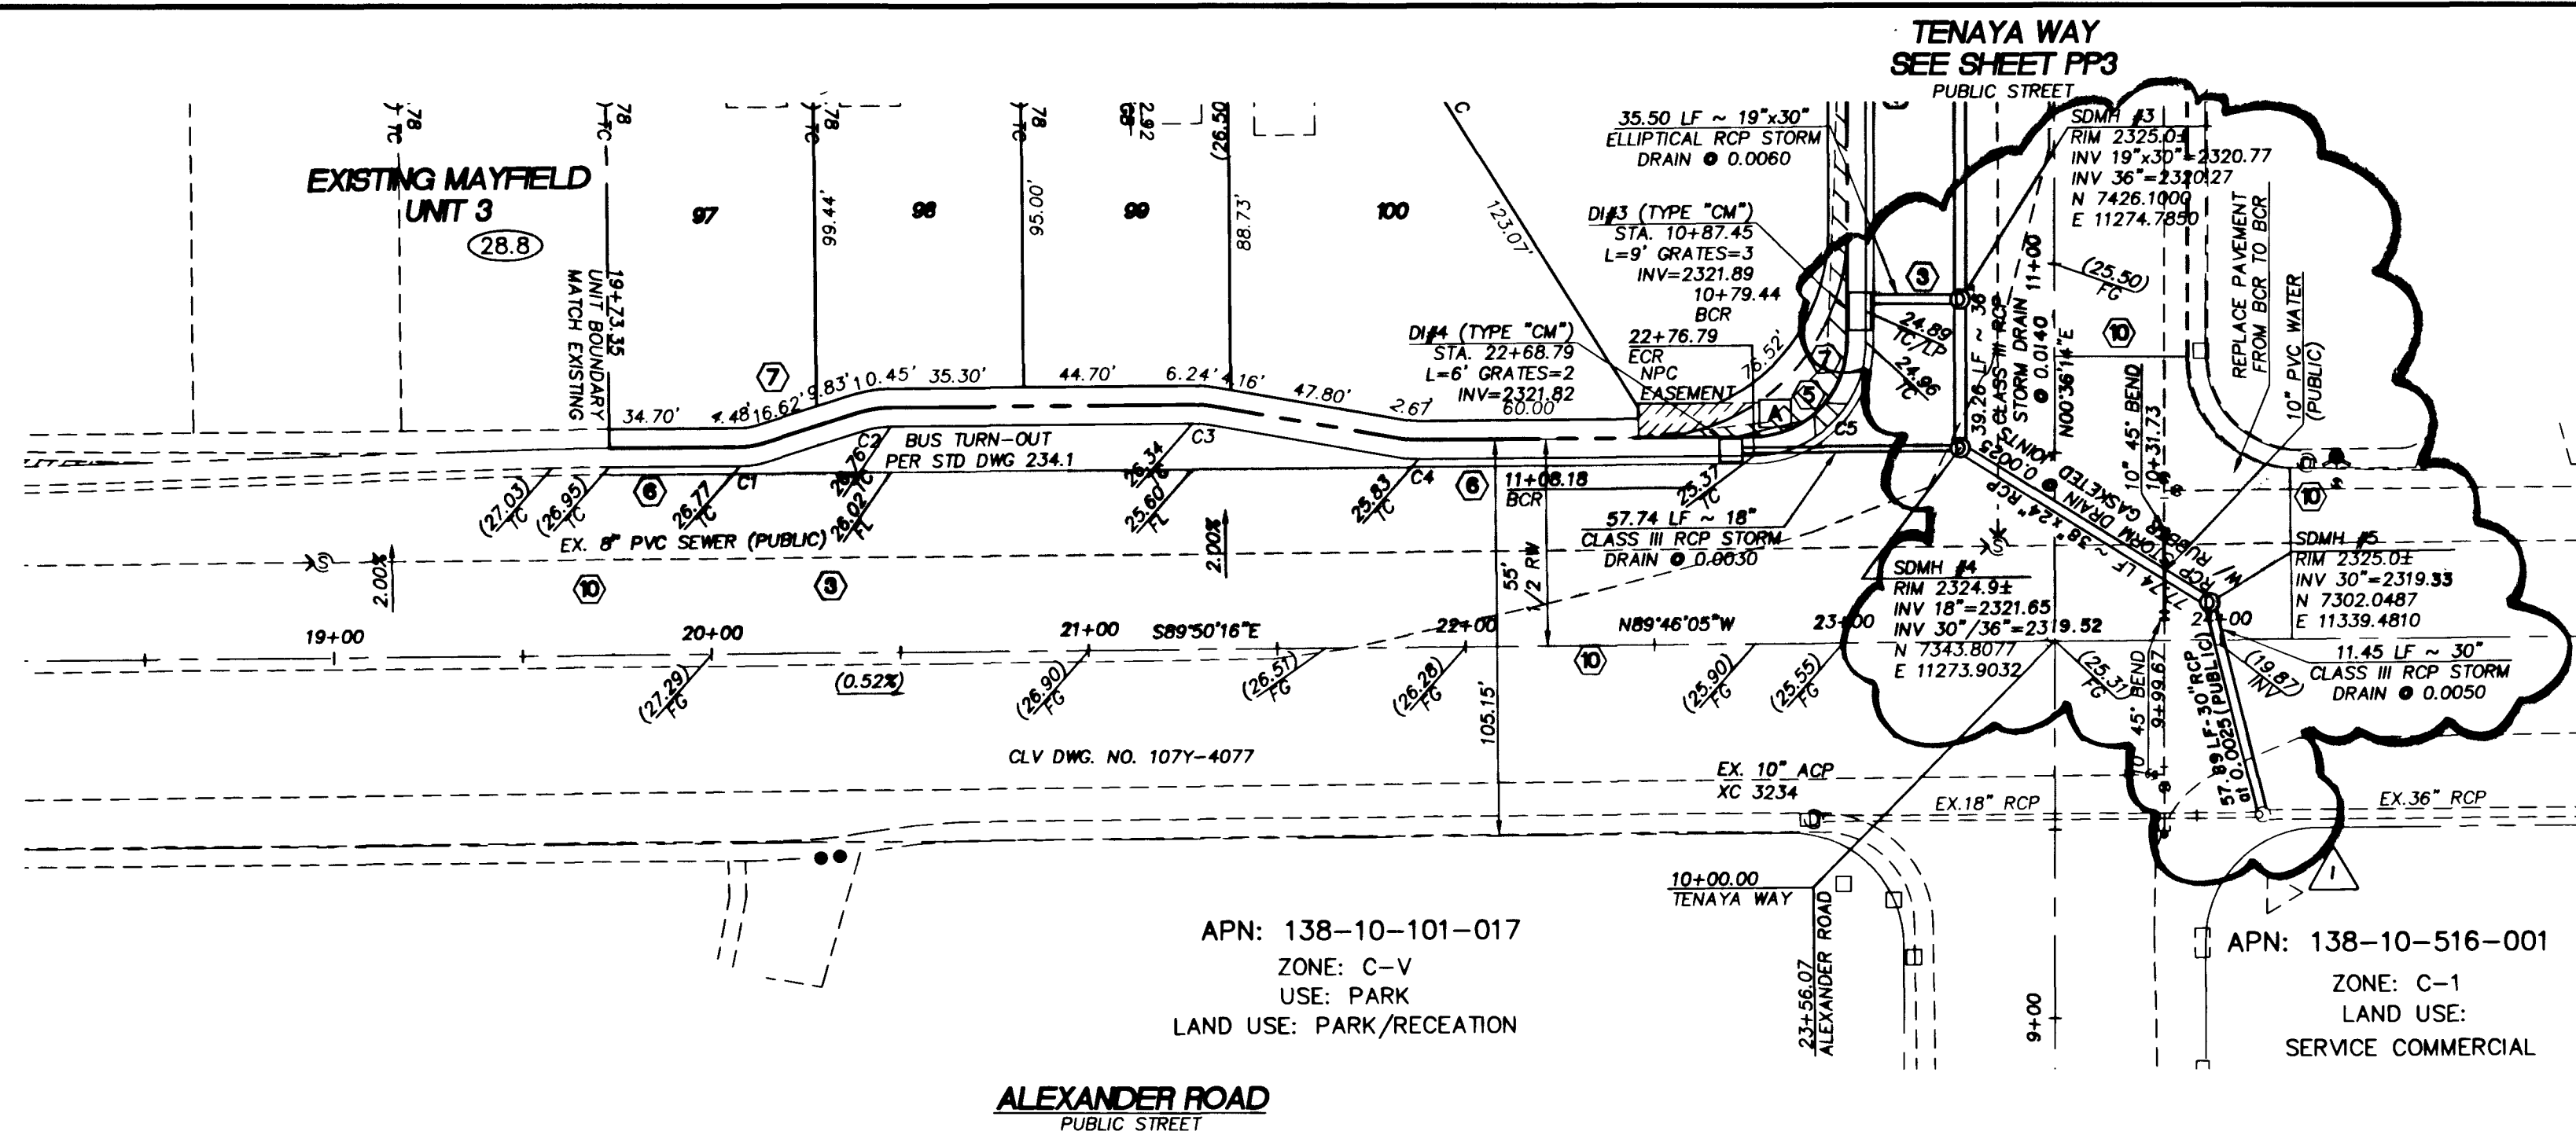


CURVE TABLE

CURVE	LENGTH	RADIUS	DELTA	TANGENT
C1	7.47'	25.00'	170°52'	3.76'
C2	7.47'	25.00'	170°52'	3.76'
C3	4.45'	25.00'	107°22'	2.23'
C4	4.45'	25.00'	107°22'	2.23'
C5	46.85'	30.00'	89°28'49"	29.73'
C6	27.05'	100.00'	147°42'33"	13.61'
C7	24.84'	100.00'	147°42'33"	12.49'
C8	47.12'	30.00'	90°00'00"	30.00'
C9	47.12'	30.00'	90°00'00"	30.00'
C10	23.60'	30.00'	45°03'57"	12.45'
C11	195.66'	41.50'	270°07'54"	41.40'
C12	23.60'	30.00'	45°03'57"	12.45'

H.C. RAMP DATA
PER STANDARD DRAWING 235

NO.	"A"	"B"	CASE
A	8.0'	8.0'	1

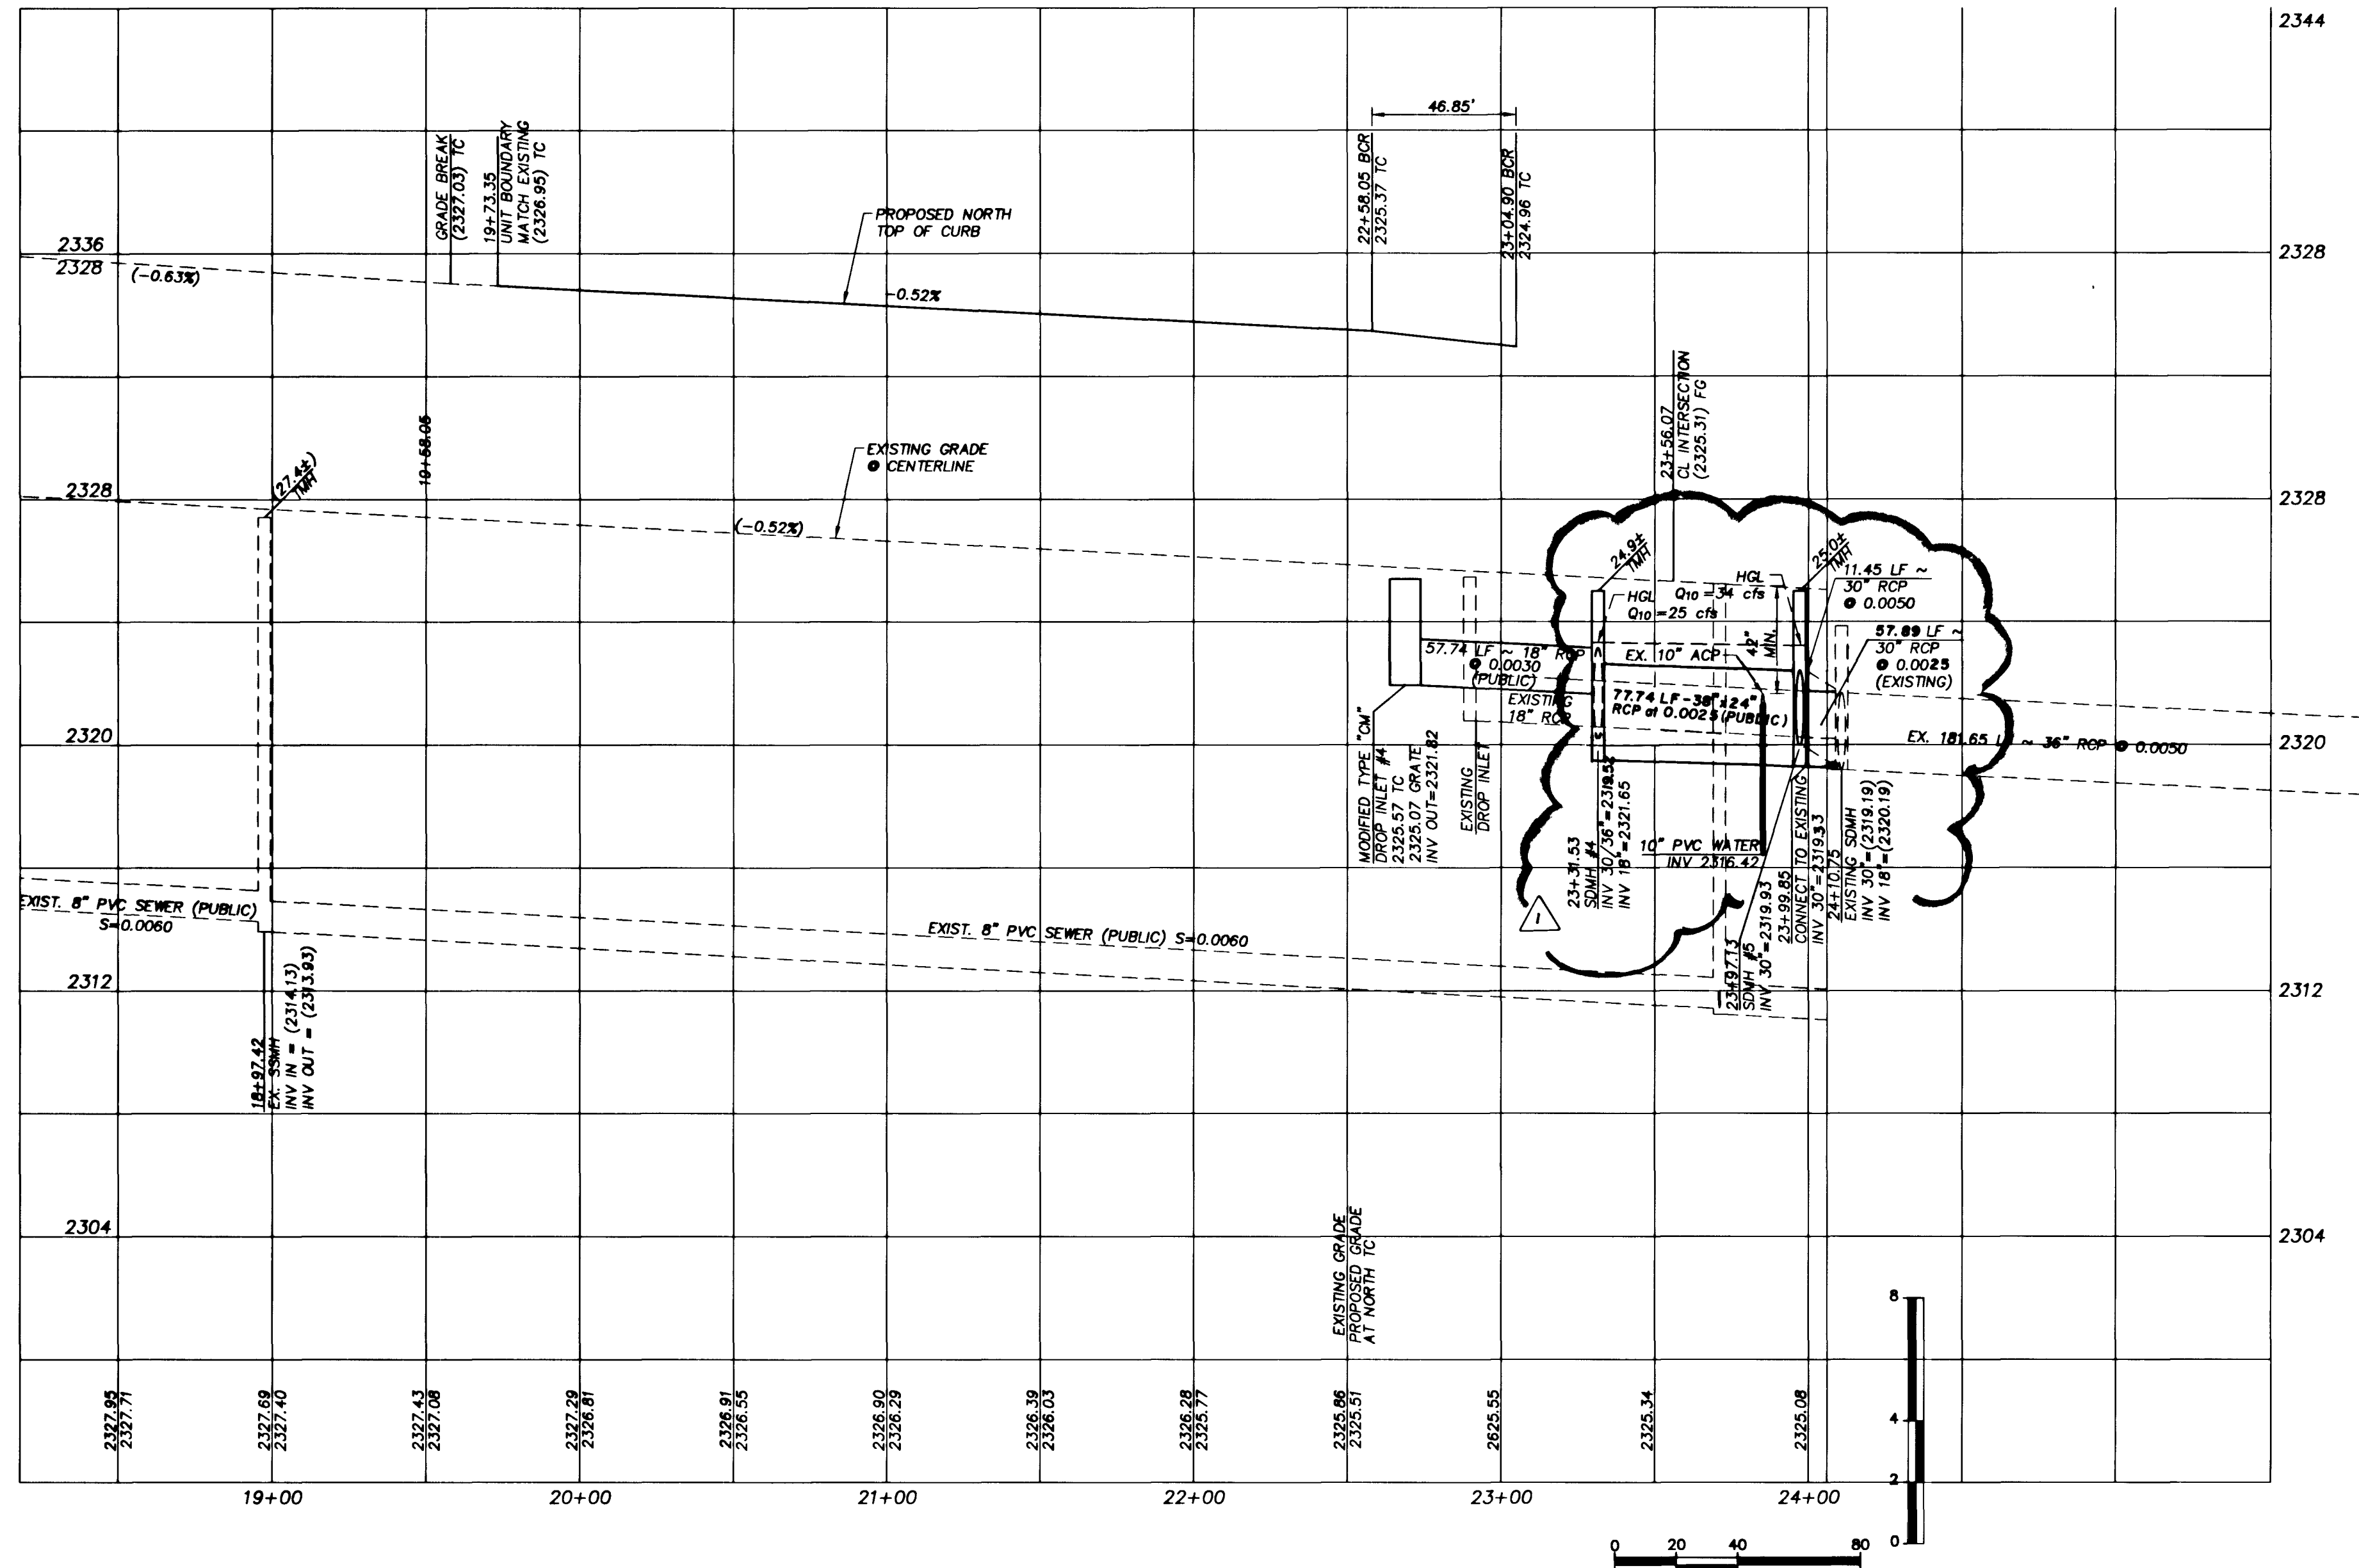

- CONSTRUCTION NOTES**
- CONSTRUCT 2" AC PAVING OVER 4" TYPE II ON 4.5" TYPE I BASE PER STD. DWG. 207
 - CONSTRUCT 3" AC PAVING OVER 4" TYPE II ON 5.5" TYPE I BASE PER STD. DWG. 205
 - CONSTRUCT 4" AC PAVING OVER 4" TYPE II ON 16.5" TYPE I BASE PER STD. DWG. 203
 - CONSTRUCT 5" AC PAVING OVER 4" TYPE II ON 16.5" TYPE I BASE PER STD. DWG. 203
 - CONSTRUCT SIDEWALK RAMP PER STD. DWG. 235
 - CONSTRUCT "L" TYPE CURB AND GUTTER PER STD. DWG. 216
 - CONSTRUCT CONCRETE SIDEWALK PER STD. DWG. 234
 - CONSTRUCT 8" CROSS GUTTER PER STD. DWG. 228
 - CONSTRUCT CONCRETE SIDEWALK UNDERDRAIN PER STD. DWG. 236
 - SAWCUT TO CENTERLINE. MATCH EXISTING
 - TRENCH AND BACKFILL PER DCSWCS STD. SD-168
 - PROVIDE BLOCKWALL OPENING FOR DRAINAGE.

NOTE:
DISPOSAL OF ASPHALT CONCRETE PIPE (ACP) SHALL BE IN ACCORDANCE WITH AWWA, LOCAL, STATE, AND FEDERAL REGULATIONS.

APPROVALS

[Signature] 9.9.03
LAS VEGAS VALLEY WATER DISTRICT DATE

Call before you dig
1-800-227-2600
UNDESIGNED SERVICE (USA)

Call before you Overhead
1-702-593-6111
UTILITY POWER COMPANY
SAFETY SERVICES DEPARTMENT

BASIS OF BEARING
BEARING SOUTH 00°36'14" WEST, BEING THE EAST LINE OF THE SOUTHWEST QUARTER (SW 1/4) OF SECTION 3, TOWNSHIP 20 SOUTH, RANGE 80 EAST, M.D.M., CITY OF LAS VEGAS, CLARK COUNTY, NEVADA, AS SHOWN IN FILE 98, PAGE 37 OF PARCEL MAPS.

BENCHMARK
CITY OF LAS VEGAS BENCHMARK 6LV00356
RIVET AND PLATE IN TOP OF CURB ON EAST SIDE OF TENAYA WAY ±400 FEET NORTH OF LARKVALE
ELEVATION: 709.4097 METERS (NAVD 88)
2327.45 FEET (NAVD 88)

KB HOME NEVADA INC. 750 PILOT ROAD, SUITE F LAS VEGAS, NEVADA 89119 (702) 614-2500		TETRA TECH, INC. INFRASTRUCTURE SOUTHWEST GROUP 301 N. Buffalo Dr. Suite 100, Las Vegas, Nevada 89105 (702) 242-4500
PLAN AND PROFILE ALEXANDER ROAD	TITLE MAYFIELD - UNIT 5 CITY OF LAS VEGAS	PROJECT NO. P08042-0037
SHEET PP4 12 OF 16	SCALE: 1"=40' DATE: 9.9.03	DRAWING NO. 10744709-5