

TRANSMITTAL

No. 01213

JMA ARCHITECTURE STUDIOS

PROJECT: William K. Moore E.S. CCSD #0695

DATE: 7/13/00

TO: City of Las Vegas

REF: Telephone Record No. 12

ATTN: Mike Snyder

JMA Project number: 98216

Phone: 229-6331

Fax: 382-8346

☐ Shop Drawings	☐ Approval	☐ Approved as Submitted
☐ Letter	☒ Your Use	☐ Approved as Noted
☐ Prints	☐ As Requested	☐ Returned After Loan
☐ Change Order	☐ Review and Comment	☐ Resubmit
☐ Plans	☐	☐ Submit
☐ Samples	☐	☐ Returned
☐ Specifications	☒ Attached	☐ Returned for Corrections
☐ Other	☐ Separate Cover Via	☐ Due Date:

ITEM NO.	COPIES	DATE	ITEM	REV. NO.	DESCRIPTION	STATUS
1	1	7/13/00	TEL. 12		Off Site Improvements	CLO

Remarks: Please see the attached Telephone Record No. 12, dated 7/13/00 regarding a conversation between JMA and CLV about off site improvements.

TELEPHONE RECORD

No. 12

JMA ARCHITECTURE STUDIOS

PROJECT: William K. Moore E.S. CCSD #0695

JOB: 0695

DATE: 7/13/2000

TIME: 9:30 am

TO: CLV MS

FROM: JMA JL

NAME: Mike Snyder

NAME: John Lopeman

PHONE: 229-6331

PHONE: 702-731-2033

SUBJECT: Off site improvements

DESCRIPTION

We believe the following record to be an accurate summary of decisions and related discussions. We will appreciate notification of exceptions to this record within (10) days of its receipt. Failing such notification, we will consider this a statement of fact in which you concur.

Mr. Snyder was asked if the Roche Construction had completed their responsibility as far as the flashing beacons are concerned. Mr. Snyder indicated the following were still incomplete:

1. Crash caps have not been installed at the flasher pole bases.
2. There is a section of sidewalk on the east side of Lamb Boulevard that has not been replaced where underground conduit has been installed.



3. The power service pedestal for the flashers has not been energized. It is required that NPCo receive a request from the CLV to energize the pedestal. The CLV must receive a request for inspection from Roche prior to requesting service from NPCo. Mr. Snyder also noted the wire from the transformer to the service pedestal must be installed by Roche (Vita). Roche should contact Manny Windhorst (375-6197) to schedule inspection.

CC:

Signed: Heather Guzman
Heather Guzman




10150 COWINGTON CROSS DRIVE LAS VEGAS NEVADA 89144 (702) 731-2033

10150 COWINGTON CROSS DRIVE LAS VEGAS NEVADA 89144 (702) 731-2033

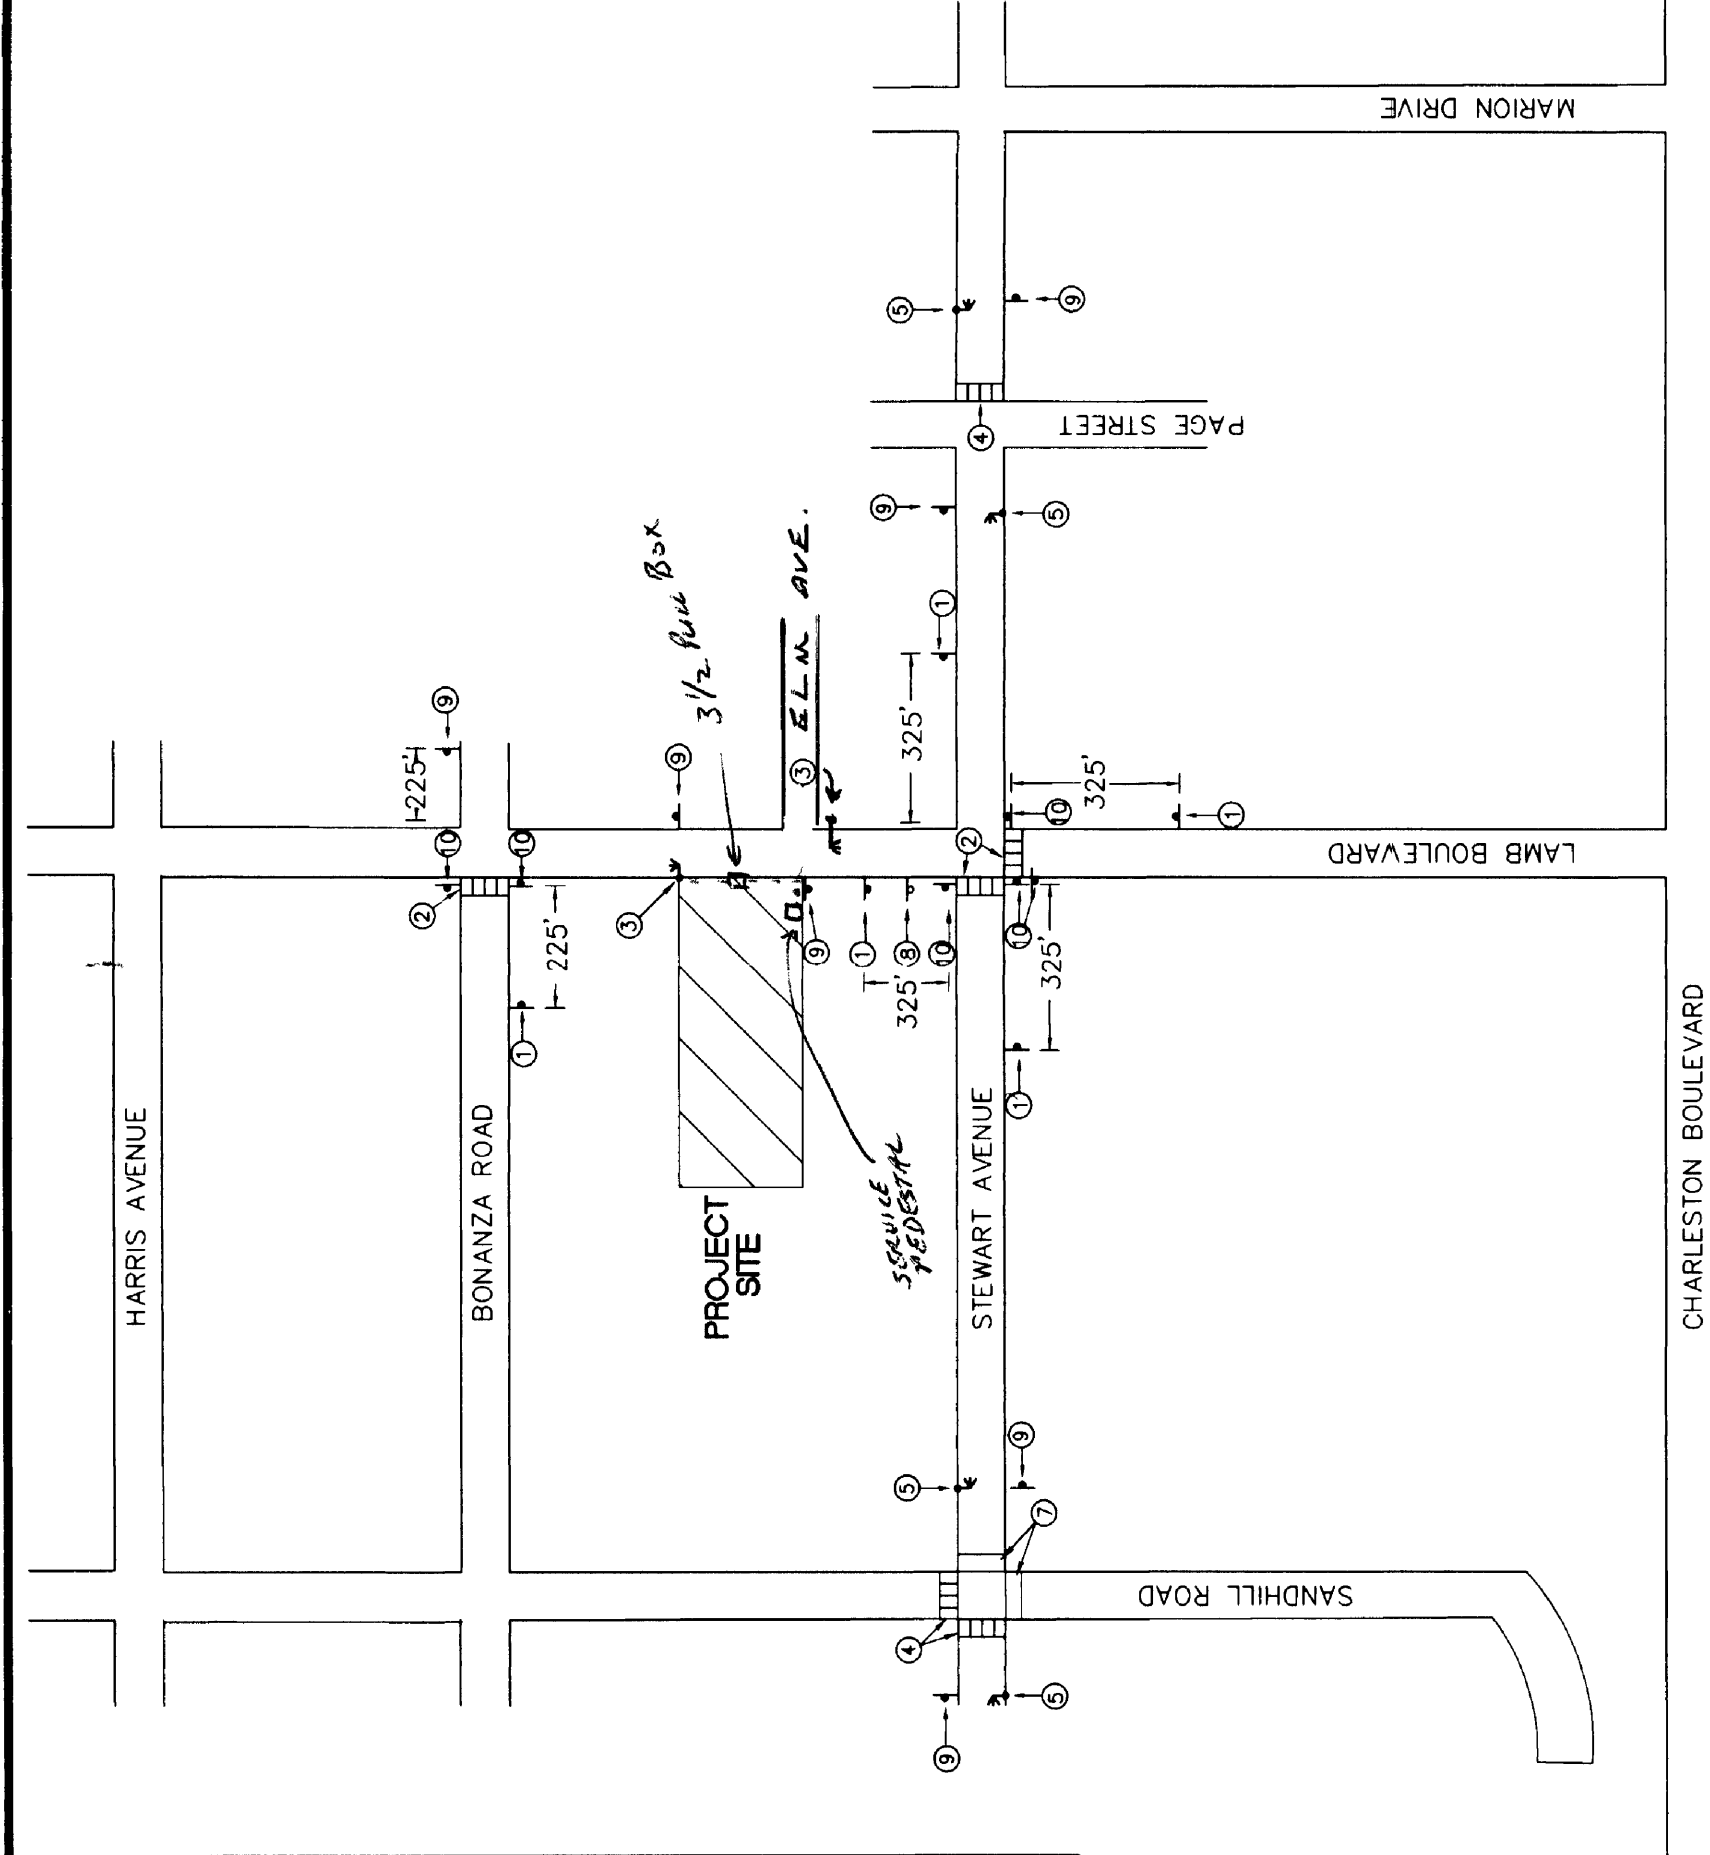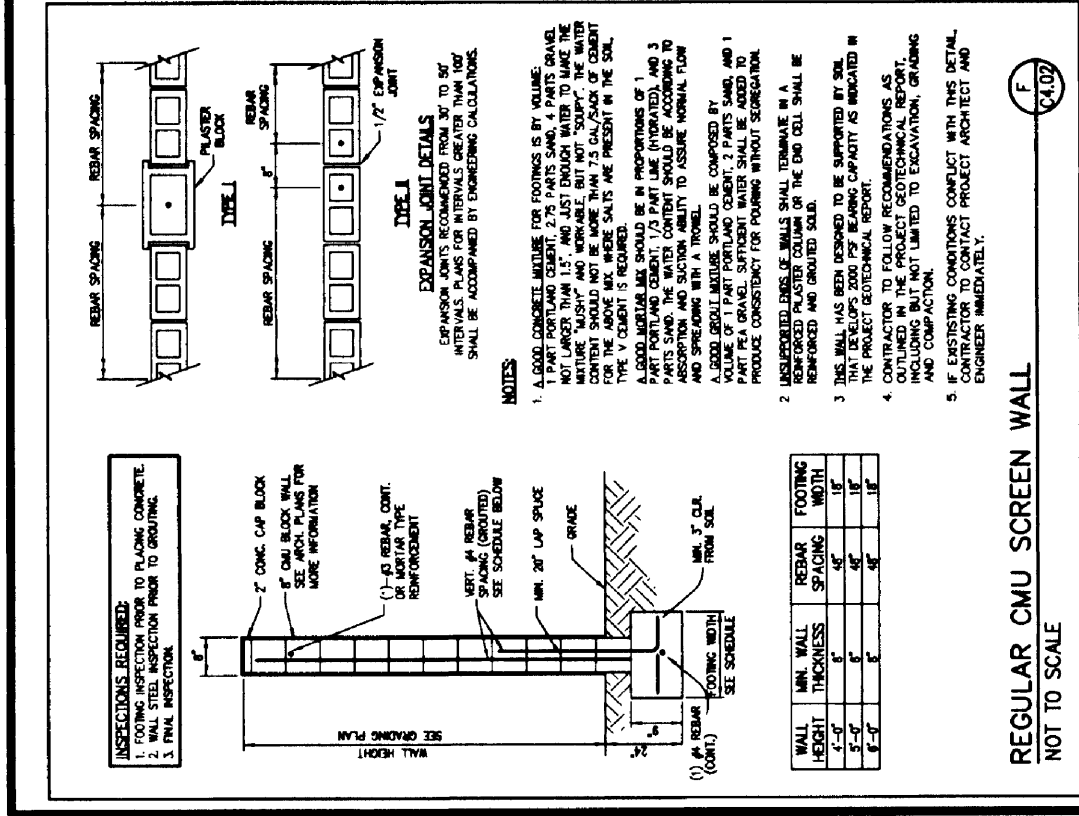

LEGEND

- PROPOSED SIGN
- EXISTING SIGN
- INSTALL S1-1 (36"x36")
- INSTALL S2-1 (36"x36")
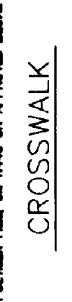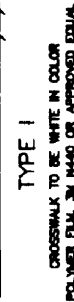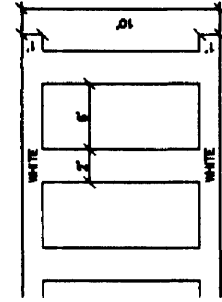

*NOTE: ALL OFFSITE SIGNAGE AND STRIPING ON THIS SHEET TO BE INSTALLED BY CLV FORCES WITH THE EXCEPTION OF UNDERGROUND CONDUITS, FOUNDATIONS, PULLBOXES, AND WIRES, ETC. FOR FLASHING BEACONS. CONTRACTORS TO COORDINATE WITH CLV FORCES. ALL ONSITE SIGNAGE AND STRIPING TO BE INSTALLED BY CONTRACTOR.

THE END SCHOOL ZONE SIGN SHOULD BE USED TO INDICATE THE END OF THE SCHOOL ZONE. THE SIGN SHOULD BE SCHEDULED FOR ALL YEAR.



