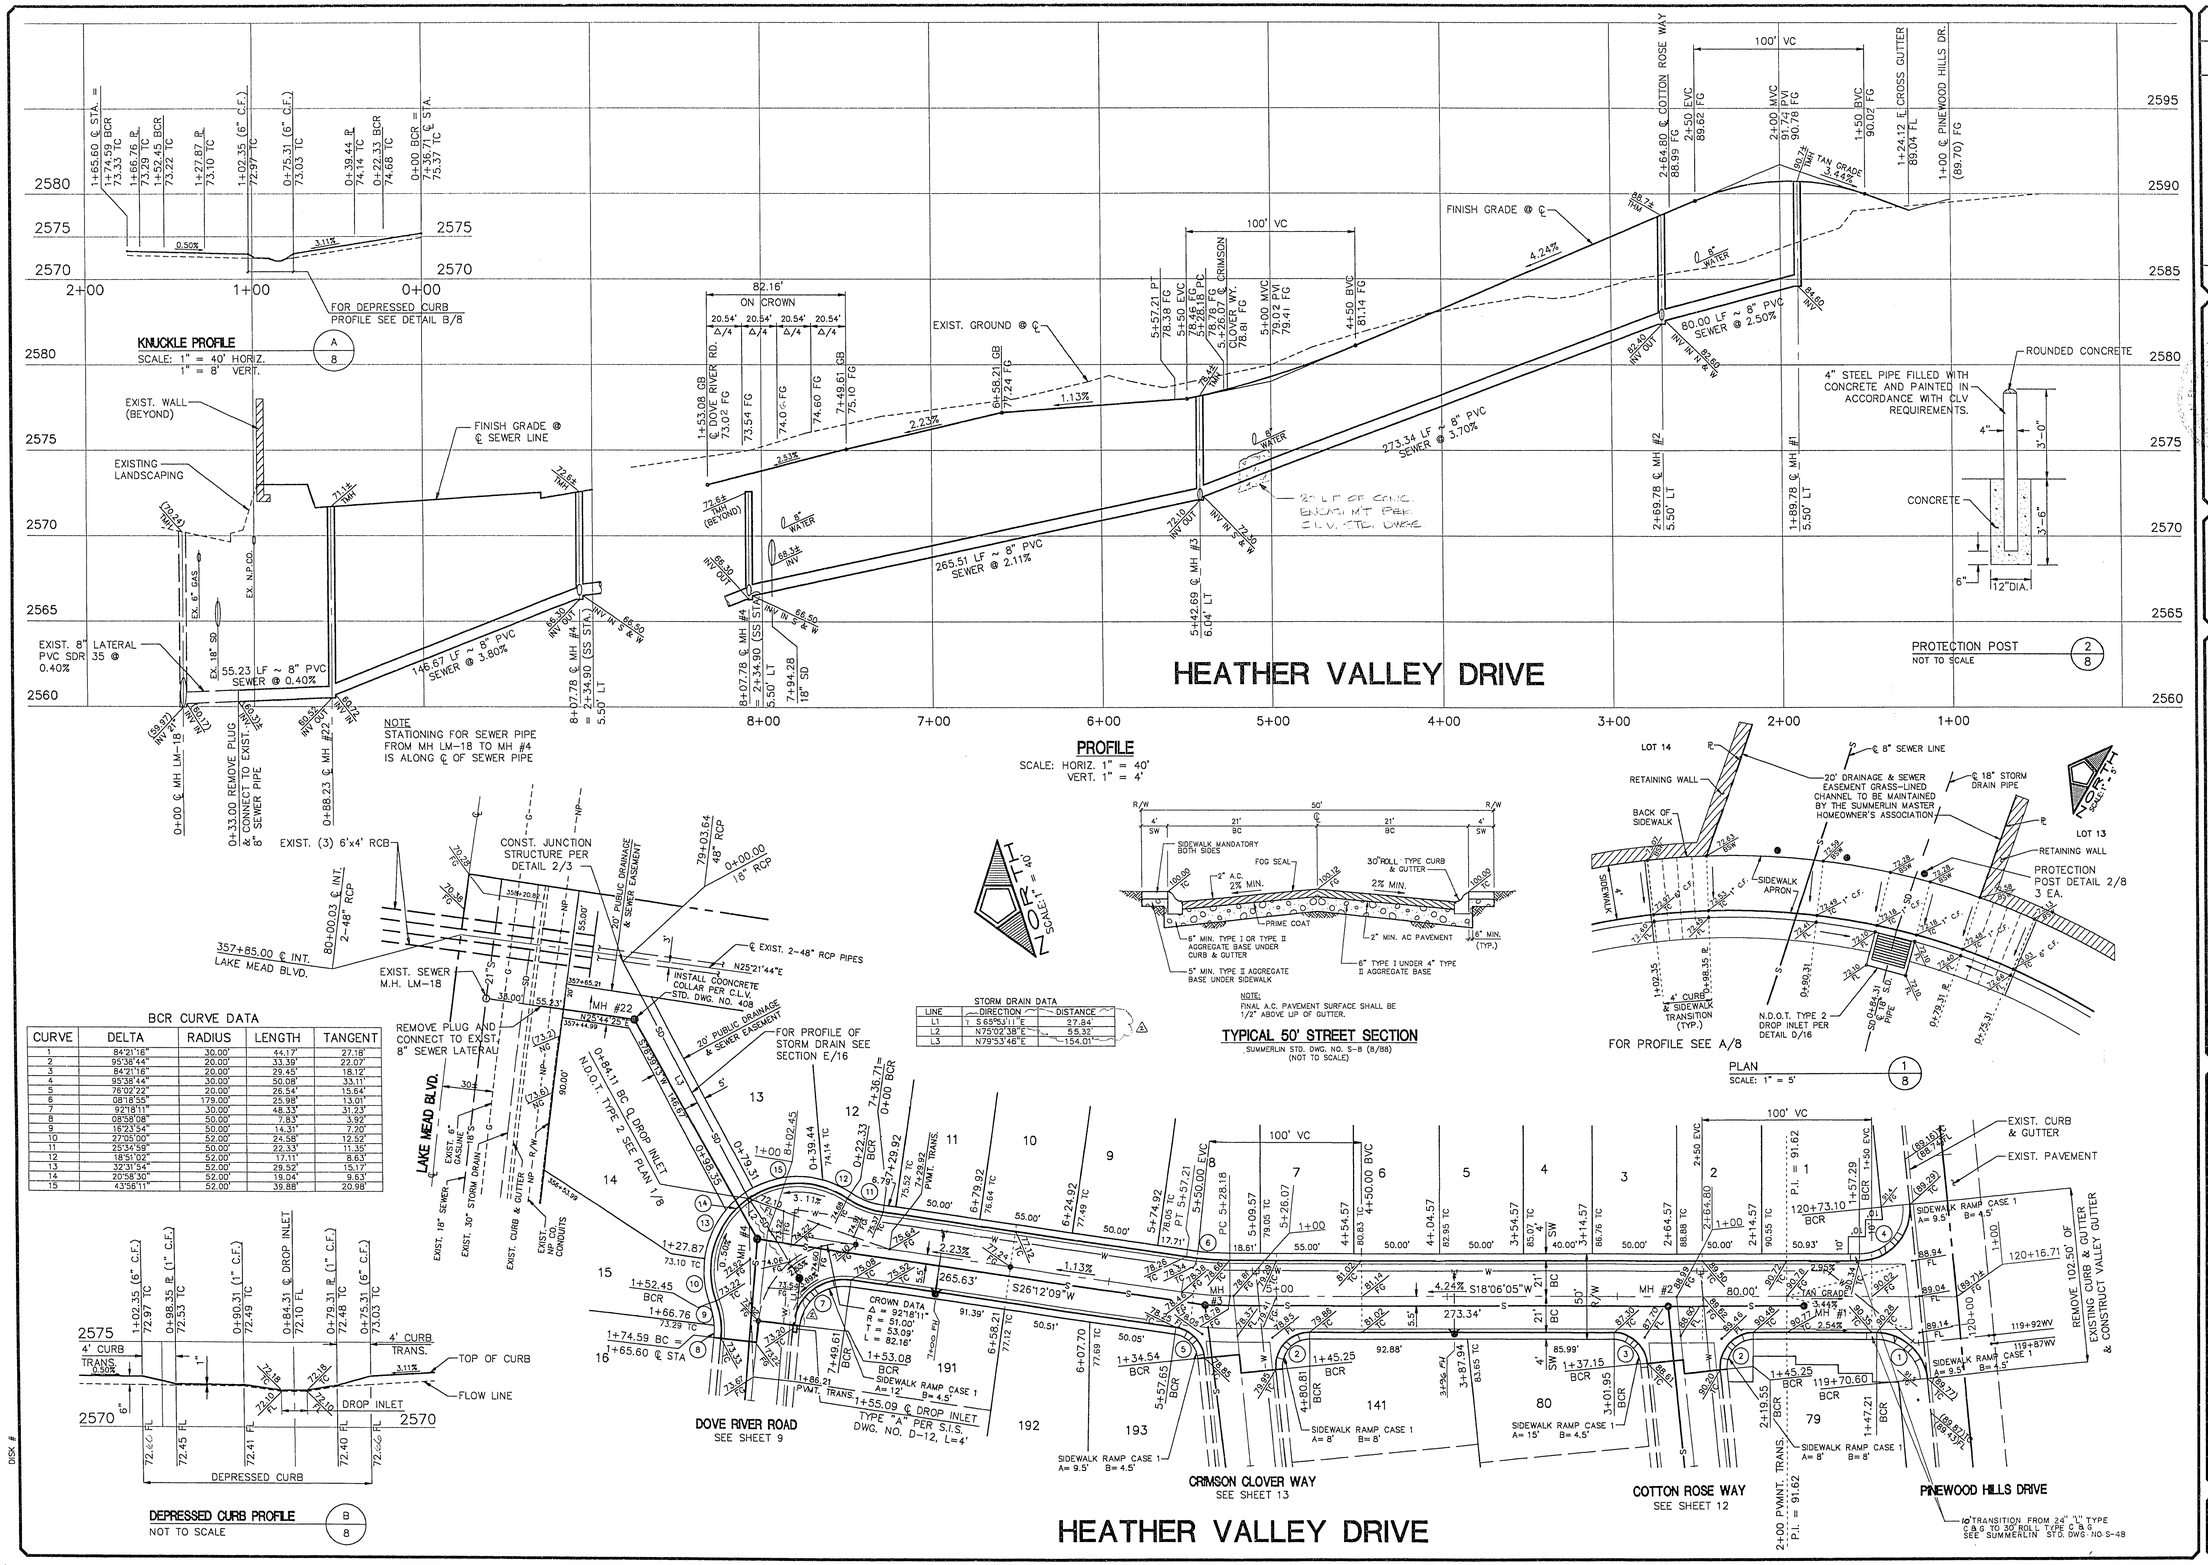

BCR CURVE DATA

CURVE	DELTA	RADIUS	LENGTH	TANGENT
1	84°21'16"	30.00'	44.17'	27.18'
2	95°38'44"	20.00'	33.39'	22.07'
3	84°21'16"	20.00'	29.45'	18.12'
4	95°38'44"	30.00'	50.08'	33.11'
5	76°02'22"	20.00'	26.54'	15.64'
6	08°18'55"	179.00'	25.98'	13.01'
7	92°18'11"	30.00'	48.33'	31.23'
8	08°58'08"	50.00'	7.83'	3.92'
9	16°23'54"	50.00'	14.31'	7.20'
10	27°05'00"	52.00'	24.58'	12.52'
11	25°34'59"	50.00'	22.33'	11.35'
12	18°51'02"	52.00'	17.11'	8.63'
13	32°31'54"	52.00'	29.52'	15.17'
14	20°58'30"	52.00'	19.04'	9.63'
15	43°56'11"	52.00'	39.88'	20.98'

STORM DRAIN DATA

LINE	DIRECTION	DISTANCE
L1	S 65°53'11"E	27.84'
L2	N75°02'38"E	55.32'
L3	N79°53'46"E	154.01'

REVISIONS			
4	LYONS ELV. EXCAVATION TOP OF BERM	2-3-93	
3	REVISED S.D. ALIGNMENT	2-25-93	
2	RELOCATED FIRE HYDRANTS	2-1-93	
NO.	DESCRIPTION	DATE	APP'D

RECOMMENDED: DEAN W. THASMUSON R.E. # 9193 DATE

DATE :	12/21/92
DRAWN BY :	CWC
DESIGNED BY :	MR
CHECKED BY :	DWR
JOB NO. :	0030.1020
SCALE :	1" = 40'

PENTACORE Engineering, Inc.
6763 West Charleston Boulevard
Las Vegas, Nevada 89102
(702) 258-0115

LEWIS HOMES OF NEVADA
WILLOW TREE
HEATHER VALLEY DRIVE

SHEET 8 OF 29

DISK #

107Y-42 42