27-5-24

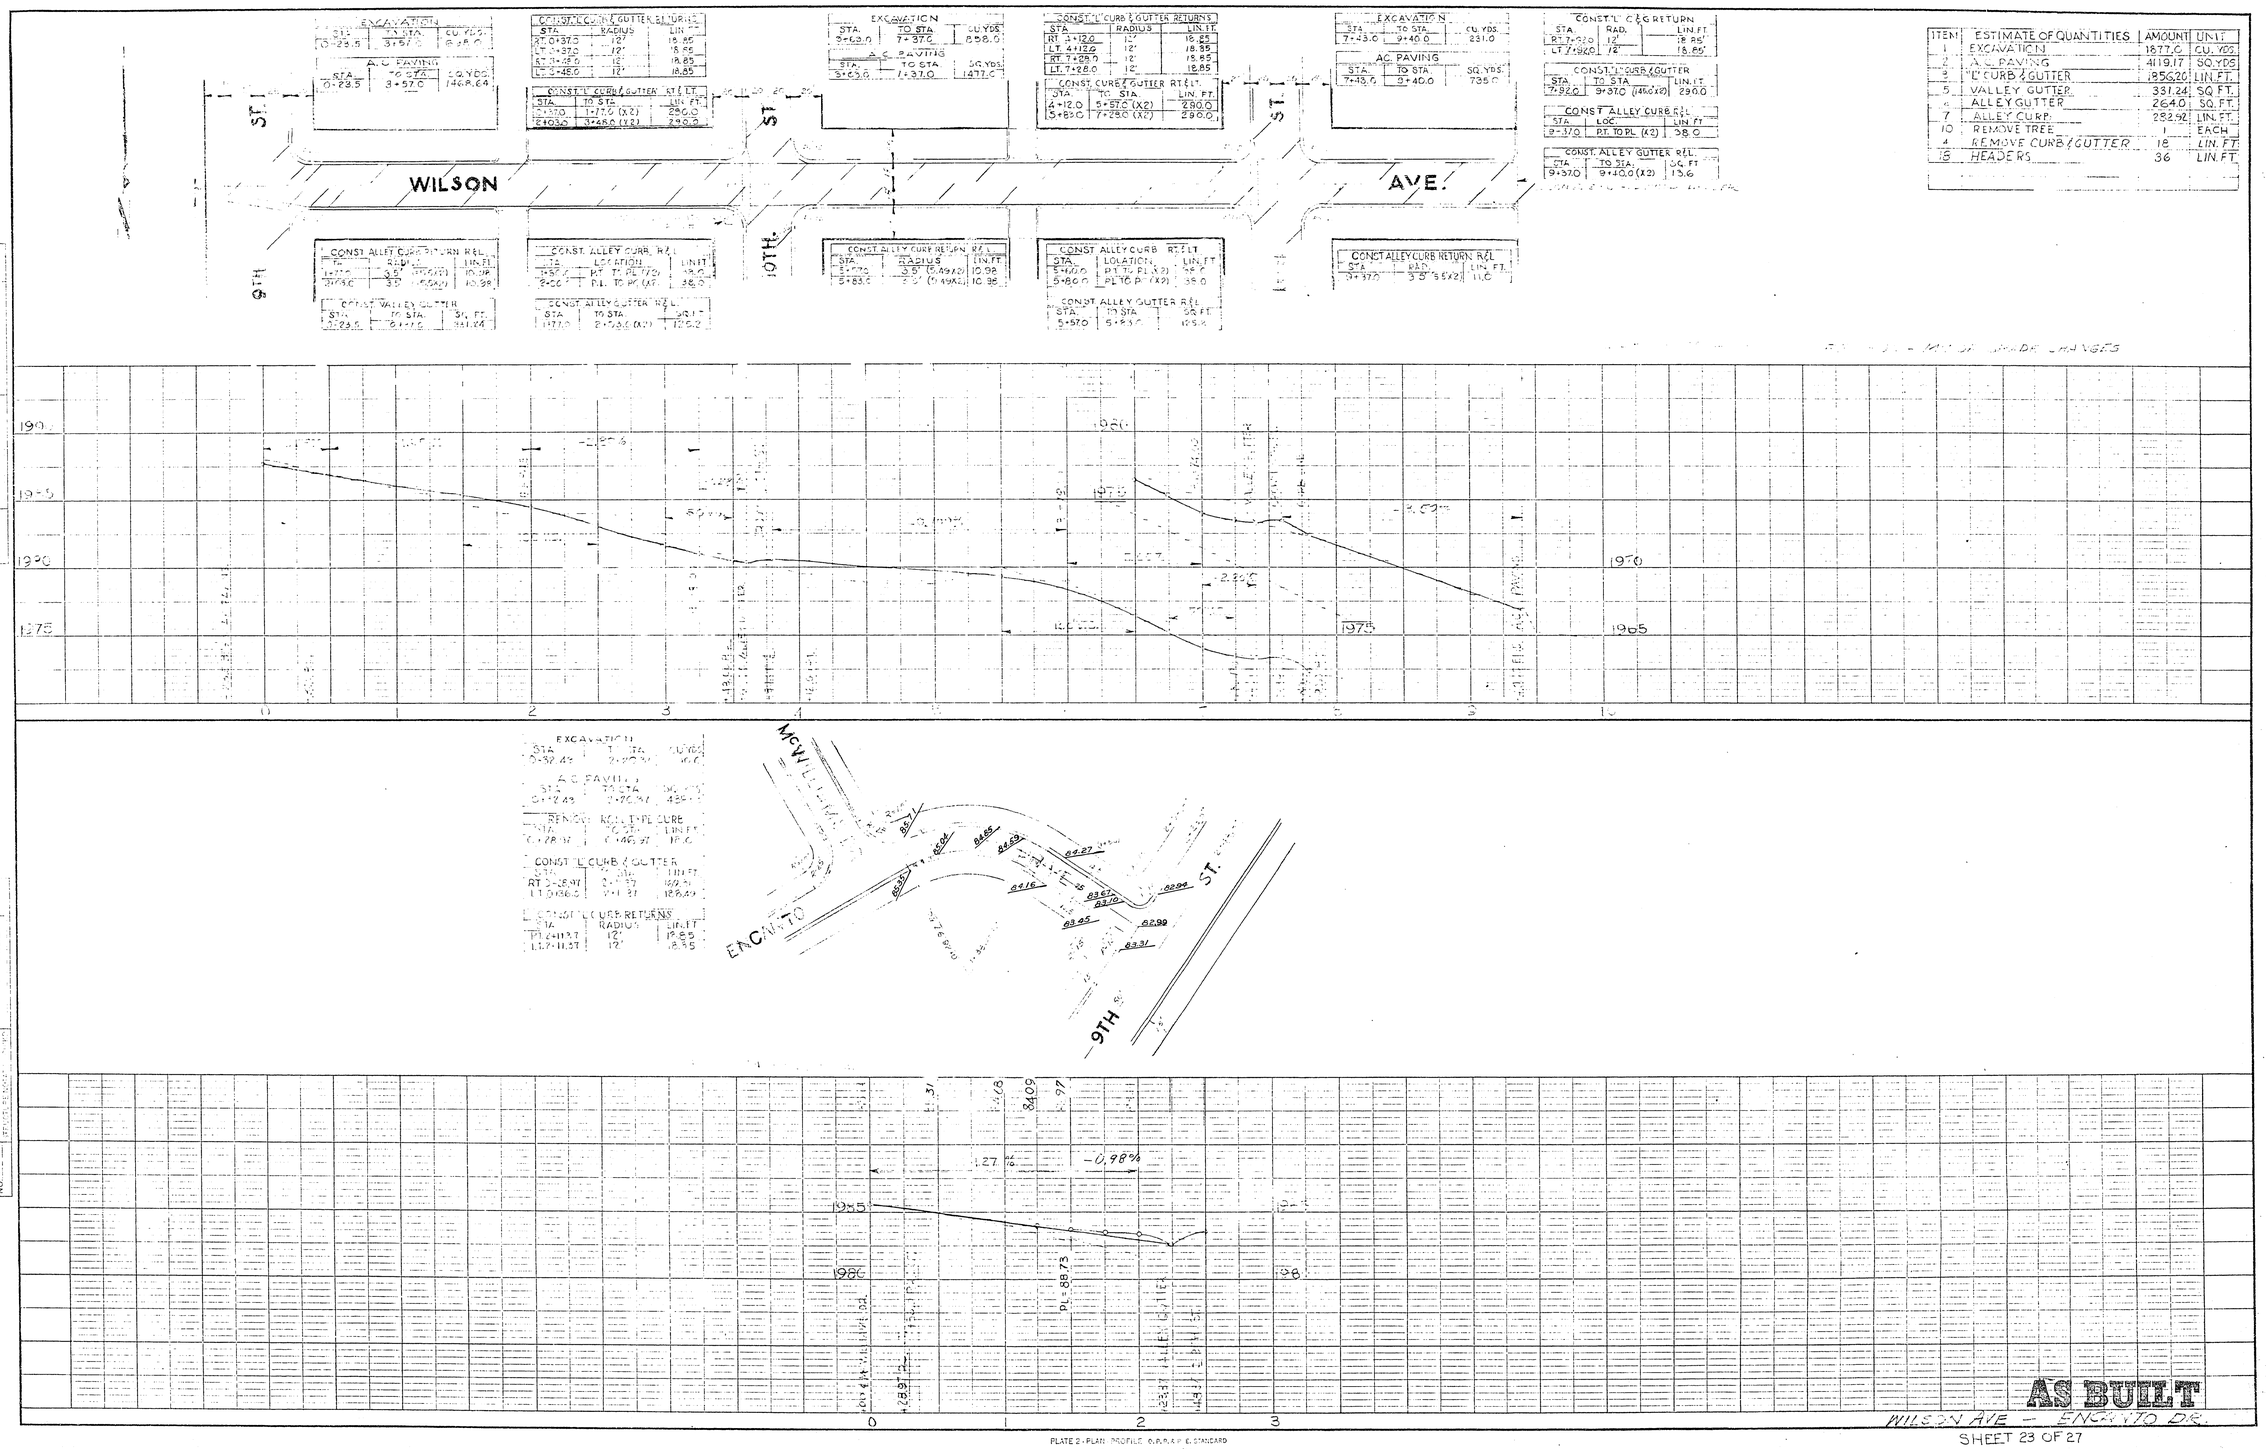

ITEM	ESTIMATE OF QUANTITIES	AMOUNT	UNIT
1	EXCAVATION	1877.0	CU. YDS.
2	A.C. PAVING	4119.17	SQ. YDS.
3	"L" CURB & GUTTER	1856.20	LIN. FT.
5	VALLEY GUTTER	331.24	SQ. FT.
6	ALLEY GUTTER	264.0	SQ. FT.
7	ALLEY CURB	282.92	LIN. FT.
10	REMOVE TREE	1	EACH
4	REMOVE CURB & GUTTER	18	LIN. FT.
15	HEADERS	36	LIN. FT.

PLATE 2 - PLAN PROFILE O.P.R.R.P.E. STANDARD
KEUFFEL & ESSER CO., NEW YORK.

K & E Co. No. 345-2

SHEET 23 OF 27

107-V5