


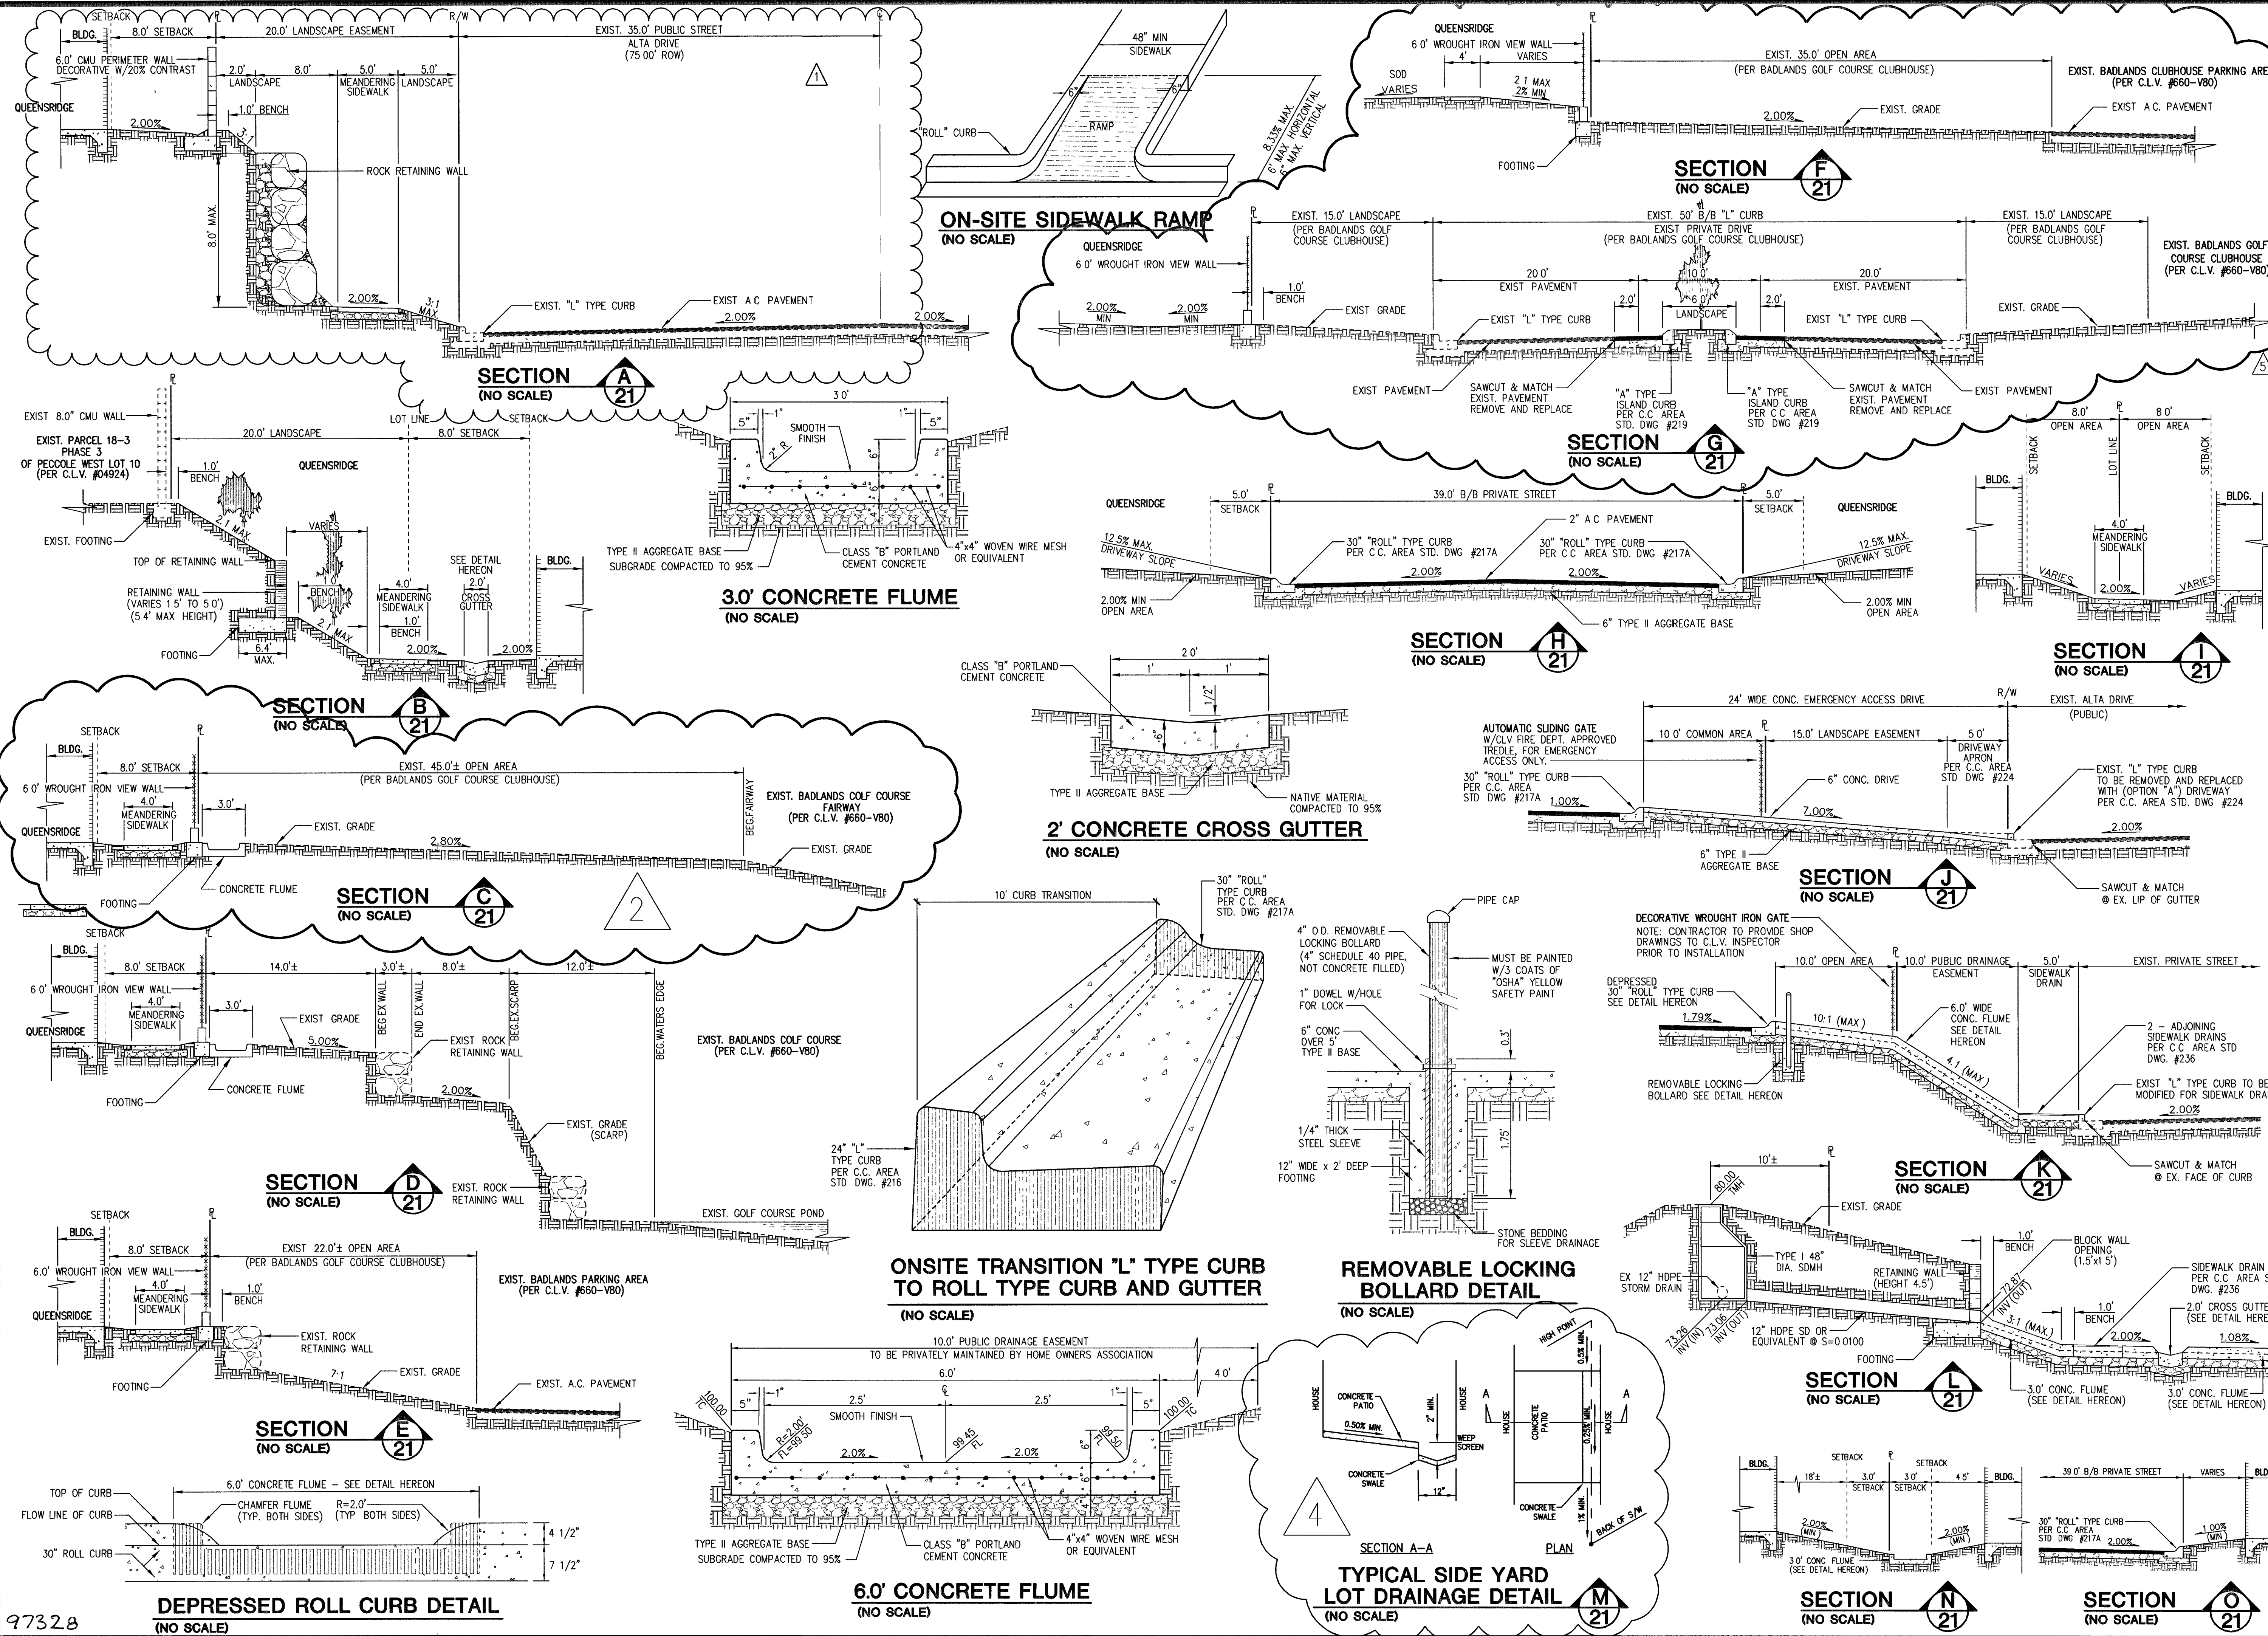

CRESTDALE ASSOCIATES, LTD				DETAIL/SECTION SHEET				WINDSOR AT QUEENSRIDGE			
1063 LAS PALMAS ENTRADA AVE. HENDERSON, NEVADA 89012				SHEET				TITLE			
DESIGNING FOR THE FUTURE PLANNERS • CONSULTING ENGINEERS • SURVEYORS 1009 WINNET PARK DRIVE • HENDERSON, NEVADA 89014 • (702) 248-5445				DRAWN BY: BLOOM 02/03				SCALE: 1"=30'			
REVISION				DESIGNED BY: BLOOM 02/03				PROJECT NO. 066-0060			
REV. DATE BY				CHECKED BY: TRUDDI 02/03				SHEET			
1 09/03 TL REVISE CROSS-SECTION "A" TO ADD ROCKERY WALL				EXP. 06-30-08				DS1			
2 10/04 AL REVISE DETAIL "C" AND "M"				1074763				21 OF 30 SHEETS			
3 12/04 AL REVISE DETAIL "M"				DRAWING NO				1016-06			
4 01/28 AL REVISE DETAIL "M"				1016-06				1016-06			
5 6/06 DB REVISE SECTIONS "C" AND "F"				1016-06				1016-06			

97328

Keelot