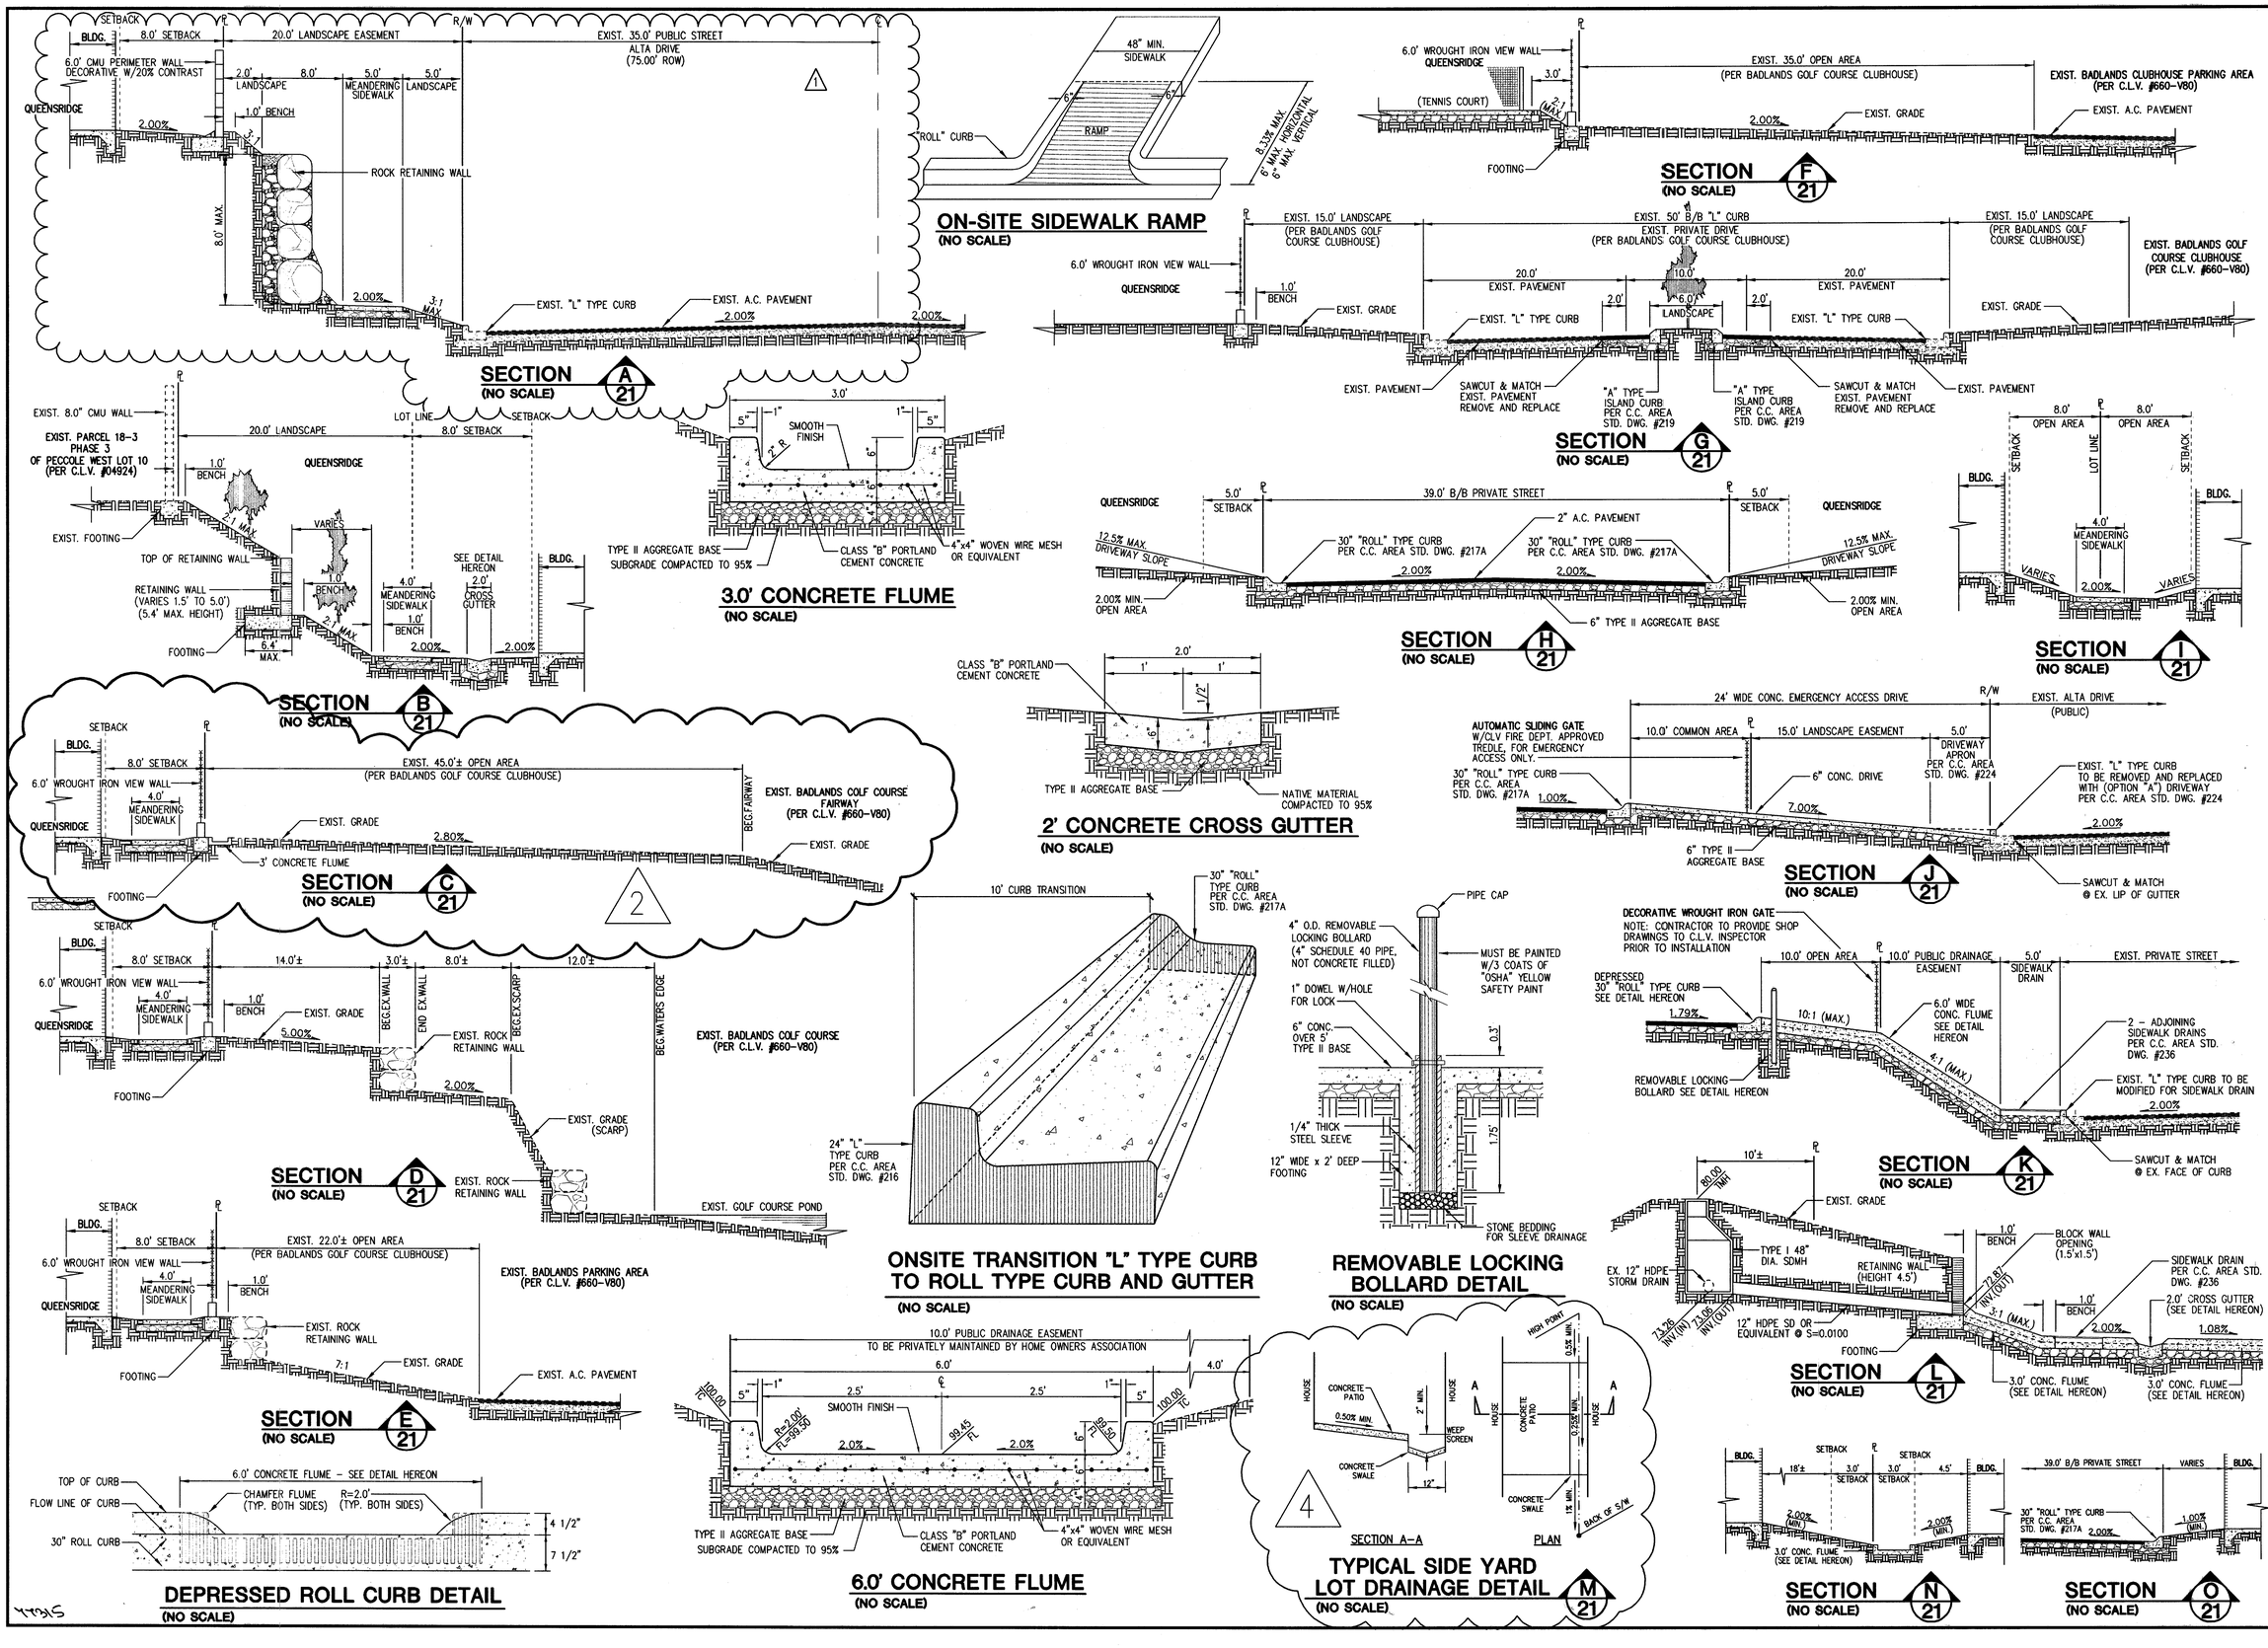

REV	DATE	BY	REVISION
1	09/03	TL	REVISE CROSS-SECTION "A" TO ADD ROCKERY WALL
2	10/04	JLO	REVISE DETAIL "C" AND "M"
3	12/04	JLO	REVISE DETAIL "M"
4	01/28	JLO	REVISE DETAIL "M"

CRESTDALE ASSOCIATES, LTD
1063 LAS PALMAS ENTRADA AVE.
HENDERSON, NEVADA 89012

VPOINT
DESIGNING FOR THE FUTURE
PLANNERS · CONSULTING ENGINEERS · SURVEYORS
1009 WHITNEY RANCH DRIVE · HENDERSON, NEVADA 89014 · (702) 248-8415

SHEET: DETAIL/SECTION SHEET

TITLE: WINDSOR AT QUEENSRIDGE

DRAWN BY: BLOOM	02/03	
DESIGNED BY: BLOOM	02/03	
CHECKED BY: TRUDI	02/03	
PROJECT NO: 066-E060	SCALE: 1"=30'	

REGISTERED PROFESSIONAL ENGINEER · STATE OF NEVADA
PETER J. LAAS
Exp:12/31/05
CIVIL
No. 14444
2/14/05

SHEET **DS1**
21 OF 30 SHEETS

DRAWING NO. 10744763

Replot