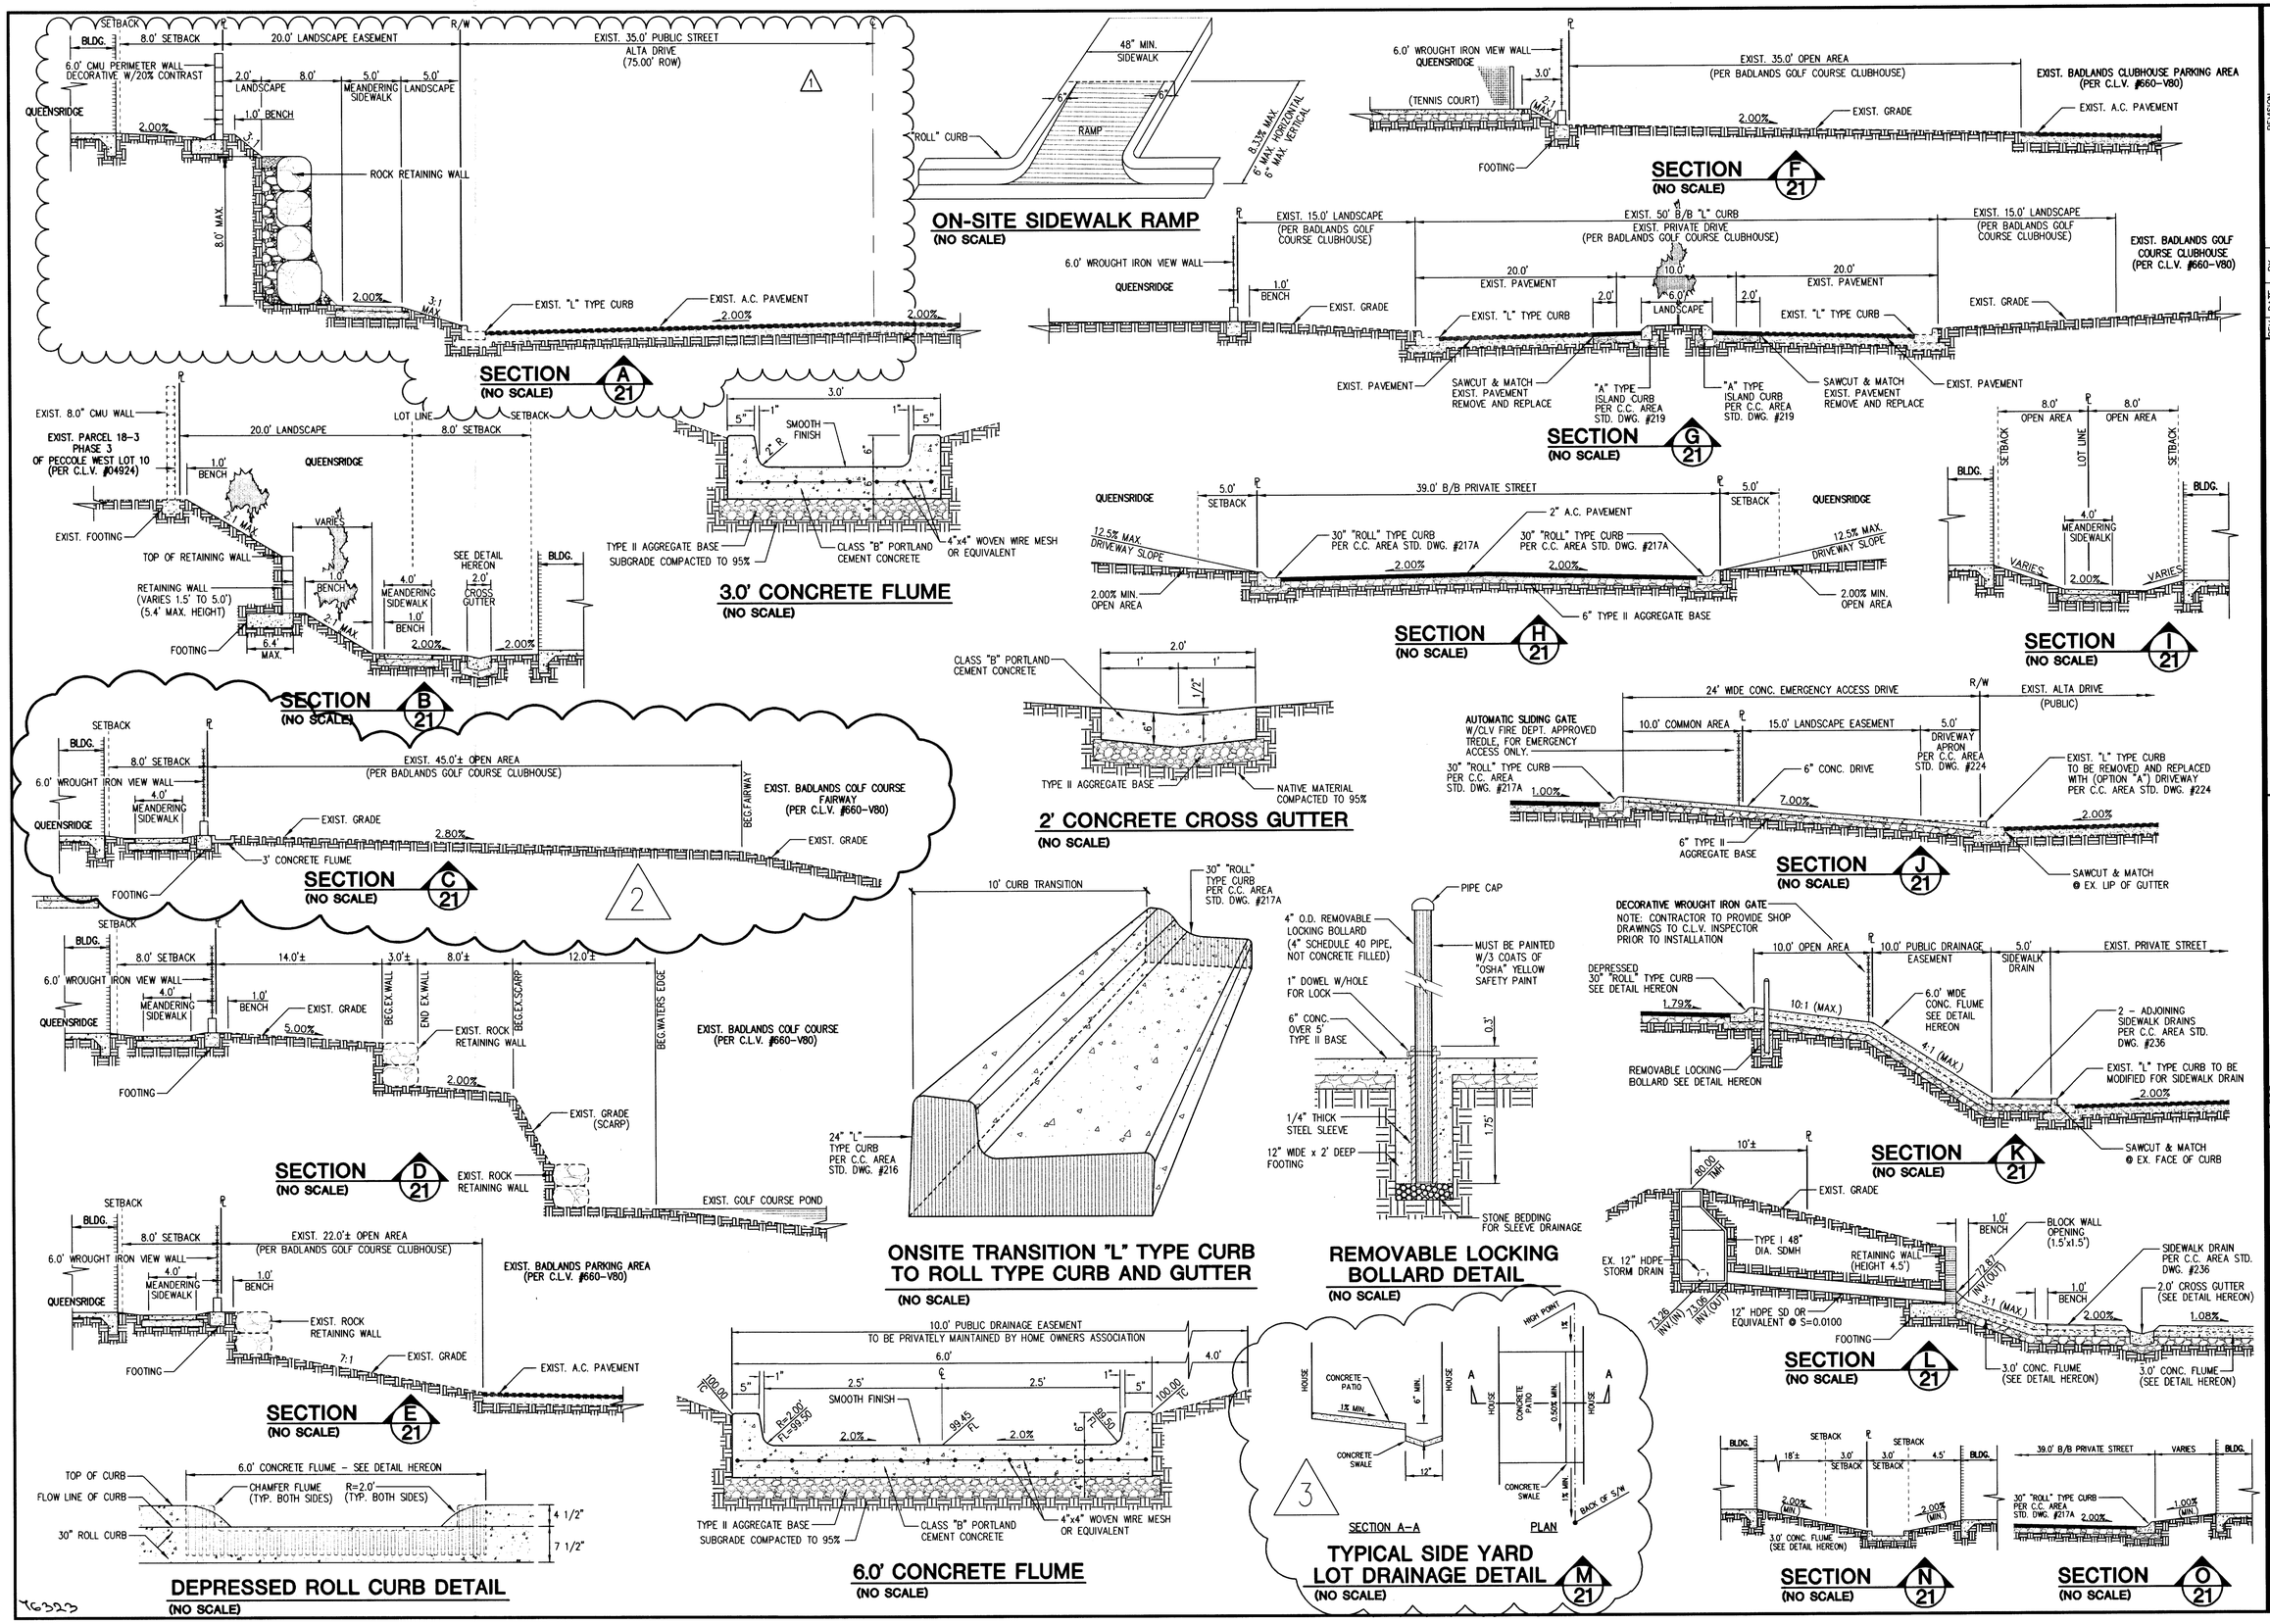

REV	DATE	BY	REVISION
1	09/03	TL	REVISE CROSS-SECTION "A" TO ADD ROCKERY WALL
2	10/04	JLO	REVISE DETAIL "C" AND "N"
3	12/04	JLO	REVISE DETAIL "M"

CRESTDALE ASSOCIATES, LTD
1063 LAS PALMAS ENTRADA AVE.
HENDERSON, NEVADA 89012

VPOINT DESIGNING FOR THE FUTURE
PLANNERS · CONSULTING ENGINEERS · SURVEYORS
1009 WHITNEY RANCH DRIVE · HENDERSON, NEVADA 89014 · (702) 248-6415

SHEET: DETAIL/SECTION SHEET

TITLE: WINDSOR AT QUEENSRIDGE

DRAWN BY: BLOOM 02/03
DESIGNED BY: BLOOM 02/03
CHECKED BY: TRUDI 02/03
PROJECT NO: 066-E060
SCALE: 1"=30'

PROFESSIONAL ENGINEER - STATE OF NEVADA
PETER J. LAAS
Exp:12/31/05
CIVIL
No. 14444
12/30/04

SHEET DS1
21 OF 30 SHEETS
DRAWING NO. 10TY 4763

Y6323