


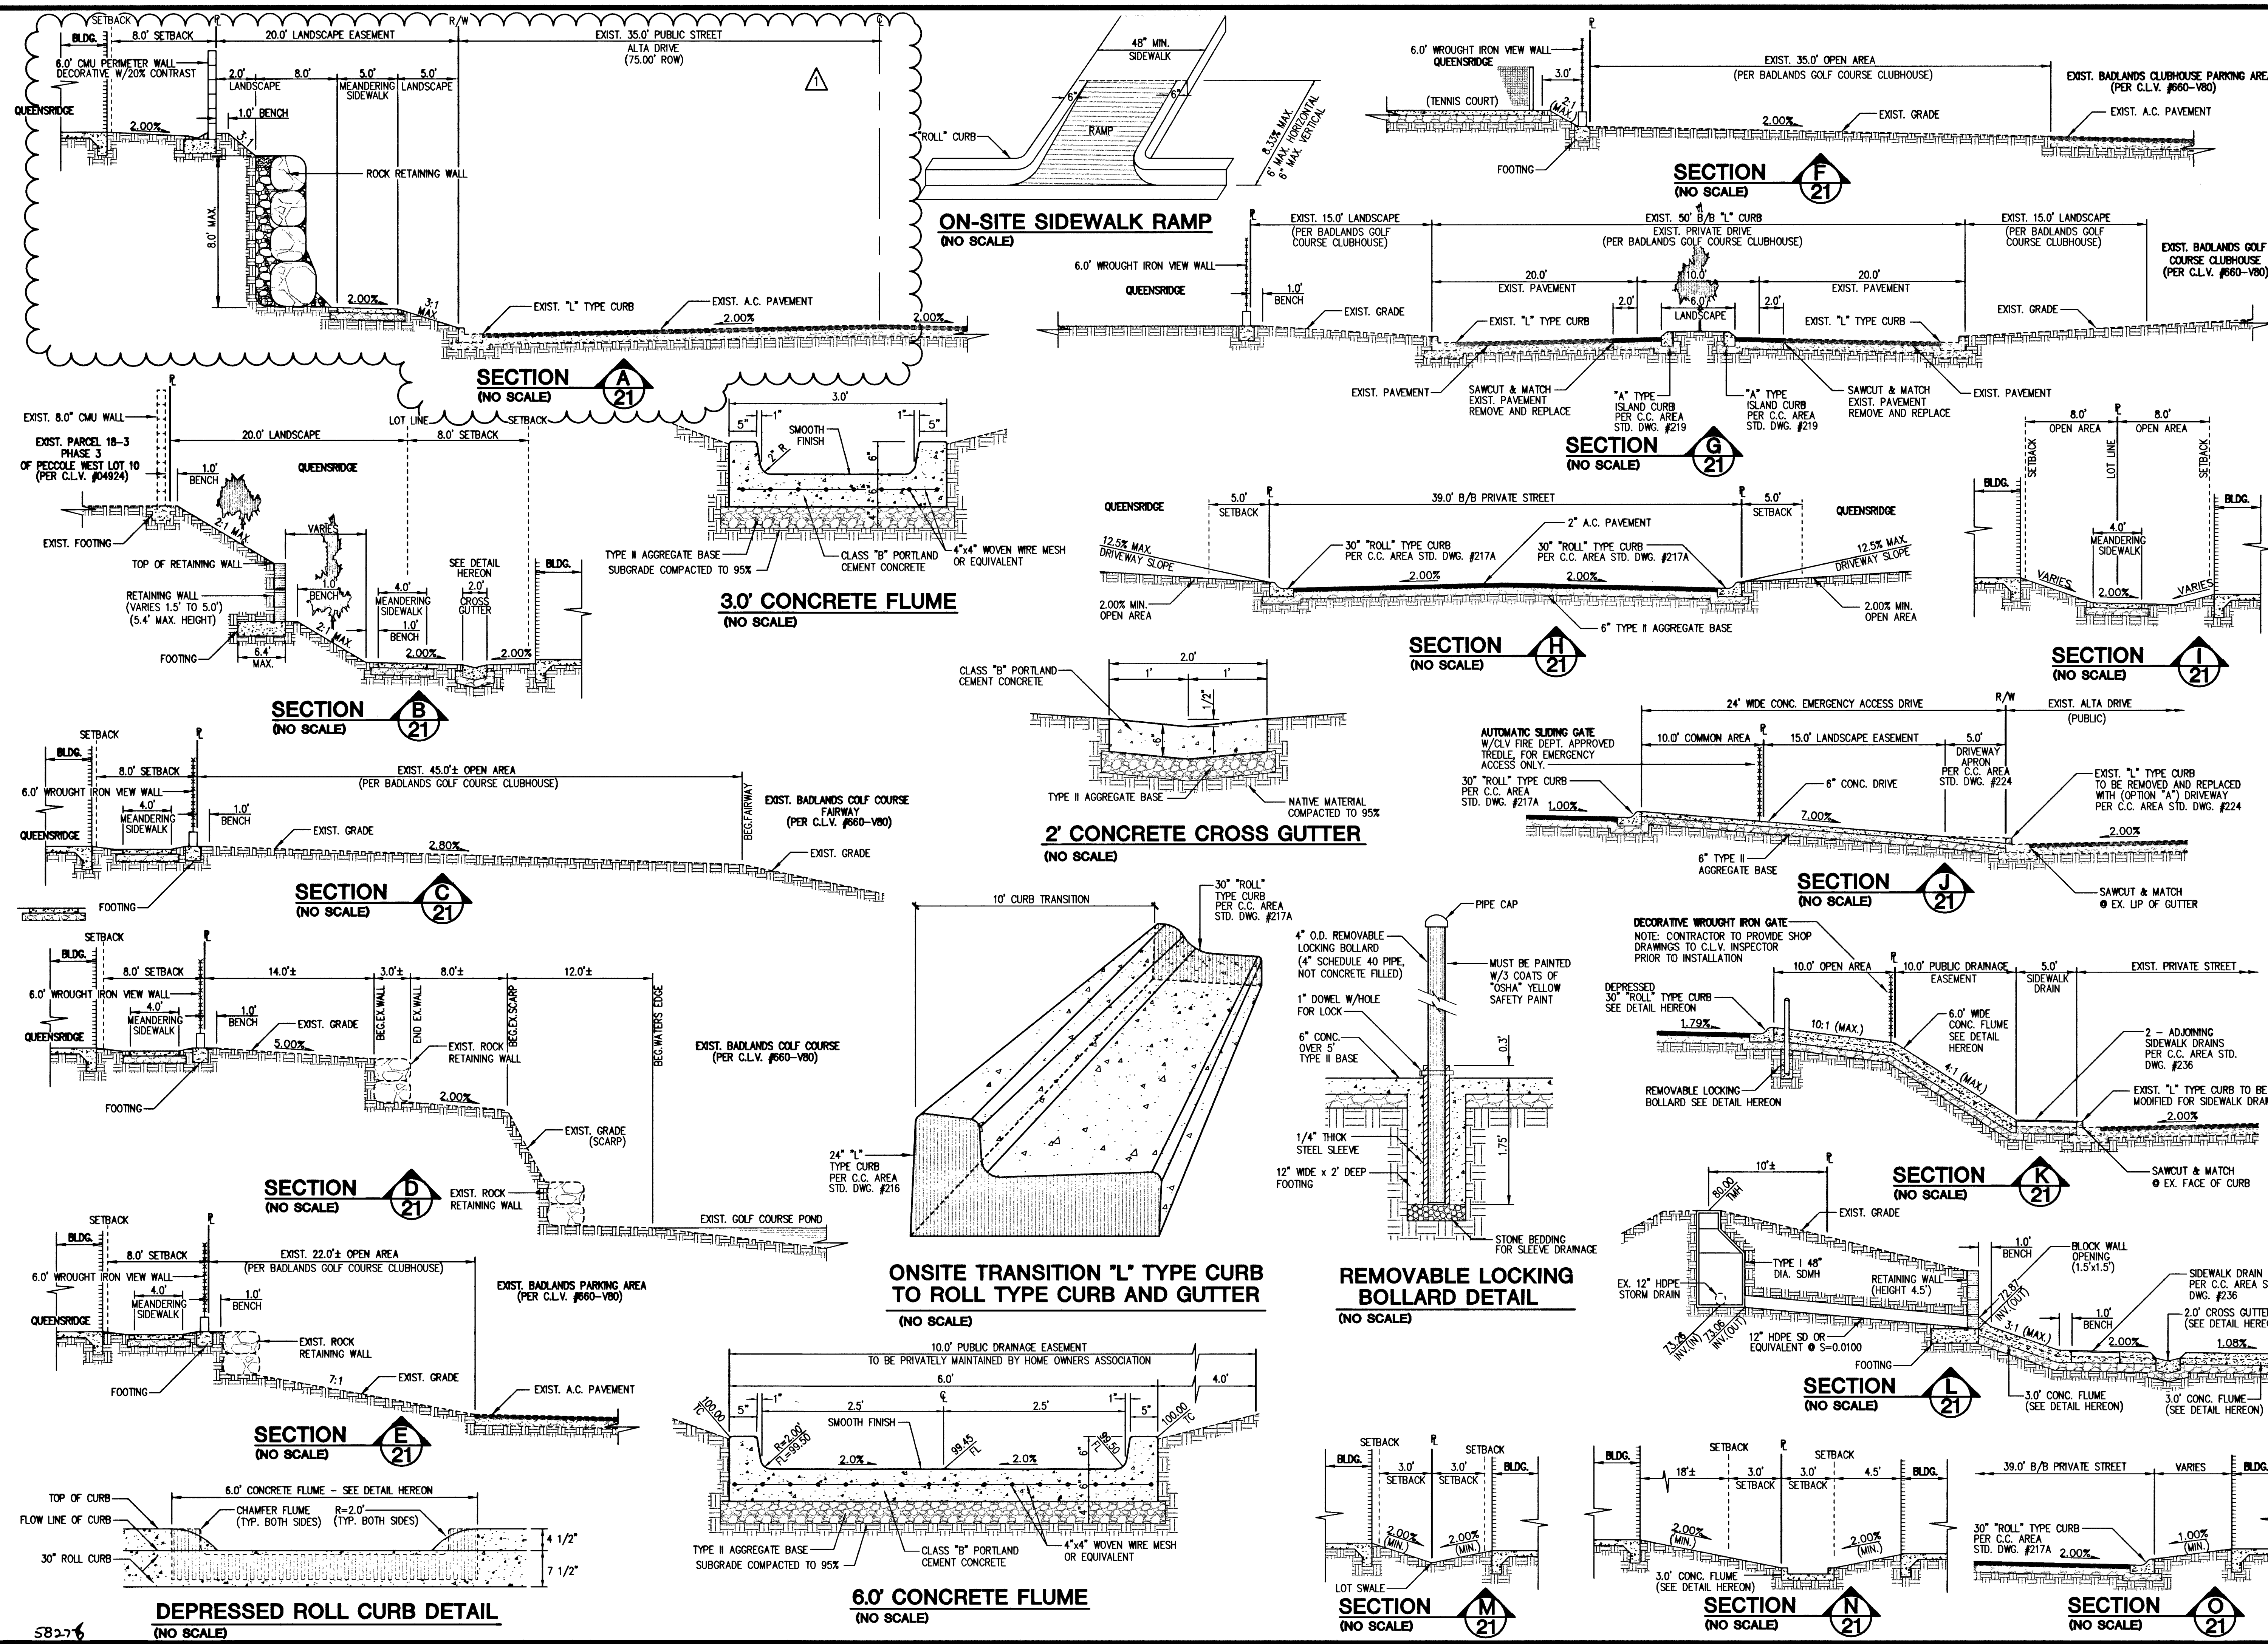

CRESTDALE ASSOCIATES, LTD		1063 LAS PALMAS ENTRADA AVE. HENDERSON, NEVADA 89012	
DESIGNING FOR THE FUTURE		PROJECT NO. 12508 WINDOR	
DRAWN BY: BLOOM		DESIGNED BY: BLOOM	
CHECKED BY: TROTT		PROJECT NO. 12508 WINDOR	
DATE: 02/03		SCALE: 1"=30'	
SHEET		DETAIL/SECTION SHEET	
TITLE		WINDSOR AT QUEENSRIDGE	
REVISION		REV. DATE BY	
1 08/03 TL		REVISE CROSS-SECTION "A" TO ADD ROCKY HILL	

PROFESSIONAL ENGINEER

Exp. 12/03

CIVIL

No. 12508 WINDOR

SHEET

DS1

21 OF 30 SHEETS

DRAWING NO.

1074763

Repld