

980212

00828

ANNEXATION MAP AMENDED RECORD OF SURVEY


LEGEND

- FOUND MONUMENTATION AS SHOWN AND DESCRIBED
- FOUND NEVADA DEPARTMENT OF TRANSPORTATION BRASS CAP IN WELL
- ▲ SET 5/8" REBAR AND ALCAP STAMPED PLS 11174
- BLM BUREAU OF LAND MANAGEMENT
- 137-33-125-001 ASSESSORS PARCEL NUMBER
- (R) RADIAL BEARING OR LINE
- LIMITS OF ANNEXATION TO CITY OF LAS VEGAS
- - - EXISTING CITY OF LAS VEGAS LIMITS
- - - MATCH LINE
- SECTION LINE
- SECTION NUMBER

REFERENCE MAPS:

- 1) BLM DEPENDENT RESURVEY - 1987
- 2) RECORD OF SURVEY FILE 68, PAGE 20
- 3) RECORD OF SURVEY FILE 80, PAGE 75
- 4) RECORD OF SURVEY FILE 87, PAGE 73
- 5) RECORD OF SURVEY FILE 88, PAGE 08
- 6) PARCEL MAP FILE 84, PAGE 70
- 7) PARCEL MAP FILE 84, PAGE 71

SCALE: 1" = 1000'

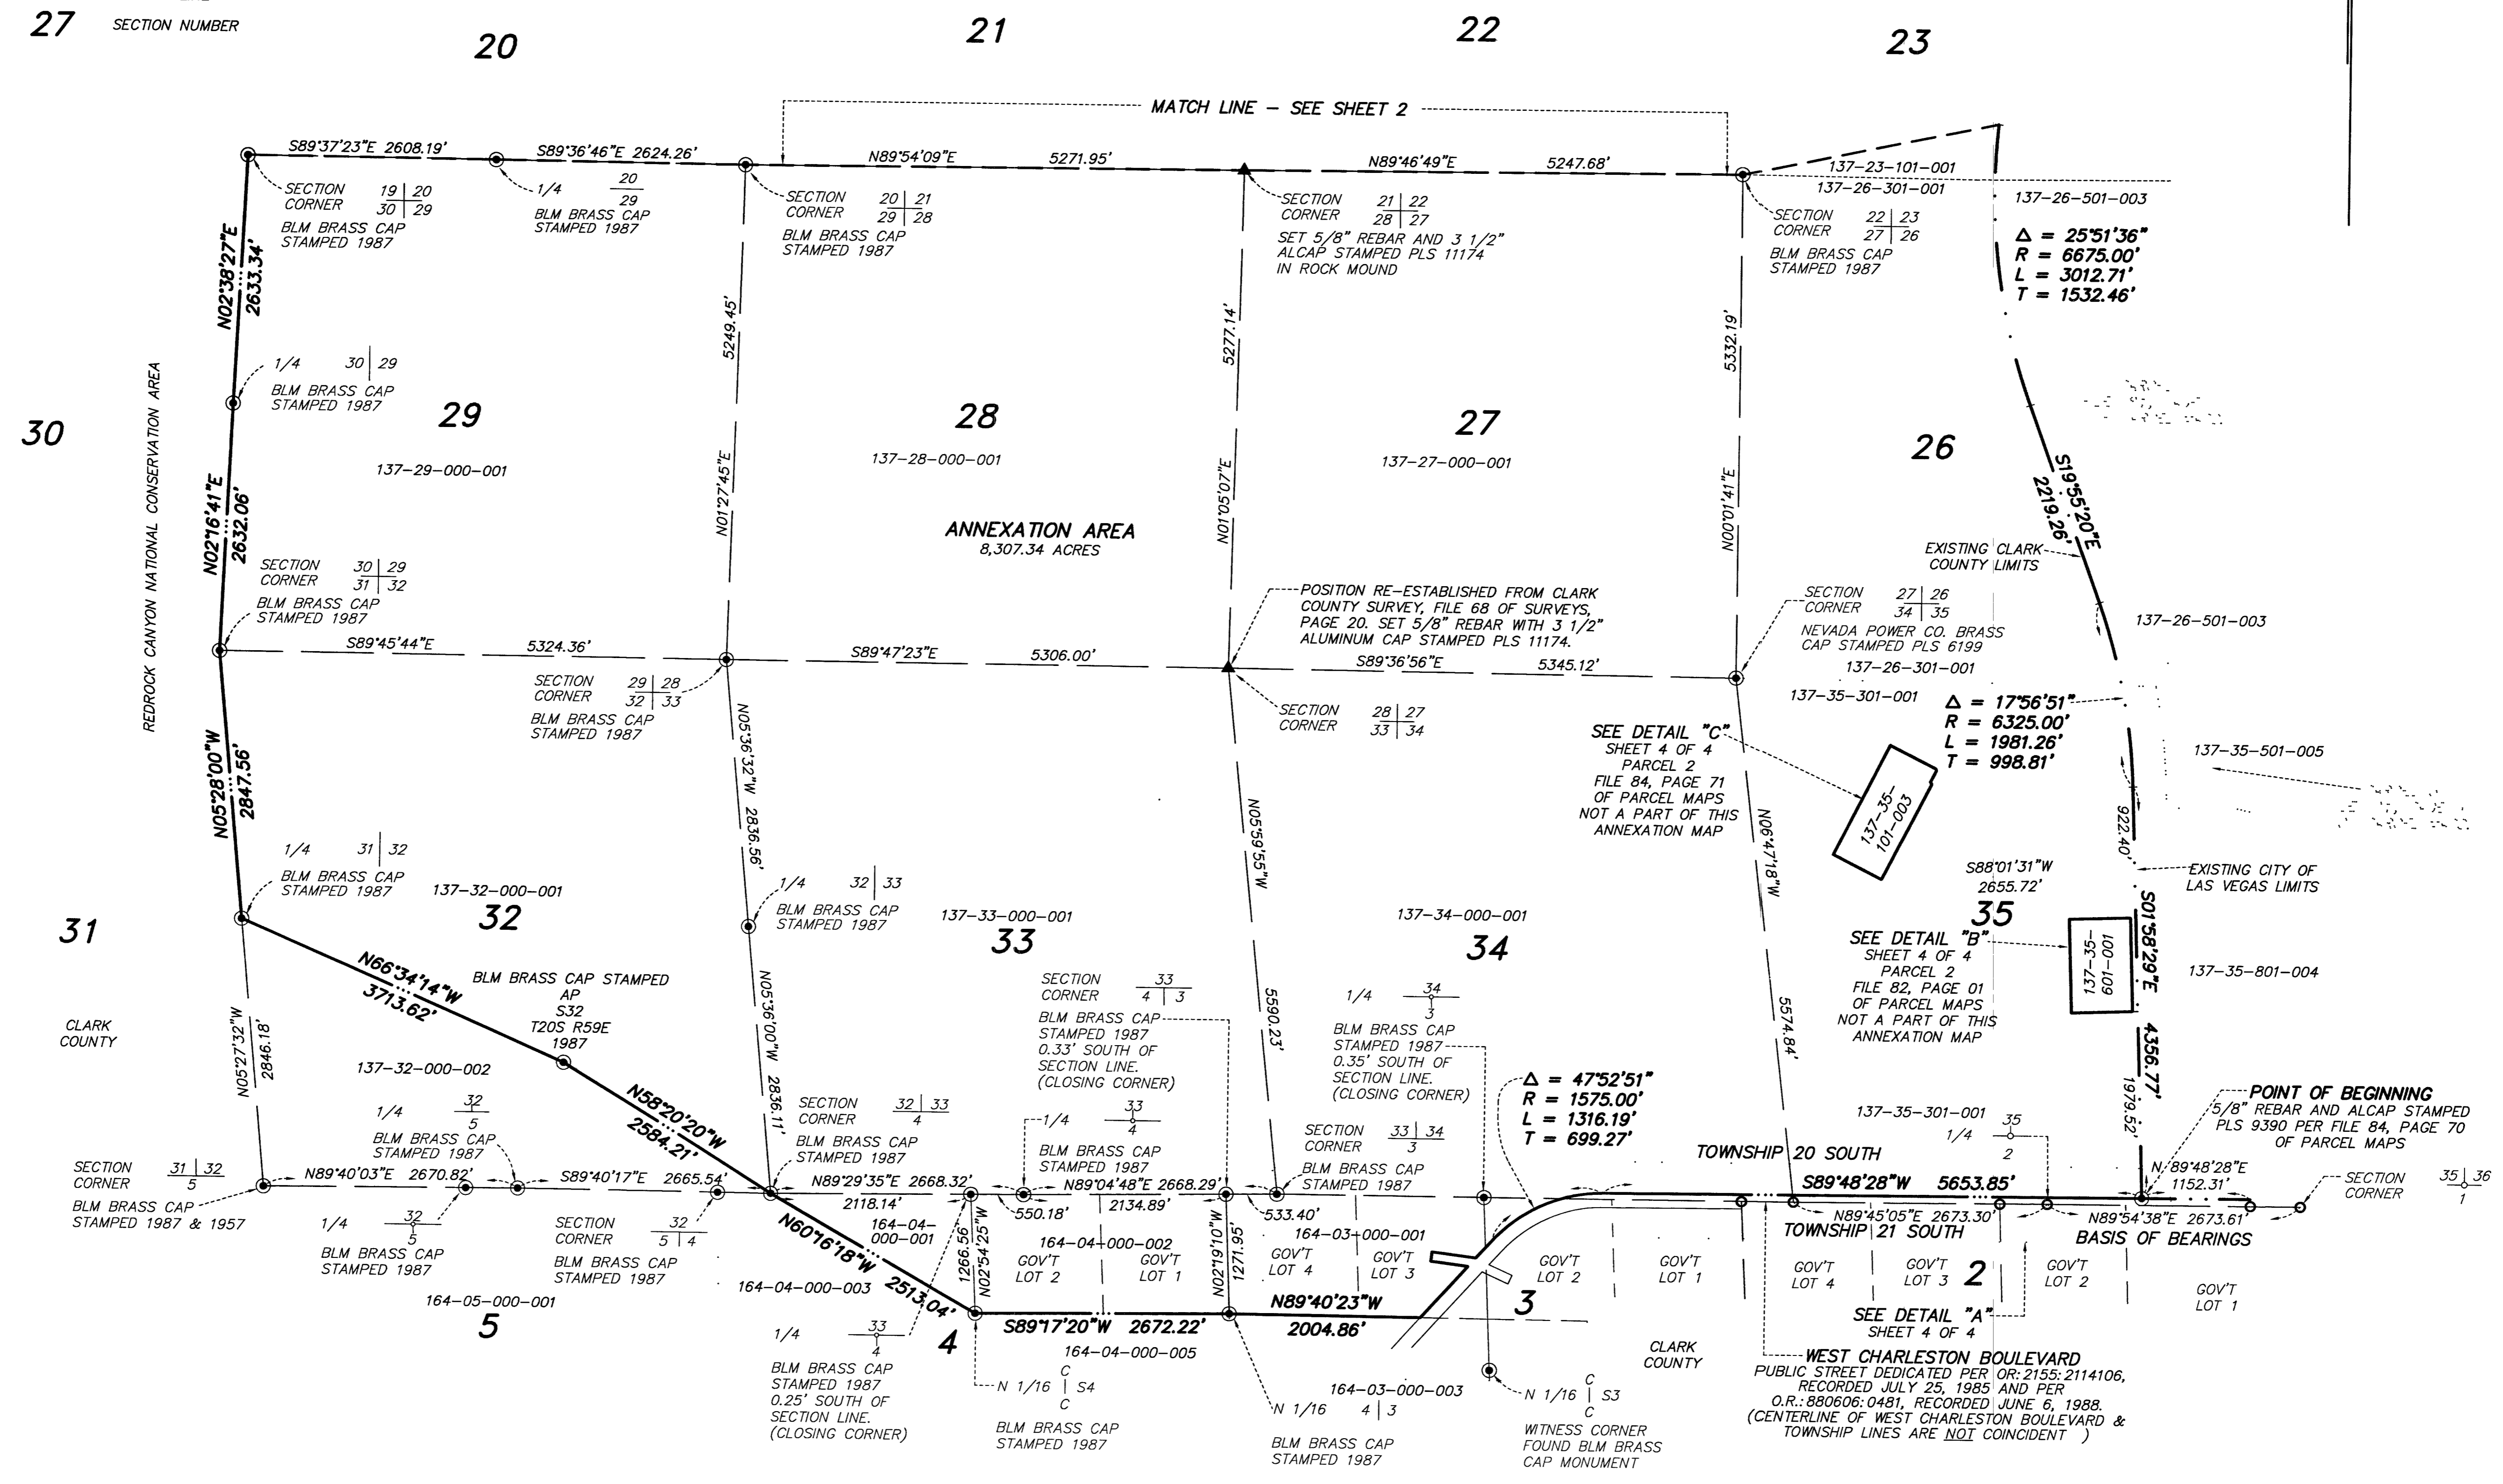

82458
62052.4101

053-425-1