


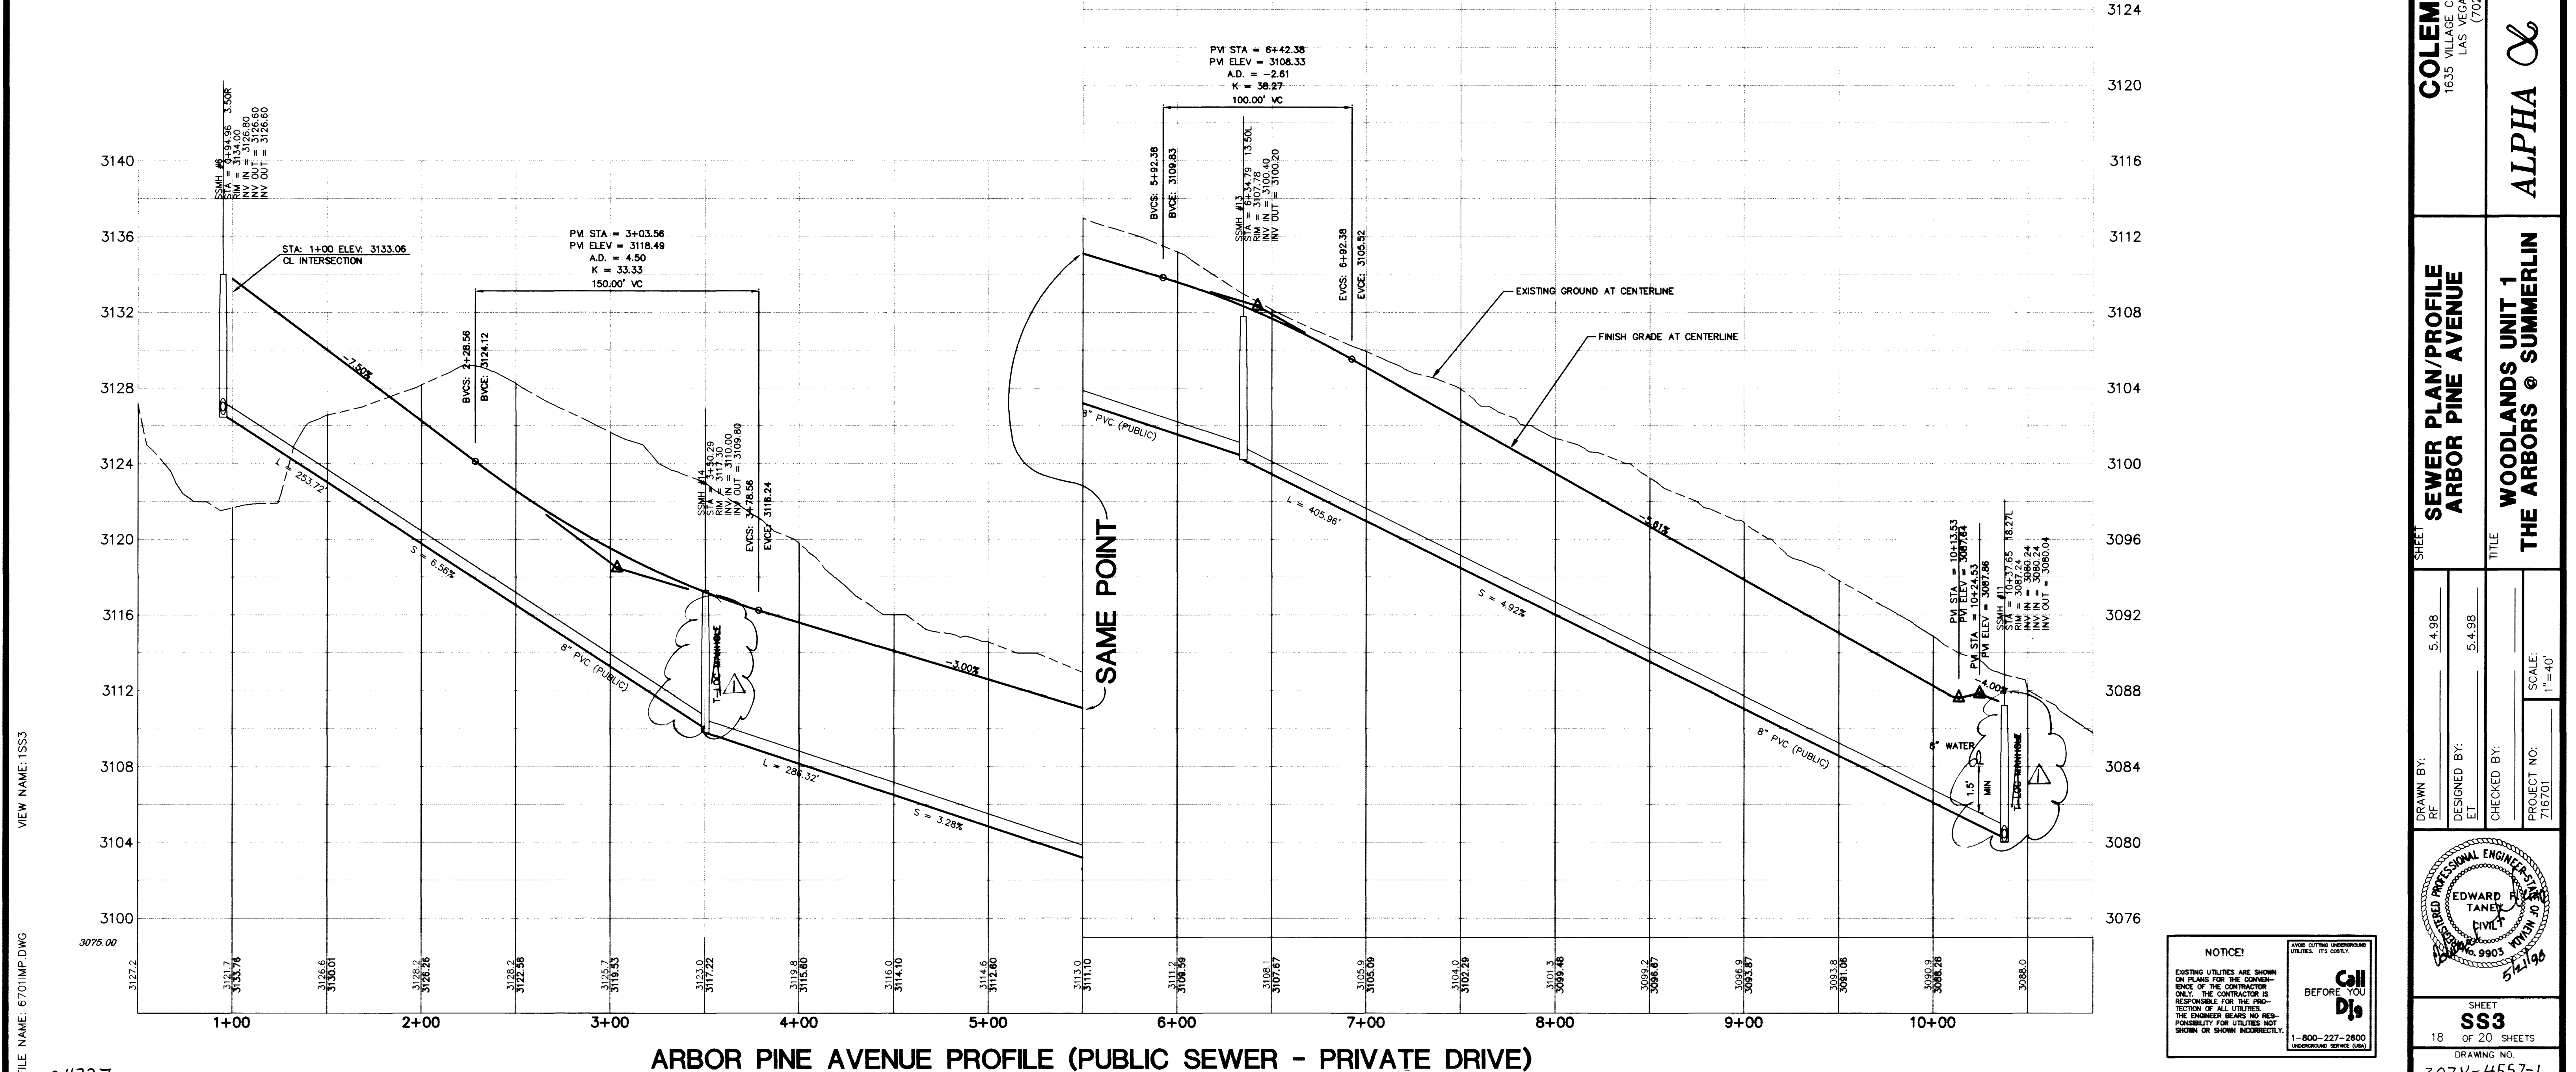

FILE NAME: 6701IMP.DWG

FILE 24727

8621 

BENCHMARK
CITY OF LAS VEGAS BENCHMARK
CLV0001954 RIVET & PLATE IN TOP OF CURB NW SIDE OF
TOWN CENTER DRIVE & SOUTH CIRCLE ISLAND.
2725.923 NGVD 1929 DATUM
2738.37 NAVD 1988 DATUM (831.6074 M)
2726.19 SUMMERLIN DATUM (USED IN THIS PROJECT)

BASIS OF BEARING
NORTH 15°23'46" EAST, BEING THE BEARING OF THE
CENTERLINE OF ANASAZI DRIVE AS SHOWN BY MAP
THEREOF ON FILE IN BOOK 64, PAGE 67 OF PLATS,
IN THE CLARK COUNTY RECORDER'S OFFICE, CLARK
COUNTY, NEVADA.

N
SCALE: 1" = 4' VERT.
SCALE: 1" = 40' HORIZ.

GRAPHIC SCALE



(IN FEET)
1 inch = 40 ft.

COLEMAN HOMES
1635 VILLAGE CENTER CIRCLE SUITE 100
LAS VEGAS, NEVADA 89134
(702) 243-9800

ALPHA & ENGINEERING COMPANY
50 So. Jones #202, Las Vegas, NV, 89107
Telephone: (702) 877-1300

SEWER PLAN/PROFILE
ARBOR PINE AVENUE

WOODLANDS UNIT 1
THE ARBORS @ SUMMERLIN

DRAWN BY: RF	5.4.98
DESIGNED BY: ET	5.4.98
CHECKED BY:	
PROJECT NO: 716/701	SCALE: 1"=40'

SHEET
SS3
18 OF 20 SHEETS
DRAWING NO.
307Y-4557-1

NOTICE!

EXISTING UTILITIES ARE SHOWN ON PLANS FOR THE CONVENIENCE OF THE CONTRACTOR ONLY. THE CONTRACTOR IS RESPONSIBLE FOR THE PROTECTION OF ALL UTILITIES. THE ENGINEER BEARS NO RESPONSIBILITY FOR UTILITIES NOT SHOWN OR SHOWN INCORRECTLY.

AVOID CUTTING UNDERGROUND UTILITIES. IT'S COSTLY.

Call BEFORE YOU Dig

1-800-227-2600
UNDERGROUND SERVICE (USA)