

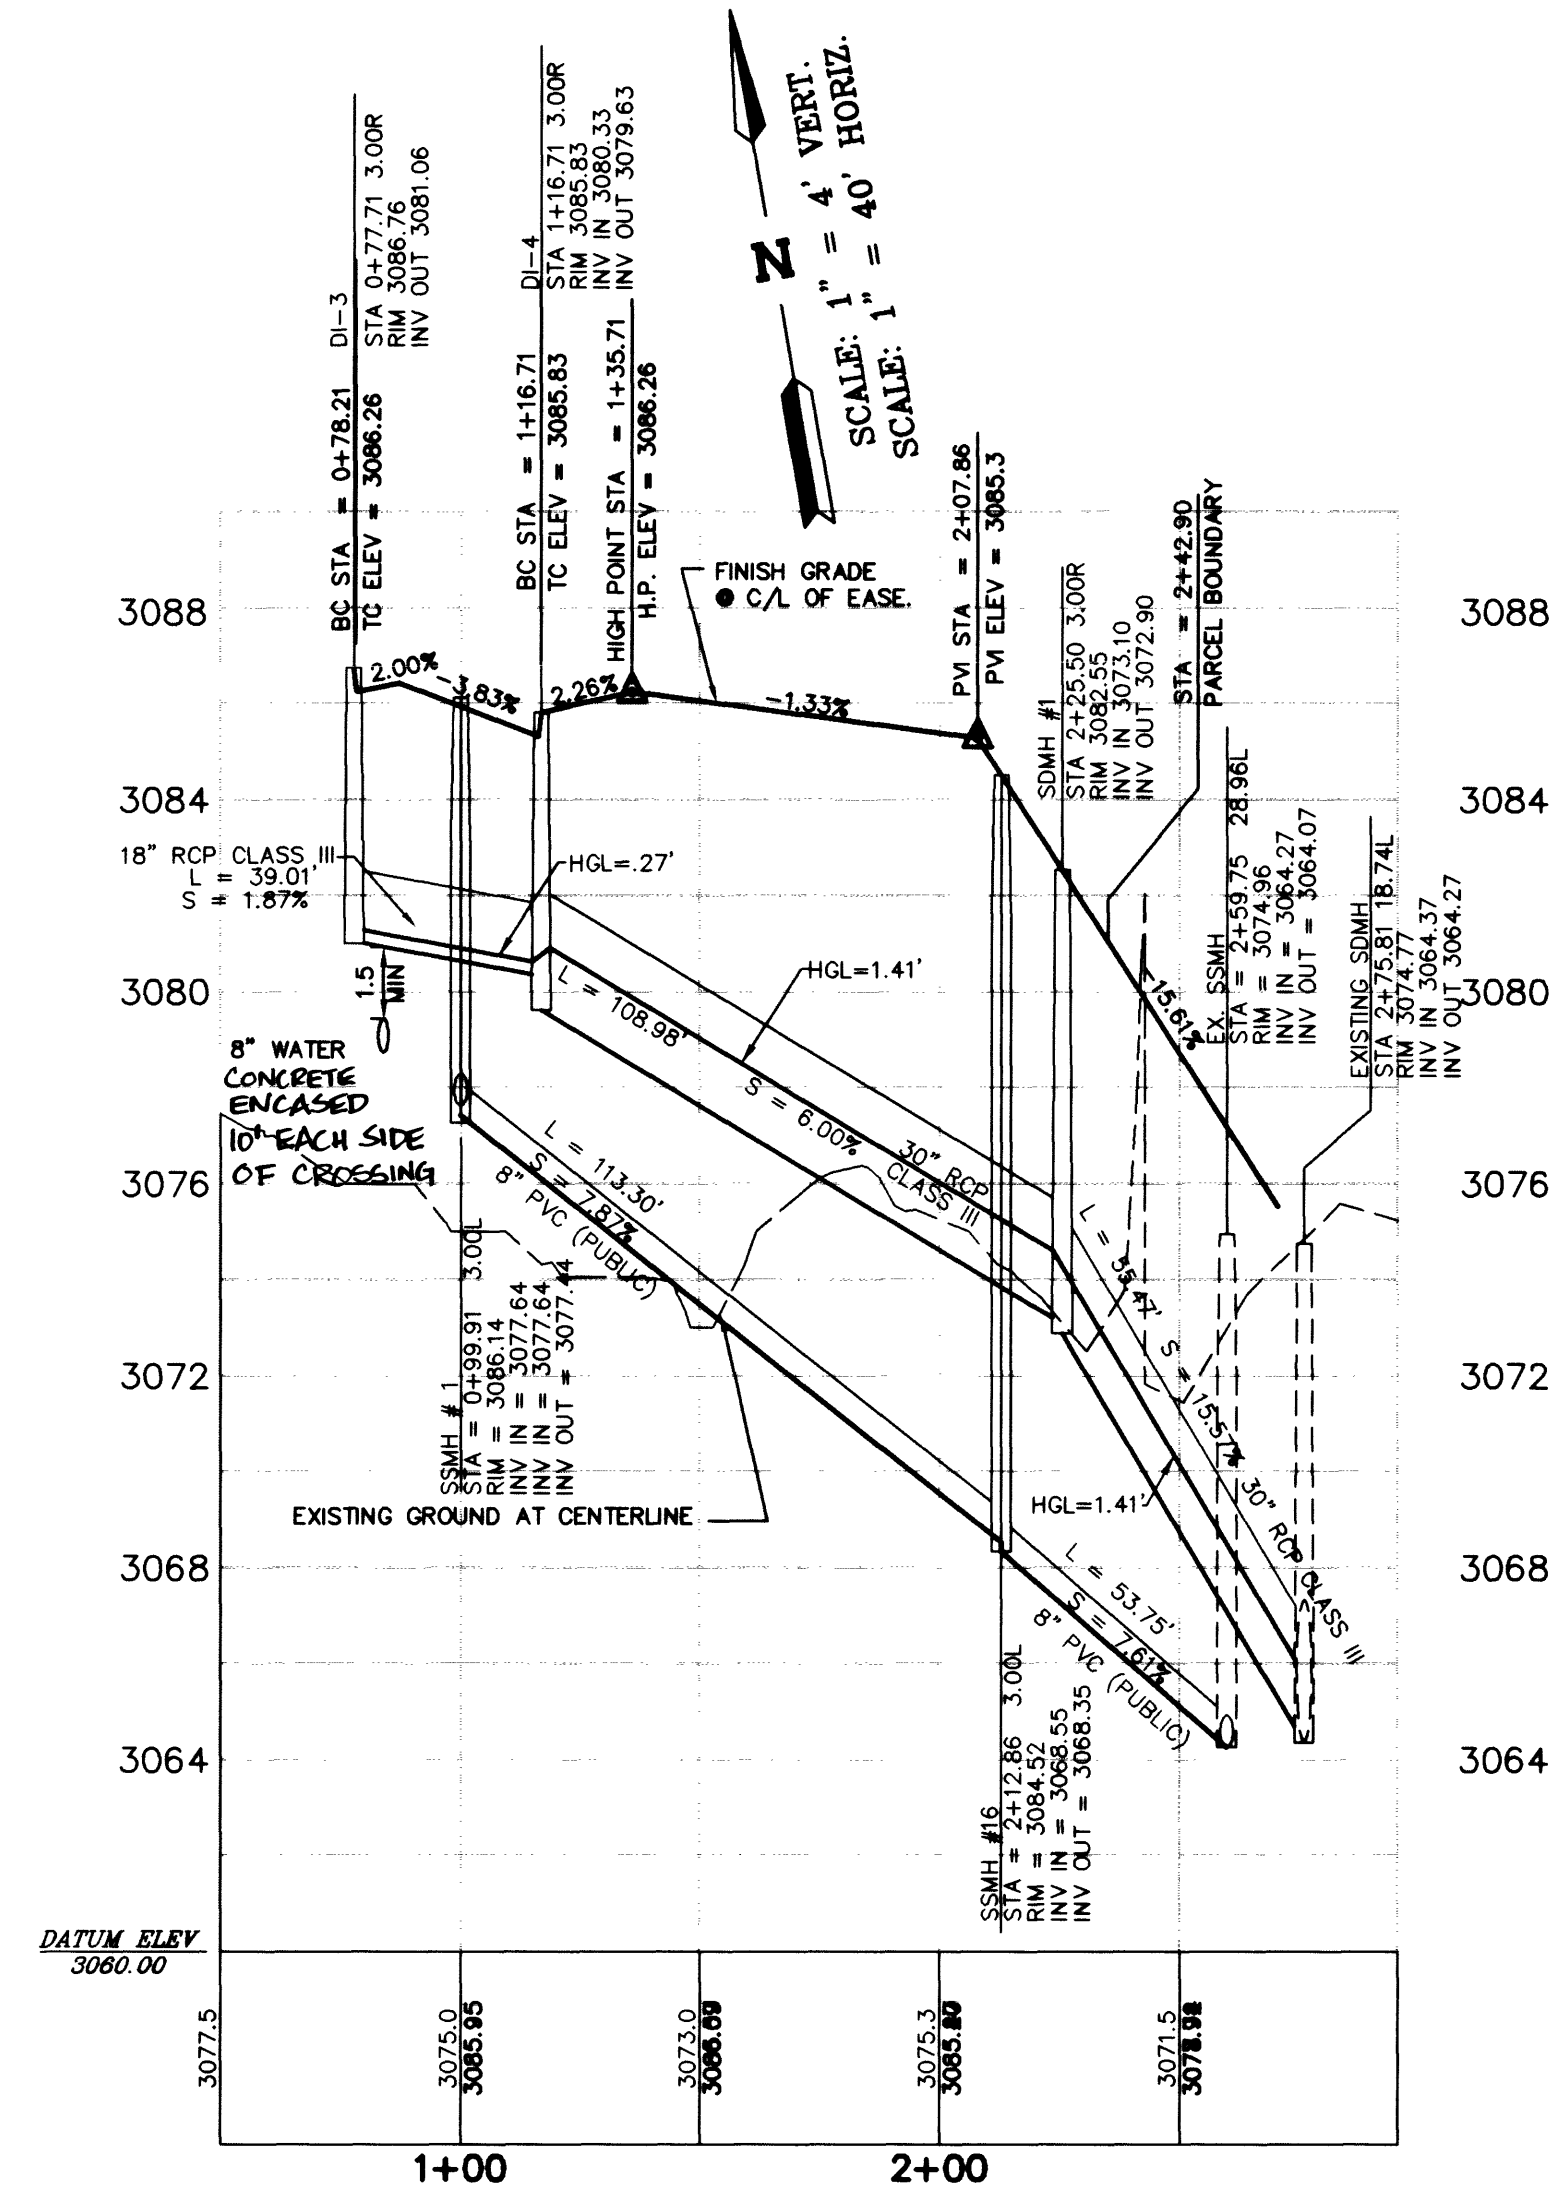
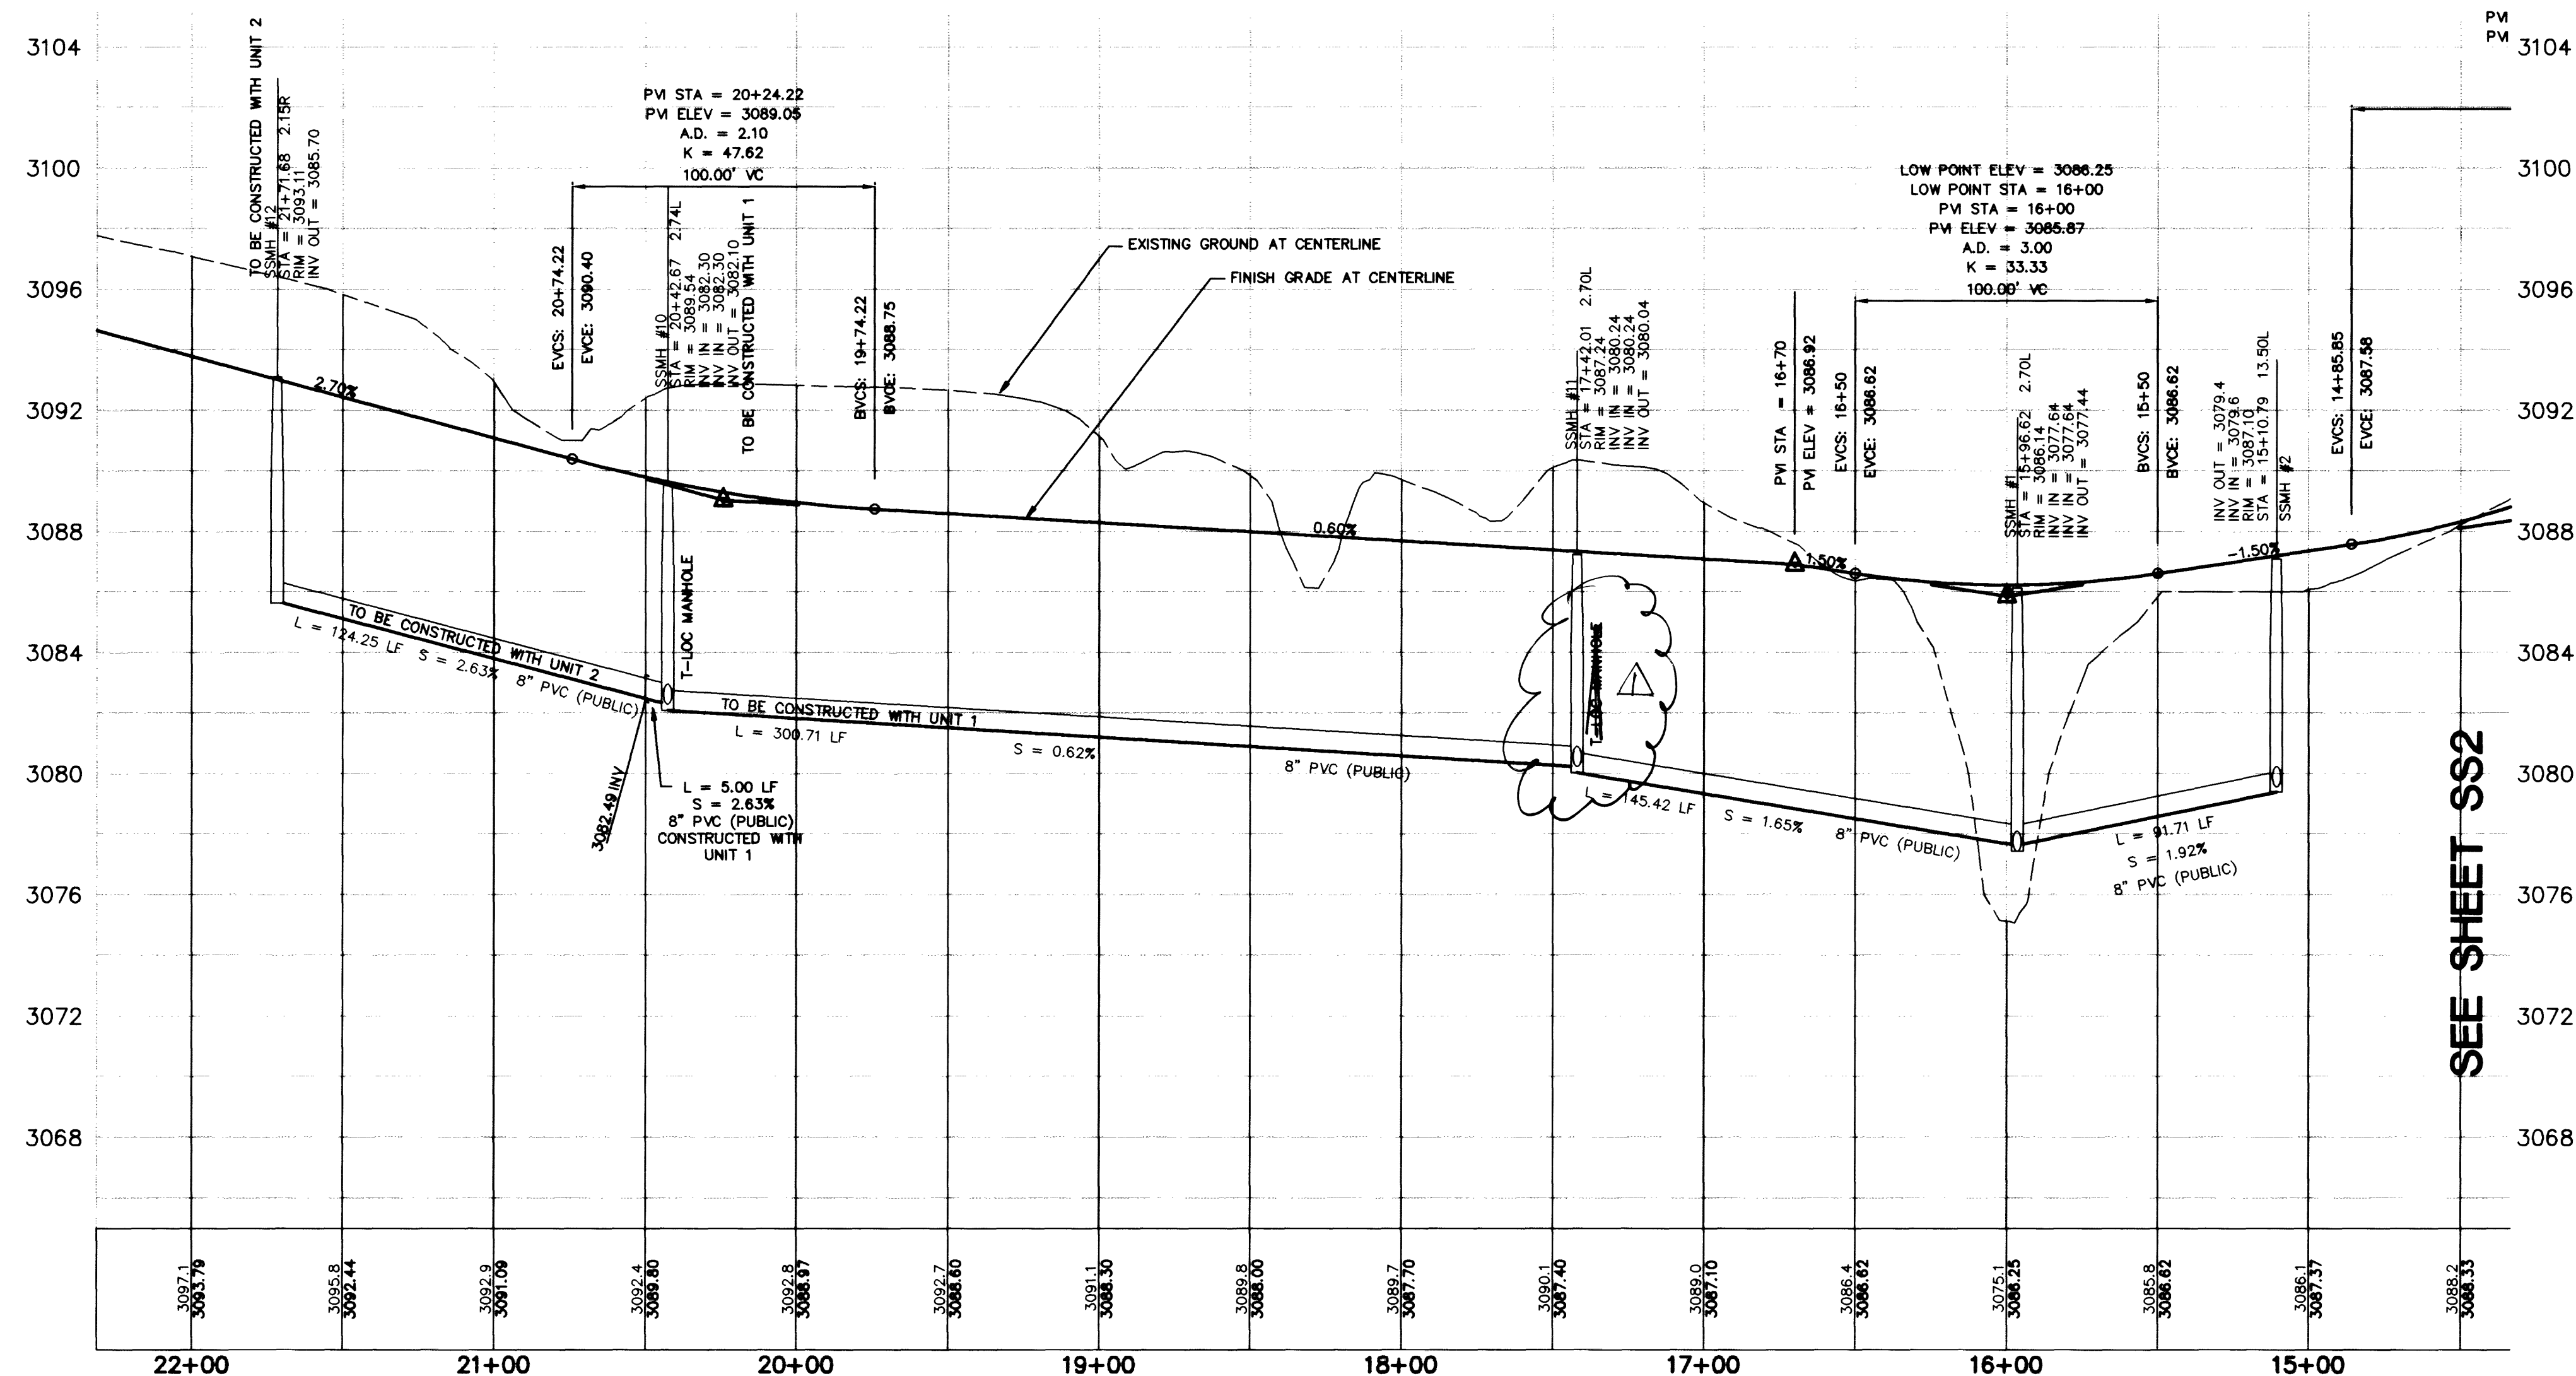
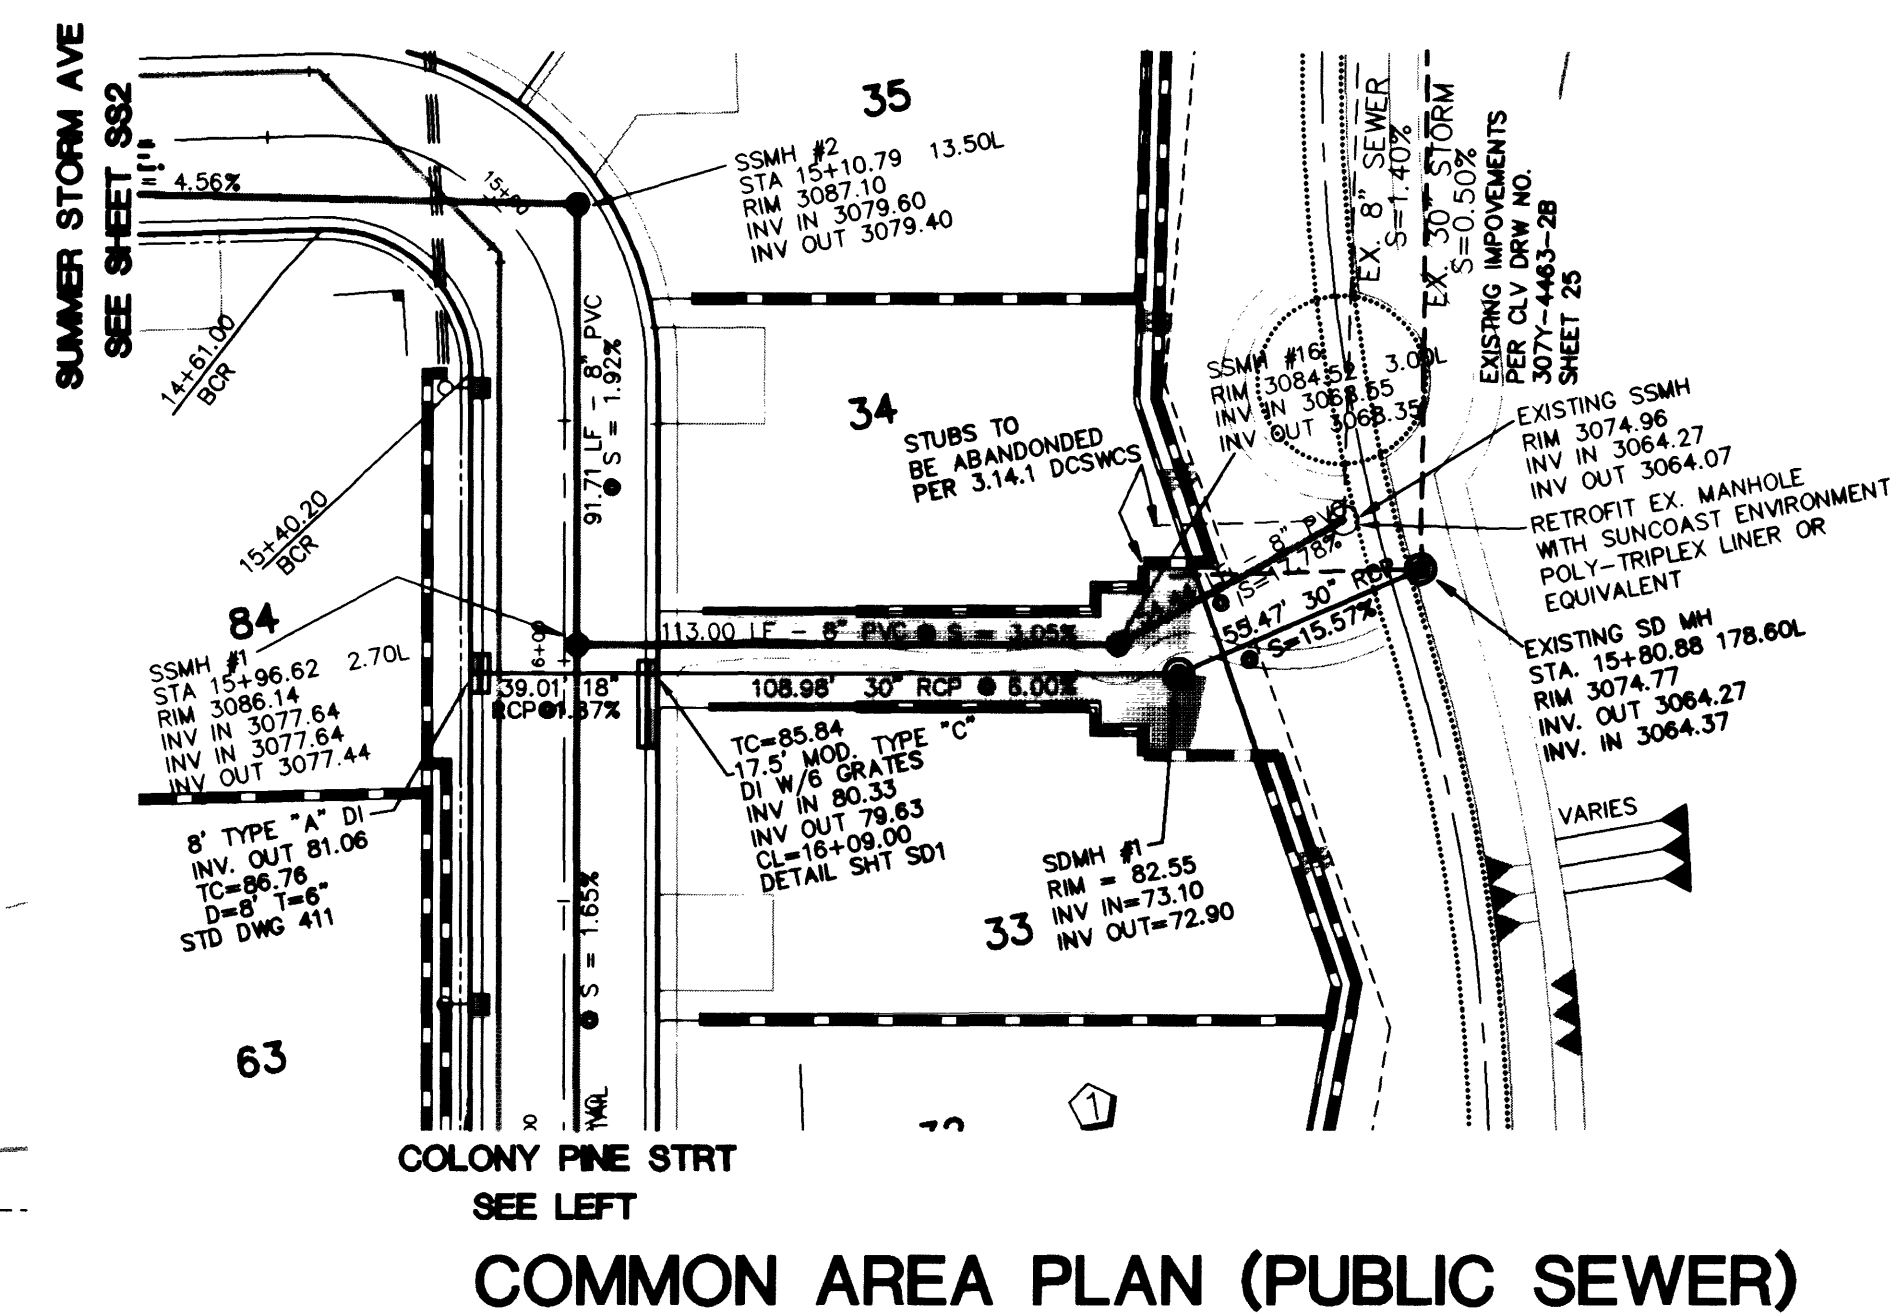


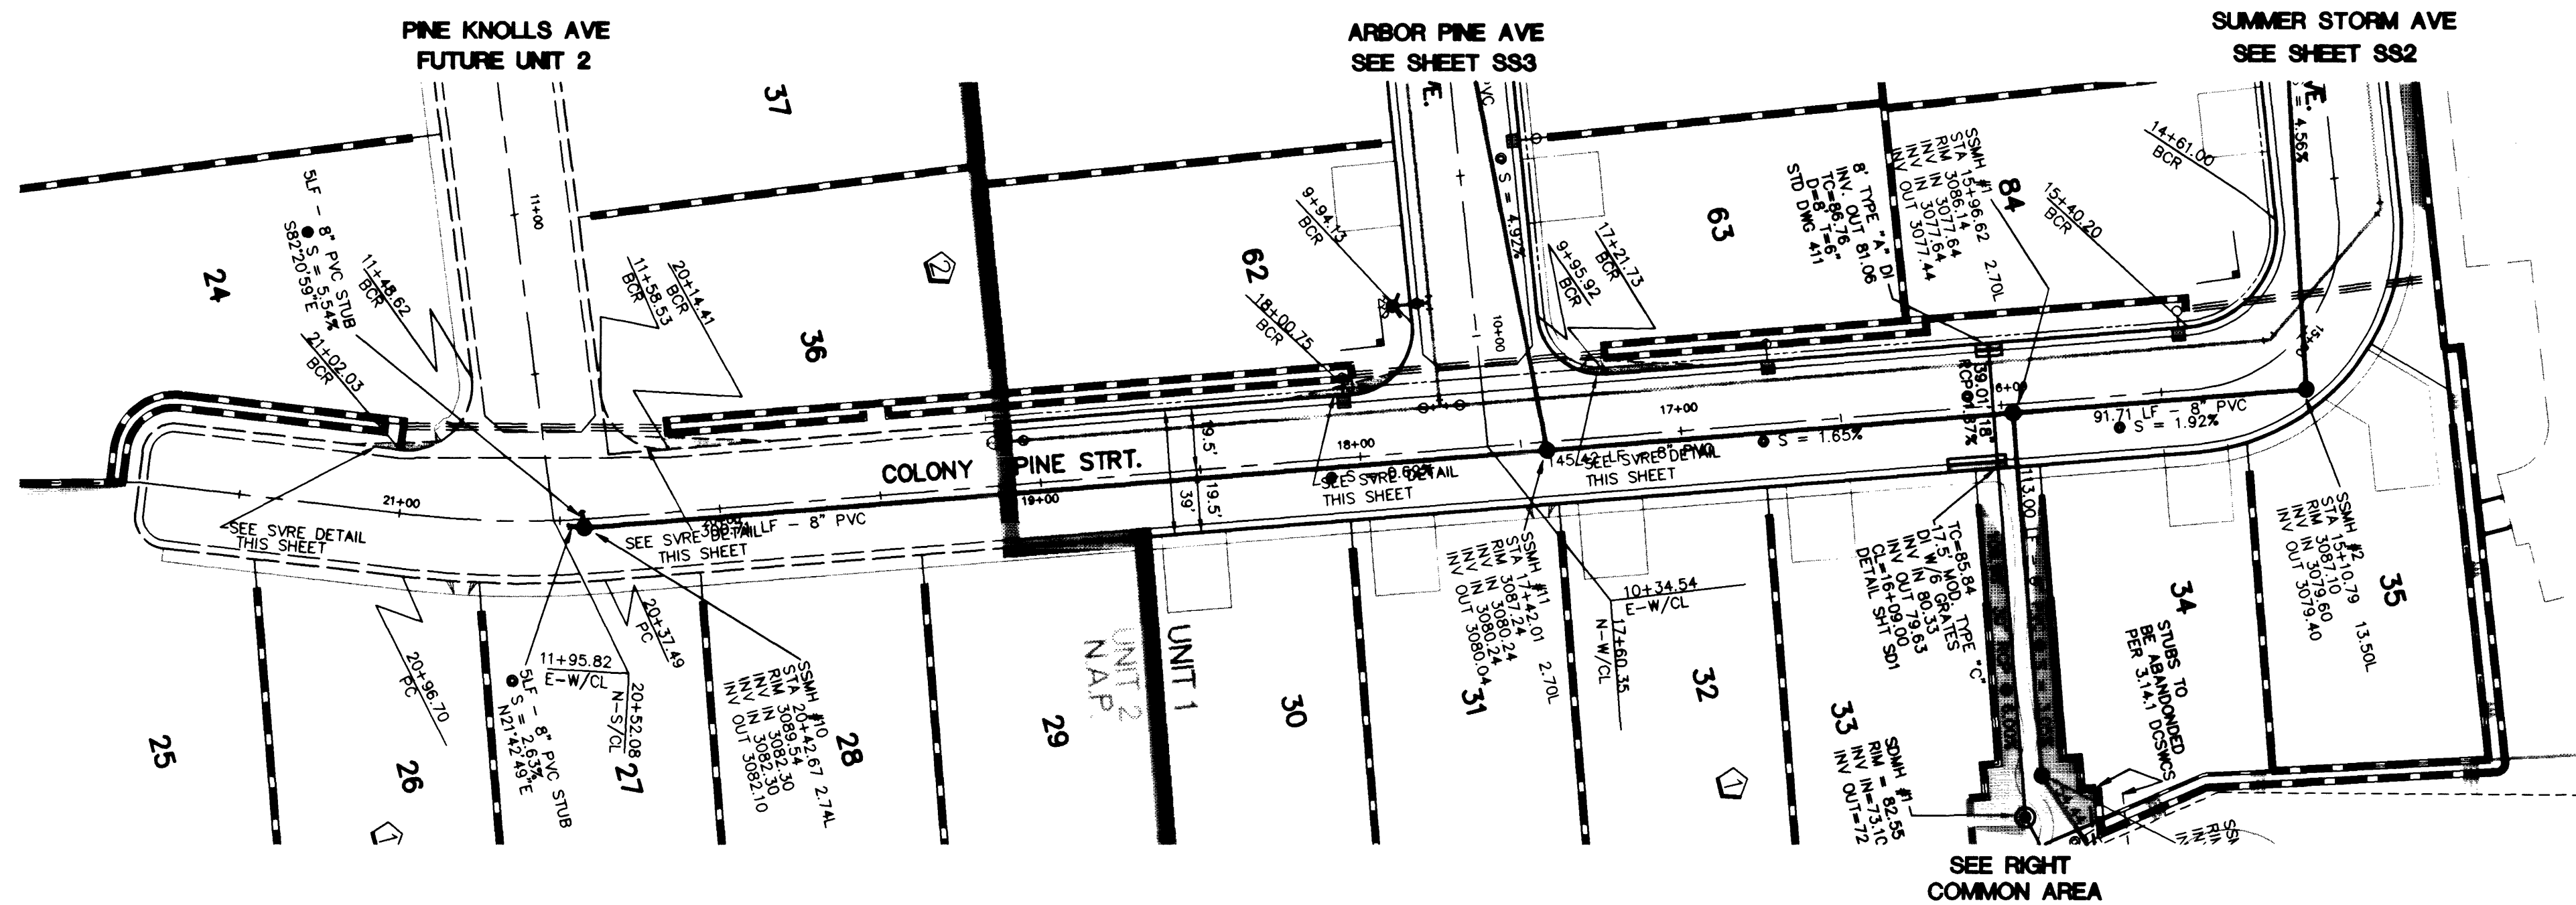

COLONY PINE STREET PROFILE (PUBLIC SEWER - PRIVATE DRIVE)

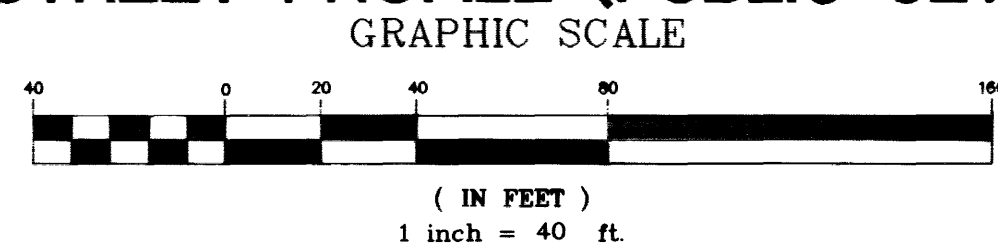

BASIS OF BEARING

NORTH 15°23'46" EAST, BEING THE BEARING OF THE CENTERLINE OF ANASAZI DRIVE AS SHOWN BY MAP THEREOF ON FILE IN BOOK 64, PAGE 67 OF PLATS, IN THE CLARK COUNTY RECORDER'S OFFICE, CLARK COUNTY, NEVADA.

BENCHMARK

CITY OF LAS VEGAS BENCHMARK
CLV0001954. RIVET & PLATE IN TOP OF CURB NW SIDE OF
TOWN CENTER DRIVE & SOUTH CIRCLE ISLAND.
2725.923 NGVD 1929 DATUM
2738.37 NAVD 1988 DATUM (831.6074 M)
2726.19 SUMMERLIN DATUM (USED IN THIS PROJECT)

NOTICE!

EXISTING UTILITIES ARE SHOWN ON PLANS FOR THE CONVENIENCE OF THE CONTRACTOR ONLY. THE CONTRACTOR IS RESPONSIBLE FOR THE PROTECTION OF ALL UTILITIES. THE ENGINEER BEARS NO RESPONSIBILITY FOR UTILITIES NOT SHOWN OR SHOWN INCORRECTLY.

AVOID CUTTING UNDERGROUND UTILITIES. IT'S COSTLY.

**Call
BEFORE YOU
Dig**

1-800-227-2600
UNDERGROUND SERVICE (USA)

		SHEET SS4 19 OF 20 SHEETS DRAWING NO. 307Y-4557-1	
DRAWN BY: _____ RF _____ DESIGNED BY: _____ ET _____ CHECKED BY: _____ PROJECT NO: 716701 SCALE: 1" = 40'		SHEET SEWER PLAN/PROFILE COLONY PINE STREET AND EASTERLY COMMON AREA	
TITLE WOODLANDS UNIT 1 THE ARBORS @ SUMMERLIN		COLEMAN HOMES 1635 VILLAGE CENTER CIRCLE SUITE 100 LAS VEGAS, NEVADA 89134 (702) 243-3800	
ALPHA & ENGINEERING COMPANY 50 So. Jones #202, Las Vegas, NV, 89107 Telephone: (702) 877-1300		1 7/16" x 7/8" REVISE 12/11/11 7/14/98 Pkt	
REV _____ DATE _____ BY _____ REVISION _____			