PLOT N

PORTION OF PLOT G

SCALE: 1" = 10'

ALL LOTS 5' x 9'
UNLESS OTHERWISE NOTED

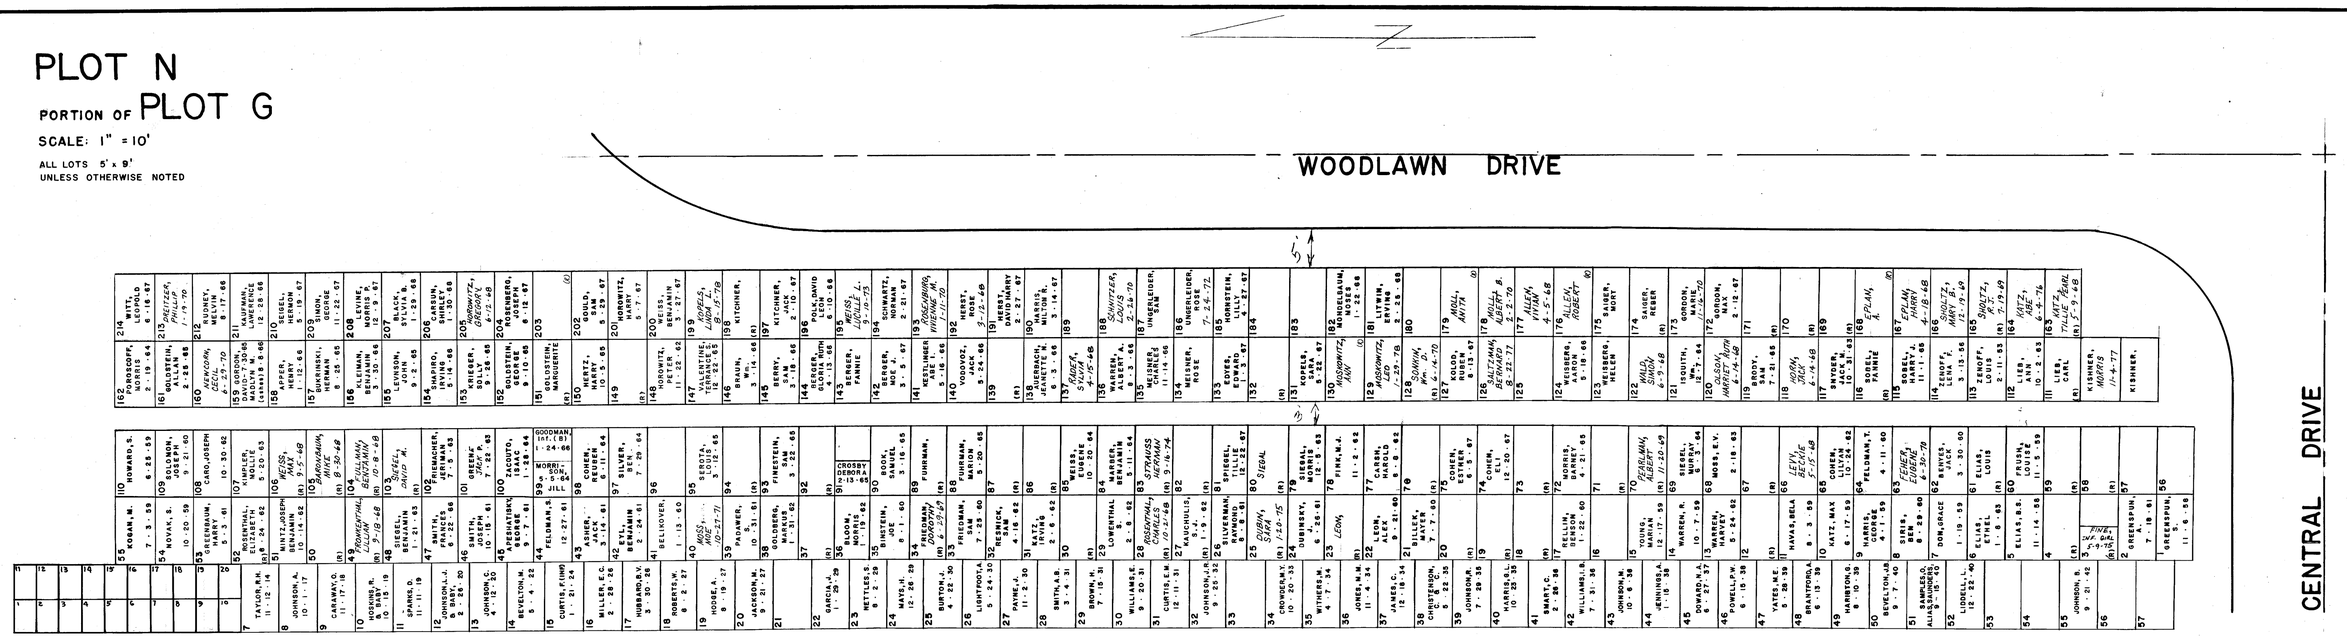

PLOT M

PORTION OF PLOT G

SCALE: 1" = 10'

ALL LOTS 5' x 9'
UNLESS OTHERWISE NOTED

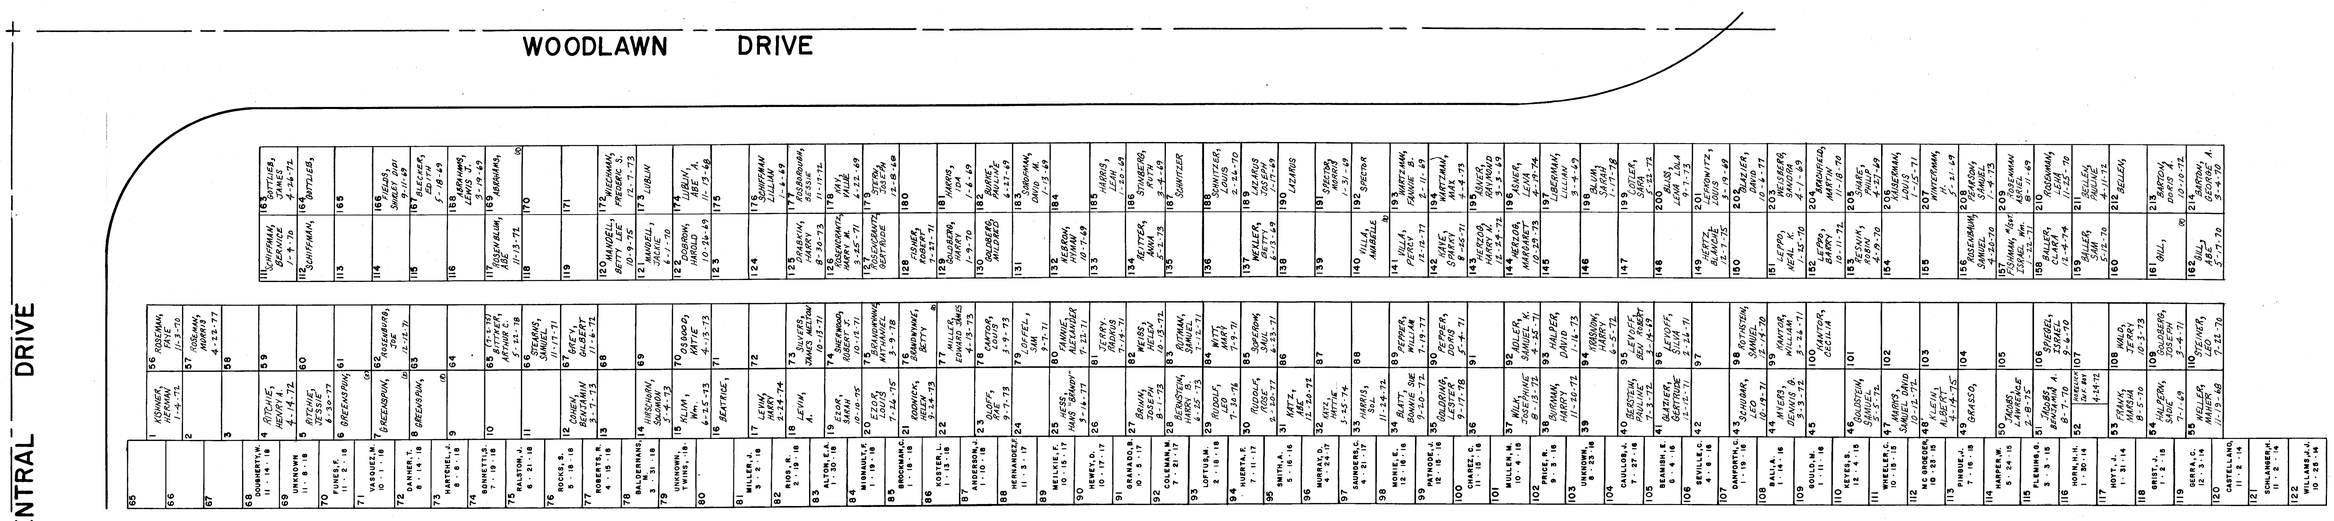

685 - 34

3396