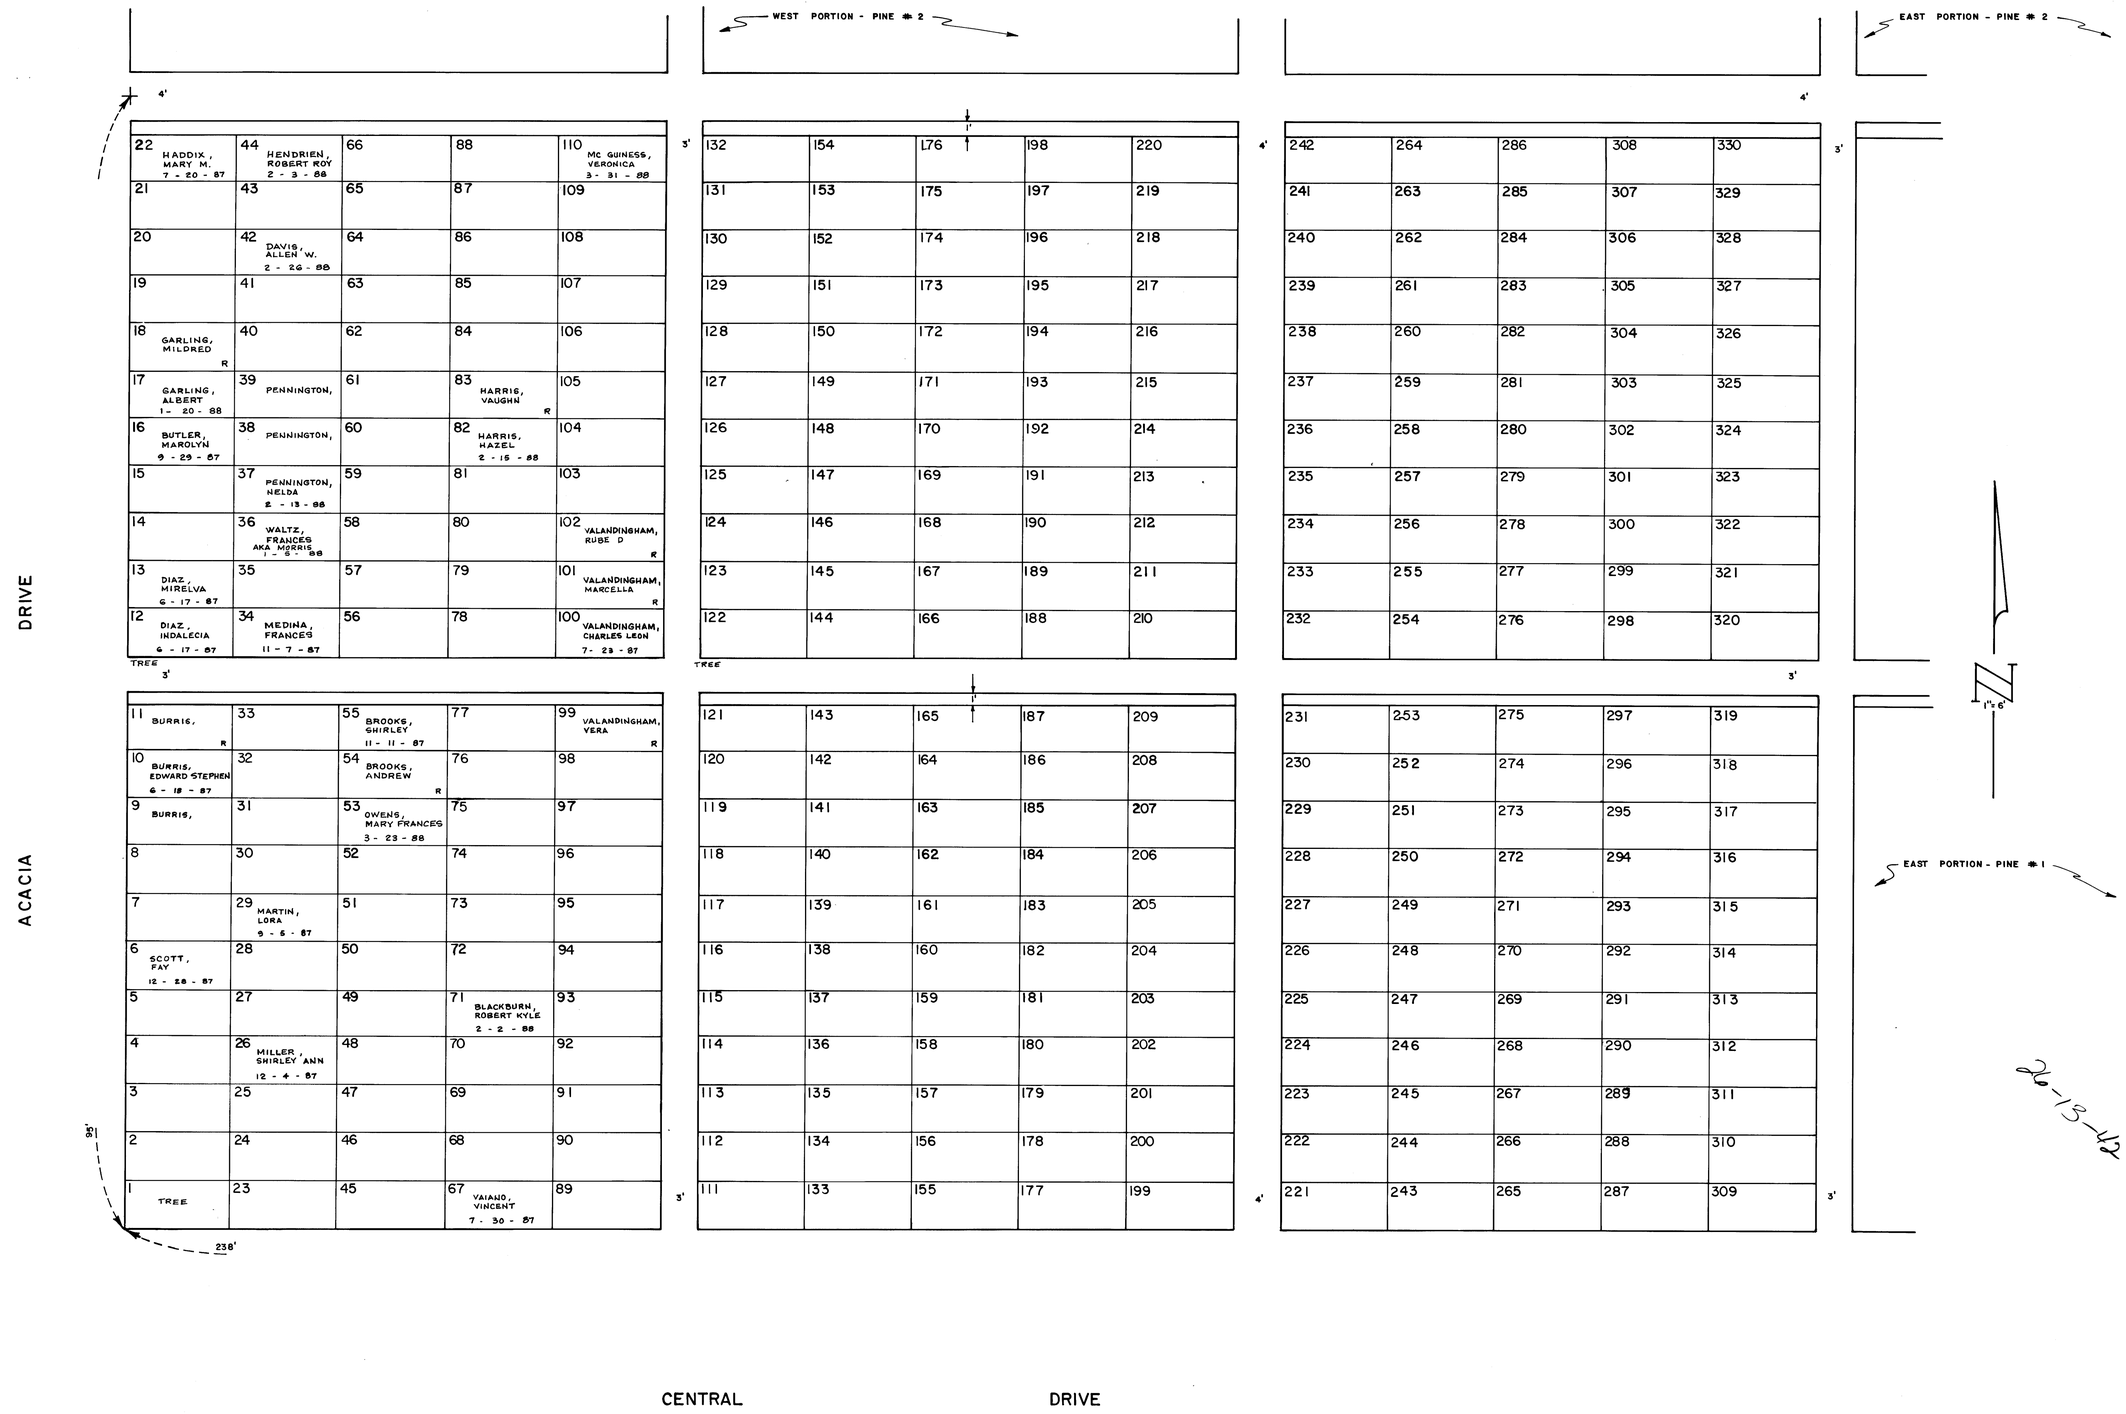

22 HADDIX, MARY M. 7 - 20 - 87	44 HENDRIEN, ROBERT ROY 2 - 3 - 88	66	88	110 MC GUINESS, VERONICA 3 - 31 - 88	132	154	176	198	220	242	264	286	308	330
21	43	65	87	109	131	153	175	197	219	241	263	285	307	329
20	42 DAVIS, ALLEN W. 2 - 26 - 88	64	86	108	130	152	174	196	218	240	262	284	306	328
19	41	63	85	107	129	151	173	195	217	239	261	283	305	327
18 GARLING, MILDRED R	40	62	84	106	128	150	172	194	216	238	260	282	304	326
17 GARLING, ALBERT 1 - 20 - 88	39 PENNINGTON,	61	83 HARRIS, VAUGHN R	105	127	149	171	193	215	237	259	281	303	325
16 BUTLER, MAROLYN 9 - 29 - 87	38 PENNINGTON,	60	82 HARRIS, HAZEL 2 - 15 - 88	104	126	148	170	192	214	236	258	280	302	324
15	37 PENNINGTON, NELDA 2 - 13 - 88	59	81	103	125	147	169	191	213	235	257	279	301	323
14	36 WALTZ, FRANCES AKA MORRIS 1 - 5 - 88	58	80	102 VALANDINGHAM, RUBE D R	124	146	168	190	212	234	256	278	300	322
13 DIAZ, MIRELVA 6 - 17 - 87	35	57	79	101 VALANDINGHAM, MARCELLA R	123	145	167	189	211	233	255	277	299	321
12 DIAZ, INDALECIA 6 - 17 - 87	34 MEDINA, FRANCES 11 - 7 - 87	56	78	100 VALANDINGHAM, CHARLES LEON 7 - 23 - 87	122	144	166	188	210	232	254	276	298	320
11 BURRIS, R	33	55 BROOKS, SHIRLEY 11 - 11 - 87	77	99 VALANDINGHAM, VERA R	121	143	165	187	209	231	253	275	297	319
10 BURRIS, EDWARD STEPHEN 6 - 18 - 87	32	54 BROOKS, ANDREW R	76	98	120	142	164	186	208	230	252	274	296	318
9 BURRIS,	31	53 OWENS, MARY FRANCES 3 - 23 - 88	75	97	119	141	163	185	207	229	251	273	295	317
8	30	52	74	96	118	140	162	184	206	228	250	272	294	316
7	29 MARTIN, LORA 9 - 5 - 87	51	73	95	117	139	161	183	205	227	249	271	293	315
6 SCOTT, FAY 12 - 28 - 87	28	50	72	94	116	138	160	182	204	226	248	270	292	314
5	27	49	71 BLACKBURN, ROBERT KYLE 2 - 2 - 88	93	115	137	159	181	203	225	247	269	291	313
4	26 MILLER, SHIRLEY ANN 12 - 4 - 87	48	70	92	114	136	158	180	202	224	246	268	290	312
3	25	47	69	91	113	135	157	179	201	223	245	267	289	311
2	24	46	68	90	112	134	156	178	200	222	244	266	288	310
1 TREE	23	45	67 VAIANO, VINCENT 7 - 30 - 87	89	111	133	155	177	199	221	243	265	287	309

Revisions	Date

Scale (h) 1" = 6' | Scale (v) | W.A.
Fld. bk. no. | Date 11 / 1 / 88
Design by | Drawn by NORMA GOMEZ

Department of Public Services Engineering Design Division

PINE # 1
WEST PORTION

WOODLAWN CEMETERY
4' X 9' PLOTS

CITY OF LAS VEGAS NEVADA

Drawing no. 686 - 13 | 5/8

3354