

FAIRVIEW DRIVE

1	JOHNSON, DOROTHY 9-24-87	23	SAUNDERS, GEORGE SR. 2-13-88	45	HILL, LOUISE & INFANT 8-13-88	67	JACOBS, KENNETH 2-6-88	89	PAYNE, HATTIE 8-3-88
2	MARSHALL, MARY 5-20-88	24	WHITE, CHARLES 4-23-88	46		68		90	
3	BANKS, THOMAS 7-2-88	25	ALEXIS, GERALDINE 8-29-88	47	NEIL,	69		91	
4	BROCK, R	26		48	NEIL,	70		92	
5	BROCK, JACK 8-30-87	27	NEWMAN, GLORIA 4-28-88	49	NEIL,	71		93	
6	TREE	28	NEWMAN, JOSE 8-18-88	50	NEIL,	72		94	
7	TREE	29	HEISIG, R	51	PARKER, DOLLY 9-20-88	73		95	
8	WILSON, BOBBIE 2-2-88	30	HEISIG, HELMUT 8-6-87	52		74		96	
9	WILSON, THOMAS 4-8-88	31	FALLON, PATRICK 7-19-88	53		75		97	
10	BOIRUM, R	32		54		76		98	
11	BOIRUM, R	33	MC LEMORE, GEORGE 1-4-88	55		77		99	WASHINGTON, ANDREW 2-12-88

111	133	155	177	199
112	134	156	178	200
113	135	157	179	201
114	136	158	180	202
115	137	159	181	203
116	138	160	182	204
117	139	161	183	205
118	140	162	184	206
119	141	163	185	207
120	142	164	186	208
121	143	165	187	209

221	243	265	287	309
222	244	266	288	310
223	245	267	289	311
224	246	268	290	312
225	247	269	291	313
226	248	270	292	314
227	249	271	293	315
228	250	272	294	316
229	251	273	295	317
230	252	274	296	318
231	253	275	297	319

12		34	ROSEMOND, DONALD 9-22-87	56		78		100	
13	JACKSON, JAMES M. 8-29-88	35	KOWALSKI, JOHANNE R	57		79		101	
14	DAVIS, MARY E. 3-31-88	36	KOWALSKI, JOSEPH 3-8-88	58		80		102	
15	NUELLS, MURRY 9-13-88	37		59		81		103	
16		38	BRIGHAM, MISTY MAE 2-22-88	60		82		104	
17		39		61		83		105	VASQUEZ, ELIDIA R
18		40	TOLENTINO, ROSARIO 4-5-88	62		84		106	VASQUEZ, PILAR J. 9-1-88
19		41	BADILLA, AMADO 12-9-87	63		85		107	SANDOVAL, LAWRENCE 2-27-88
20		42		64		86		108	GILMORE, SYRD 7-22-88
21	HASMAN, R	43		65		87		109	DEAN, JIMMIE 9-18-87
22	HASMAN, R	44	GONZALEZ, SILBIANA 6-6-88	66		88		110	VAN OSCAR 6-9-88


122	144	166	188	210
123	145	167	189	211
124	146	168	190	212
125	147	169	191	213
126	148	170	192	214
127	149	171	193	215
128	150	172	194	216
129	151	173	195	217
130	152	174	196	218
131	153	175	197	219
132	154	176	198	220

232	254	276	298	320
233	255	277	299	321
234	256	278	300	322
235	257	279	301	323
236	258	280	302	324
237	259	281	303	325
238	260	282	304	326
239	261	283	305	327
240	262	284	306	328
241	263	285	307	329
242	264	286	308	330

DRIVE

ACACIA

EAST PORTION - PINE # 2

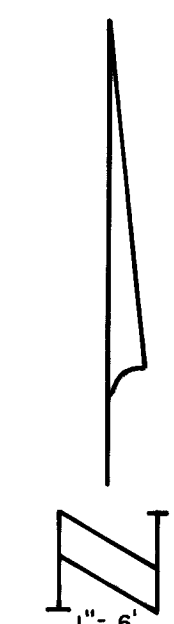

WEST PORTION - PINE # 1

EAST PORTION - PINE # 1

26-13-44

Scale (h) 1" = 6' Scale (v) 1" = 6' Date 5/3/88 Design by Drawn by NORMA GOMEZ		W.A. Date Revisions
Department of Public Services Engineering Design Division		JUNIPER SECTION WEST PORTION
WOODLAWN CEMETERY 4' X 9' PLOTS		Date

