4' grave space
in these sections

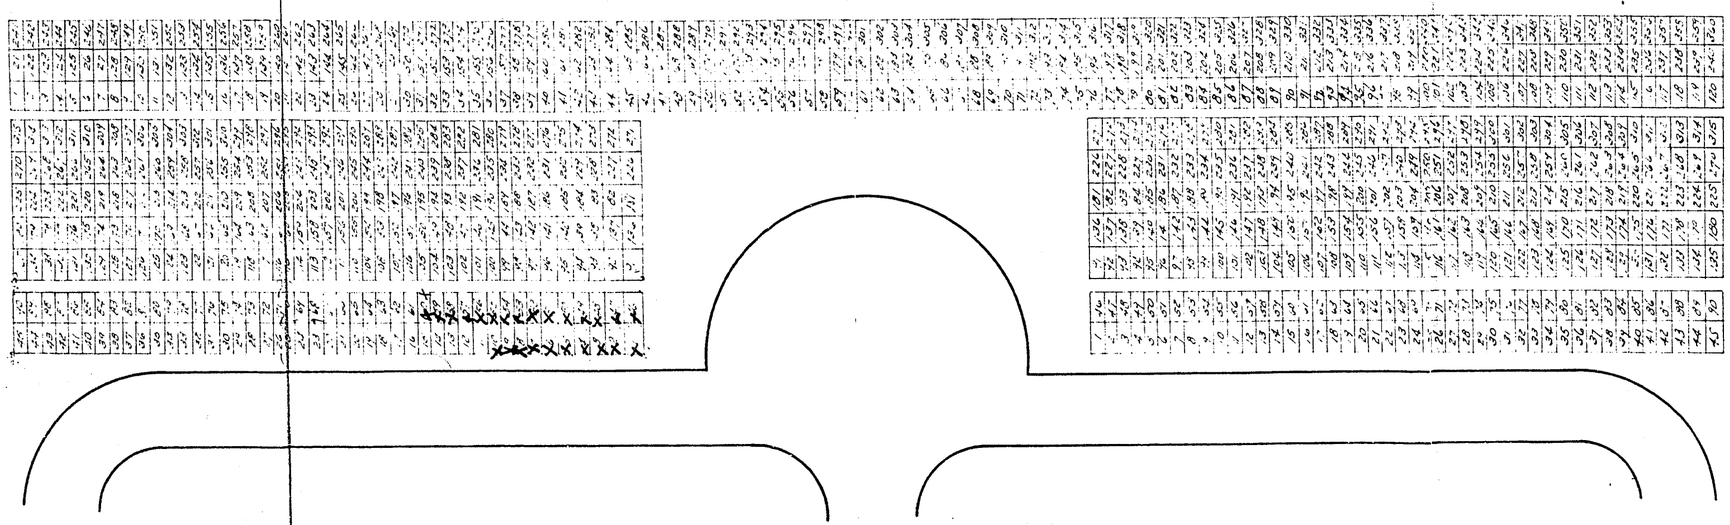

REPLAT OF LOTS P-Q-R WOODLAWN CEMETERY

3-607-3A

7-19-40

20-13-113

68.5.-11