


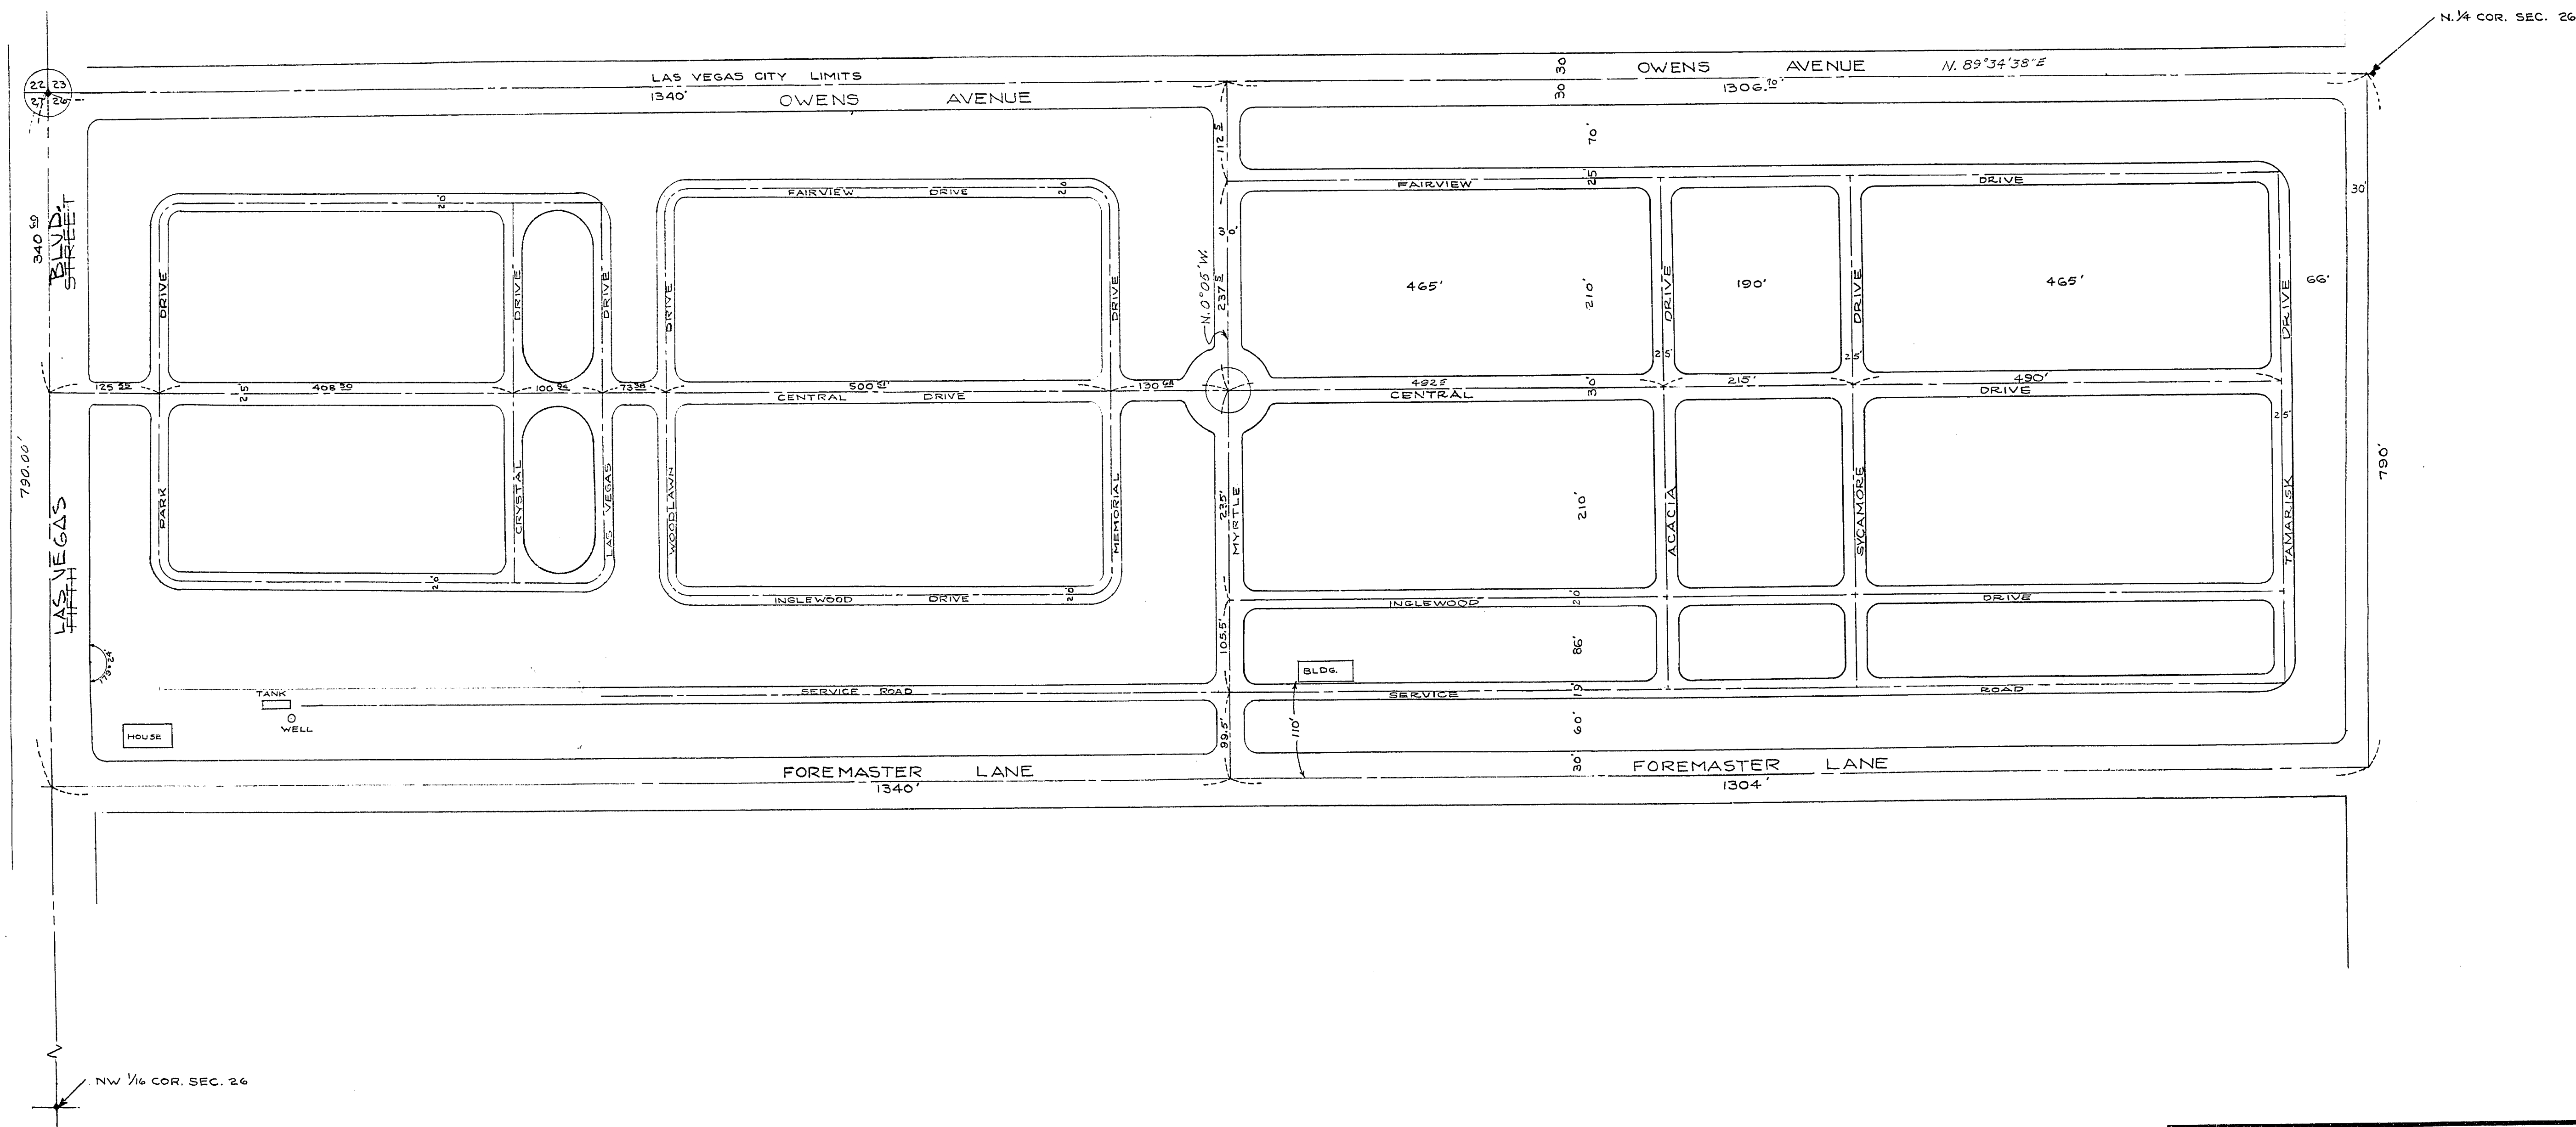

REVISIONS			CITY OF LAS VEGAS NEVADA ENGINEERING DEPT.	
NO.	BY	DESCRIPTION	DATE	SCALE: 1" = 100'
1	J.M.	REALIGN. STS. IN NEW ADDITION	12-29-54	FIELD BOOK NO. 54-14; 55-17
2				WORK ORDER NO. 1175
3				DRAWING NO.
4				685.-V5
5				
6				
26-13-118