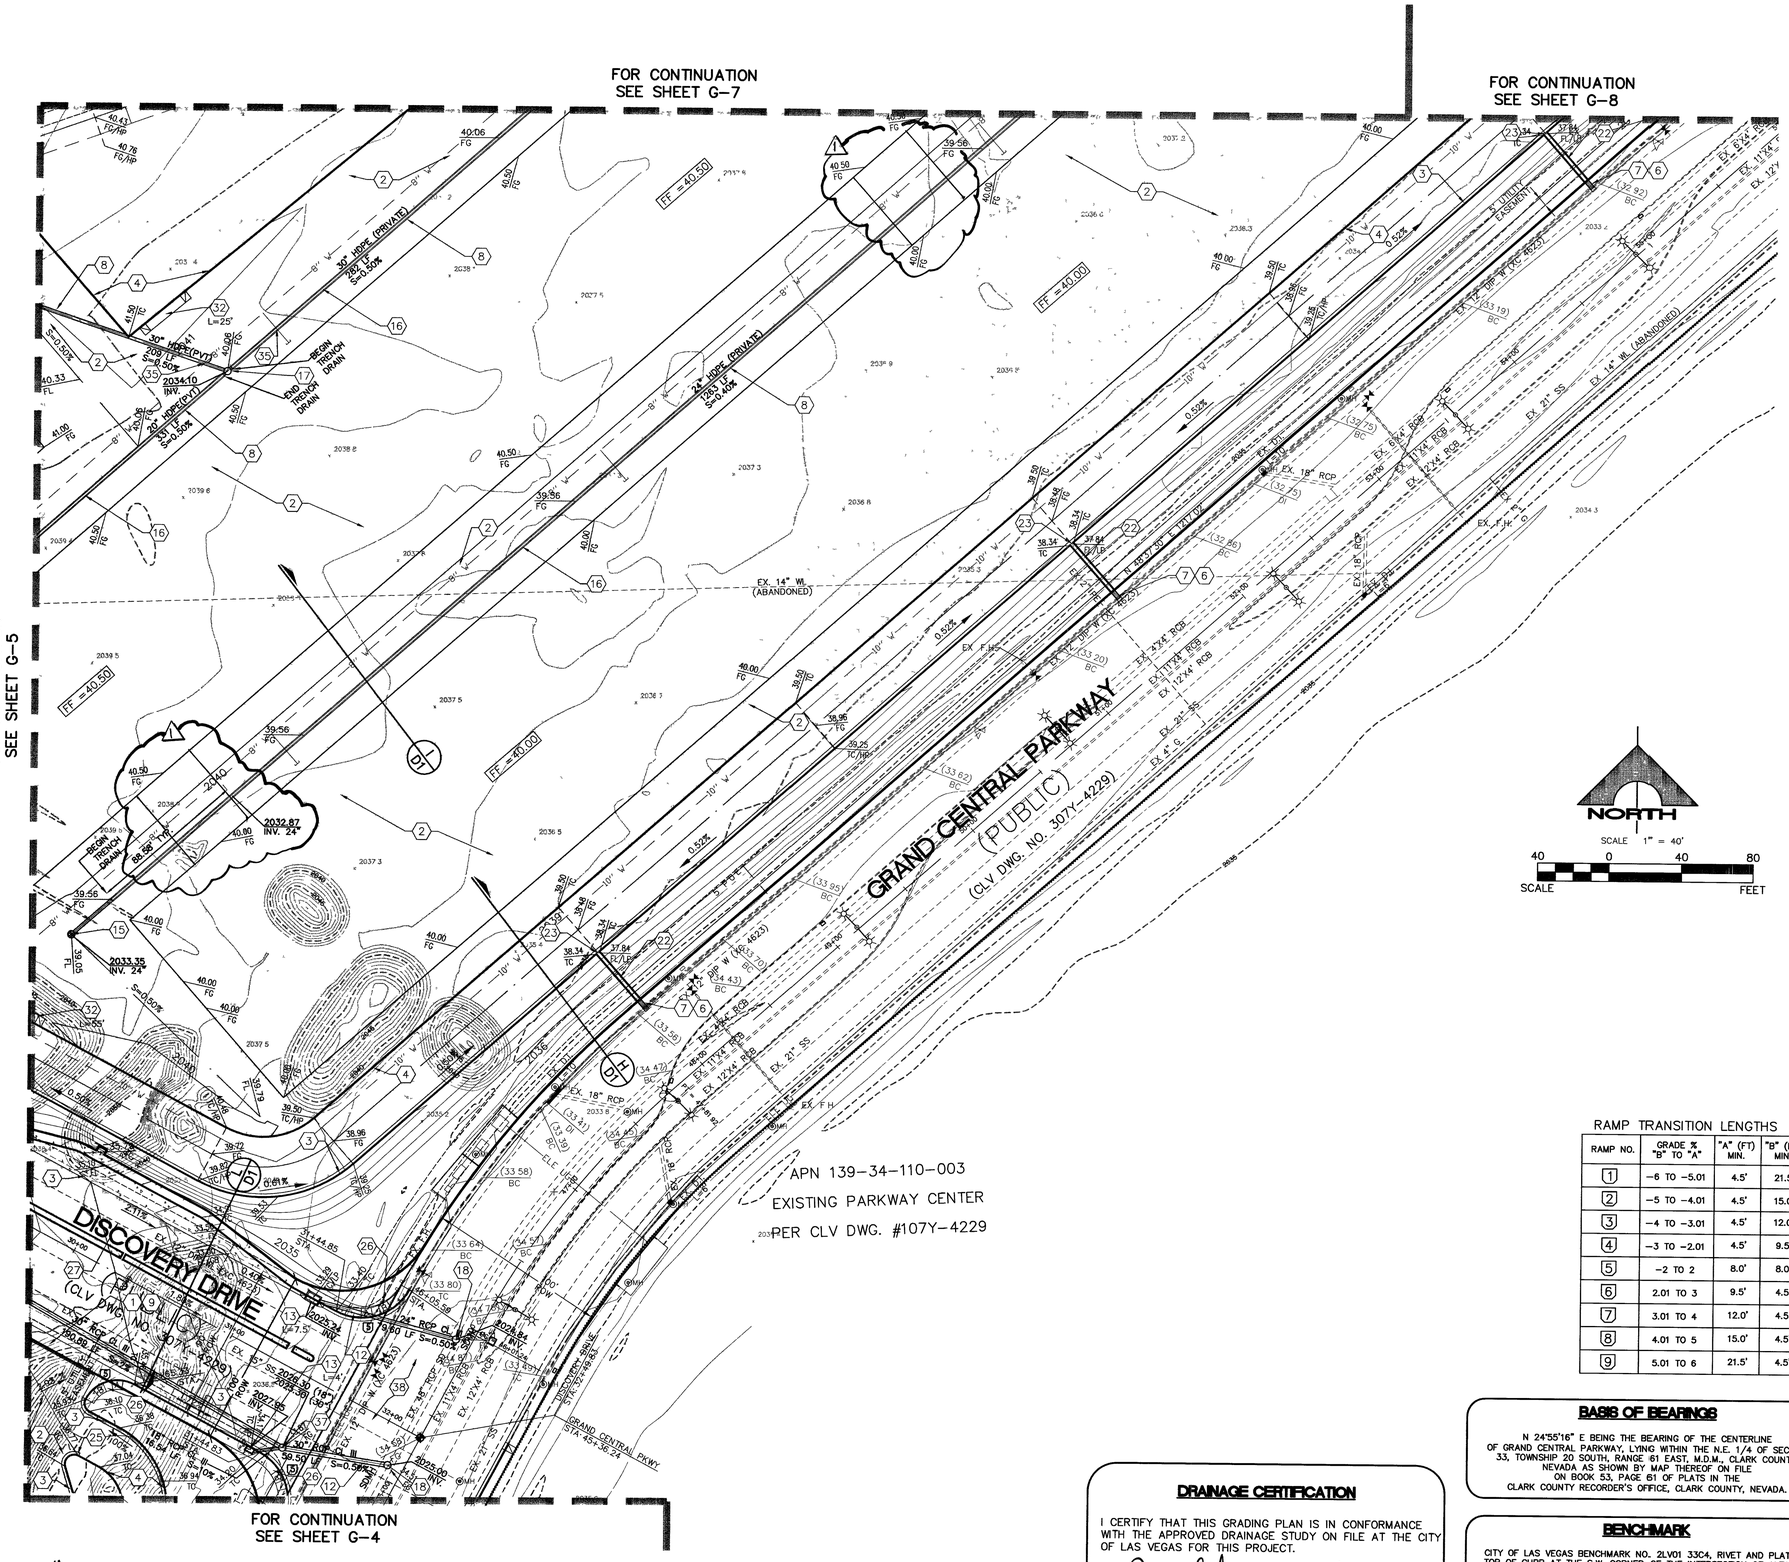
FOR CONTINUATION
SEE SHEET G-7
FOR CONTINUATION
SEE SHEET G-8
FOR CONTINUATION
SEE SHEET G-5
FOR CONTINUATION
SEE SHEET G-4
GRAND CENTRAL PARKWAY
(PUBLIC)
(CLV DWG. NO. 307Y-4229)
DISCOVERY DRIVE
(CLV DWG. NO. 107Y-4229)
EX. 14" WL
(ABANDONED)
30" HDPE (PRIVATE)
S=0.50%
REGEN TRENCH DRAIN
END TRENCH DRAIN
2034.10
INV. 24"
2032.87
INV. 24"
2033.35
INV. 24"
2027.85
INV. 30"
2028.24
INV. 30"
