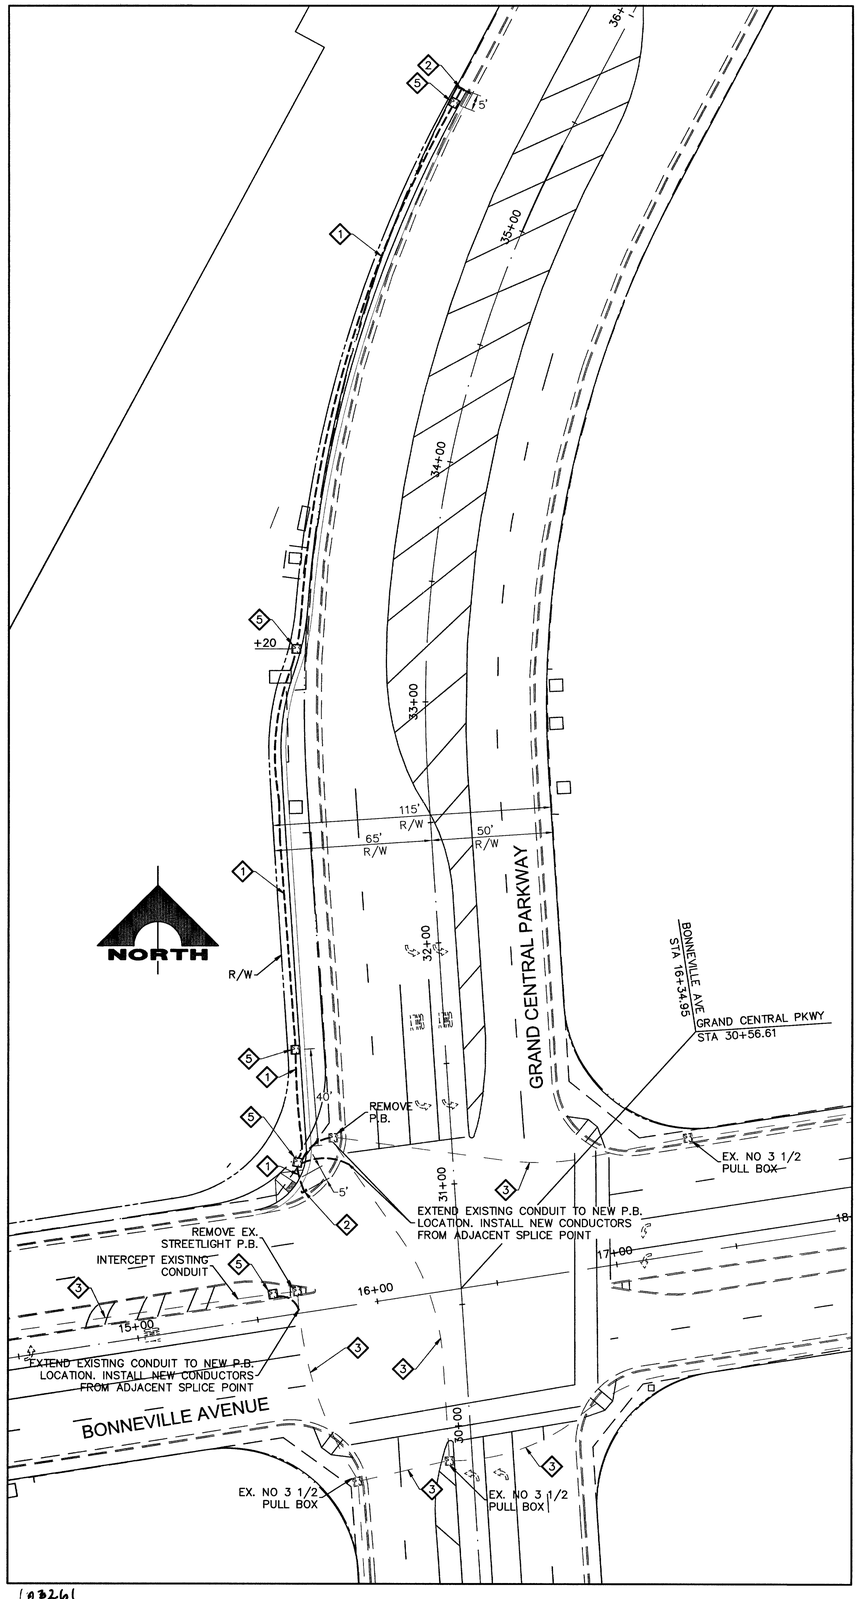

STREETLIGHT MODIFICATION

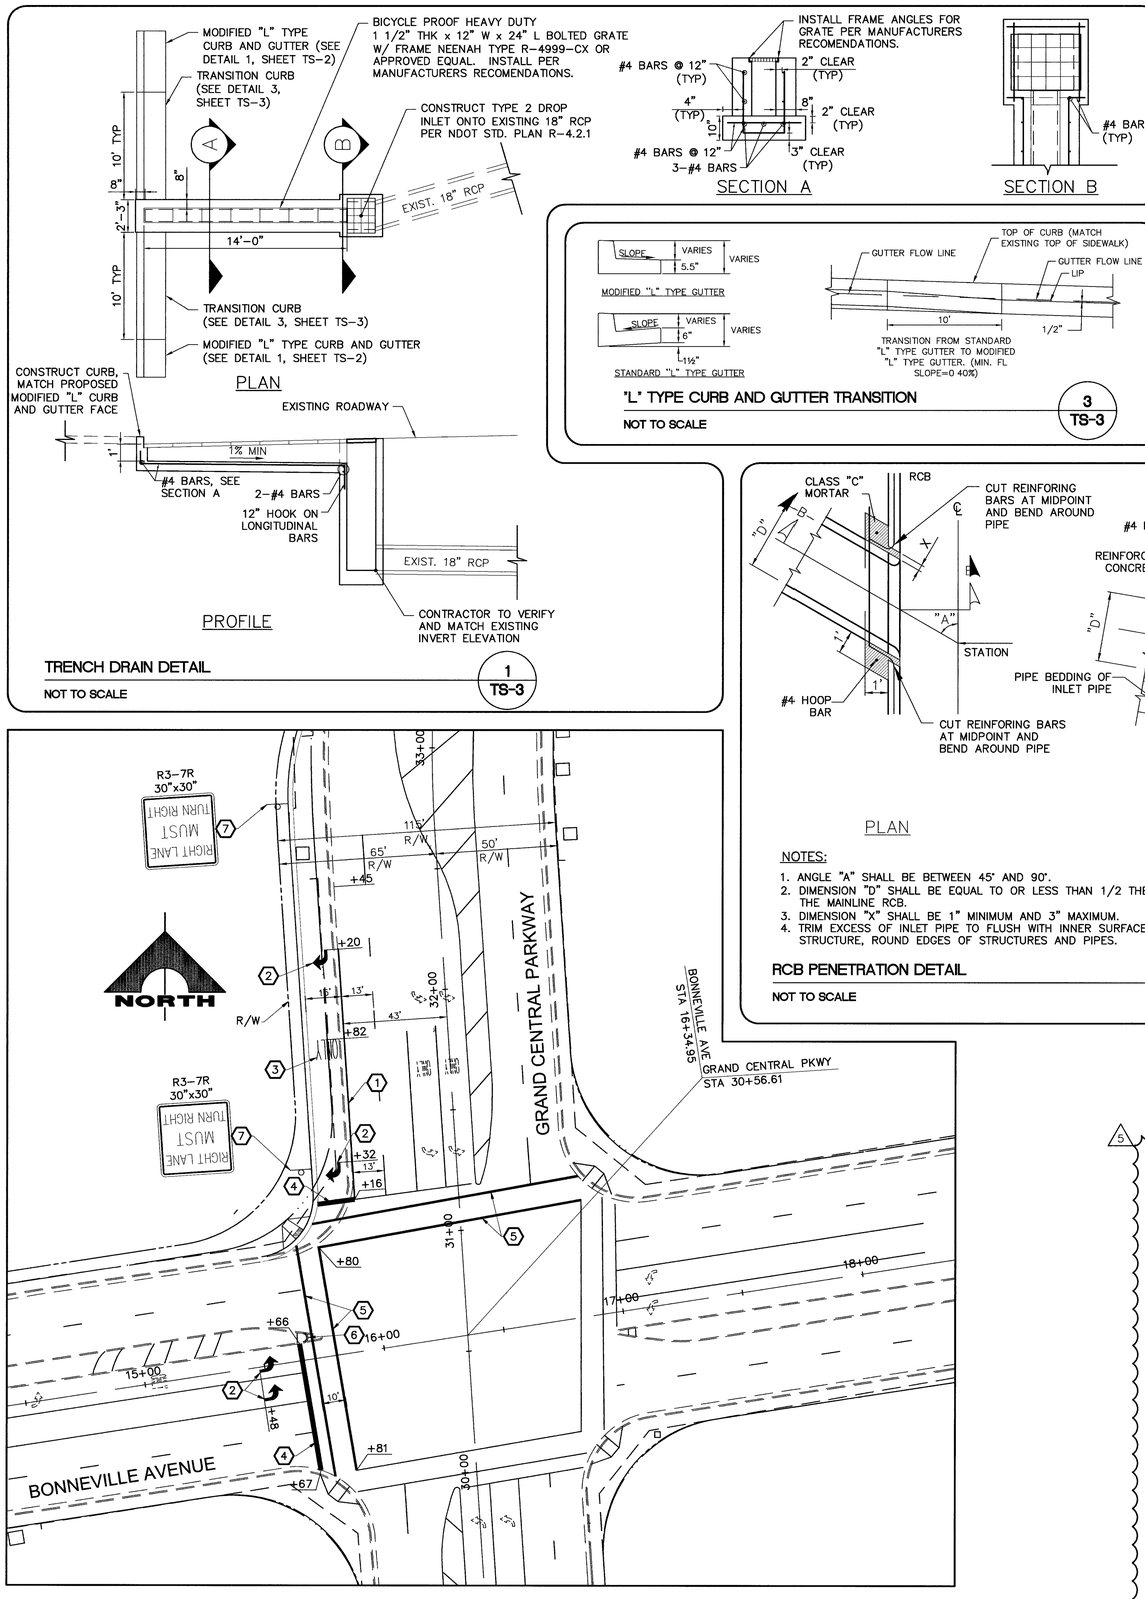

PERMANENT SIGNING AND STRIPING

TRENCH DRAIN DETAIL — 1 / TS-3

NOT TO SCALE

"L" TYPE CURB AND GUTTER TRANSITION — 3 / TS-3

NOT TO SCALE

STREET LIGHTING NOTES

1. 2" CONDUIT W/1-#8 GROUND
2. STUB AND CAP 2" CONDUIT 5' BEYOND P.B.
3. EXISTING 1-1/4" CONDUIT
4. STUB AND CAP 2" CONDUIT 5' BEYOND NEW PCC PAVEMENT
5. INSTALL NO. 3 1/2 P.B. (USDCCA STD. DWG. NO. 404.110)

SIGNING AND STRIPING NOTES

1. STORAGE LANE LINE (RPM) (USDCCA STD. DWG. NO. 246A)
2. WHITE PAVEMENT ARROW (PMF – TYPE I)
3. WHITE PAVEMENT "ONLY" (PMF – TYPE I)
4. 24-INCH WHITE STOP LINE (PAINT)
5. CROSSWALK LINE (PAINT) (USDCCA STD. DWG. NO. 254)
6. MEDIAN NOSE MARKINGS (USDCCA STD. DWG. NO. 248)
7. INSTALL NEW SIGN

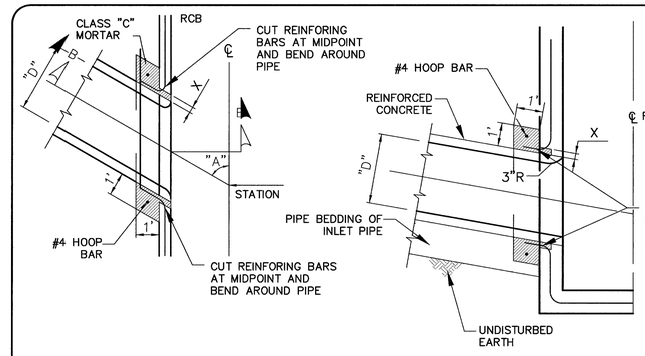

NOTES:

1. ANGLE "A" SHALL BE BETWEEN 45° AND 90°.
2. DIMENSION "D" SHALL BE EQUAL TO OR LESS THAN 1/2 THE INSIDE DIAMETER OF THE MAINLINE RCB.
3. DIMENSION "X" SHALL BE 1" MINIMUM AND 3" MAXIMUM.
4. TRIM EXCESS OF INLET PIPE TO FLUSH WITH INNER SURFACE OF RCB OR STRUCTURE, ROUND EDGES OF STRUCTURES AND PIPES.

RCB PENETRATION DETAIL — 2 / TS-3

NOT TO SCALE

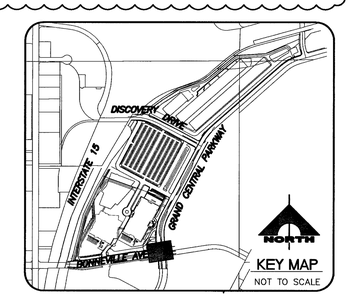

KEY MAP — NOT TO SCALE

30 0 30 60
SCALE FEET

AVOID HITTING OVERHEAD POWER LINES IT'S COSTLY
CALL BEFORE YOU DO OVERHEAD
1-702-227-2929

Call before you Dig.
1-800-227-2600
UNDERGROUND SERVICE (USA)

STATE OF NEVADA — MATTHEW D. METER — No. 10700 — CIVIL — PROFESSIONAL ENGINEER

DATE: 6/7/07

REV	DATE	DESCRIPTION	DATE AGEN. APP	DATE BCW. APP
A	6/7/07	REVISE TRAFFIC SIGNAL FOR RIGHT-TURN LANE	6/13/07	

DESIGN:
DRAWN:
CHECK:
ISSUE DATE:
ISSUE EDITOR:
PLOT DATE: 06-07-07
PLOT TIME: 11:13:27

G.C. WALLACE, INC.
Engineers/Planners/Surveyors
1555 SOUTH RAINBOW BLVD./LAS VEGAS, NEVADA, 89146
TELEPHONE: (702) 804-2000• FAX: (702) 804-2299
G:\619-298\dwg\Traf\Improv\US_STO1.dwg MMeyer

WORLD MARKET CENTER
PHASE IA
WMC ASSOCIATES, LLC

STREETLIGHT MODIFICATION, PERMANENT SIGNING AND STRIPING PLAN
GRAND CENTRAL PKWY/BONNEVILLE AVE INTERSECTION

DRAWING
TS-3
38 OF 42 SHTS

103261

107V3916-1A