




PLAN
NO. 1
NO. 2
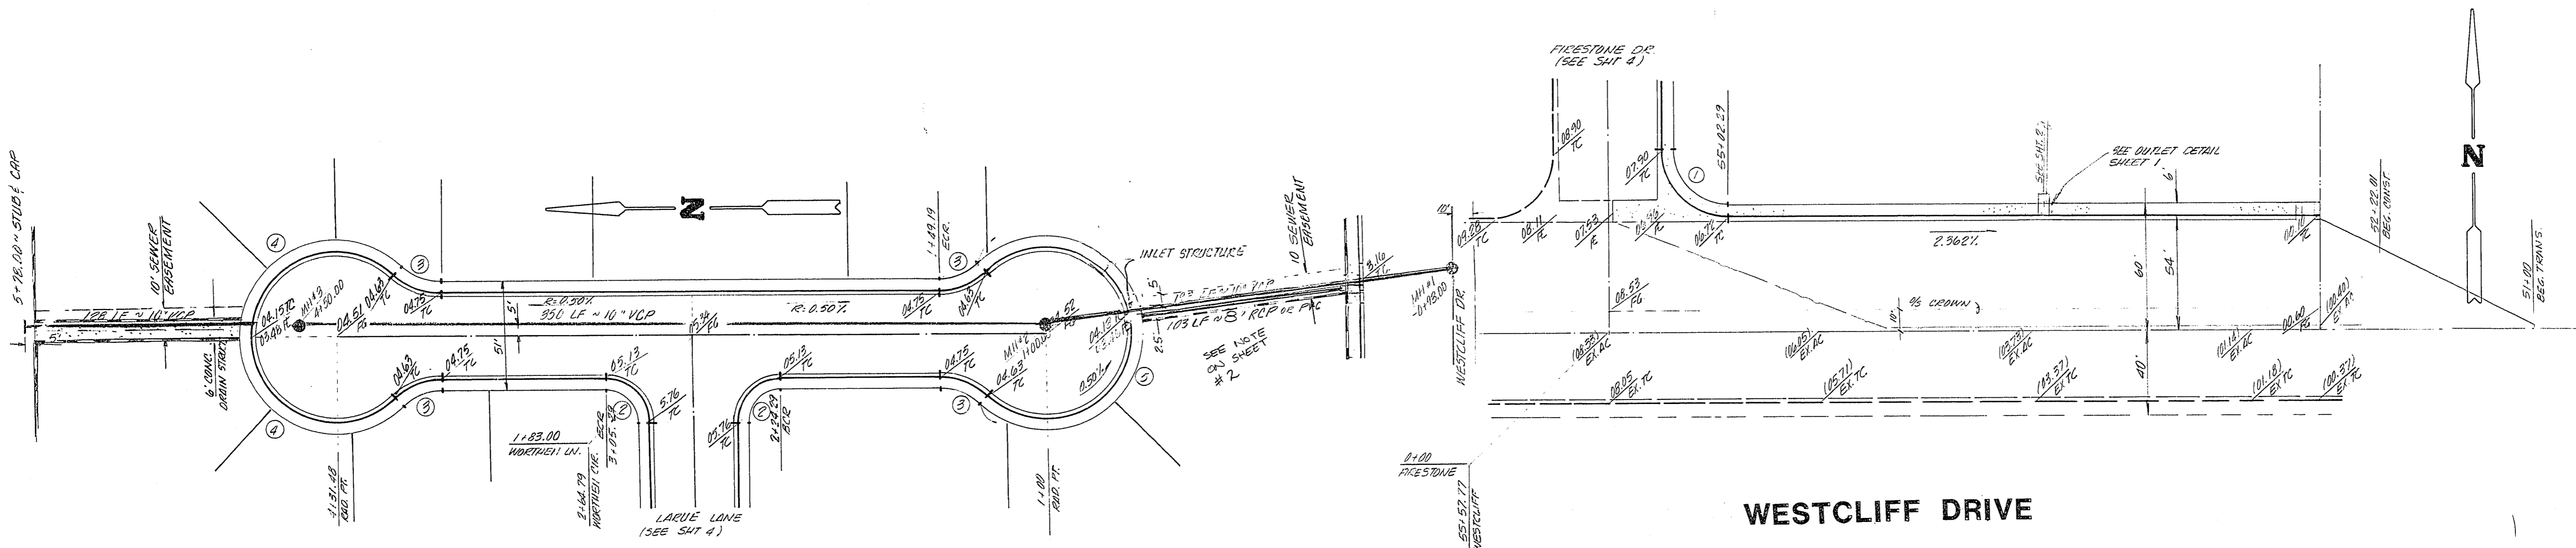

WORTHEN CIRCLE

WESTCLIFF DRIVE

CURVE	DATA	R	L	T
1	90.19-27	30.00	47.99	58.17
2	90.01-20	20.00	31.42	28.00
3	44.14-57	30.00	23.17	12.20
4	134.14-57	40.50	94.90	95.79
5	26.5-25-54	40.50	180.79	180

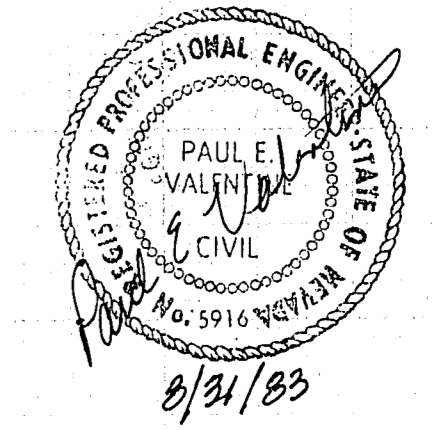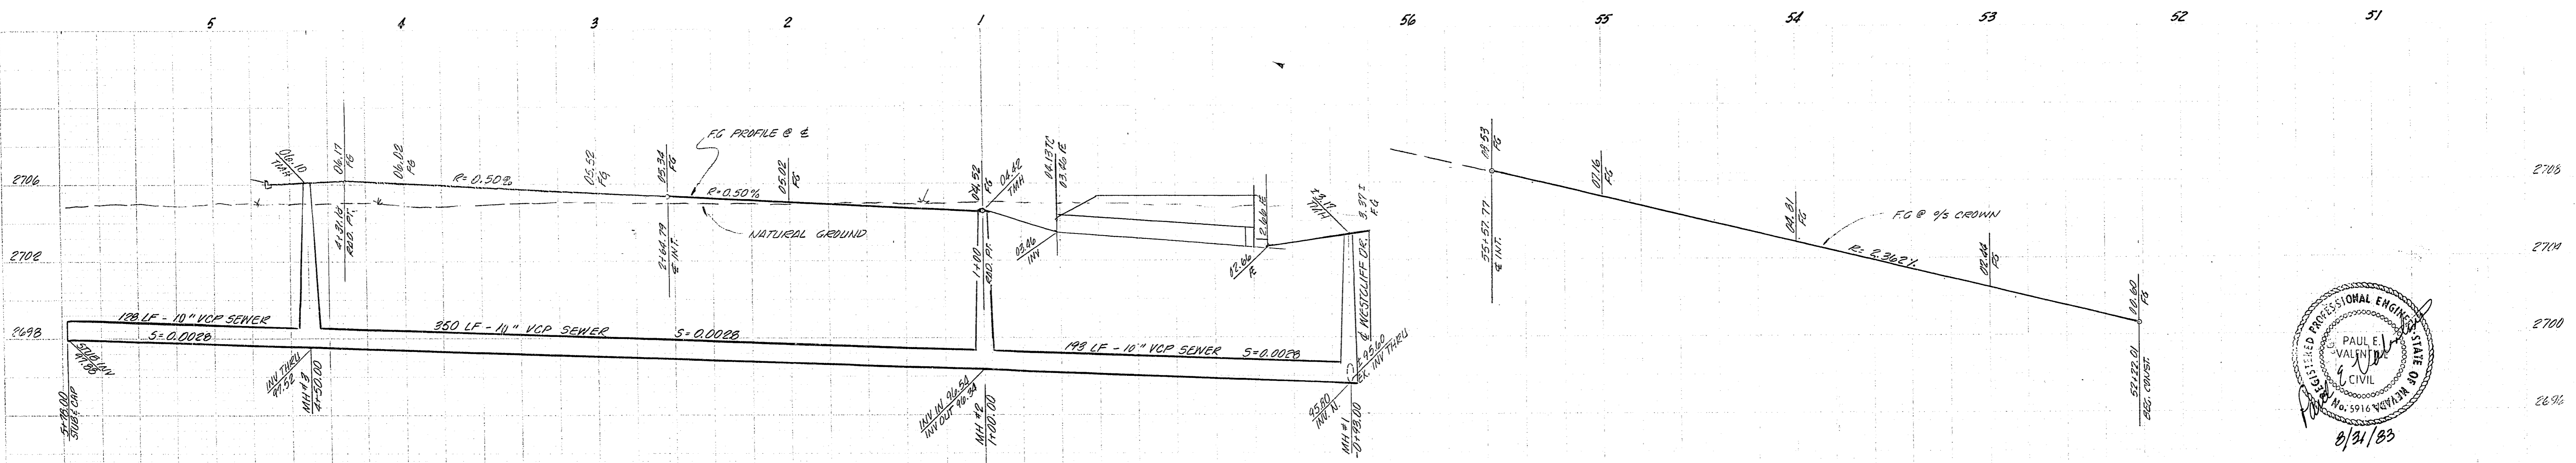

APPROVAL
James B. [Signature] 11/12/83
 CIVIL CHIEF LAND DEVELOPMENT AND FLOOD CONTROL DATE

9-24-84 REVISED GRADING & STORM DRAIN LOCATION
 10-24-84 [Signature]

ENGINEERS & SURVEYORS INCORPORATED		7022 W. CHARLESTON BLVD. LAS VEGAS, NV 89117 PHONE: (702) 363-6415	
WORTHEN ESTATES			
STREET PLAN AND PROFILE:			
WESTCLIFF DR.		WORTHEN CIRCLE	
DRWN. REV	DES. REV	CHKD.	DATE 7/23/83
WO.NO.	H.SCALE 1"=40'	V.SCALE 1"=4'	SHEET 3 OF 7

REV. 10-7-85 RE: DRAIN PIPE SIZE

REV 9/24/84

7-9-83 1078-3365