



**TENAYA WAY (PUBLIC)
PLAN**

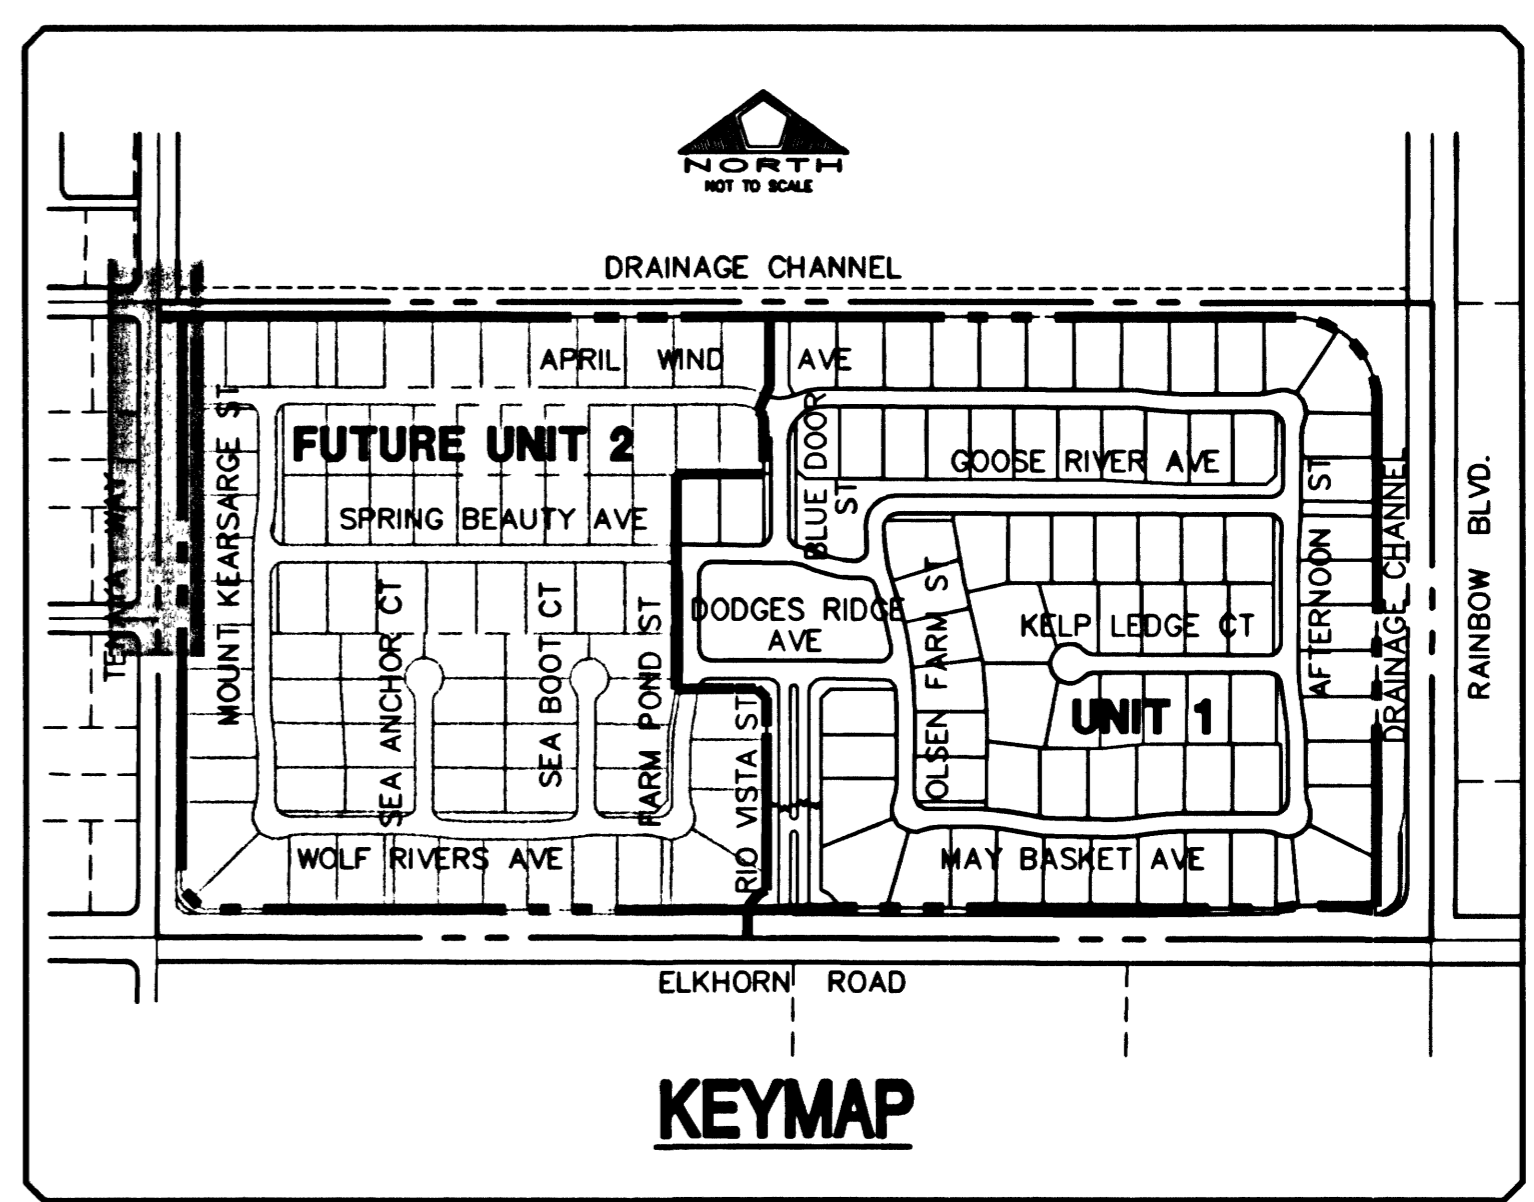


KEYMAP

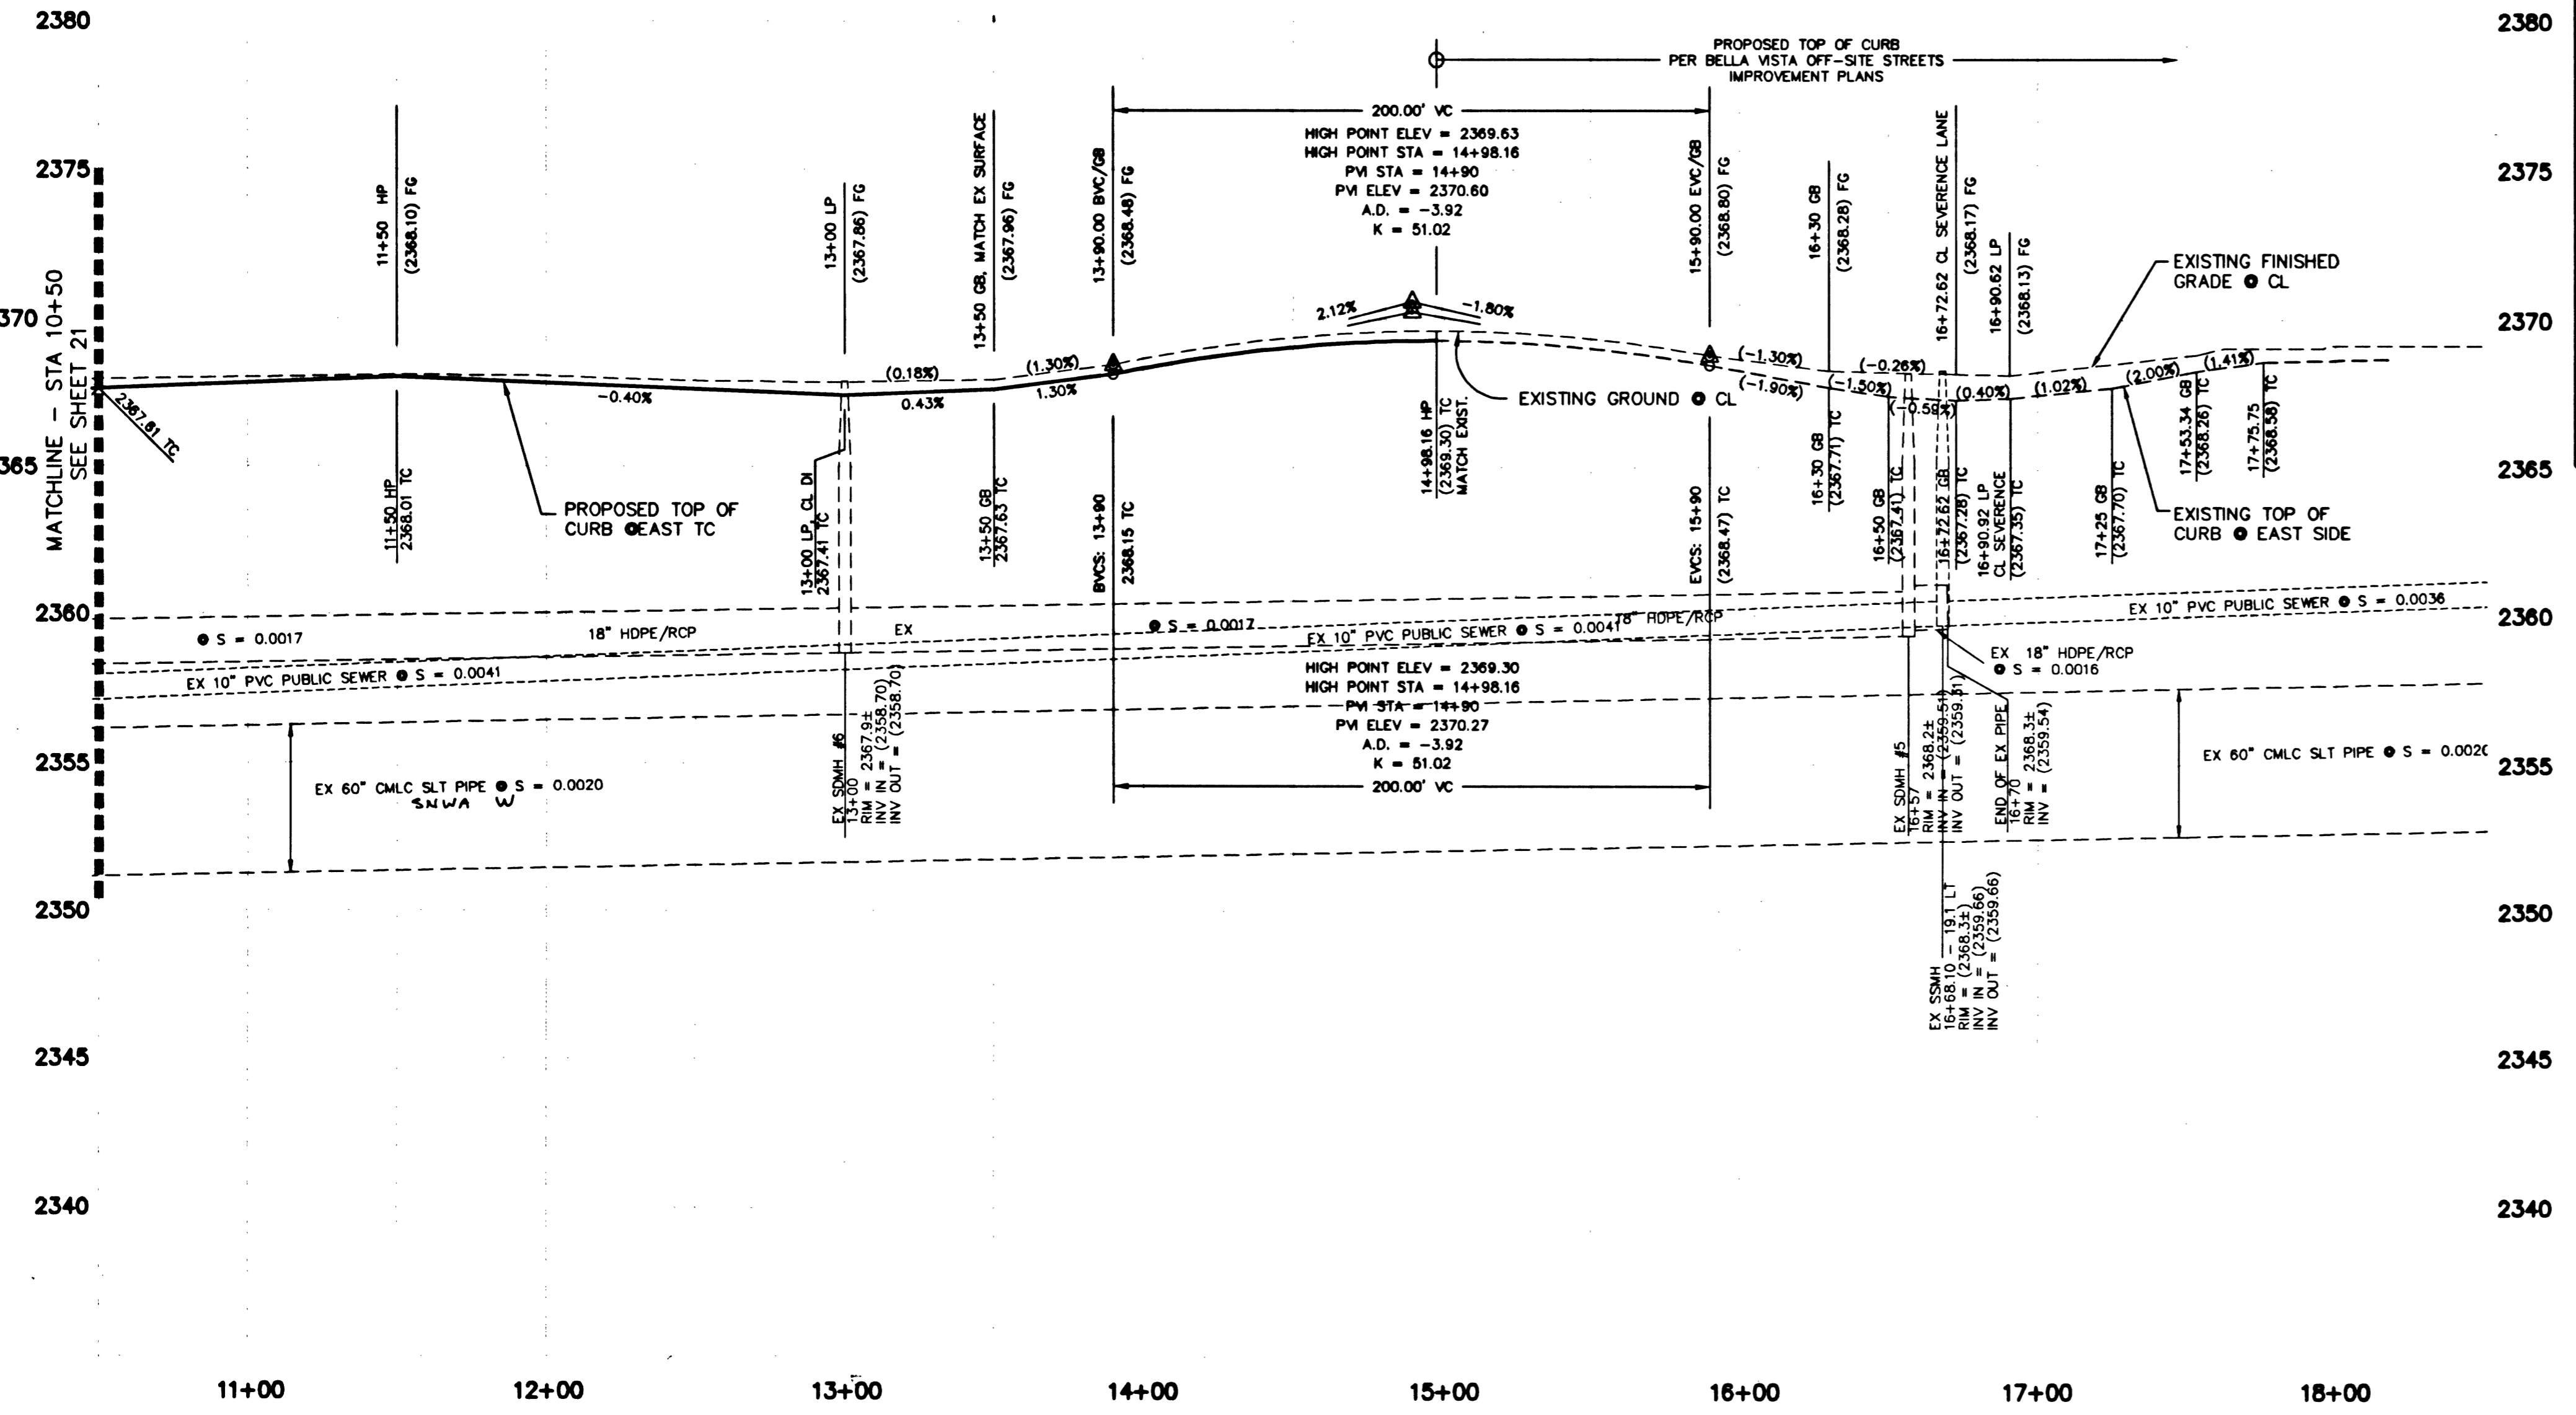


**TENAYA WAY (PUBLIC)
PROFILE**

SCALE: HORIZ. 1" = 40'
VERT. 1" = 4'

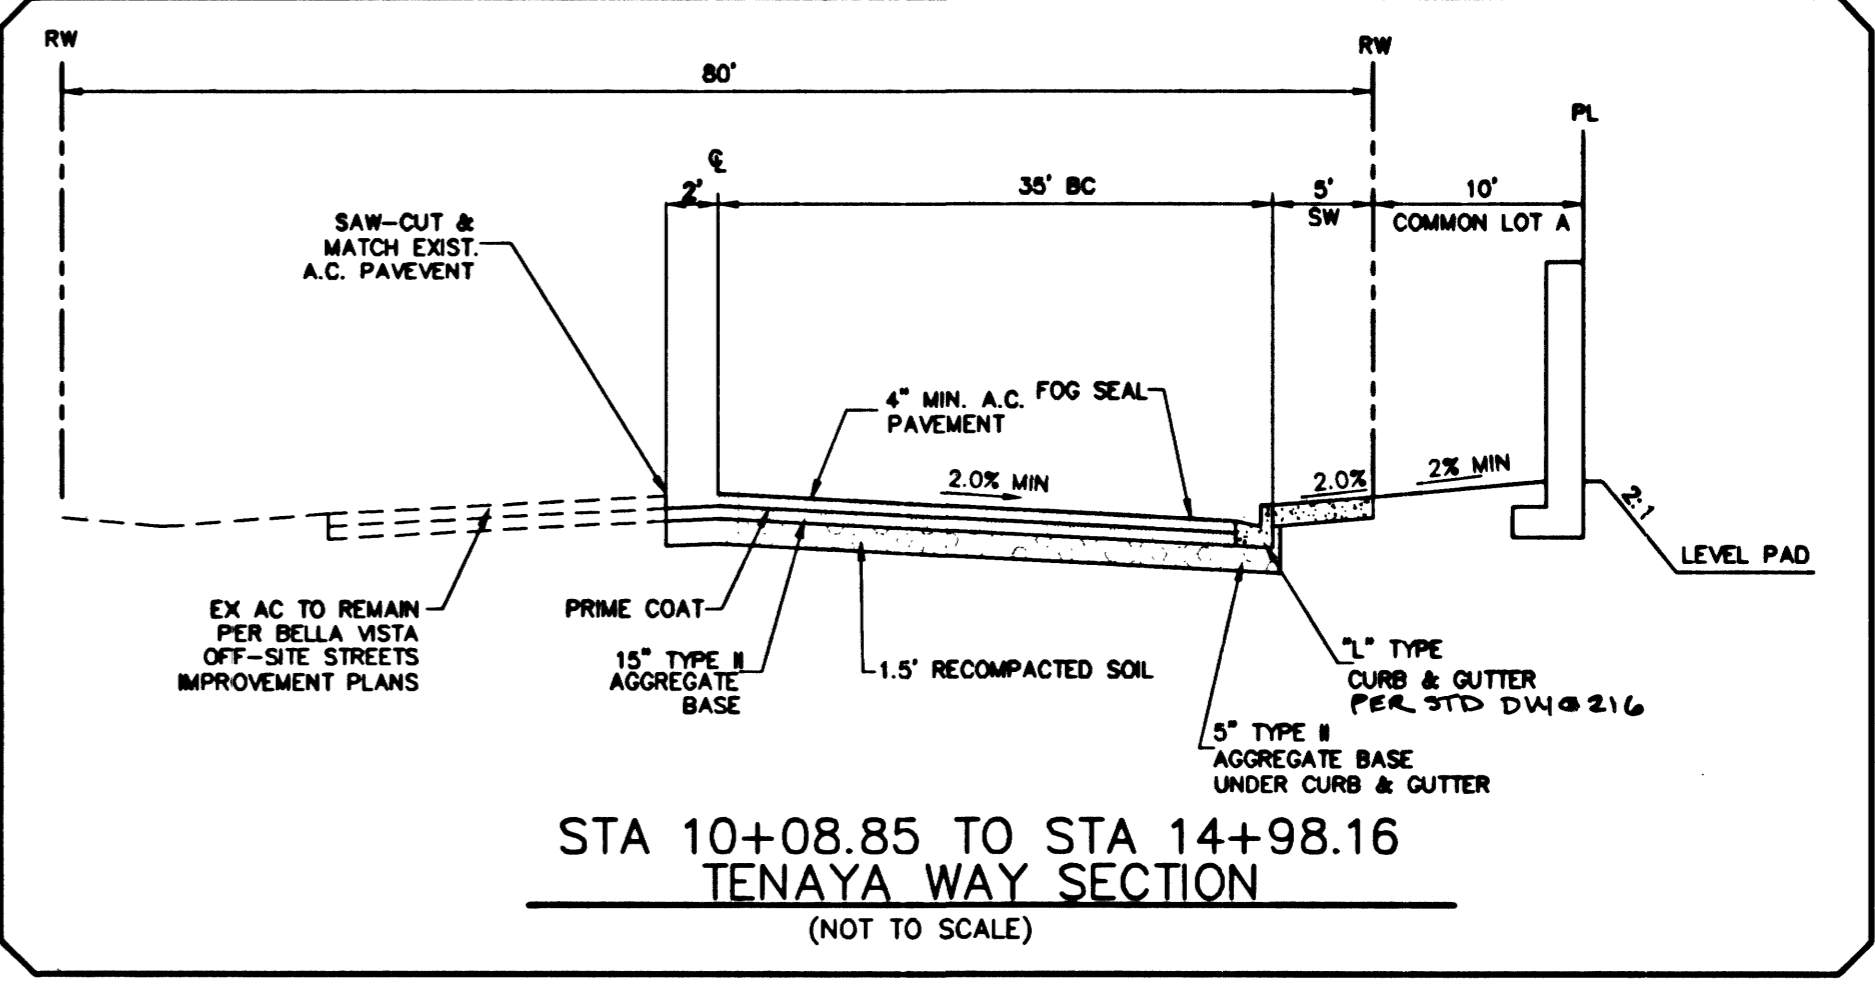

**STA 10+08.85 TO STA 14+98.16
TENAYA WAY SECTION
(NOT TO SCALE)**

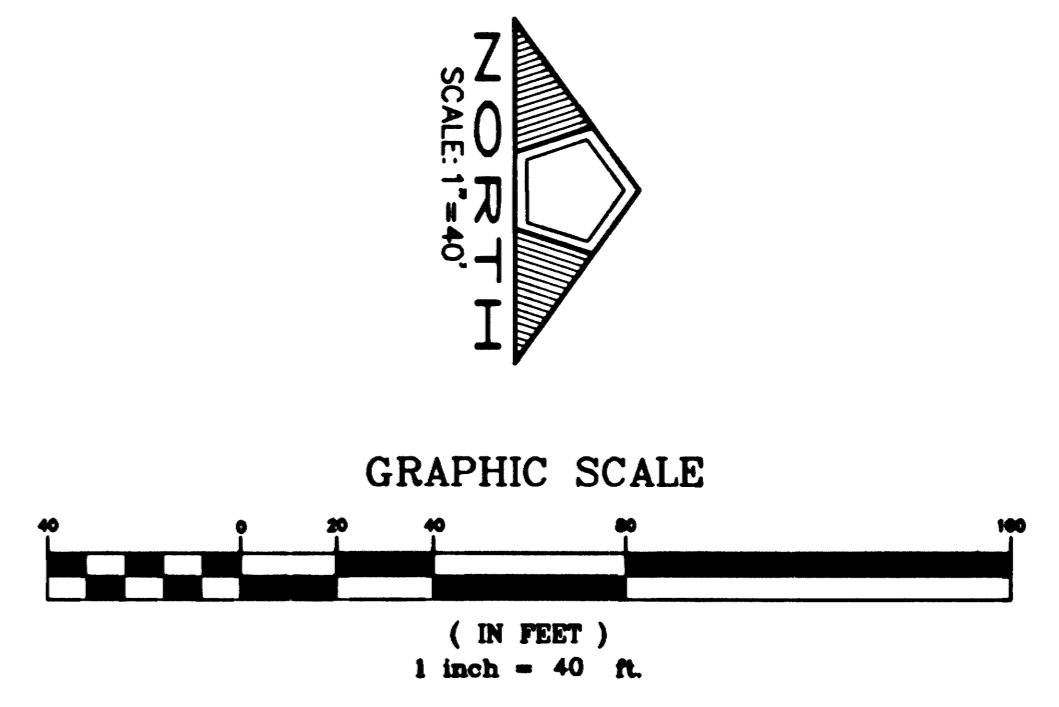

BENCHMARK
CITY OF LAS VEGAS BENCHMARK NO. 1LV90 115WS.
RIVET AND PLATE IN TOP OF CURB, SOUTH SIDE OF
RAINBOW BLVD. AND FLANAGAN DRIVE, 200' NORTH
OF GRAND TETON DRIVE.
ELEVATION: = 724.3622 METERS (N.A.V.D. 88)
ELEVATION: = 2376.512 U.S. FEET
(CALCULATED N.A.V.D. 88)

BASIS OF BEARING
THE BASIS OF BEARING FOR THIS SURVEY IS THE WEST LINE OF THE SOUTHEAST QUARTER
(SE 1/4) OF SECTION 15, TOWNSHIP 19 SOUTH, RANGE 60 EAST, M.D.M., CLARK COUNTY,
NEVADA, AS SHOWN IN FILE 115, PAGE 13 OF OFFICIAL RECORDS, CLARK COUNTY, NEVADA,
I.E. NORTH 001°55' EAST

Avoid hitting overhead
power lines. It's costly.
**Call
before you do
Overhead**
1-702-593-6111

Avoid cutting underground
utility lines. It's costly.
**Call
before you
Dig.**
1-800-227-2600

| | | | |
|-----|-------------|------|--------|
| NO. | DESCRIPTION | DATE | APP'D. |
| | | | |
| | | | |
| | | | |

PULTE HOMES
1635 VILLAGE CENTER CIRCLE, SUITE 250
LAS VEGAS, NEVADA 89134
(702) 256-7800

PENTACORE
CIVIL ENGINEERING, LAND SURVEYING, PLANNING
CONSULTING
605 WEST CHARLESTON BOULEVARD
LAS VEGAS, NEVADA 89146 (702) 256-0115

**TENAYA WAY
STA 10+50.00 TO STA 16+72.62
PLAN AND PROFILE**

**WYETH RANCH
UNIT 1**

| | |
|--------------|----------|
| DATE: | 11/20 |
| DESIGNED BY: | |
| CHECKED BY: | |
| JOB NO.: | 01470231 |
| SCALE: | 1"=40' |

PROFESSIONAL ENGINEER - STATE OF NEVADA
RICHARD P. SENECA
CIVIL
11752

SHEET **22** OF 41

CL.V. DWG.# 1078-4699