
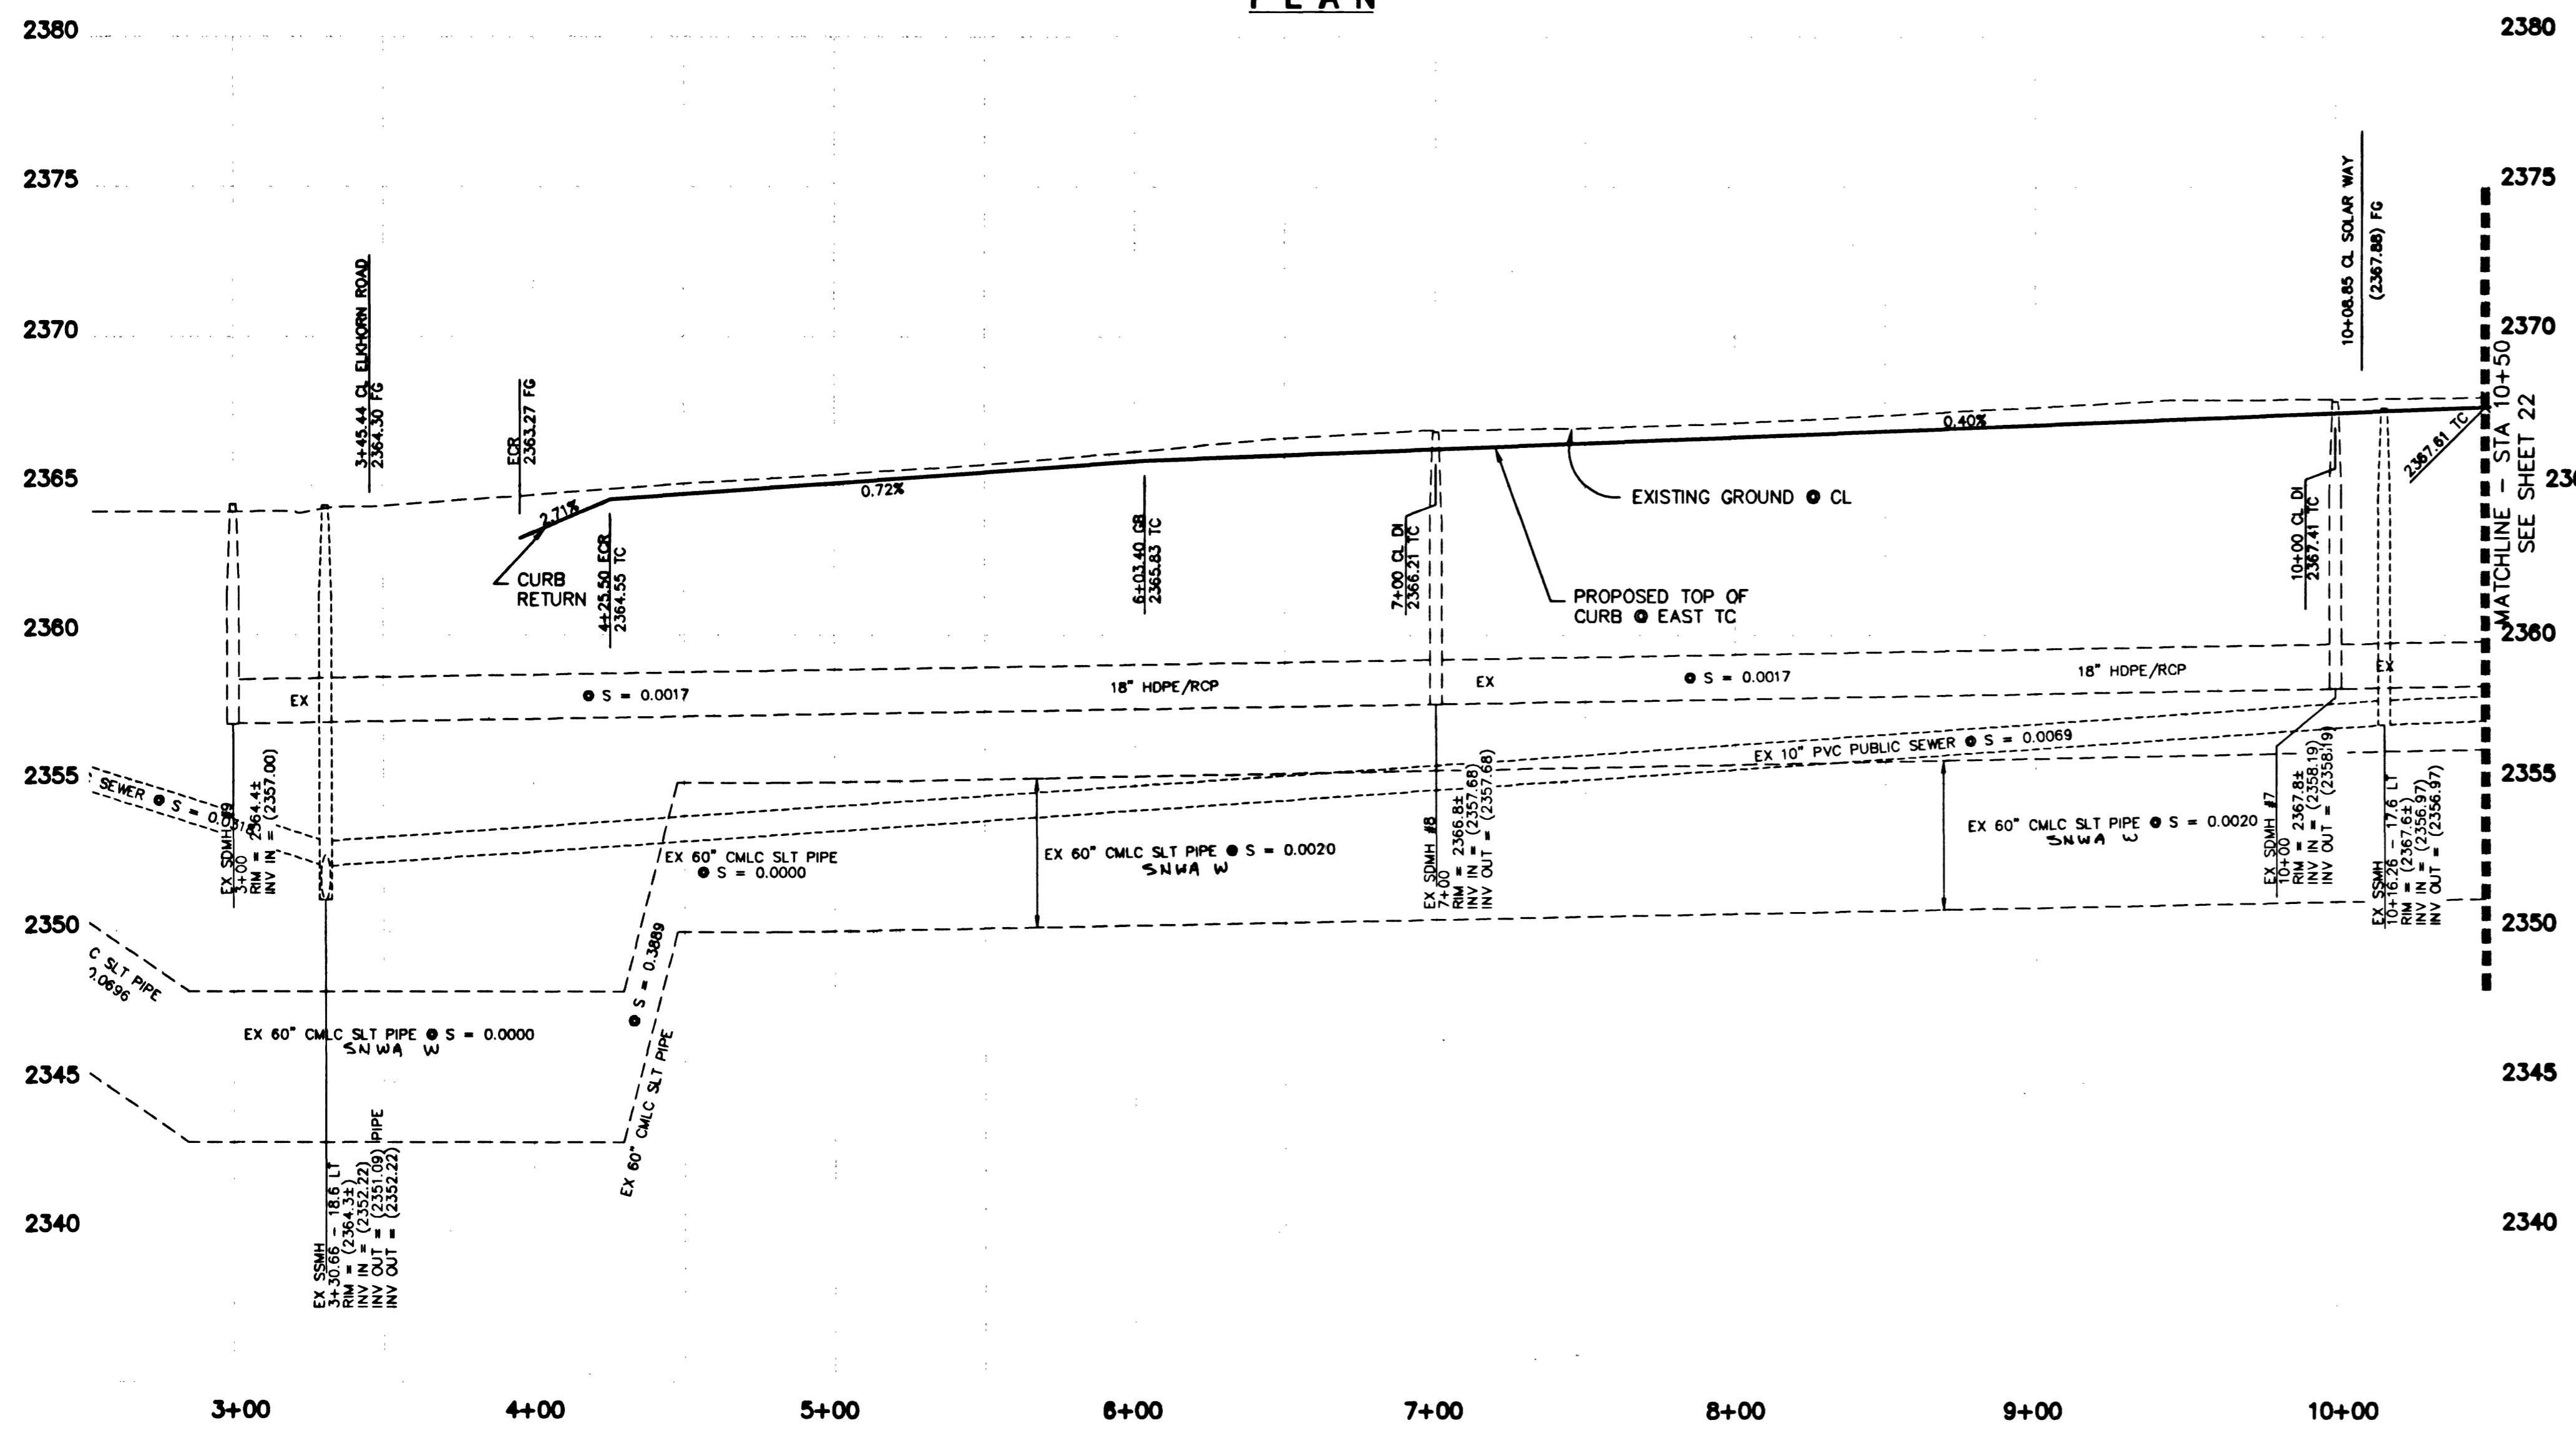
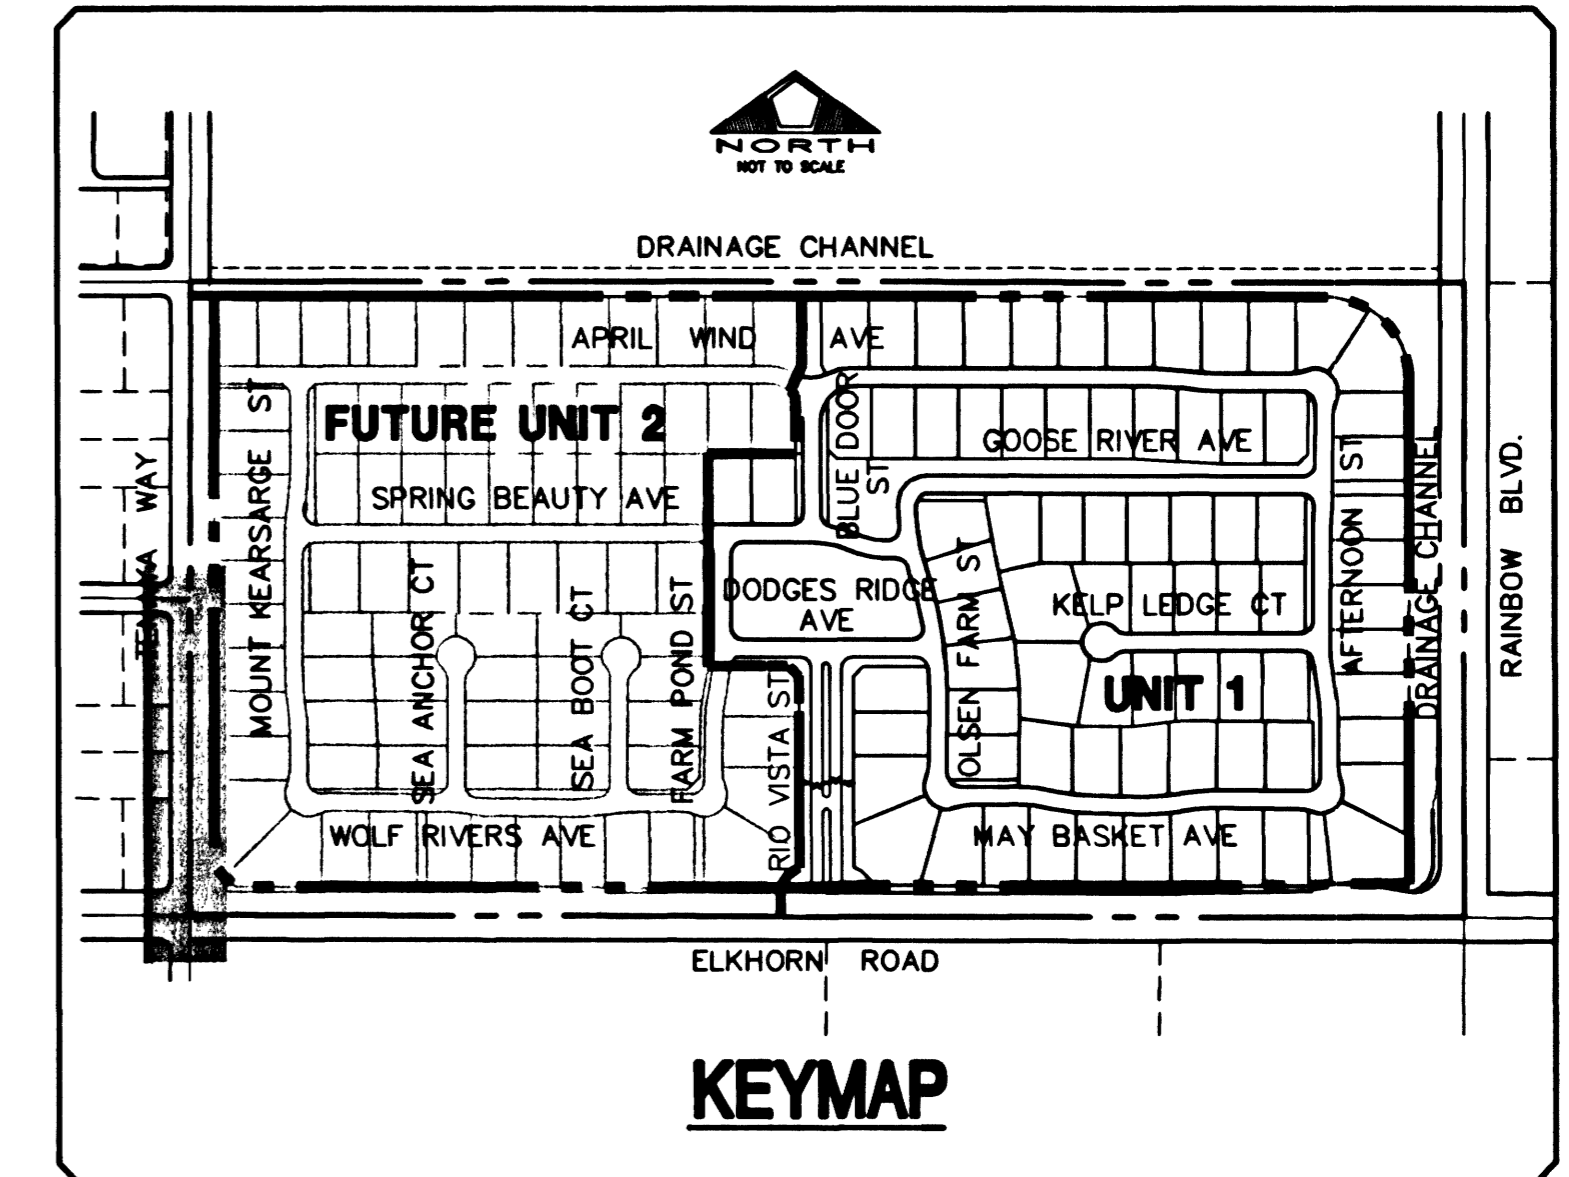





TENAYA WAY (PUBLIC) PLAN

Back Curb Curve Table			
No.	Radius	Delta	Tangent
C1	30.00'	90°03'16"	47.13'
			30.03'

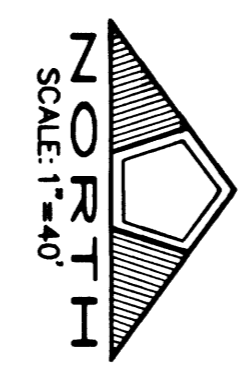

TENAYA WAY (PUBLIC) PROFILE

SCALE: HORIZ. 1" = 40'
VERT. 1" = 4'

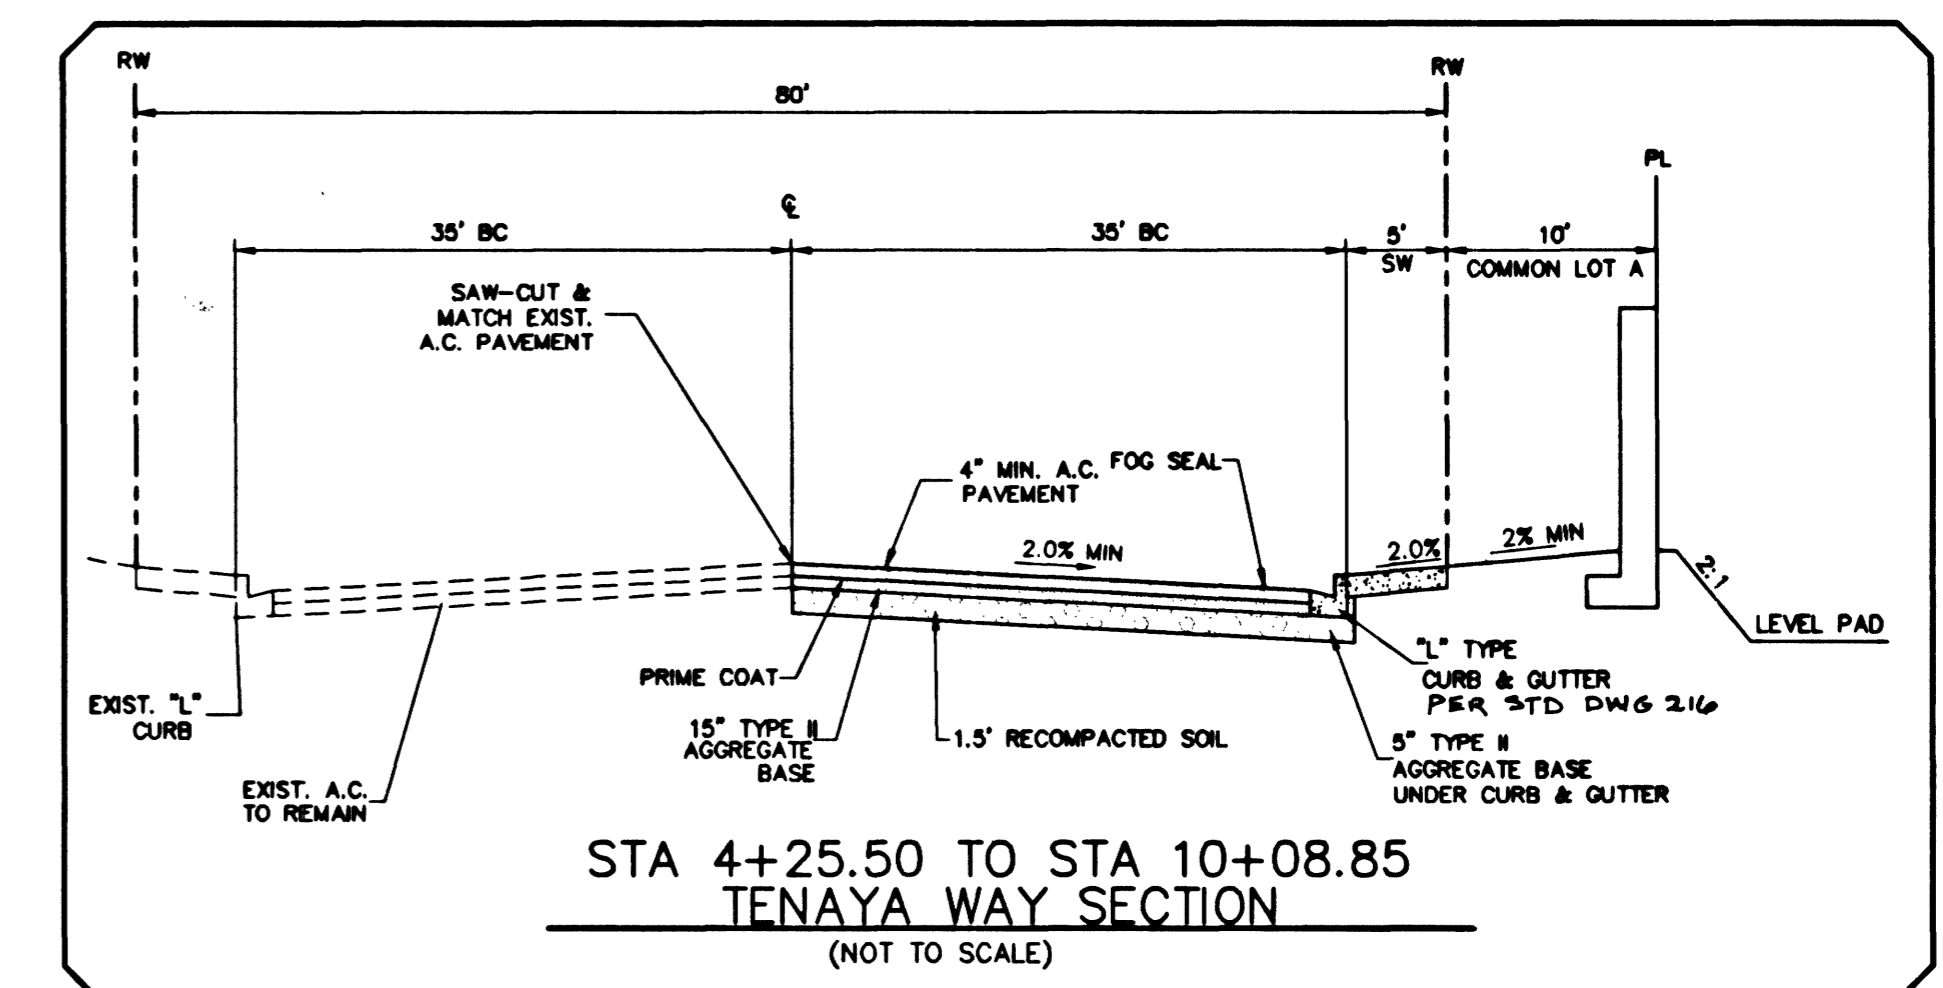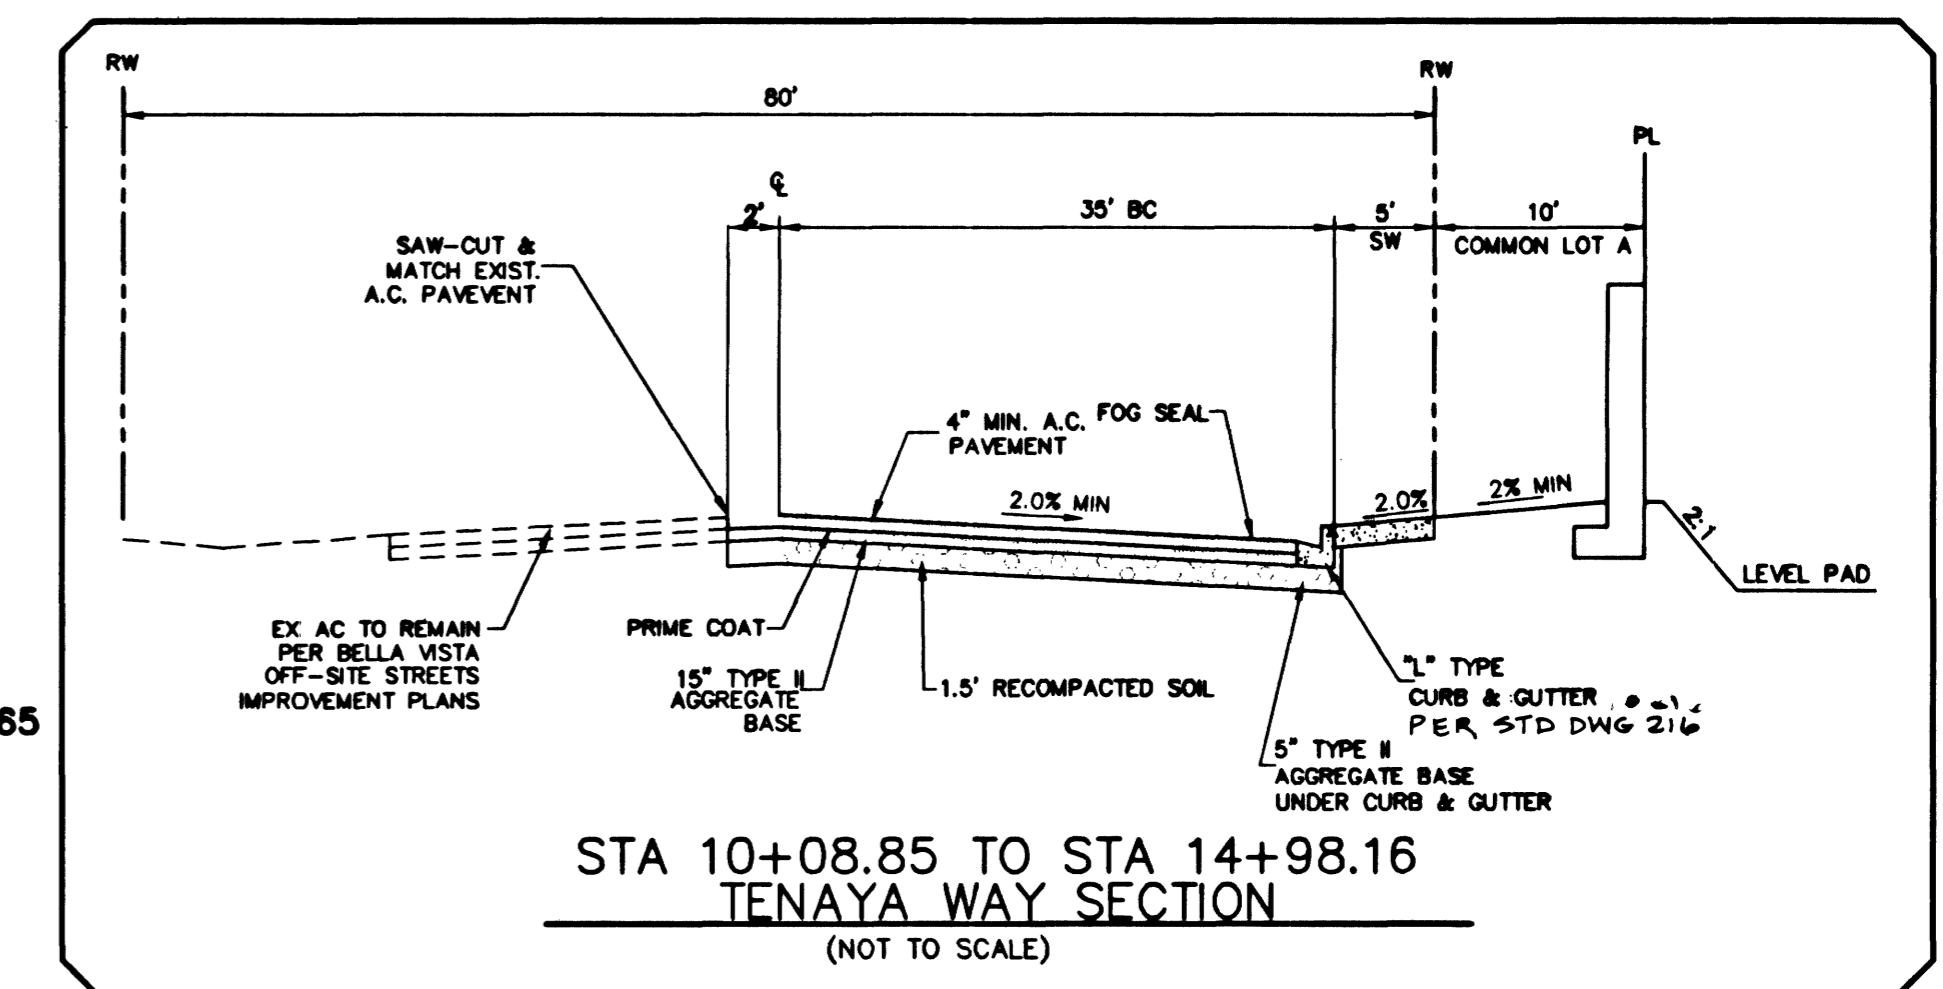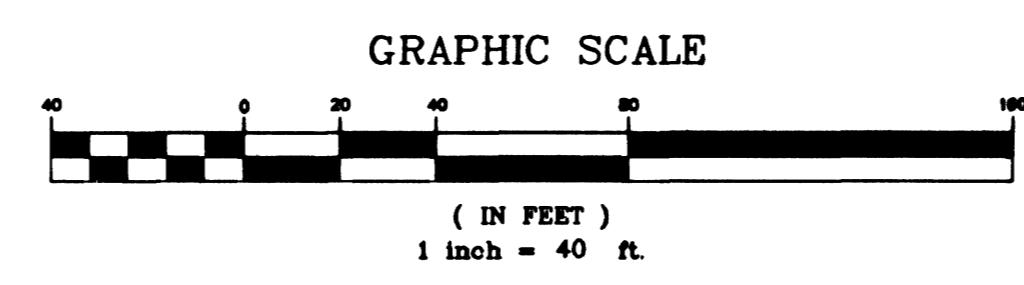

BENCHMARK
CITY OF LAS VEGAS BENCHMARK NO. 11V90 11SWS.
RIVET AND PLATE IN TOP OF CURB, SOUTH SIDE OF
RAINBOW BLVD. AND FLANAGAN DRIVE, 200' NORTH
OF GRAND TETON DRIVE.
ELEVATION: = 724.3622 METERS (N.A.V.D. 88)
ELEVATION: = 2376.512 U.S. FEET
(CALCULATED N.A.V.D. 88)

BASIS OF BEARING
THE BASIS OF BEARING FOR THIS SURVEY IS THE WEST LINE OF THE SOUTHEAST QUARTER
(SE 1/4) OF SECTION 15, TOWNSHIP 19 SOUTH, RANGE 50 EAST, M.D.M., CLARK COUNTY,
NEVADA, AS SHOWN IN FILE 115, PAGE 13 OF OFFICIAL RECORDS, CLARK COUNTY, NEVADA,
I.E. NORTH 00°11'55" EAST

Avoid hitting overhead power lines. It's costly.
Call before you do Overhead
1-702-593-6111

Avoid cutting underground utility lines. It's costly.
Call before you Dig.
1-800-227-2600

NO.	DESCRIPTION	DATE	APP'D


PULTE HOMES
1635 VILLAGE CENTER CIRCLE, SUITE 250
LAS VEGAS, NEVADA 89134
(702) 256-7900

PENTACORE
CIVIL ENGINEERING AND SURVEYING
6783 WEST CHARLESTON BOULEVARD
LAS VEGAS, NEVADA 89146 (702)266-0115

**TENAYA WAY
STA 3+45.44 TO STA 10+50.00
PLAN AND PROFILE**

**WYETH RANCH
UNIT 1**

DATE: 11/01	SCALE: 1"=40'
PM: [Signature]	
DRAWN BY: [Signature]	
DESIGNED BY: [Signature]	
CHECKED BY: [Signature]	
ADA CHECKED: [Signature]	
JOB NO.: 0147.0231	

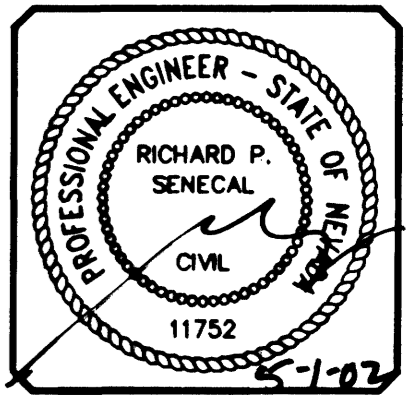

SHEET **21** OF 41
C.L.V. DWG.#

W:\Active\08147029\Drawings\Unit 1 plans\01-pp013.DWG: ebeberger Wed, 01 May 2002 - 4:17pm

41491

107Y-7699