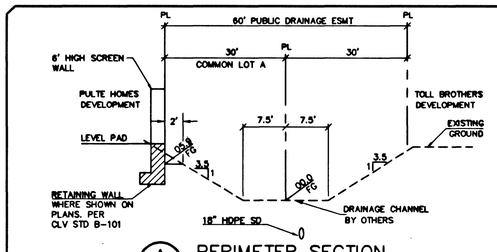

A/7 PERIMETER SECTION
NOT TO SCALE

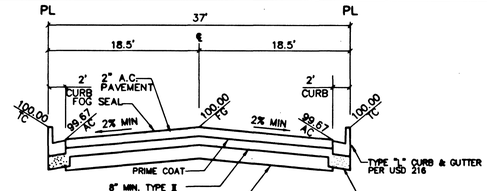

B/7 TYPICAL INTERIOR STREET SECTION (PRIVATE)
NOT TO SCALE

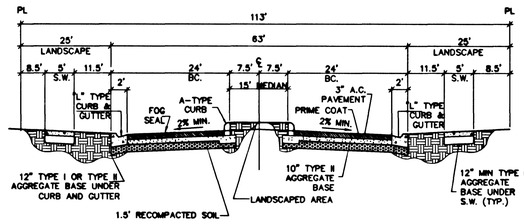

C/7 GATED PRIVATE ENTRY STREET SECTION
(NOT TO SCALE)

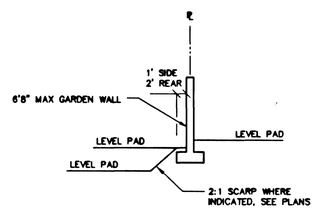

NOTE:
WALL TO BE CONSTRUCTED PER SEPARATE BLOCK WALL PLANS.

D/7 SIDE AND REAR YARD SECTION
(NOT TO SCALE)

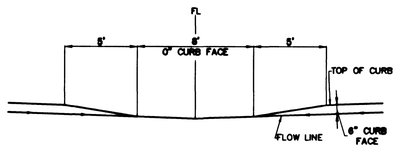

TYPICAL DEPRESSED CURB SECTION
(NOT TO SCALE)

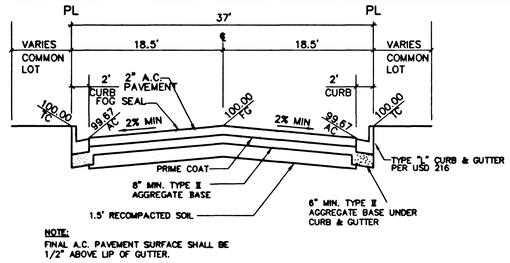

J/7 TYPICAL INTERIOR STREET SECTION (PRIVATE) W/ COMMON LOT
NOT TO SCALE

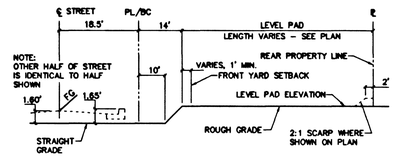

K/7 TYPICAL STREET ROUGH GRADE SECTION
(NOT TO SCALE)

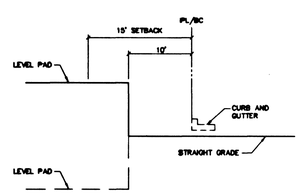

L/7 TYPICAL CORNER LOT ROUGH GRADE SECTION (NOT TO SCALE)

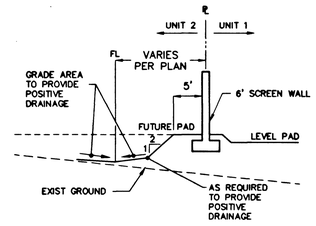

N/7 PERIMETER SECTION
(NOT TO SCALE)

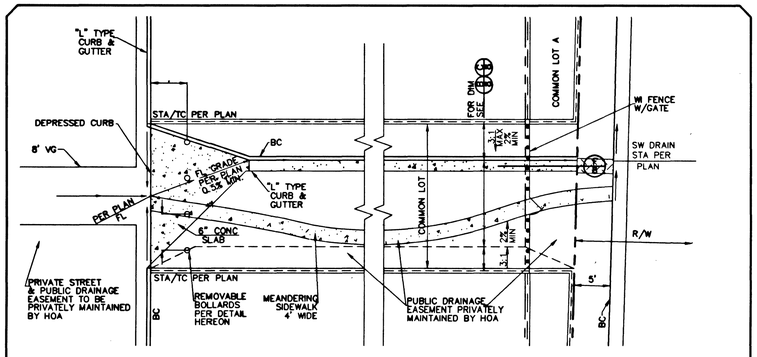

TYPICAL DRAINAGE EASEMENT DETAIL
SCALE: 1" = 10'

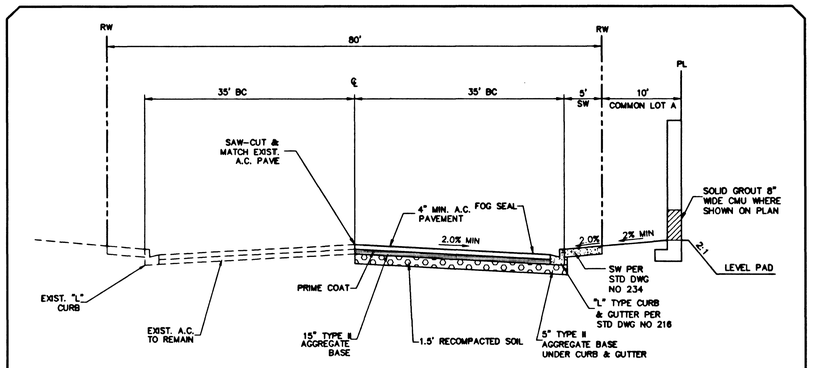

G/7 TENAYA WAY
(NOT TO SCALE)

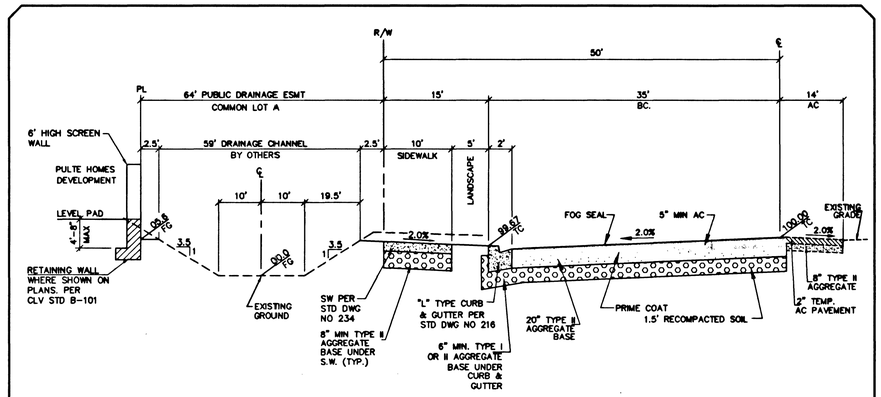

H/7 RAINBOW BLVD SECTION
(NOT TO SCALE)

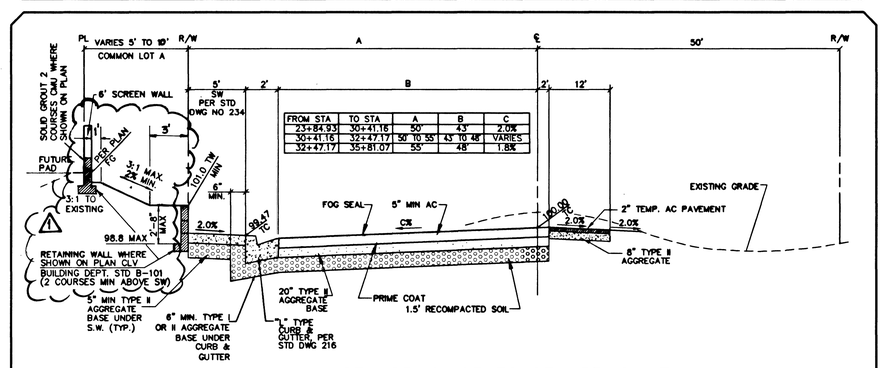

I/7 STA 23+84.93 TO STA 35+81.07 ELKHORN ROAD SECTION
(NOT TO SCALE)

NO.	DESCRIPTION	DATE	APPD.
1	ADDED RETAINING WALL TO SECTION I	11/19/01	RPS

PULTE HOMES
1635 VILLAGE CENTER CIRCLE, SUITE 250
LAS VEGAS, NEVADA 89134
(702) 256-7900

PENTACORE
CIVIL ENGINEERING · LAND SURVEYING · PLANNING
CONSTRUCTION MANAGEMENT · CONSULTING
5795 W. SUNSET ROAD, SUITE 1 BOULEVARD
LAS VEGAS, NEVADA 89146 (702)258-0115

GRADING SECTIONS AND DETAILS 1

WYETH RANCH UNIT 1

DATE : 11/19/01
PM : SLY
DRAWN BY :
DESIGNED BY :
CHECKED BY :
ADA CHECKED :
JOB NO. : 0147.0230
SCALE : 1" = 40'

PROFESSIONAL ENGINEER - STATE OF NEVADA
RICHARD P. SENECAL
CIVIL
11752
11-6-02

SHEET 7 OF 41

C.L.V. DWG.# 107Y-4699

W:\Active\98147028\Drawings\unit 1 plans\01-G01.dwg menecal Mon, 06 May 2002 - 3:21pm

41477 44908