



**ELKHORN ROAD (PUBLIC)
PLAN**

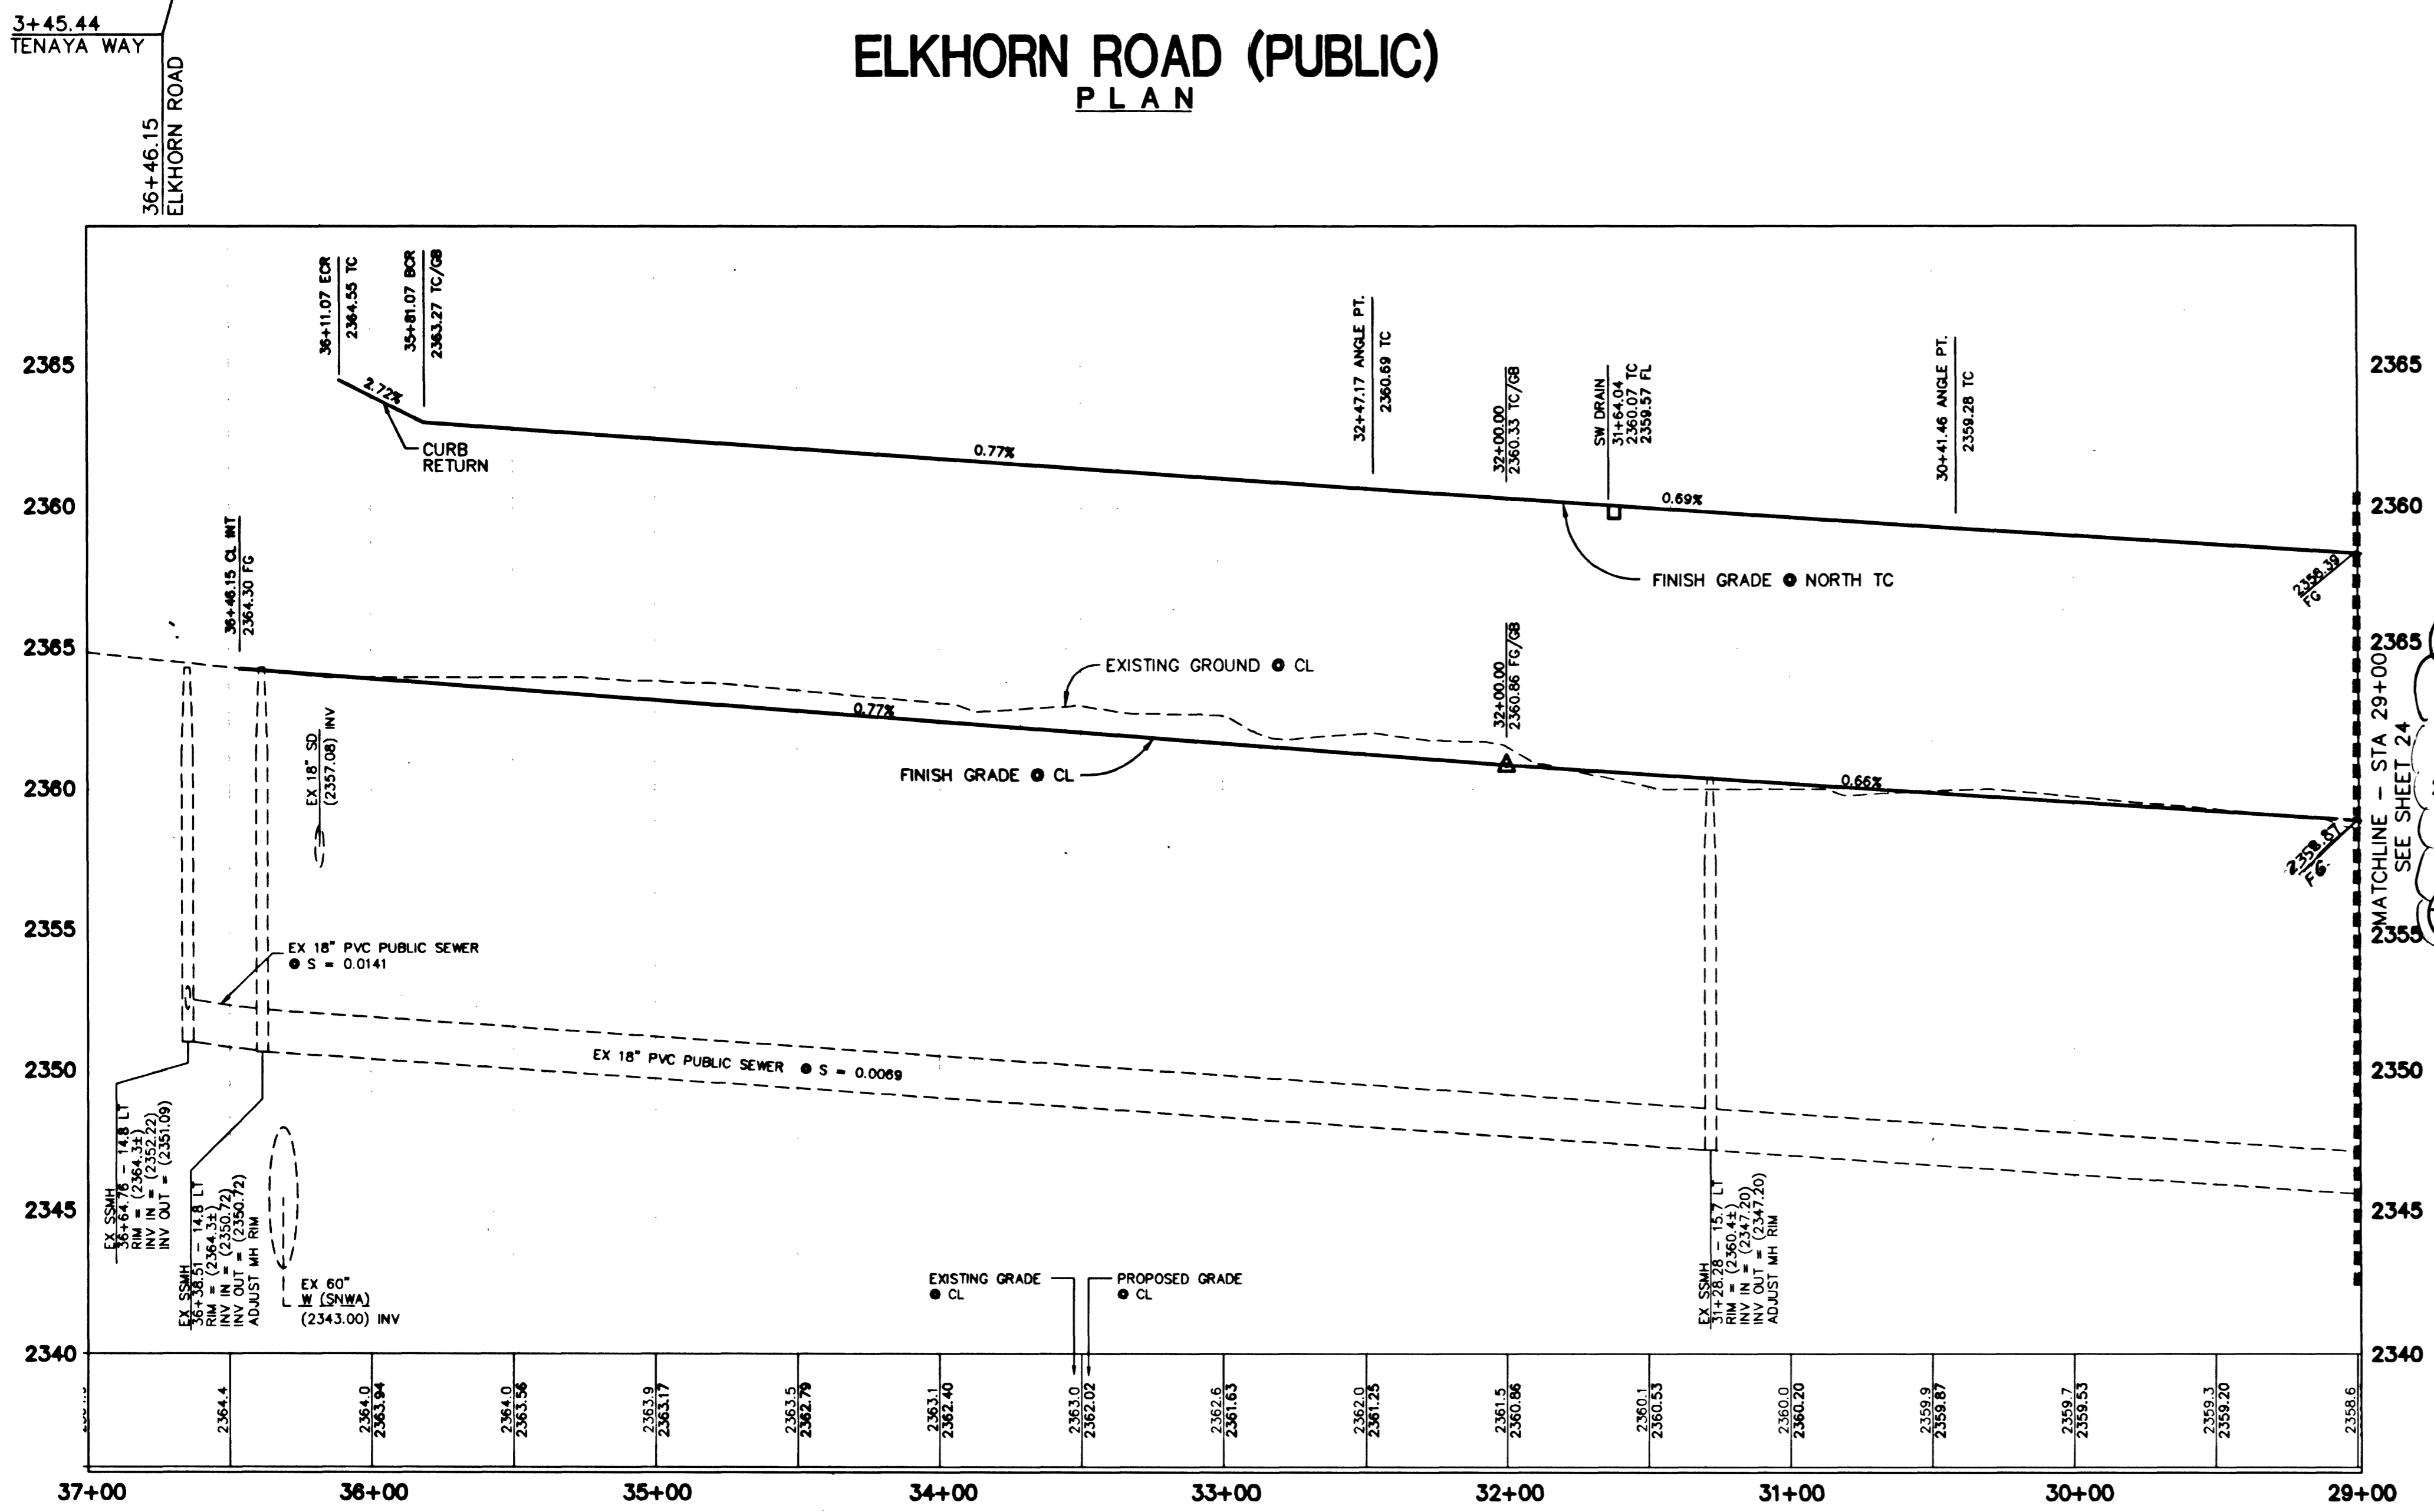


**ELKHORN ROAD (PUBLIC)
PROFILE**



SCALE: HORIZ. 1" = 40'
VERT. 1" = 4'

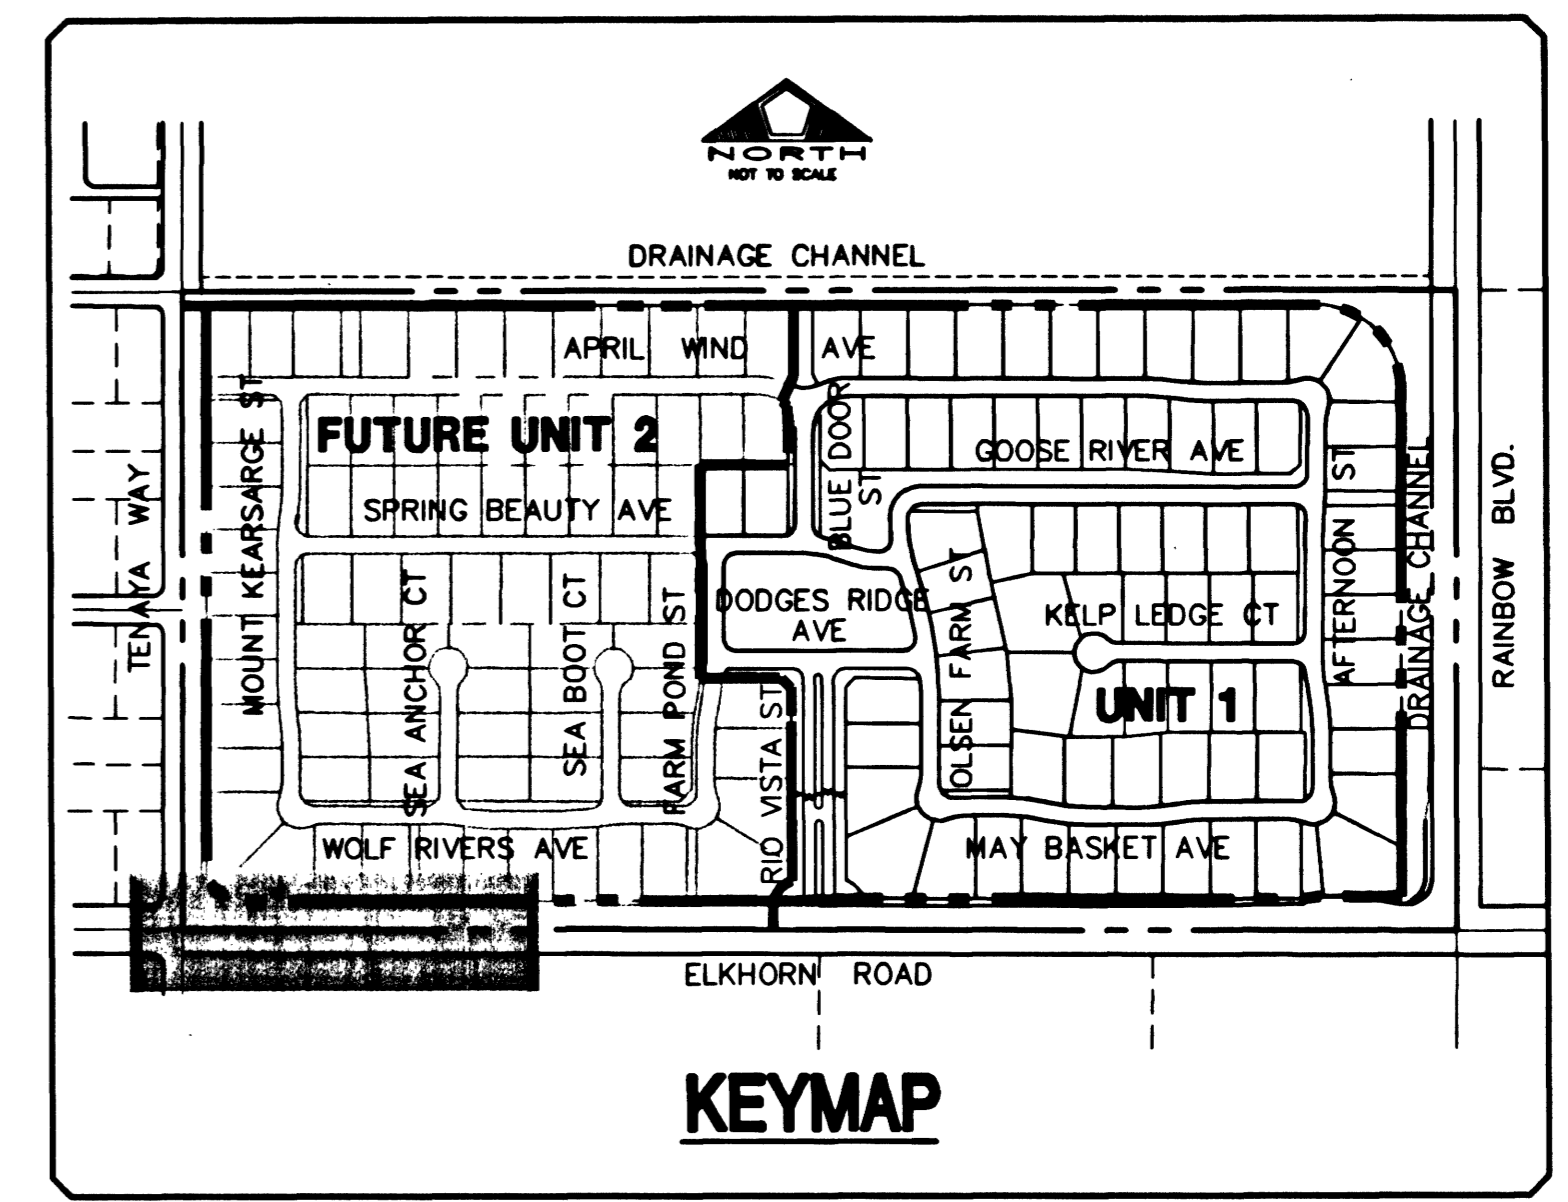

KEYMAP

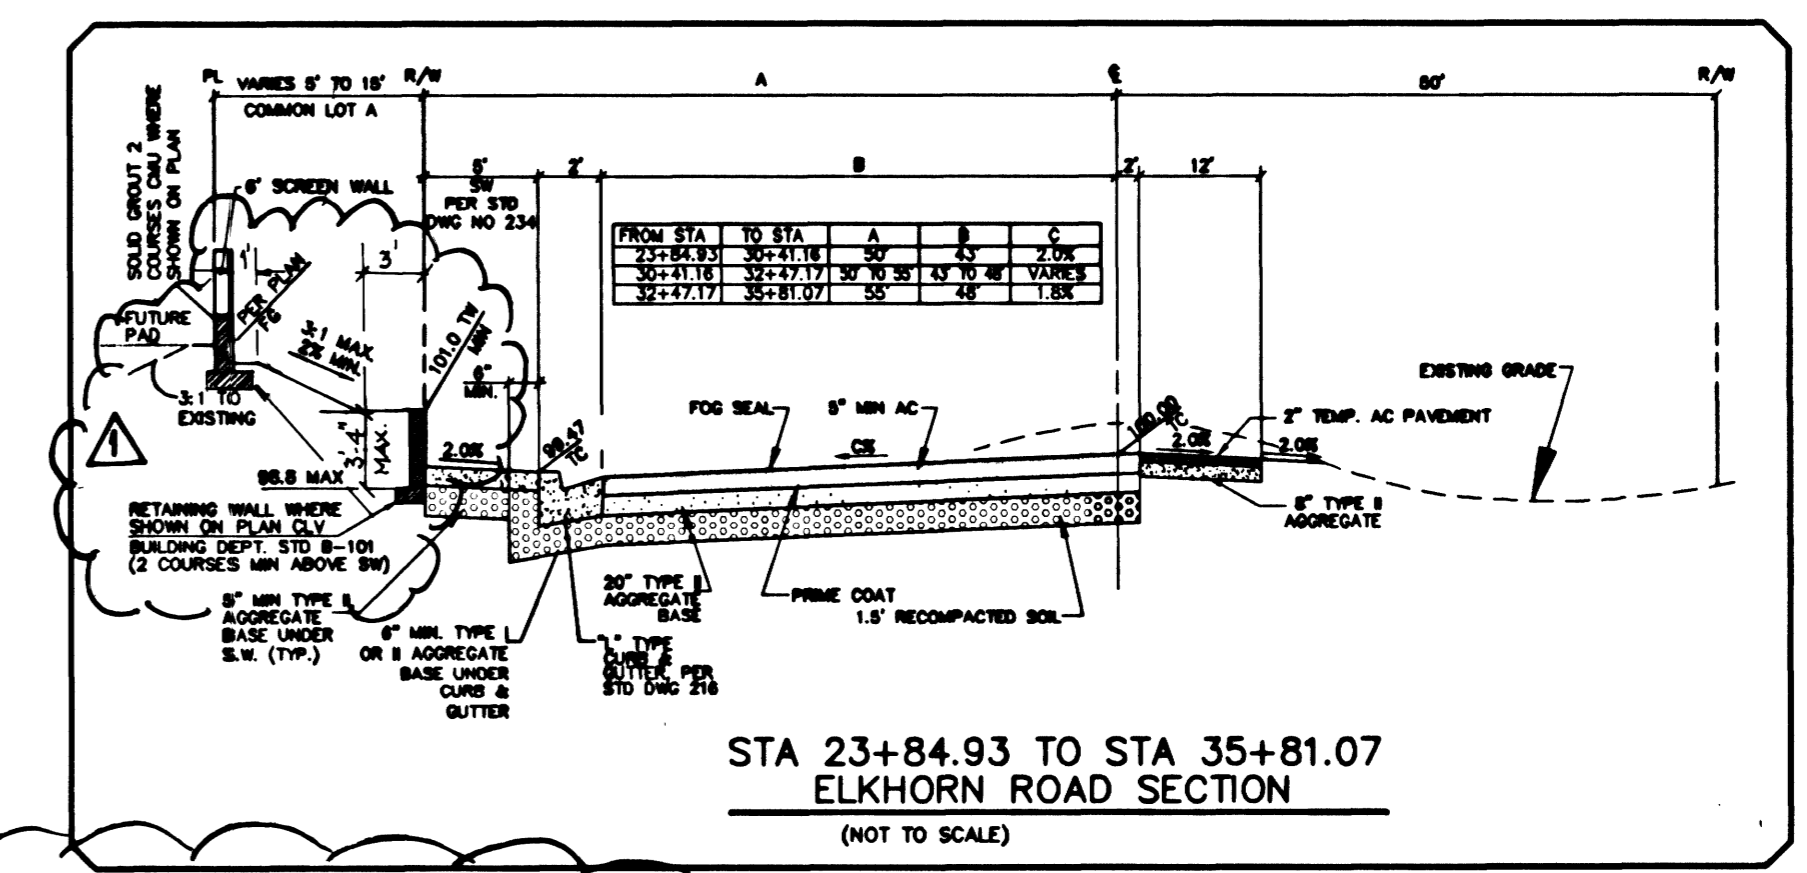

**STA 23+84.93 TO STA 35+81.07
ELKHORN ROAD SECTION
(NOT TO SCALE)**

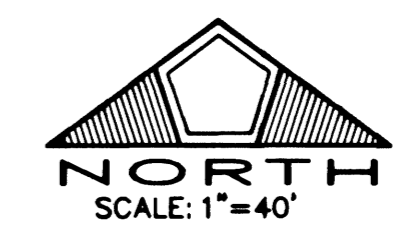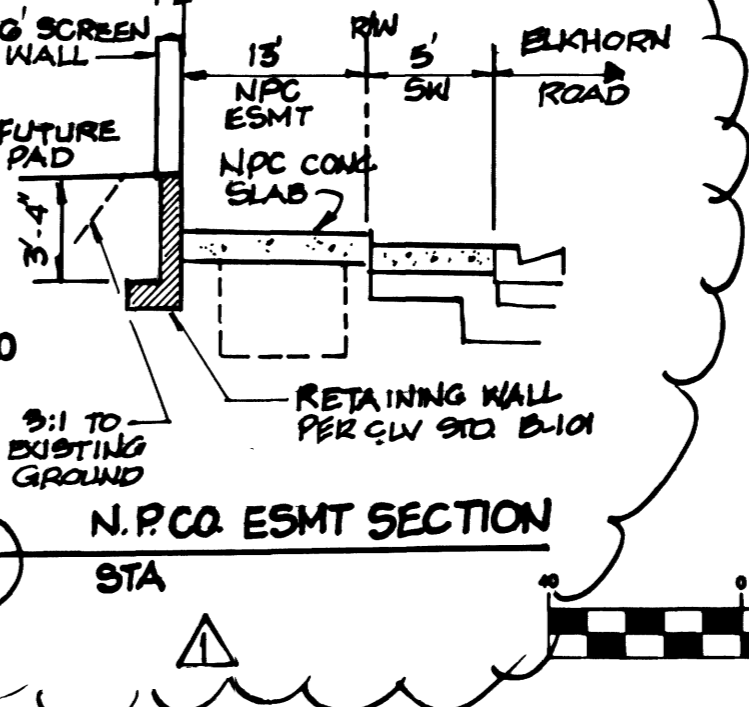

GRAPHIC SCALE
1 inch = 40 ft.

BASIS OF BEARING
THE BASIS OF BEARING FOR THIS SURVEY IS THE WEST LINE OF THE SOUTHEAST QUARTER (SE 1/4) OF SECTION 15, TOWNSHIP 19 SOUTH, RANGE 60 EAST, M.D.M., CLARK COUNTY, NEVADA, AS SHOWN IN FILE 115, PAGE 13 OF OFFICIAL RECORDS, CLARK COUNTY, NEVADA, I.E. NORTH 00°11'55" EAST

BENCHMARK
CITY OF LAS VEGAS BENCHMARK NO. 11V90 115WS. RIVET AND PLATE IN TOP OF CURB, SOUTH SIDE OF RAINBOW BLVD. AND FLANAGAN DRIVE, 200' NORTH OF GRAND TETON DRIVE.
ELEVATION = 724.3622 METERS (N.A.V.D. 88)
ELEVATION = 2376.512 U.S. FEET
(CALCULATED N.A.V.D. 88)

Avoid hitting overhead power lines. It's costly.
Call before you do Overhead
1-702-593-6111

Avoid cutting underground utility lines. It's costly.
Call before you Dig.
1-800-227-2600

NO.	DESCRIPTION	DATE
1	ADDED TOP OF RETAINING WALL, ADDED SECTION A & REVISED THESE SECTIONS	11/26/01


PULTE HOMES
1635 VILLAGE CENTER CIRCLE, SUITE 250
LAS VEGAS, NEVADA 89113
(702) 256-7900

PENTACORE
CIVIL ENGINEERING, LAND SURVEYING, PLANNING
CORPORATION
6793 WEST CHARLESTON BOULEVARD
LAS VEGAS, NEVADA 89148 (702)256-0115

**ELKHORN ROAD
PLAN AND PROFILE**
STA 29+00.00 TO STA 36+46.15

**WYETH RANCH
UNIT 1**

DATE:	11/26/01
DRAWN BY:	
DESIGNED BY:	
CHECKED BY:	
ADA CHECKED:	
JOB NO.:	0147.0231
SCALE:	1" = 40'

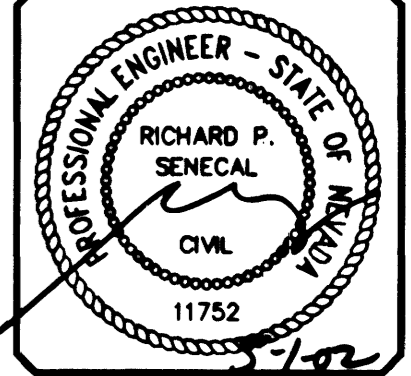

SHEET **23** OF 41
C.L.V. DWG.#

107Y-4699

W:\Active\88147028\Drawings\Unit 1_plans\01-pp015.dwg deaberge Wed, 01 May 2002 - 4:24pm

41493
44910