

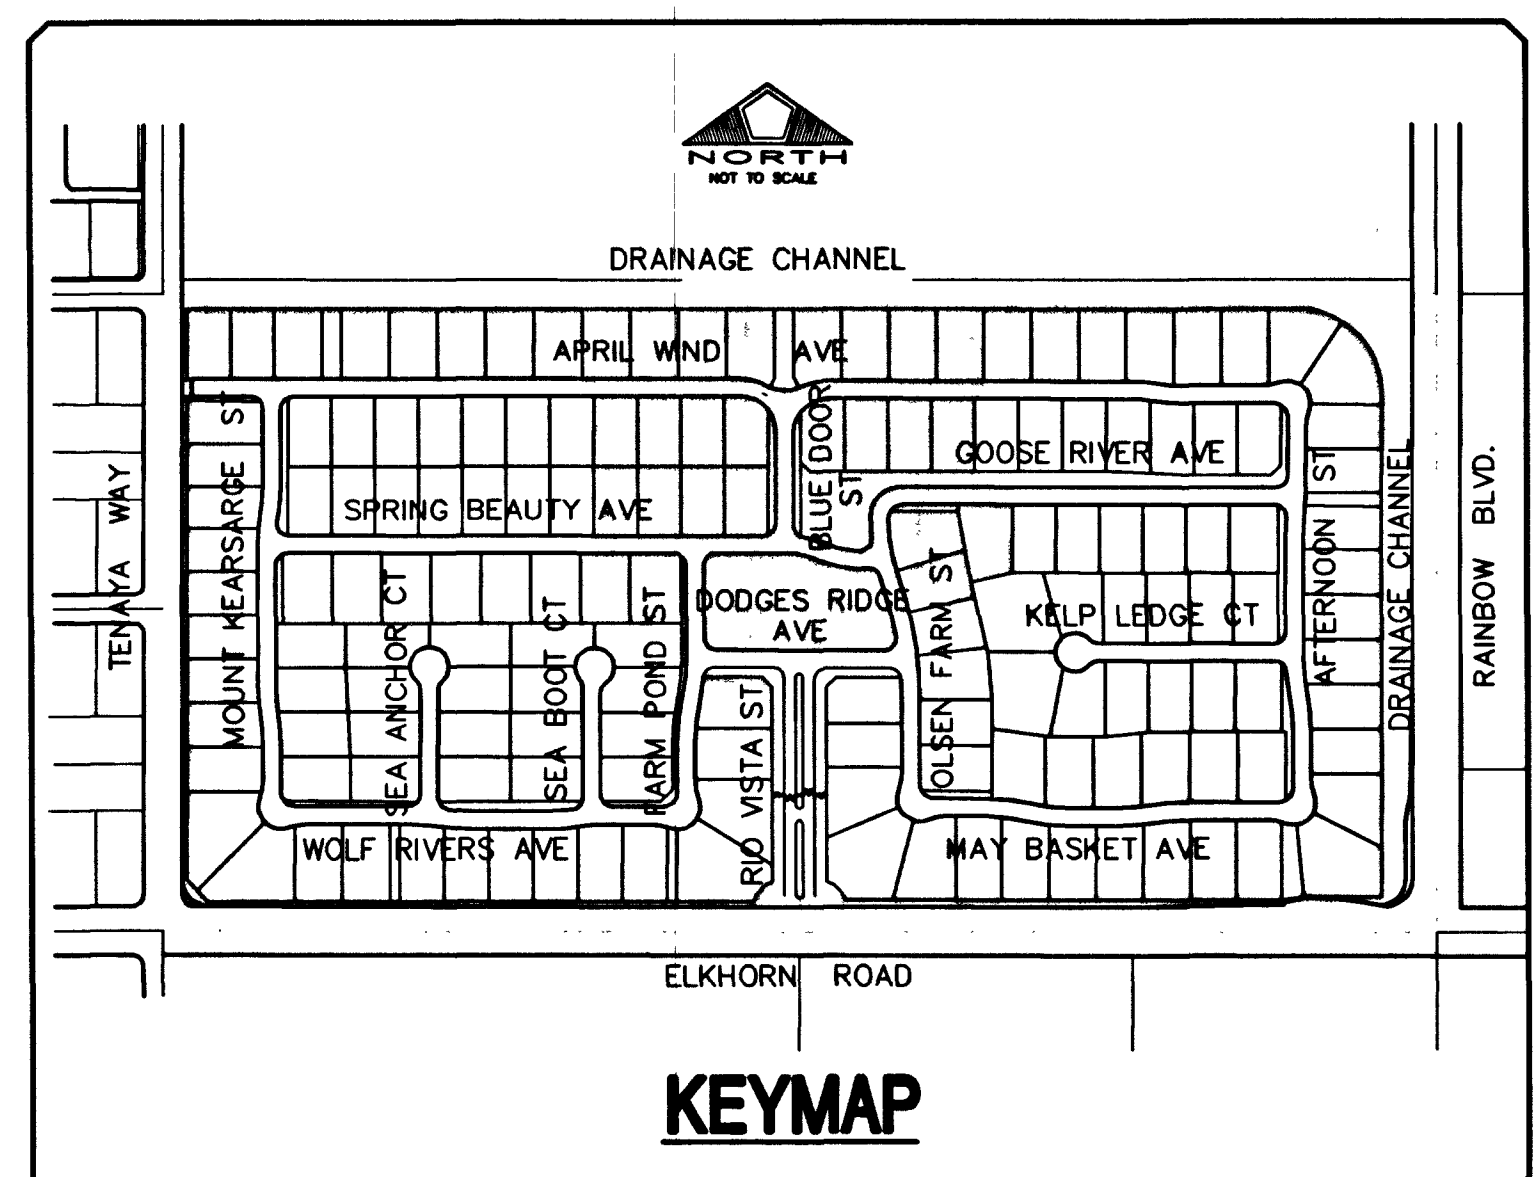
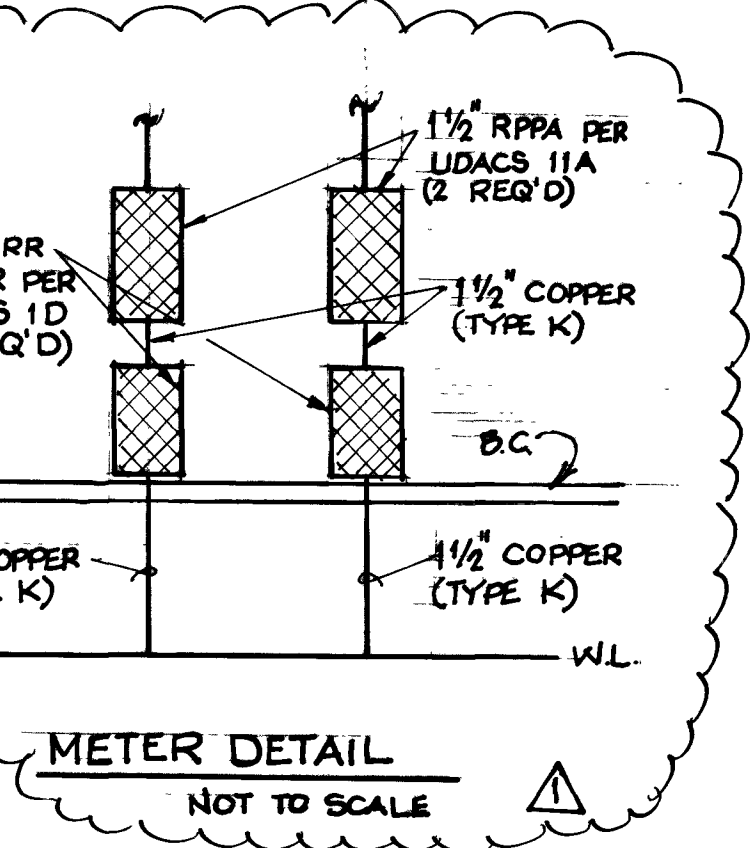
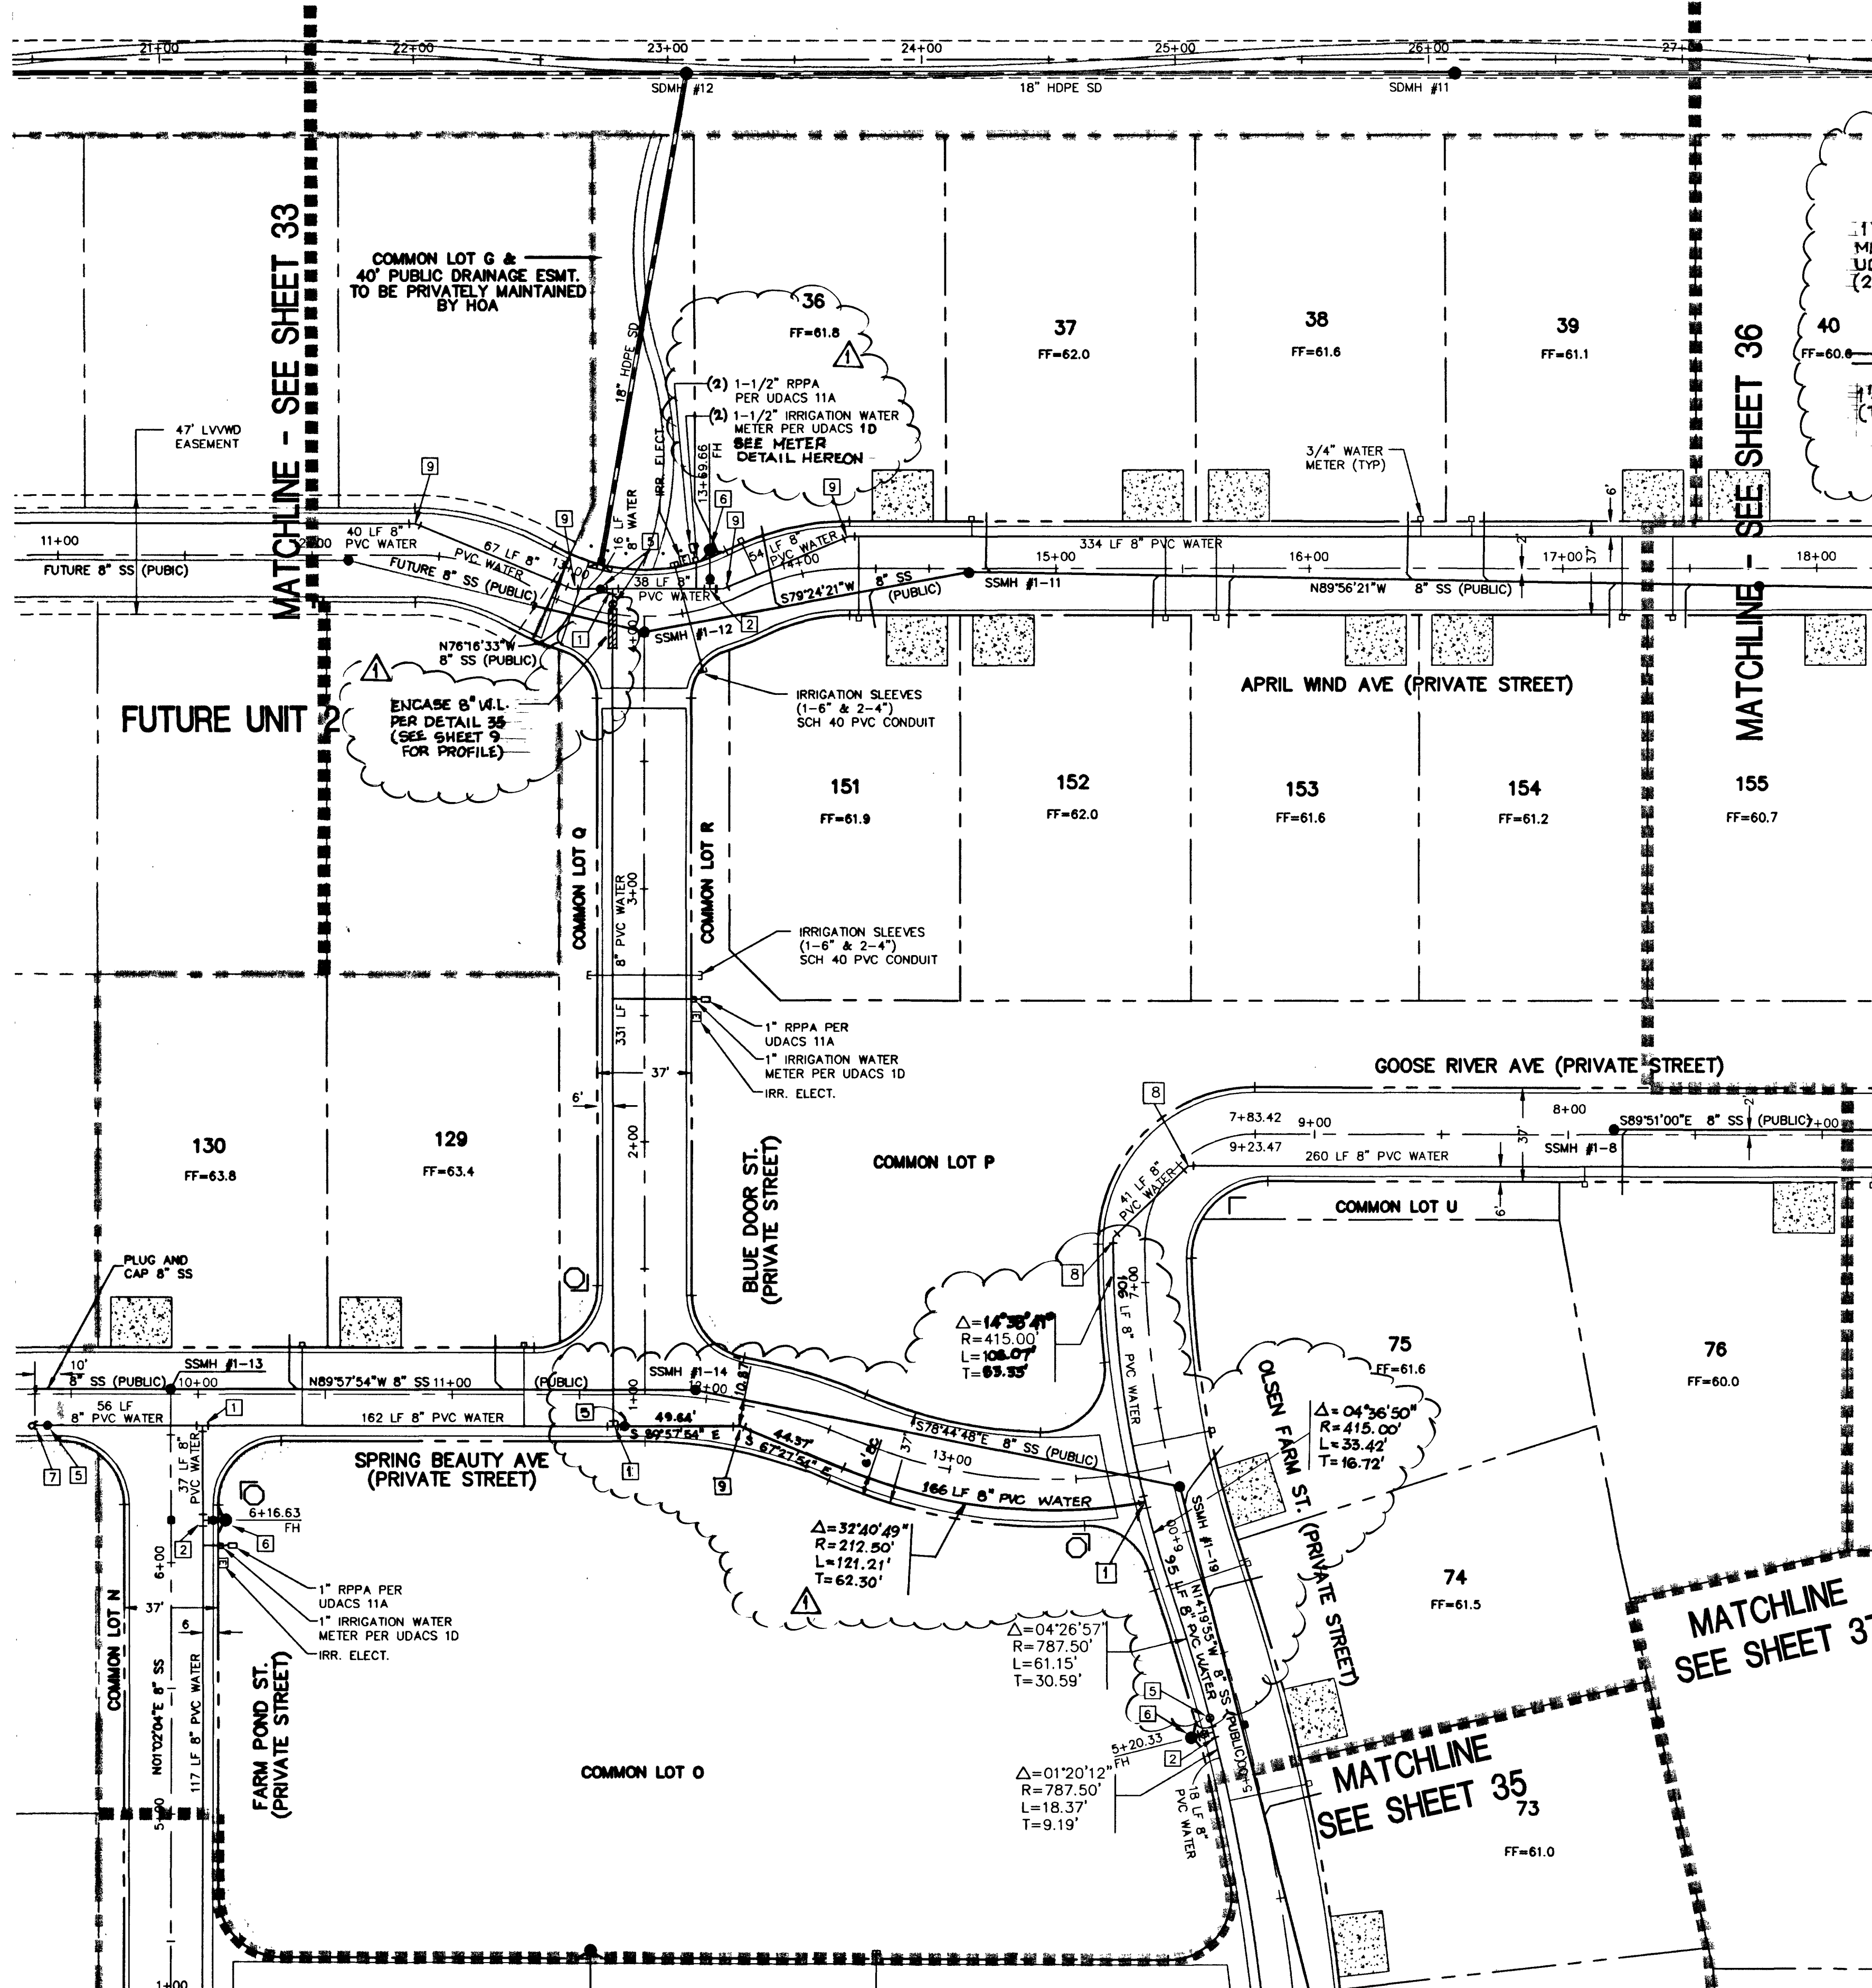


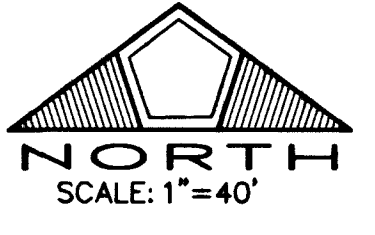

- LVVWD NOTES**
LVVWD PROJECT # 26249
- NO WORK SHALL BEGIN UNTIL THE WATER PLANS HAVE BEEN RELEASED FOR CONSTRUCTION BY THE LVVWD. FOLLOWING WATER PLAN APPROVAL, FORTY-EIGHT (48) HOUR NOTICE SHALL BE GIVEN TO THE LVVWD COMMUNICATIONS SUPPORT CENTER (258-7171) PRIOR TO THE START OF CONSTRUCTION. NOTICE MUST BE GIVEN BY 2:00 P.M. THE BUSINESS DAY PRIOR TO A LVVWD INSPECTION. WHEN REQUESTING INSPECTION, PLEASE REFER TO THE PROJECT NUMBER IDENTIFIED ABOVE.
 - ALL WORK SHALL CONFORM TO LVVWD STANDARD PLATES, DRAWING, AND SPECIFICATIONS AND THE UNIFORM DESIGN AND CONSTRUCTION STANDARDS FOR WATER DISTRIBUTION SYSTEMS (UDACS), LATEST EDITION.
 - ALL WORK, EXCEPT AS MODIFIED BY THESE PLANS OR BY NOTE 2, SHALL BE DONE IN ACCORDANCE WITH THE MOST CURRENT DRAFT OR EDITION OF THE UNIFORM STANDARD SPECIFICATIONS FOR PUBLIC WORKS CONSTRUCTION OFF-SITE IMPROVEMENTS, CLARK COUNTY AREA.
 - A SINGLE PIPE MATERIAL SHALL BE USED THROUGHOUT THE PROJECT, UNLESS OTHERWISE APPROVED BY THE LVVWD.
 - ALL SERVICE LATERALS TWO INCHES (2") IN DIAMETER AND SMALLER SHALL BE COPPER TUBING WITH LVVWD APPROVED SERVICE SADDLES.
 - ALL WATER METER BOXES SHALL BE LOCATED OUTSIDE OF DRIVEWAY AREAS.
 - ALL VALVES SHALL BE LOCATED OUTSIDE OF DRIVEWAYS, GUTTERS, CURBS AND ALLEY GUTTERS.
 - THE FOLLOWING REQUIREMENTS MUST BE MET IN THE EVENT A WATER LINE AND A SANITARY SEWER OR STORM SEWER LINE CROSS:
 - A MINIMUM EIGHTEEN INCH (18") VERTICAL SEPARATION (OUTSIDE TO OUTSIDE) MUST BE MAINTAINED WHEN THE WATER LINE IS INSTALLED OVER THE SANITARY OR STORM SEWER LINE. IF THE VERTICAL SEPARATION CANNOT BE MAINTAINED OR THE WATER LINE MUST BE PLACED UNDER THE SANITARY OR STORM SEWER LINE, THE SANITARY OR STORM SEWER LINE MUST BE CONSTRUCTED WITH ONE OF THE FOLLOWING OR, AS SHOWN ON THESE PLANS:
 - POTABLE WATER SUPPLY QUALITY MATERIAL.
 - ENCASEMENT, WITH FOUR INCH (4") CONCRETE (MINIMUM).
 - SLEEVING WITH POTABLE WATER SUPPLY QUALITY PIPE.
- EACH PROVISION MUST EXTEND ALONG THE SANITARY OR STORM SEWER, ON EITHER SIDE OF THE WATER MAIN, A MINIMUM TEN FOOT (10') DISTANCE PERPENDICULAR TO THE EXTERIOR OF MAIN.
- WARNING TAPE SHALL BE REQUIRED OVER ALL MAINS, ALL SIX INCH (6") DIAMETER AND LARGER SERVICE LATERALS, AND ANY SERVICE LATERAL NOT INSTALLED PERPENDICULAR TO THE MAIN IN ACCORDANCE WITH STANDARD PLATE NO. 27.
 - ALL WATER FACILITIES SHALL BE FILLED, DISINFECTED, PRESSURE TESTED, FLUSHED, FILLED AND AN ACCEPTABLE WATER SAMPLE OBTAINED PRIOR TO CONNECTION TO THE LVVWD'S DISTRIBUTION SYSTEM.
 - THE CONTRACTOR MUST OBTAIN ALL METERS TWO INCHES (2") AND SMALLER FROM LVVWD CENTRAL STORES. TELEPHONE 258-3152 FORTY-EIGHT (48) HOURS PRIOR TO PICK-UP.
 - CONSTRUCTION MAY INTERRUPT SERVICE, WITH LVVWD APPROVAL AND PROPER NOTIFICATION, BETWEEN THE HOURS OF 10:00 P.M. AND 8:00 A.M. SUNDAY THROUGH THURSDAY. CIRCUMSTANCES MAY REQUIRE A TEMPORARY SERVICE FEED BE INSTALLED, WITHOUT LVVWD REIMBURSEMENT. ANY TEMPORARY SERVICE FEED MUST HAVE PRIOR LVVWD APPROVAL.
 - ALL WATER FACILITY CONSTRUCTION MATERIALS USED MUST BE AS LISTED ON THE LVVWD'S PRE-APPROVED MATERIALS AND MANUFACTURERS LISTING FOR NEW FACILITIES, LATEST REVISION OR SPECIFICALLY APPROVED ON THESE PLANS.

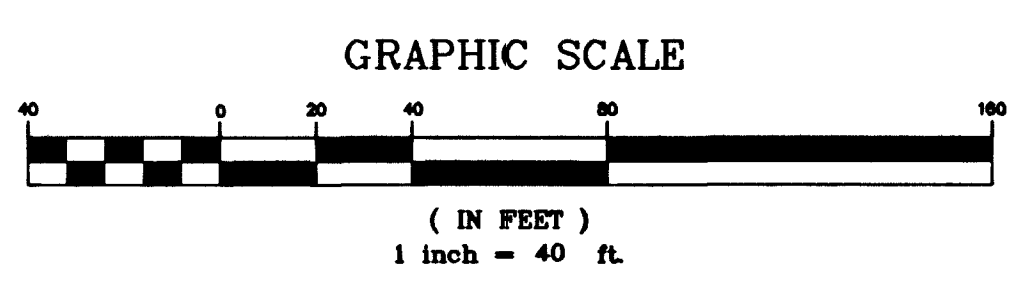

- WATER FITTINGS LEGEND:**
- 1 8" TEE
 - 2 8"x6" TEE
 - 3 8"x6" REDUCER
 - 4 8" 90° BEND
 - 5 8" GATE VALVE
 - 6 FIRE HYDRANT ASSY. PER UDACS PLATE 7 INCLUDING 6" G.V.
 - 7 2" BLOW-OFF ASSEMBLY W/CAP PER UDACS PLATE 4
 - 8 8" 45° BEND
 - 9 8" 22.5° BEND
 - 10 8" x 8" CROSS
 - 11 12" x 8" TEE

Call before you Dig.
1-800-227-2600

Call before you do Overhead
1-702-593-6111

- UTILITY LEGEND**
- EX 8" W EXISTING WATER LINE W/SIZE
 - 8" W PROPOSED WATER LINE W/SIZE
 - PROPOSED WATER LATERAL
 - PROPOSED FIRE HYDRANT W/6" LATERAL & 6" G.V.
 - EX 8" S EXISTING SEWER LINE W/SIZE
 - 8" S PROPOSED SEWER LINE W/SIZE
 - PROPOSED SEWER LATERAL
 - EXISTING SEWER MANHOLE
 - PROPOSED SEWER MANHOLE
 - 0" LIP DRIVEWAY
 - GATE VALVE
 - CONCRETE DRIVEWAY
 - 12" W 8" W WATER REDUCER
 - BWV REQUIRES BACKWATER VALVE
 - PRV REQUIRES PRESSURE REDUCER VALVE

- TRAFFIC LEGEND**
- 9" D3 STREET NAME SIGN (PER STD DWG 250)
 - 30" STOP SIGN (R1-1) LOCATE AT BCR
 - BLUE REFLECTIVE MARKER
 - STREET SIGN AS NOTED PER PLAN

APPROVALS

CITY FIRE MARSHAL: [Signature] DATE: 5/1/02

LAS VEGAS VALLEY WATER DISTRICT: [Signature] DATE: 5/1/02

REDUCED PRESSURE PRINCIPLE ASSEMBLY (2) 1" (2) 1 1/2"

APPROVED REDUCED PRESSURE PRINCIPLE ASSEMBLY(S) SHALL BE INSTALLED PER THE UDACS PLATE NO. 11A. NO WATER SHALL BE TAKEN FROM A SERVICE REQUIRING BACKFLOW PREVENTION UNTIL THE REDUCED PRESSURE PRINCIPLE ASSEMBLY HAS BEEN SUCCESSFULLY TESTED BY THE LVVWD.

ANY BLOCK WALL OR OTHER FENCE MATERIAL SHALL BE DESIGNED AND CONSTRUCTED AROUND THE OUTSIDE OF THE EASEMENT(S) TO ALLOW THE DISTRICT DIRECT ACCESS FROM THE ADJACENT RIGHT-OF-WAY. EASEMENTS SHALL BE CLEARLY MARKED OR STAKED PRIOR TO THE START OF CONSTRUCTION.

BASIS OF BEARING

THE BASIS OF BEARING FOR THIS SURVEY IS THE WEST LINE OF THE SOUTHEAST QUARTER (SE 1/4) OF SECTION 15, TOWNSHIP 19 SOUTH, RANGE 60 EAST, M.D.M., CLARK COUNTY, NEVADA, AS SHOWN IN FILE 115, PAGE 13 OF OFFICIAL RECORDS, CLARK COUNTY, NEVADA. I.E. NORTH 00°11'55" EAST

PULTE HOMES
1635 VILLAGE CENTER DRIVE, SUITE 250
LAS VEGAS, NEVADA 89134
(702) 256-7900

PENTACORE
CIVIL ENGINEERING AND SURVEYING
CONSULTING
6763 WEST CHARLESTON BOULEVARD
LAS VEGAS, NEVADA 89146 (702) 258-0115

WYETH RANCH UNIT 1

UTILITY AND TRAFFIC PLAN 1

DATE: 11/26/01
DRAWN BY: SLY
DESIGNED BY:
CHECKED BY:
ADA CHECKED:
JOB NO.: 0147/0230
SCALE: 1" = 40'

PROFESSIONAL ENGINEER - STATE OF NEVADA
RICHARD P. SENEAL
CIVIL
11752

SHEET **34** OF 41
C.L.V. DWG.#
307Y-4699