



1 CONCRETE SWALE DETAIL

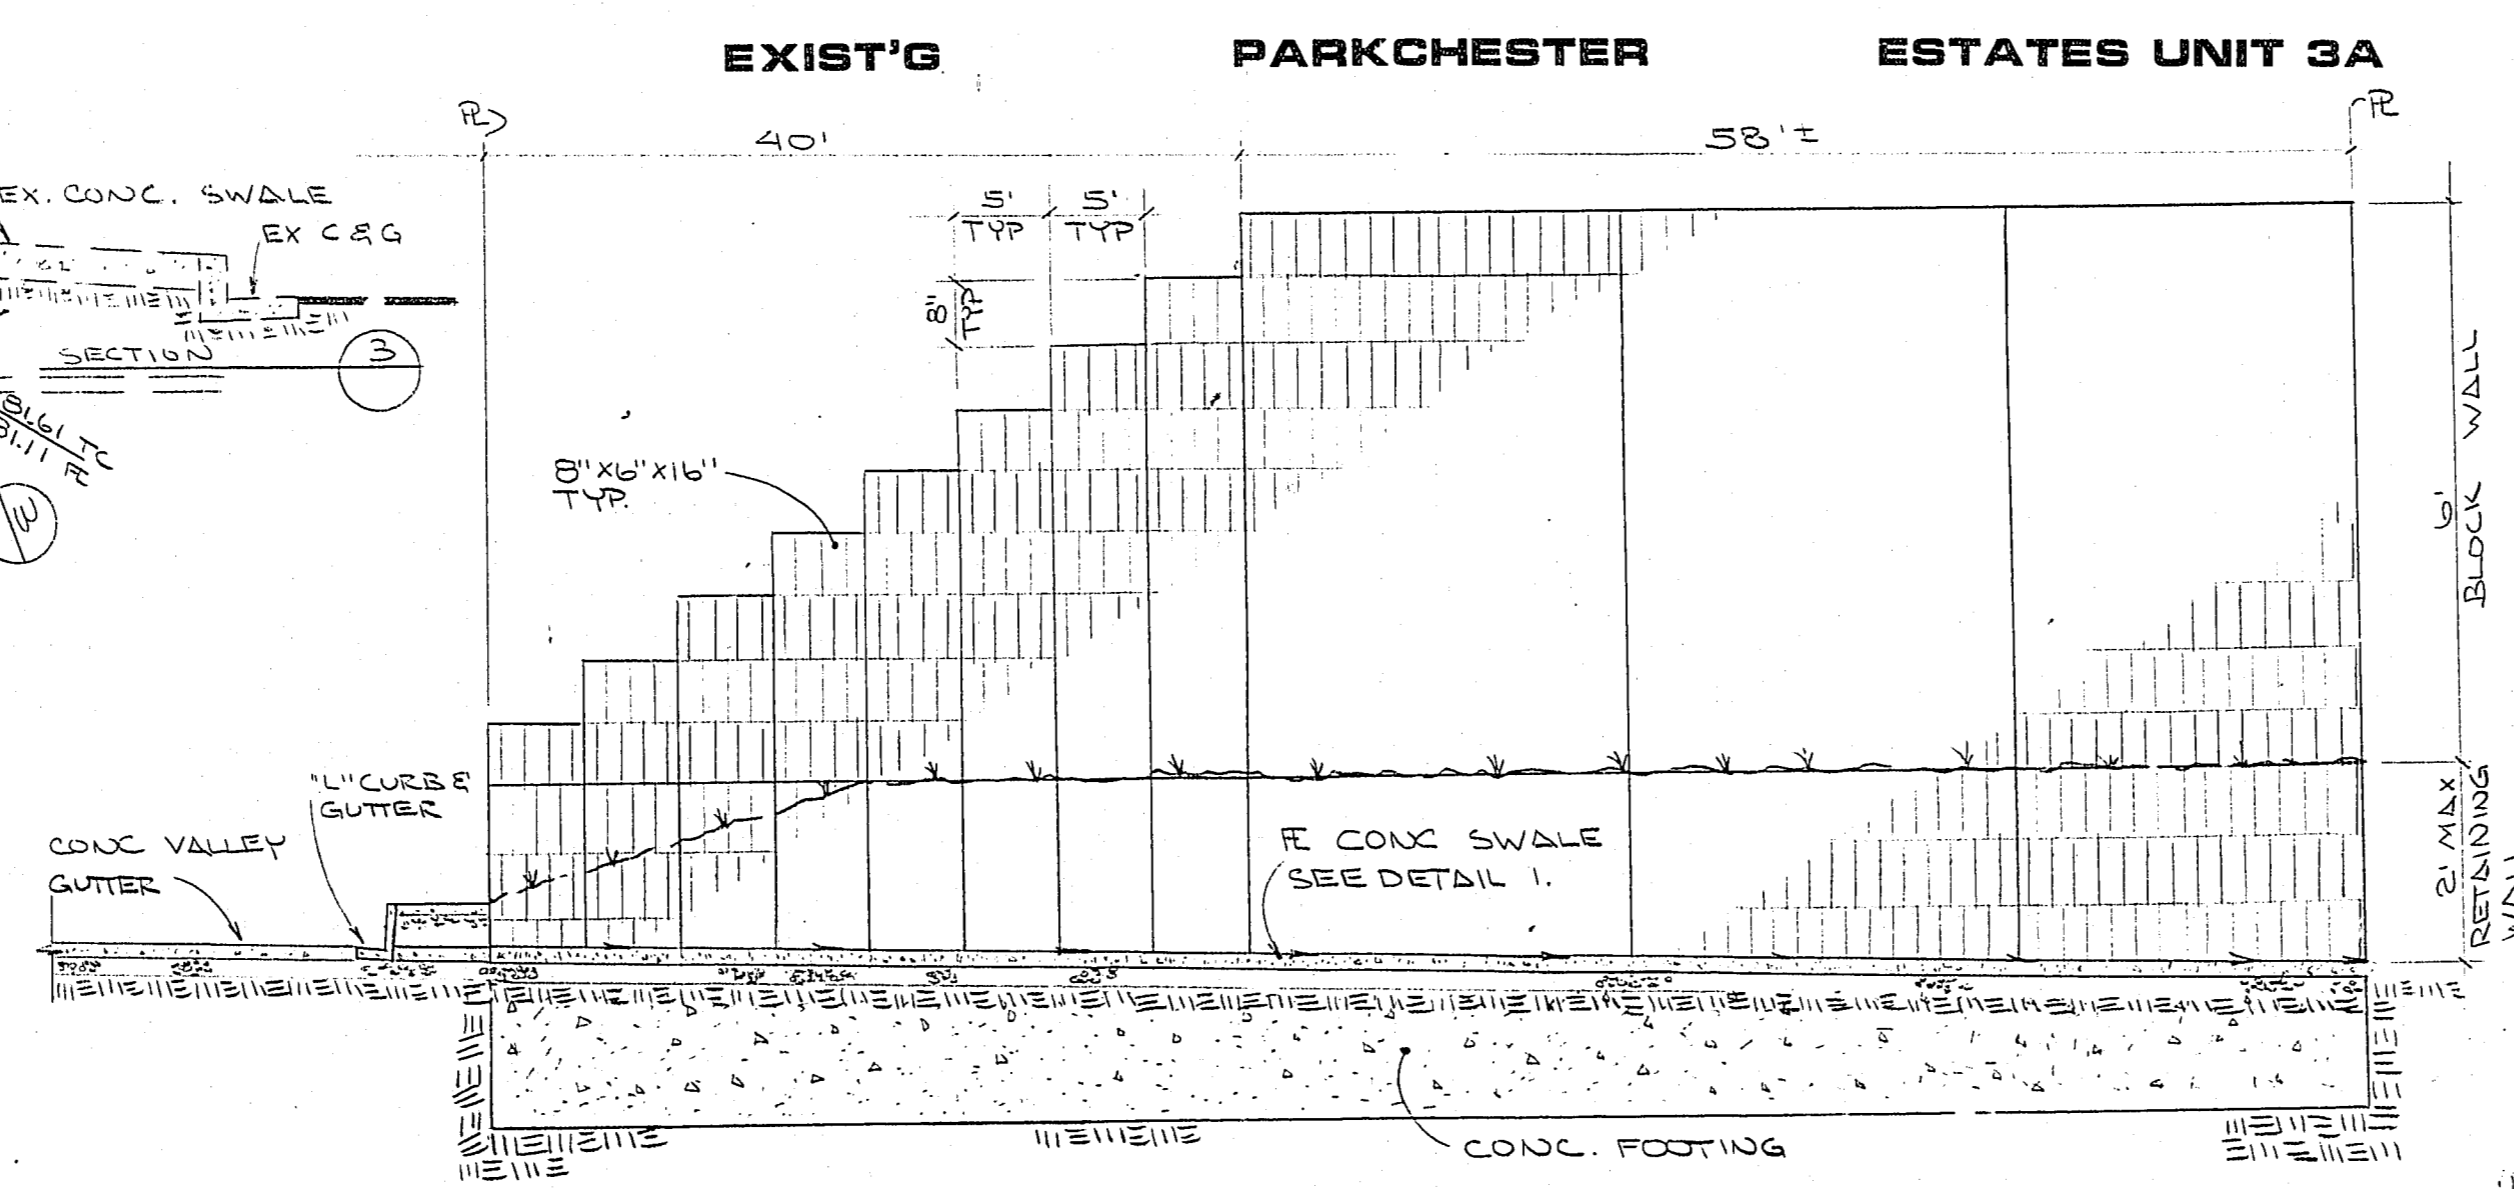

2 BLOCK WALL DETAIL

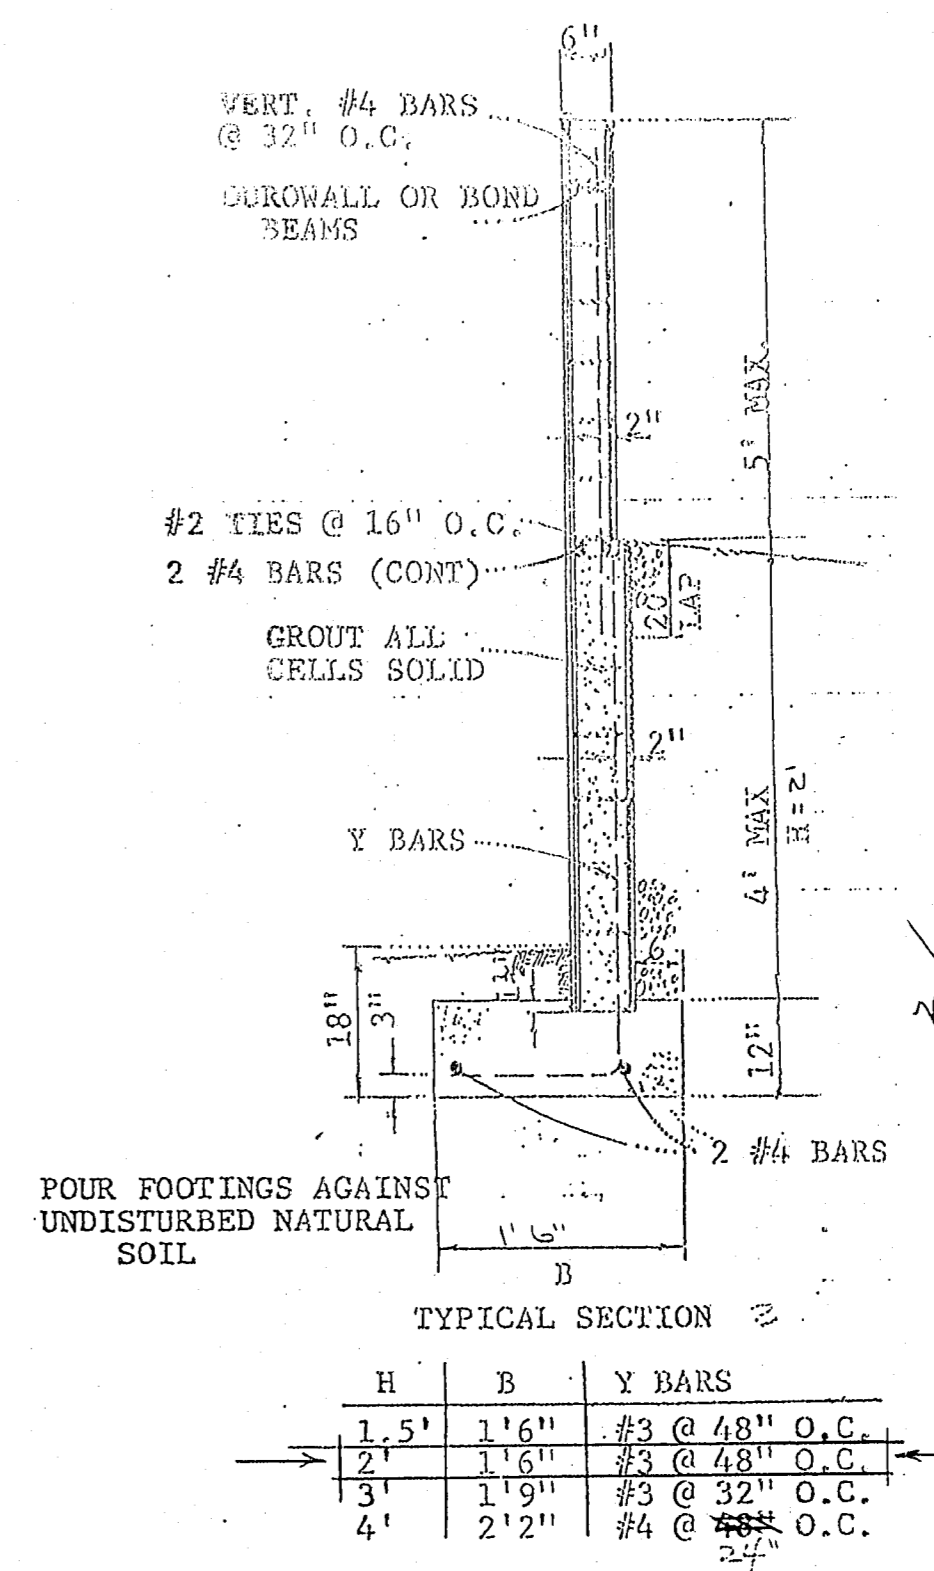

H	B	Y BARS
1.5'	1.6"	#3 @ 48" O.C.

- NOTES:
1. OMIT HEAD JOINT IN FIRST COURSE ABOVE LOW SIDE FG @ 32" O.C. FOR WEEP HOLE.
 2. EMBED FIRST COURSE 1 1/2" IN FOOTING.
 3. RETAINING PORTION OF WALL TO BE WATER PROOFED AND BACKED WITH 6" MIN. TYPE II GRAVEL.
 4. ALL ANGLE POINTS AND CONNECTING WALLS SHALL BE TIED IN WITH DUROWALL ON REINFORCING.
 5. KEY TO BE CONSTRUCTED IN SECTION WHEN RETAINMENT EXCEEDS 5'.

RETAINING WALL DETAIL

REVISION

REV	DATE	BY
1	3-95	TDWA

CHARLEY R JOHNSON RPE
NEVADA CERT #3005

CONSULTING ENGINEERS • PLANNERS
2800 WEST SAHARA AVENUE BUILDING 4 SUITE B
LAS VEGAS, NEVADA 89102 PHONE (702) 873-7550

vtm nevada

ROUGH GRADING PLAN

PROJECT - YELLOW ROSE ESTATES

WO NO. 2942

BY DWM CRV

DATE 3/21/97

SCALE 1" = 30'

SHEET 10 OF 10 SHEETS

7-9-10 1074. 8329