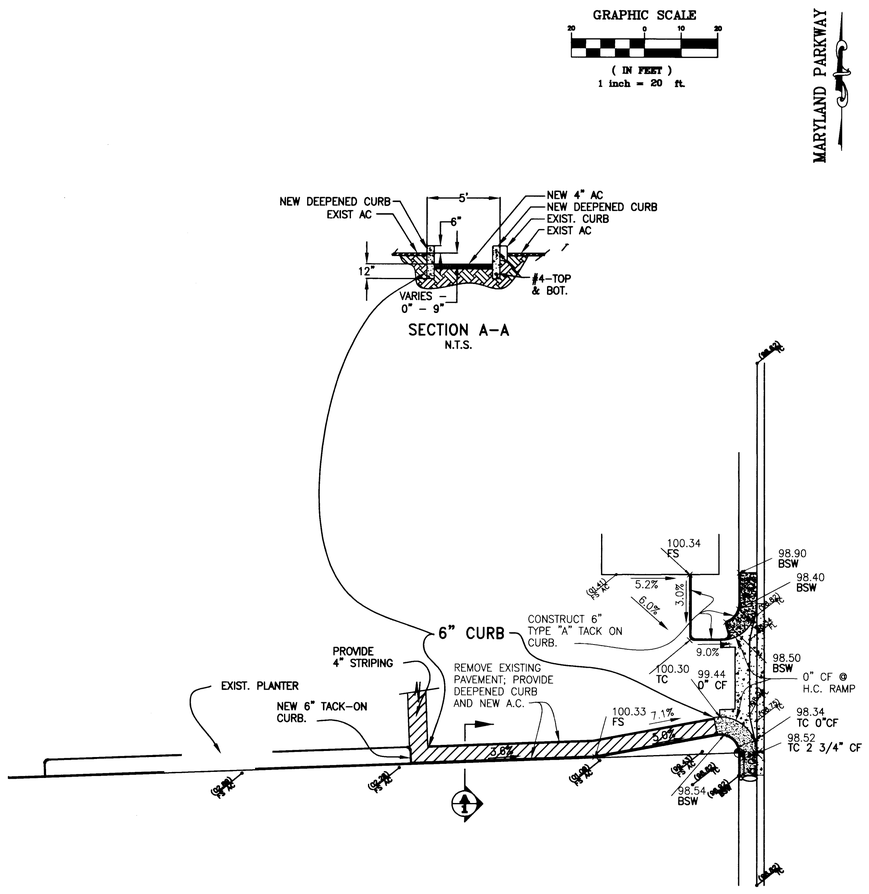

DRAWN BY: BAM	DESIGN BY: ALL	12/28/99	ADDED SHEET W/REVISED HC RAMP. KJT 11/19/00
		JOB NO: 1096	DRAWING NO: 1096

YUNG KWANG CHURCH
YUNG KWANG CHURCH
REVISED HANDICAPPED RAMP

HASKEW ENGINEERING & CONSTRUCTION, INC.
3035 EAST PATRICK LANE, SUITE 14
LAS VEGAS, NEVADA 89120
LAS VEGAS: 702-547-6333
FAX: 702-547-6203

PROFESSIONAL ENGINEER - STATE OF NEVADA
BARBARA MALLOY
CIVIL
No. 10932
12/28/99

SHEET
2 OF 2

20176

107-V2977

P:\land projects\1096 Yung Kwang Church\dwg\hc_ramp.dwg Tue Dec 28 14:20:59 1999 B. MALLOY

YUNG KWANG CHURCH
YUNG KWANG CHURCH
REVISED HANDICAPPED RAMP

2 OF 2

87-12177