
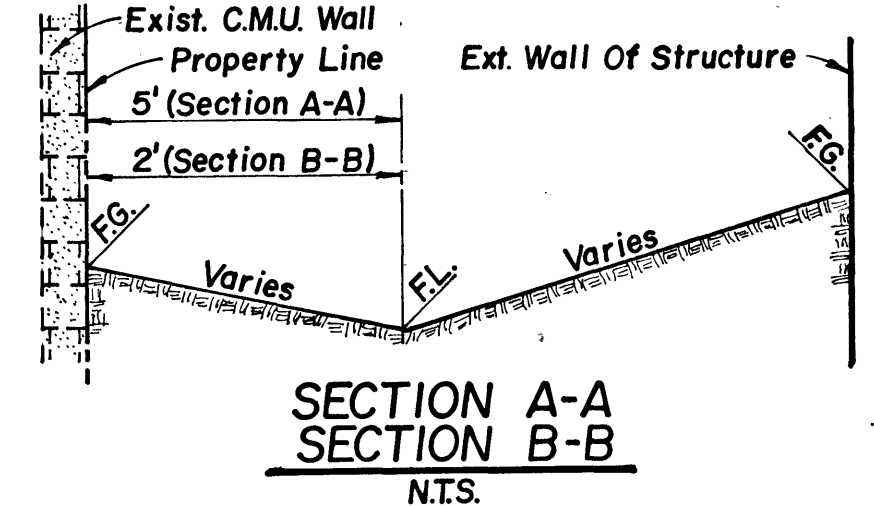
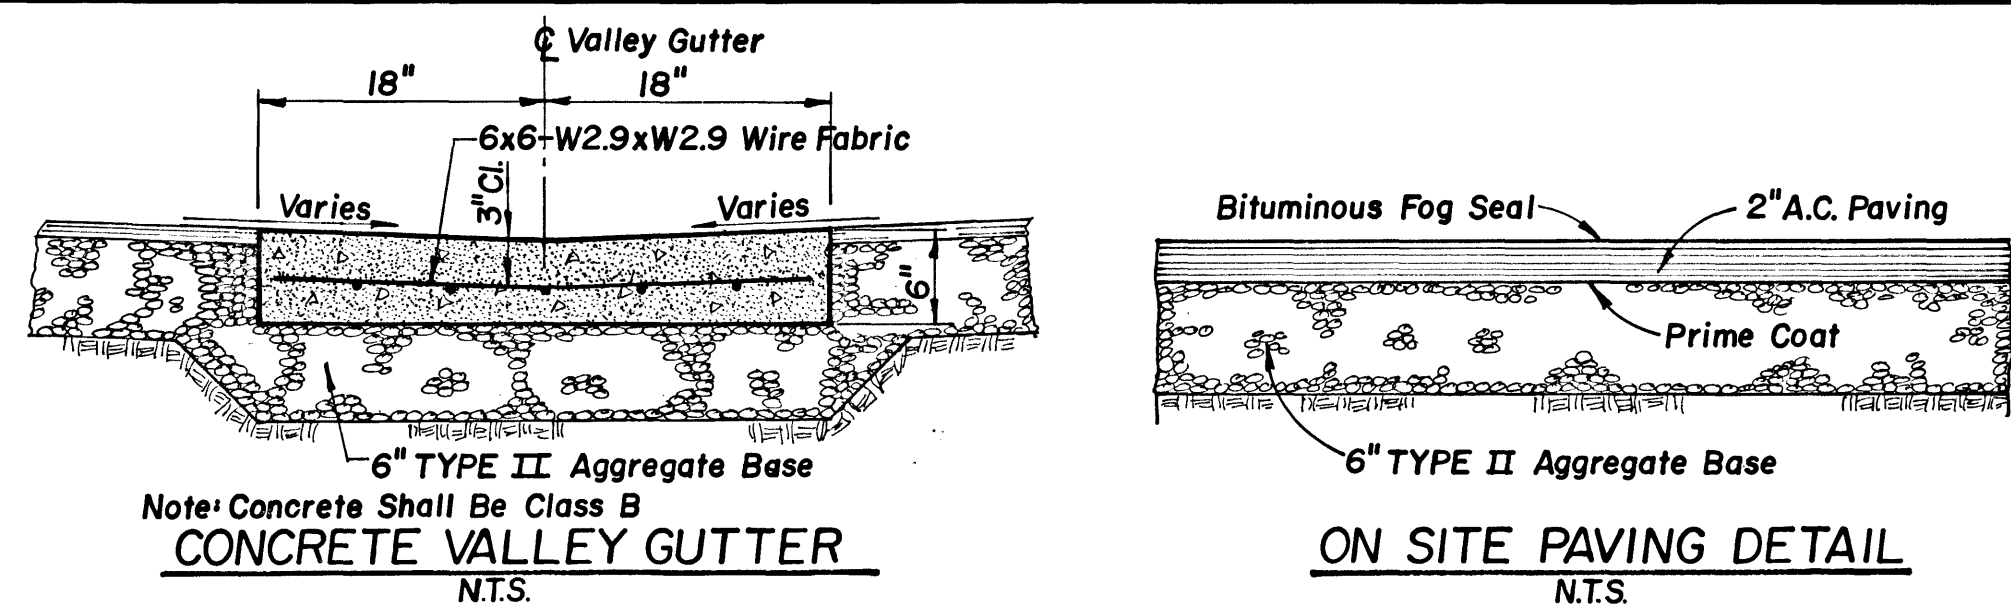


EXISTING A.G. SPANO APARTMENTS

SCALE: 1"=20'

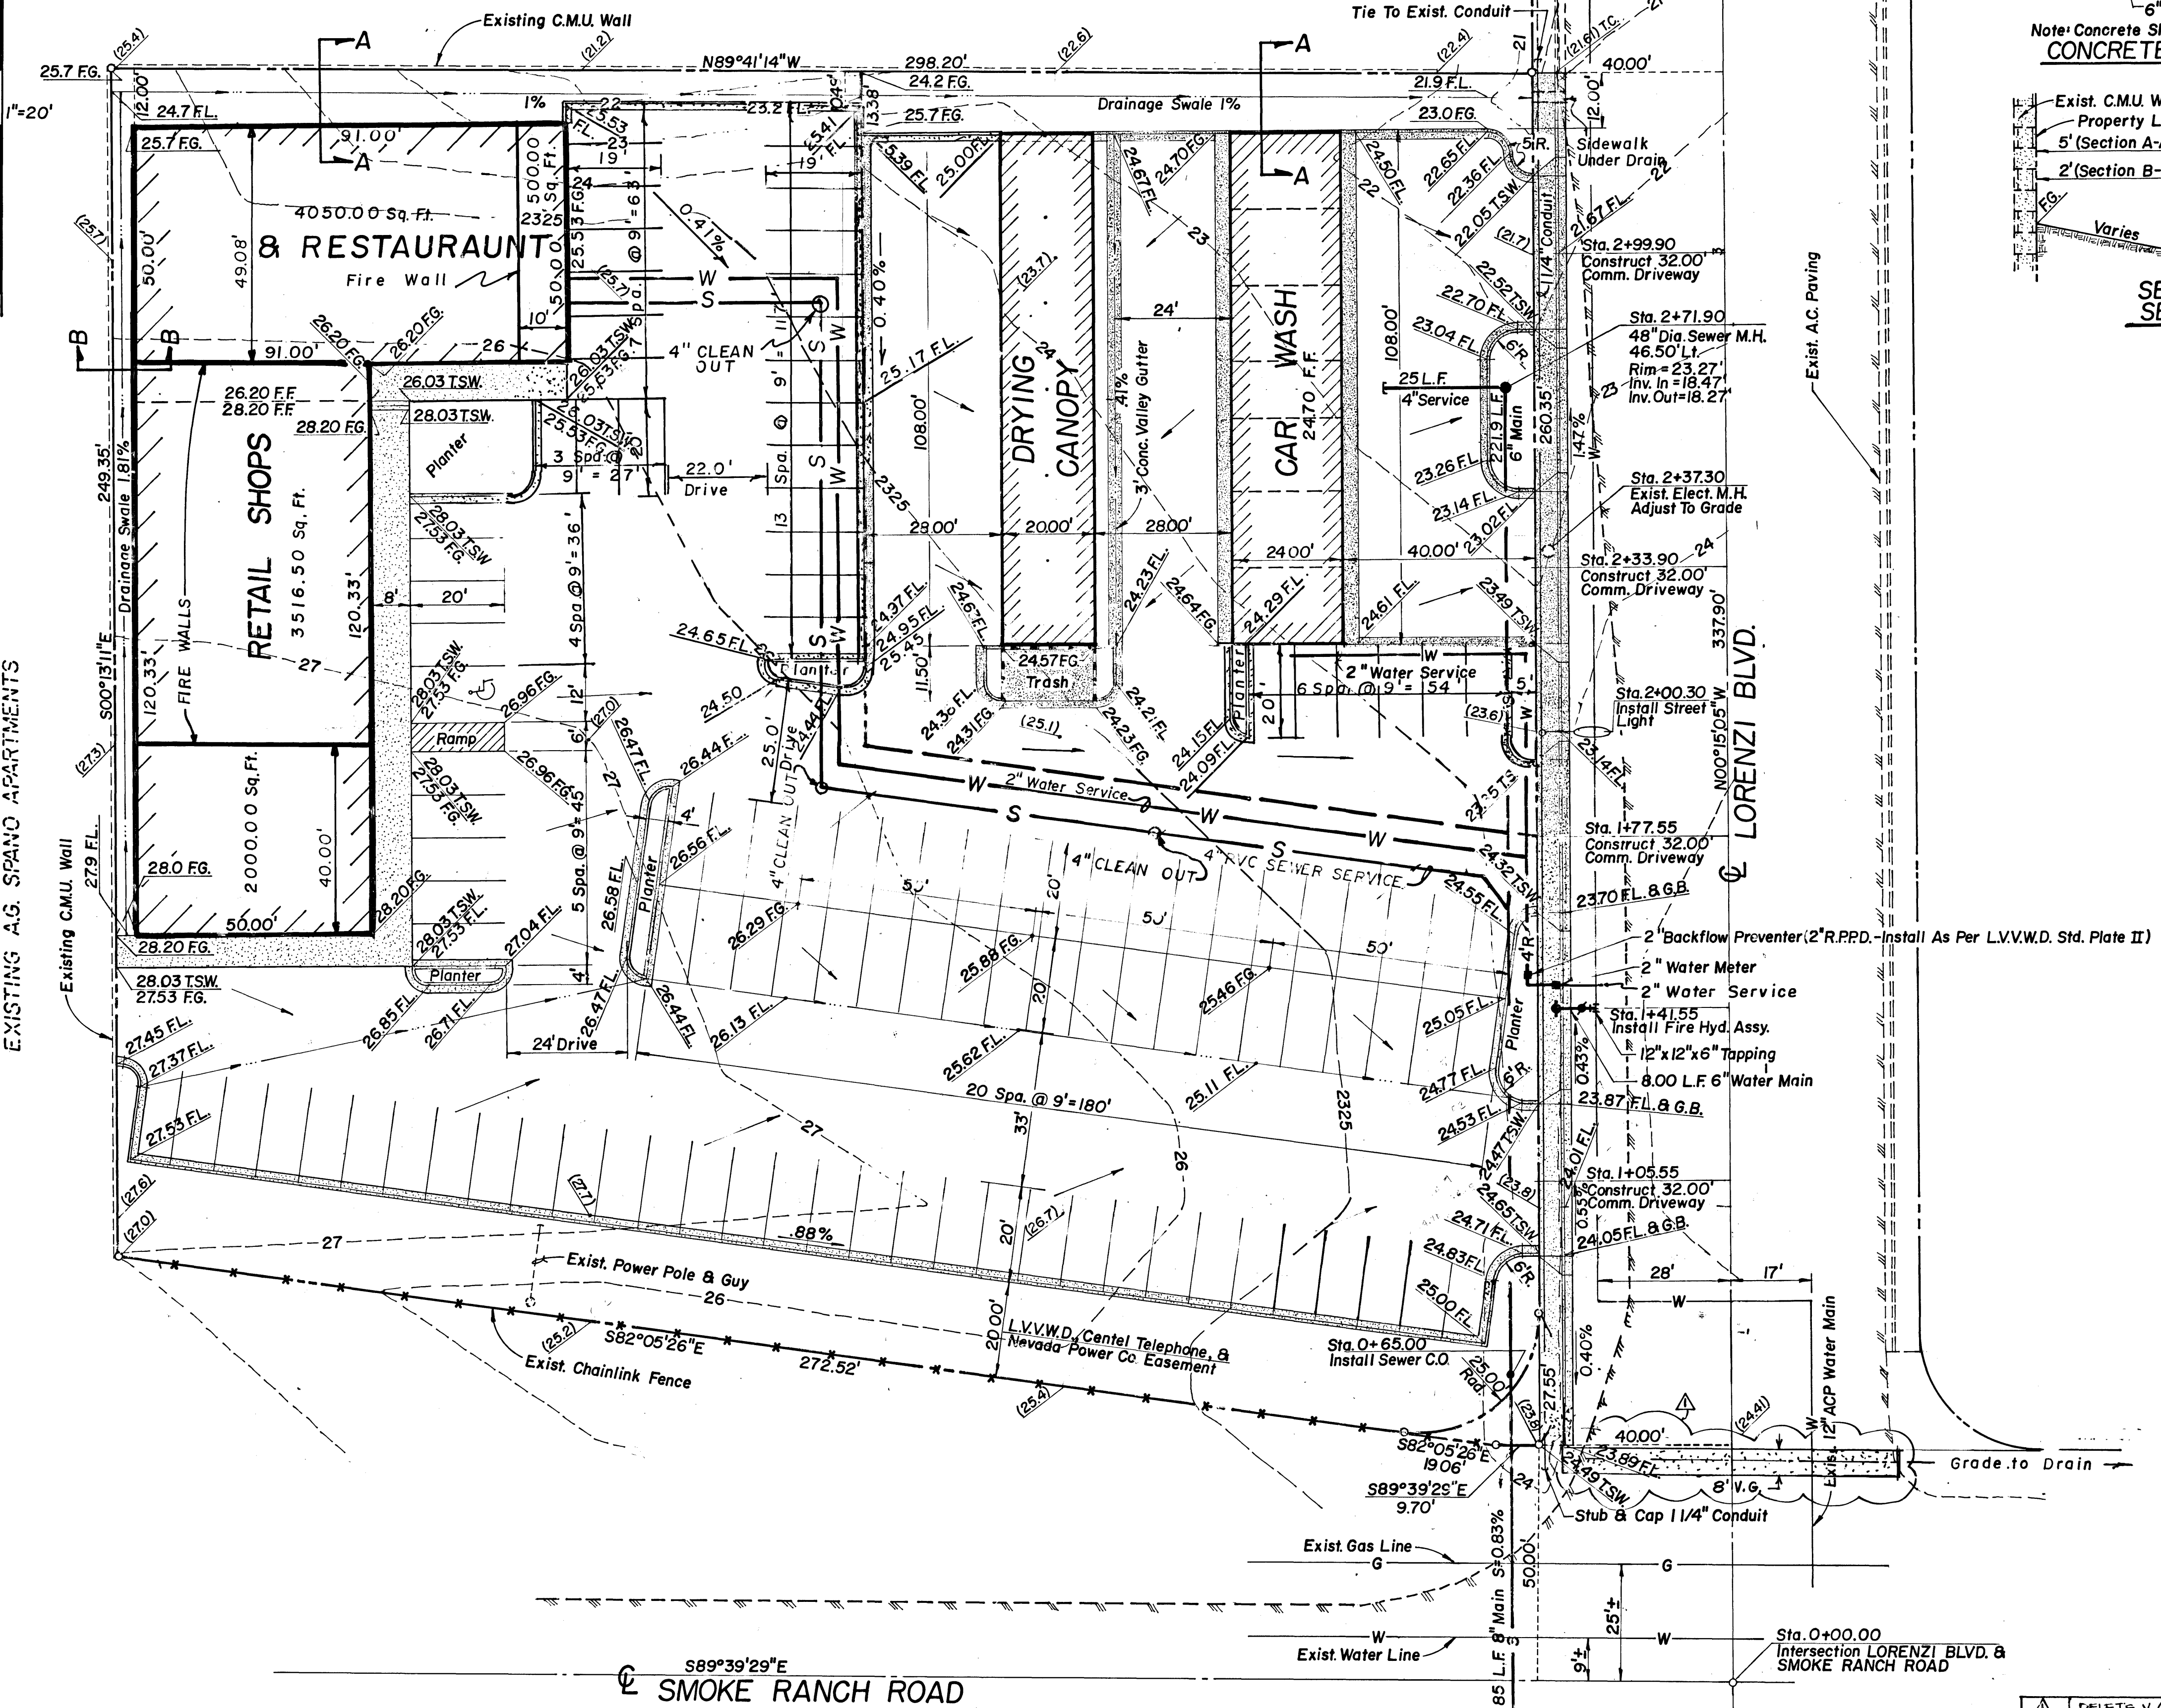

MATERIALS LIST

- 1 each 12" x 12" x 6" Tapping Tee & Valve
- 1 each 2" Water Meter (by L.V.V.W.D.)
- 1 each 2" Water Service (by Contractor)
- 1 each Fire Hydrant
- 8.00 L.F. 6" Water Main



12/4/39

REVISIONS:
ADDED SHOPPING CENTER
2-5-90

SCALE: 1"=20'
DATE

TITLE: **PLOT & GRADING PLAN**
FOR: **ZUNI CONSTRUCTION INC.**

New 48" Dia. Sewer M.H.
Rim = 24.65'
Inv. In N. = 15.72'
Inv. In W. = 15.52'
Inv. Out. E. = 15.52'
S=1.01%

Exist. C.L.V. Sewer M.H.
Rim = 24.55'
Inv. = 15.35'

Exist. 12" Sewer
S=1%

DELETE V.L. ACROSS LORENZI PER CITY
REV. 5-22-90

Bronken Engineering Chartered
1818 INDUSTRIAL ROAD, LAS VEGAS, NEVADA 89102 (702) 382-6660

SHEET NUMBER
2 OF 3

17-3-90
107-11732